

3921 East Baseline Road

Gilbert . Arizona



Suite B001 - 2,385 RSF

Suite B002 - 1,431 RSF

Suite B005 - 1,102 RSF

Suite B006 - 1,219 RSF

Suite B008 - 2,519 RSF

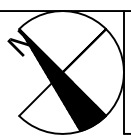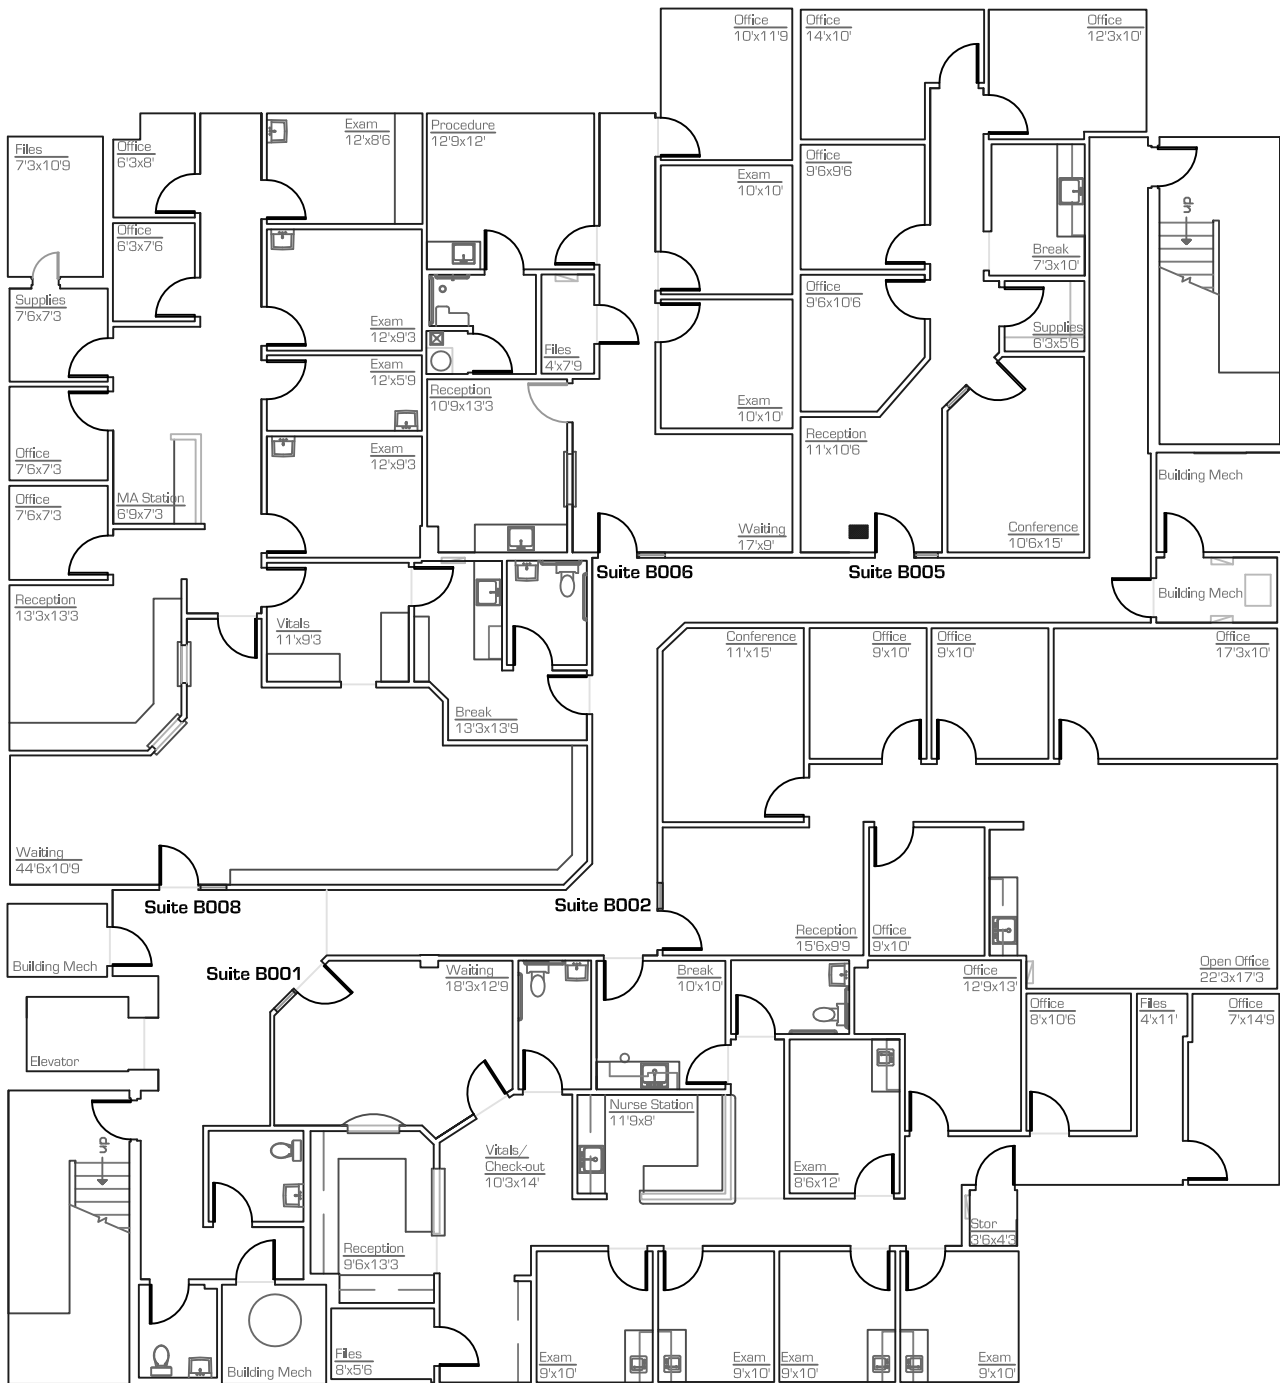

As-Built

scale: nts
February.2020

*All dimensions are approximate at ± 3"
*All information is of general nature

precision**DIMENSIONS**

as-built & design
602.790.6412

