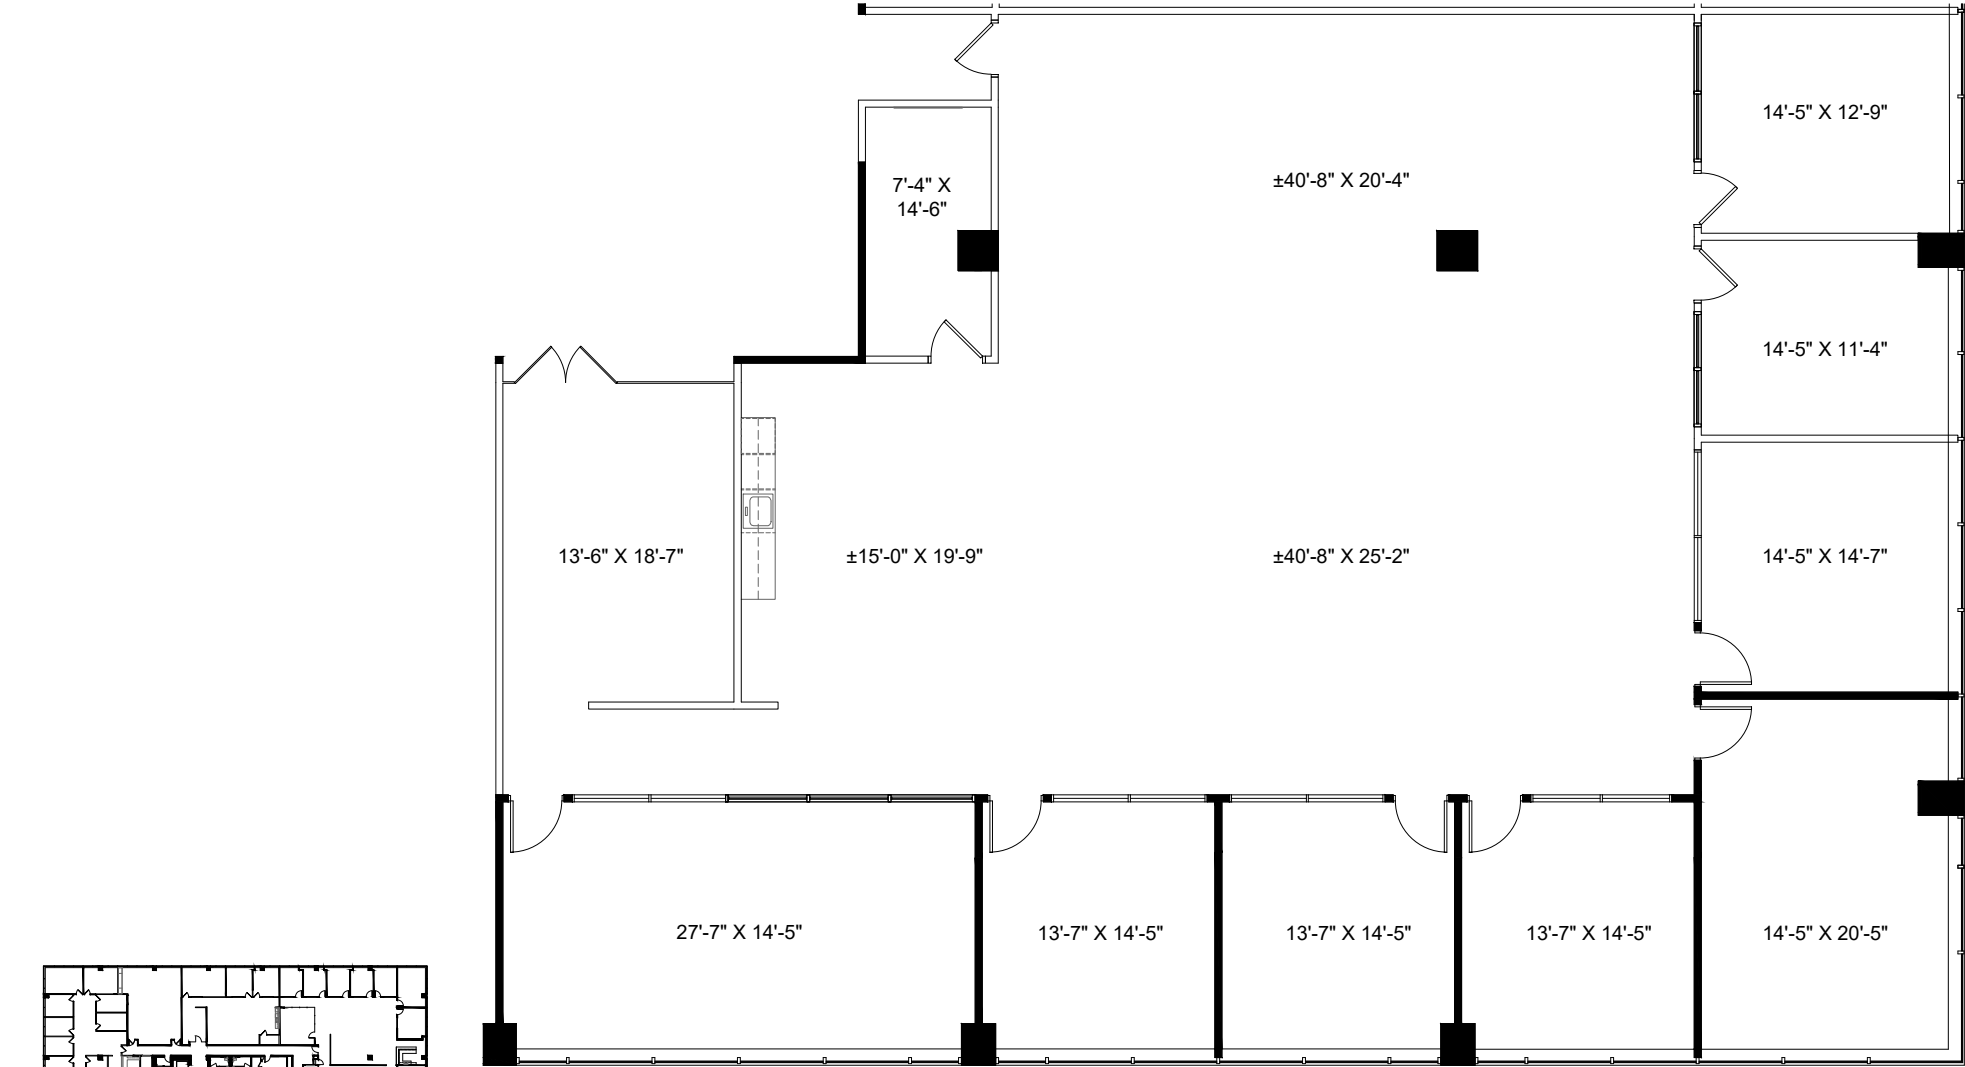


ALL DIMENSIONS ARE APPROXIMATE AND SUBJECT TO NOMINAL VARIANCE.

WESTERN SECURITIES ESTABLISHED · 1932	Uptown Center 2626 HOWELL STREET DALLAS, TEXAS 75204		rsf: 5,848	go studio 1201 main street suite 1370 dallas, texas 75202 214.420.4646
	AS-BUILT PLAN SUITE 980		scale: N.T.S.	
			date: 12.23.2025	