


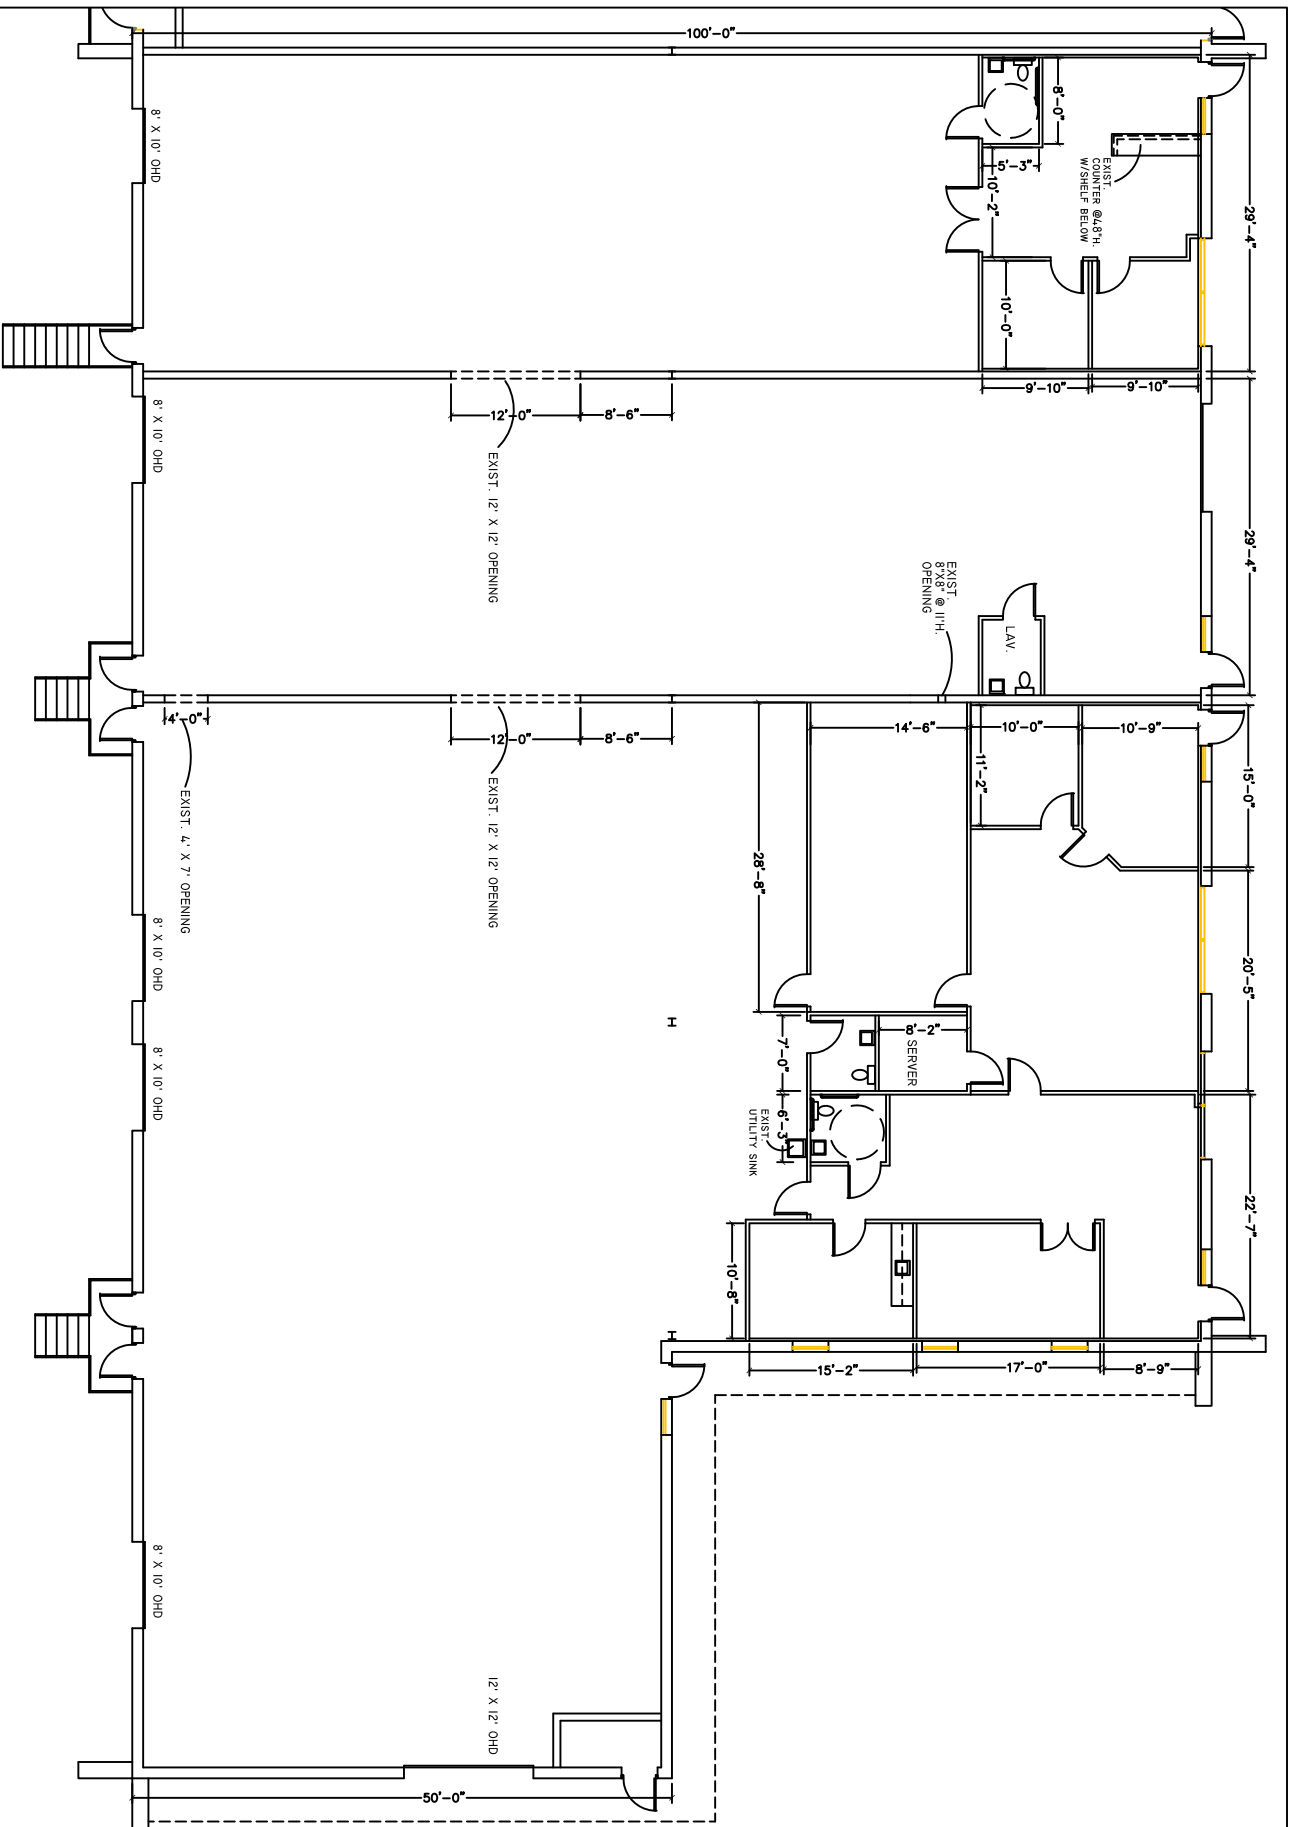

AS-BUILT
CROSSROADS COMMERCE CENTRE
2107 EMMORTON PARK ROAD
SUITES 101-104, 133-137
EDGEWOOD, MD
14,025 SQ.FT. (INCLUDES 2,827 SQ.FT. OF OFFICE)

SCALE: N.T.S.
DATE: 10/30/09
REVISED:



Hill Management Services, Inc.
9640 Deeteco Road
Timonium, Maryland 21093
(410) 666-1000
www.hillmgt.com