




**DEPARTMENT OF ENVIRONMENTAL HEALTH
SEWAGE DISPOSAL SYSTEM
"AS-BUILT"**

(R) Tank Only

Approval Issued to: Name Manuel Guerra Installer's Name Dudley Excavating
 Mailing Address: 1194 Patricia Dr Chico Application Number 90/25 AP Number 78-290-20
 Property Address 8165 Hwy 99E Los Molinos

Total Number: Living units _____ Bedrooms _____
 Water Supply: Public System _____ Individual _____
 Septic Tank: Distance from well 100' feet Total Liquid Capacity 1,200 gal.
 Drainfield: Total Linear Feet _____ ft.
 Width of Trench or Bed _____ ft.
 Distance Between Drain Lines _____ ft. (edge to edge) **TANK ONLY**
 Depth Rock Over Drain Line _____ in.
 Depth Rock Beneath Drain Line _____ in.
 Distance of well from closest portion of sewer system _____ ft.
 Seepage Pit: Depth _____ Diameter _____ Number _____

SKETCH OF ACTUAL SYSTEM AS CONSTRUCTED

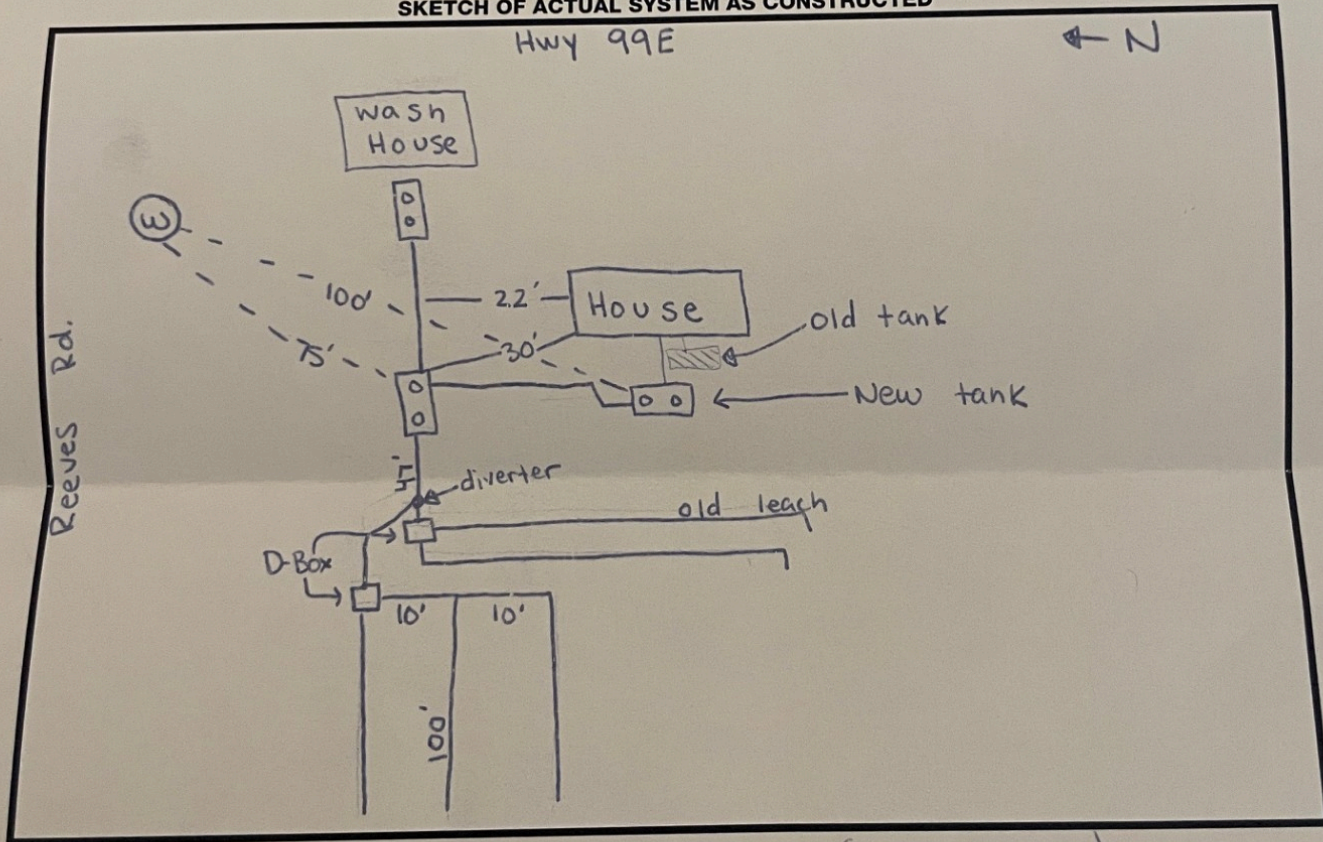

M. Lindero (see other page)
 SIGNATURE OF INSTALLER DATE

System meets all codes and is therefore **APPROVED** X for use. **DISAPPROVED** _____

Date 9/17/2025
 REV.4/97

E.H.Specialist A