


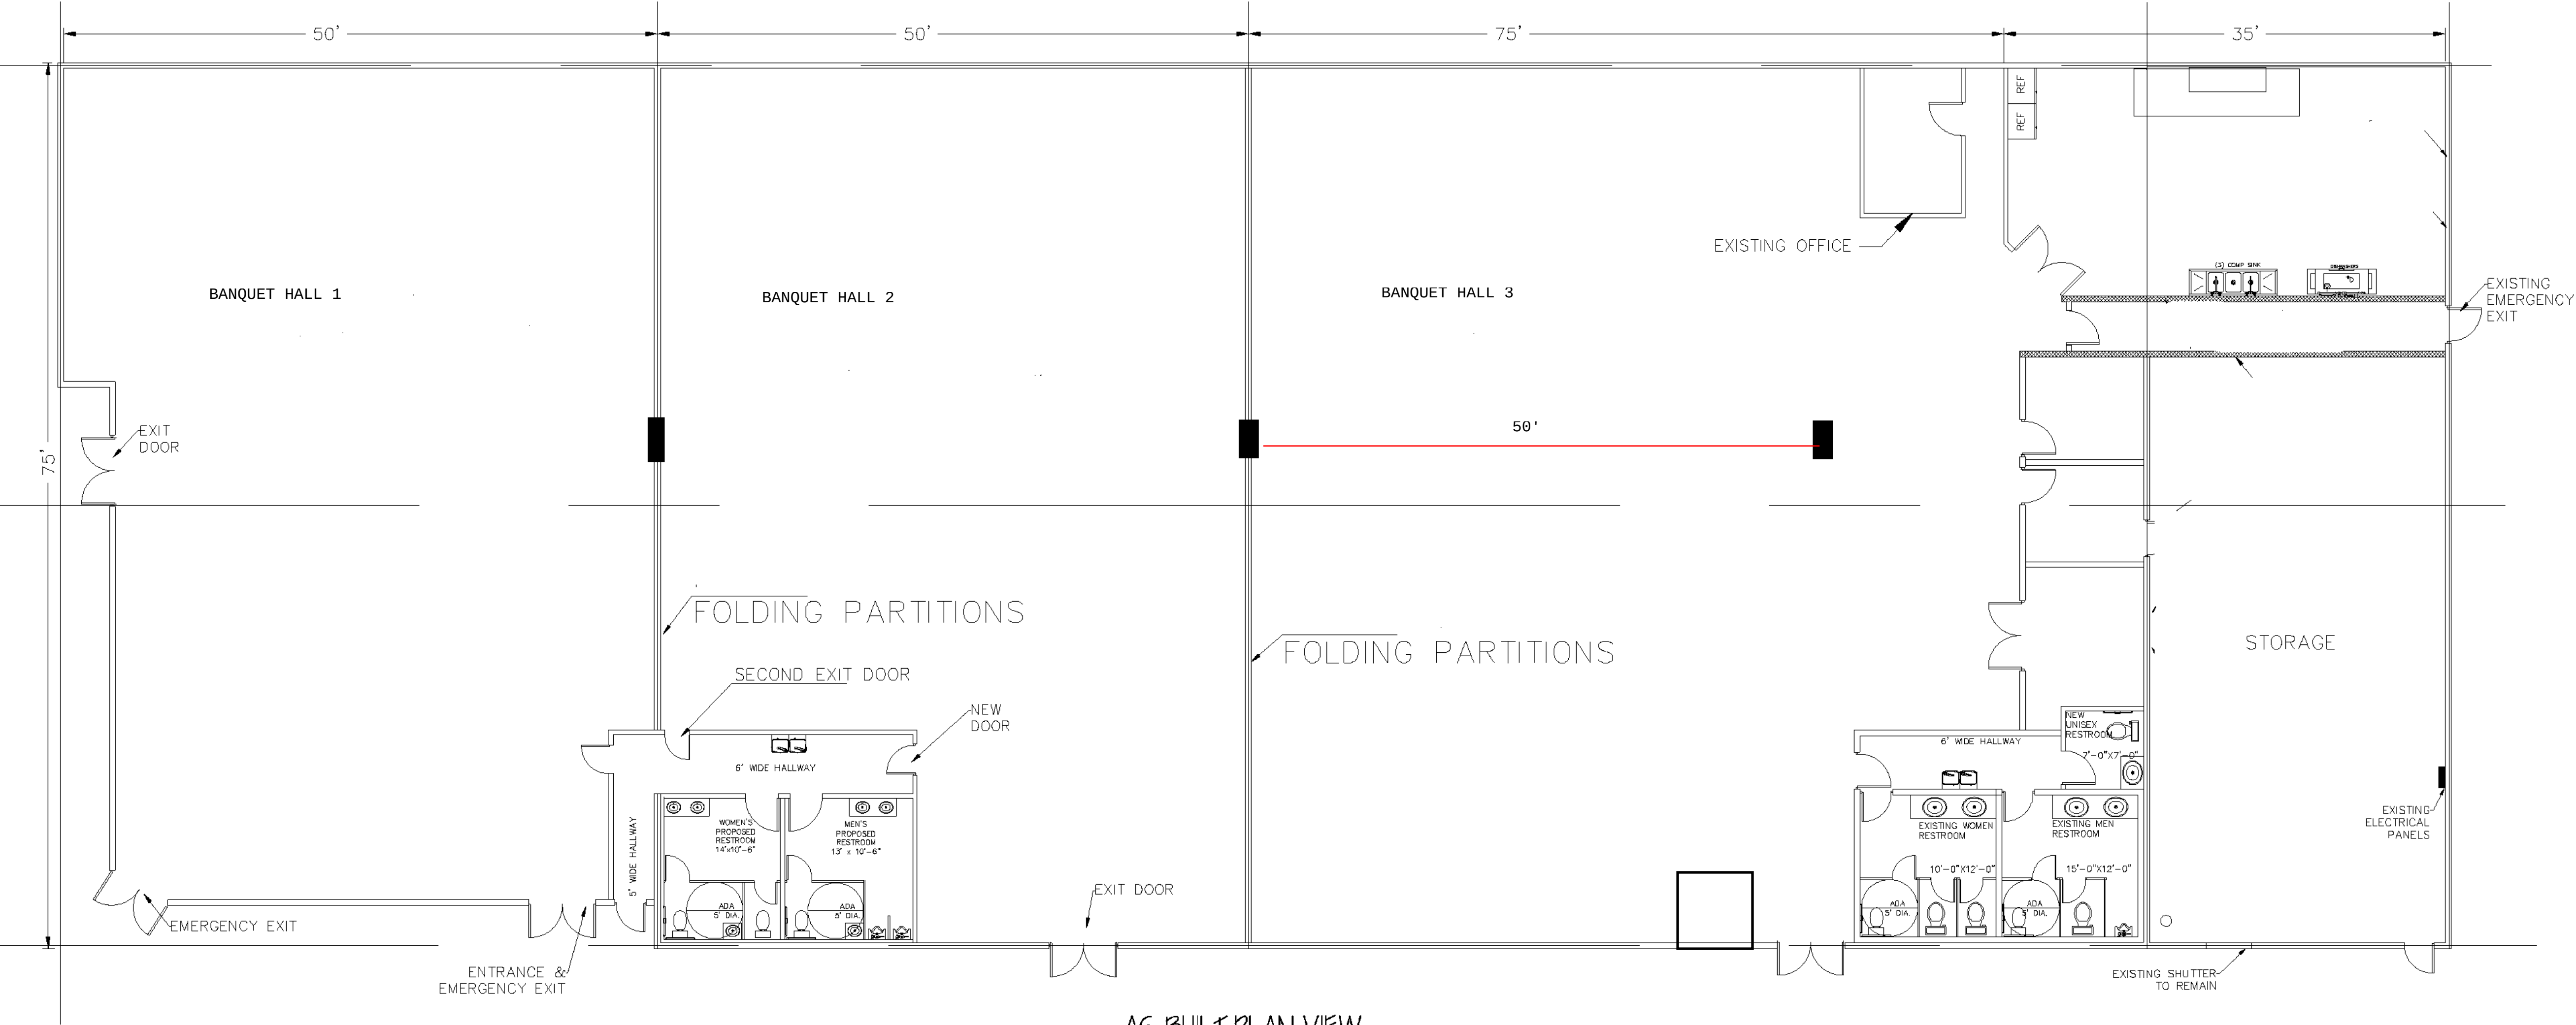

AS-BUILT PLAN VIEW
SCALE: 1/4" = 1'-0"