VICINITY MAP (NOT TO SCALE) CRYSTAL LAKE W LAKEVIEW AVE SEMINOLE AVE W LAKE MARY BLVD WASHINGTON AVE

DESCRIPTION

LOTS 1 AND 2. NICKSTE. ACCORDING TO THE PLAT THEREOF. AS RECORDED IN PLAT BOOK 88, PAGES 21 THROUGH 25, INCLUSIVE, OF THE PUBLIC RECORDS OF SEMINOLE COUNTY,

TOGETHER WITH NON EXCLUSIVE EASEMENTS FOR THE BENEFIT OF THE ABOVE DESCRIBED PARCEL AS CREATED BY AND SET FORTH IN THAT CERTAIN GENERAL WARRANTY DEED AND EASEMENT FOR PARKING AND INGRESS/EGRESS BY AND BETWEEN OAKS AT LAKE MARY, LTD. AND OAKS OUT, LLC. RECORDED MAY 4, 2017 IN OFFICIAL RECORDS BOOK 8905, PAGE 1884, OF THE PUBLIC RECORDS OF SEMIN OLE COUNTY

ENCUMBRANCES

4. EASEMENTS IN FAVOR OF FLORIDA POWER CORPORATION RECORDED AUGUST 22 1974 IN OFFICIAL RECORDS BOOK 1028, PAGES 1773, 1774 AND 1776. (OFF SUBJECT PROPERTY, NOT SHOWN HEREON.)

5. DEVELOPERS AGREEMENT RECORDED APRIL 2, 1987 IN OFFICIAL RECORDS BOOK 1833 PAGE 1001; AS AFFECTED BY AMENDMENT TO DEVELOPERS AGREEMENT RECORDED APRIL 10, 1989 IN OFFICIAL RECORDS BOOK 2058, PAGE 324; AND AMENDMENT TO DEVELOPERS AGREEMENT RECORDED JUNE 24, 1998 IN OFFICIAL RECORDS BOOK 3448, PAGE 1411. (ON AND OFF SUBJECT PROPERTY, BLANKET IN NATURE.)

6. PERMANENT PERPETUAL DRAINAGE AND RIGHT OF WAY EASEMENT BETWEEN SEMINOLE COUNTY AND SANDEFUR DEVELOPMENT, INC. RECORDED SEPTEMBER 29, 1988 IN OFFICIAL RECORDS BOOK 2001, PAGE 639. (ON SUBJECT PROPERTY, SHOWN HEREON.)

7. RESOLUTION NO. 90 R 17 FOR WIDENING OF ROADWAY AND IMPROVEMENT OF DRAINAGE SYSTEM RECORDED IN OFFICIAL RECORDS BOOK 2144, PAGE 418, AND RECORDED FEBRUARY 16, 1990 IN OFFICIAL RECORDS BOOK 2153, PAGE 1927. (OFFICIAL RECORDS BOOK 2144, PAGE 418 IS INCOMPLETE AND CANNOT BE GRAPHICALLY DEPICTED; OFFICIAL RECORDS BOOK 2153, PAGE 1927 NOT PROVIDED.)

8. CROSS ACCESS EASEMENT BETWEEN JAMES BRANNEN MURPHY, JOSEPH VAUGHN AND BENEQUITY PROPERTIES RECORDED MARCH 22, 1999 IN OFFICIAL RECORDS BOOK 3614, PAGE 1077, RE RECORDED IN OFFICIAL RECORDS BOOK 3714, PAGE 737. (OFF SUBJECT PROPERTY, NOT SHOWN HEREON.)

9. STORMWATER DRAINAGE AND UTILITY EASEMENT BETWEEN BENEQUITY PROPERTIES; OAKS AT LAKE MARY, LTD.; AND COMMUNITY NATIONAL OF LAKE MARY, INC. RECORDED MARCH 22, 1999 IN OFFICIAL RECORDS BOOK 3614, PAGE 1103. (ON SUBJECT PROPERTY, BLANKET IN NATURE.)

10. PARKING AND ACCESS EASEMENT BETWEEN BENEQUITY PROPERTIES; OAKS AT LAKE MARY, LTD.; AND COMMUNITY NATIONAL OF LAKE MARY, INC. RECORDED MARCH 22, 1999 IN OFFICIAL RECORDS BOOK 3614, PAGE 1113, AND RERECORDED AUGUST 27, 1999 IN OFFICIAL RECORDS BOOK 3713, PAGE 1301. (ON SUBJECT PROPERTY, BLANKET IN NATURE AND OFF SUBJECT PROPERTY, NOT PLOTTABLE.)

11. CONDITIONS AND RESTRICTIONS PERTAINING TO "RETENTION AREA" AS SET OUT IN SHORT FORM LEASE BY AND BETWEEN OAKS AT LAKE MARY, LTD., A FLORIDA LIMITED PARTNERSHIP, LANDLORD, AND FAMILY DOLLAR STORES OF FLORIDA, INC., A FLORIDA CORPORATION, TENANT, RECORDED FEBRUARY 6, 2008 IN OFFICIAL RECORDS BOOK 6923, PAGE 639. (ON SUBJECT PROPERTY, SHOWN IN ITS APPROXIMATE LOCATION HEREON.)

12. DRAINAGE AND RETENTION POND EASEMENT IN FAVOR OF SEMINOLE COUNTY, A CHARTER COUNTY AND POLITICAL SUBDIVISION OF THE STATE OF FLORIDA, RECORDED IN OFFICIAL RECORDS BOOK 8491, PAGE 1879. (ON AND OFF SUBJECT PROPERTY, SHOWN

13. EASEMENT FOR PARKING AND INGRESS/EGRESS AS SET FORTH IN THAT CERTAIN GENERAL WARRANTY DEED RECORDED MAY 4, 2017 IN OFFICIAL RECORDS BOOK 8905, PAGE 1884. (ON AND OFF SUBJECT PROPERTY, IN AREA SHOWN HEREON.)

14. TRAFFIC CONTROL UTILITY EASEMENT IN FAVOR OF SEMINOLE COUNTY, A CHARTER COUNTY AND POLITICAL SUBDIVISION OF THE STATE OF FLORIDA, RECORDED AUGUST 19, 2019 IN OFFICIAL RECORDS BOOK 9418, PAGE 438. (ON SUBJECT PROPERTY, SHOWN HEREON.)

15. ORDINANCE NO. 1639 REZONING CERTAIN LANDS RECORDED JUNE 9, 2021 IN OFFICIAL RECORDS BOOK 9956, PAGE 1598. (ON SUBJECT PROPERTY, BLANKET IN NATURE.)

16. RESTRICTIONS, COVENANTS, EASEMENTS, SETBACKS, OR OTHER MATTERS AS MAY BE SHOWN ON THE PLAT OF NICKSTE, AS RECORDED IN PLAT BOOK 88, PAGES 21 THROUGH 25, INCLUSIVE, PUBLIC RECORDS OF SEMINOLE COUNTY, FLORIDA. *(ON SUBJECT* PROPERTY, BLANKET IN NATURE.)

MAP OF SURVEY

NOTES

1. BEARING STRUCTURE IS ASSUMED AND BASED ON THE SOUTH RIGHT-OF-WAY LINE OF WEST LAKE MARY BOULEVARD, BEING N89°39'42"E.

2. THIS SURVEY REFLECTS ONLY MATTERS OF RECORD AS PROVIDED BY THE CLIENT OR CLIENTS REPRESENTATIVE.


3. THE SURVEYOR HAS NOT PHYSICALLY LOCATED THE UNDERGROUND UTILITIES. THIS SURVEY WAS MADE ON THE GROUND. ANY UNDERGROUND UTILITIES SHOWN HEREON HAVE BEEN LOCATED FROM OBSERVED SURFACE UTILITY FEATURES AND/OR DRAWING PROVIDED BY CLIENT. THE SURVEYOR MAKES NO GUARANTEE THAT THE UNDERGROUND UTILITIES SHOWN COMPRISE ALL SUCH UTILITIES IN THE AREA, EITHER IN SERVICE OR ABANDONED. THE SURVEYOR FURTHER DOES NOT WARRANT THAT THE UNDERGROUND UTILITIES SHOWN ARE IN THE EXACT LOCATION INDICATED ALTHOUGH HE DOES CERTIFY THAT THEY ARE SHOWN AS ACCURATELY AS POSSIBLE FROM INFORMATION AVAILABLE


4. SUBJECT PROPERTY LIES IN ZONE "X", BASED ON FLOOD INSURANCE RATE MAP NO. 12117C0065F, COMMUNITY NO. 120416, CITY OF LAKE MARY, SEMINOLE COUNTY, FLORIDA, EFFECTIVE SEPTEMBER 28, 2007.


5. THIS SURVEY IS VALID ONLY FOR THE PARTIES TO WHOM IT IS CERTIFIED TO. LIABILITY TO THIRD PARTIES MAY NOT BE TRANSFERRED OR ASSIGNED.


6. THIS SURVEY EXCEEDS THE ACCURACY REQUIREMENTS SET FORTH IN FLORIDA

7. THIS SURVEY WAS MADE WITH BENEFIT OF CHICAGO TITLE INSURANCE COMPANY'S COMMITMENT NO. 11117335, EFFECTIVE: MAY 8, 2023.

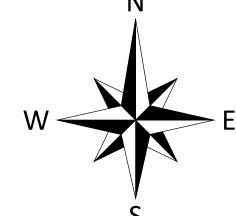

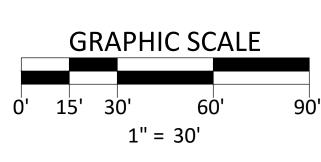

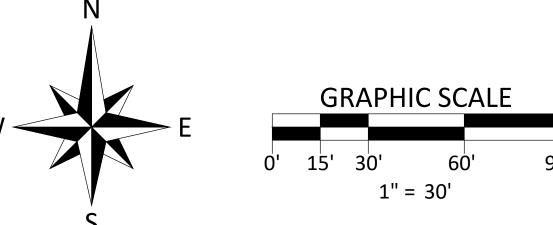

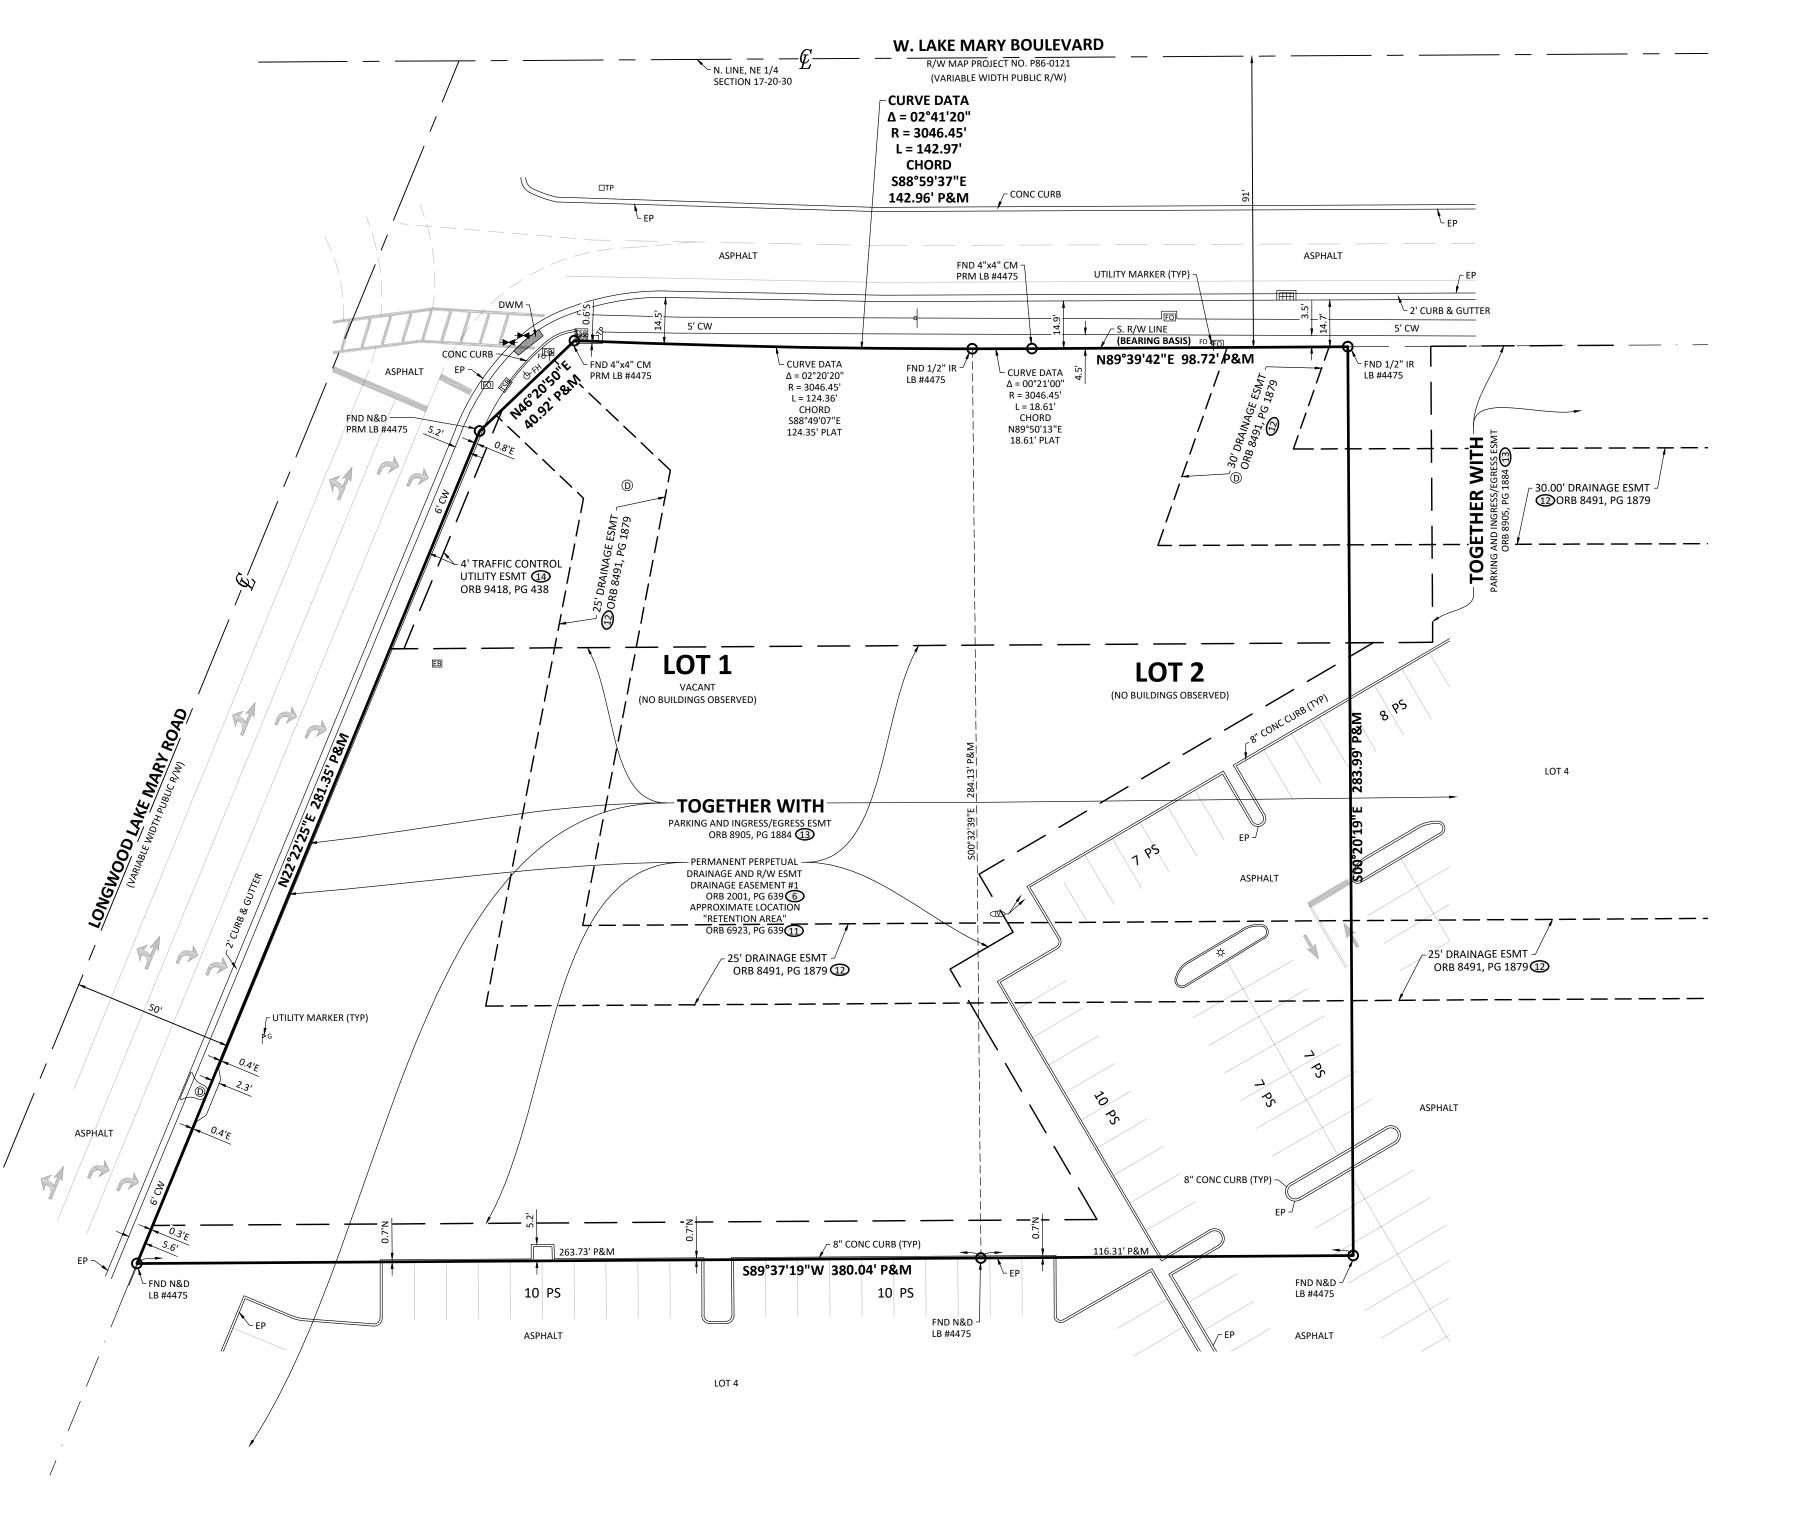



ACCURIGHT SURVEYS OF ORLANDO INC., LB 4475 2012 E. Robinson Street, Orlando, Florida 32803 www.AccurightSurveys.net ACCU@AccurightSurveys.net PHONE: (407) 894-6314

SCALE: 1" = 20' JOB #57069 SHEET 1 OF 1 DRAWN BY: SAH PREPARED FOR: OAKS OUT, LLC SUBDIVISION NAME: NICKSTE

- METAL SHED

- MITERED END SECTION

- MONITORING WELL

VERTICAL DATUM

VERTICAL DATUM

- OFFICIAL RECORDS BOOK

- POINT OF CURVATURE

- PER ENGINEERING PLANS

- POINT OF INTERSECTION

- POINT OF REVERSE

- POINT OF TANGENCY

- REINFORCED CONCRETE PIPE

- SHOWN FOR DIRECTION ONLY

- UNDERGROUND TELEPHONE

- TRANSFORMER/JUNCTION BOX

CURVATURE

AND MAPPER

- PLASTIC PIPE

- CURVE RADIUS

- RIGHT OF WAY

- SANITARY LINE

- SQUARE FEET

- SEWER VALVE

- STORM INLET

- TOP OF BANK

- TRAFFIC SIGN

- UTILITY BOX

- UTILITY POLE

- WOOD FENCE

- WATER VALVE

- WATER METER

- WATER LINE

- TELEPHONE RISER

- TRAFFIC SIGNAL BOX

- UTILITY EASEMENT

- UTILITY MARKER

- SANITARY MANHOLE

- STORM/DRAIN LINE

- STORM MANHOLE

- POINT OF COMMENCEMENT

- NON-TANGENT

- OVERHEAD WIRE

- PLASTIC FENCE

- PLAT BOOK

- BOTTOM OF BANK MEAS - MEASURED - BACK FLOW PREVENTER MF - METAL FENCE - BENCHMARK - BOLLARD - BURIED ELECTRIC BARBED WIRE FENCE - CABLE TV RISER NAVD - NORTH AMERICAN - BURIED CABLE TV NGVD - NATIONAL GEODETIC - CENTRAL ANGLE CBW - CONCRETE BLOCK WALL **COVERED CONCRETE** - CERTIFIED CORNER RECOR - CONCRETE FLUME CHW - CONCRETE HEAD WAL - CHAIN LINK FENCE - CENTERLINE - CONCRETE MONUMENT CMP - CORRUGATED METAL PIPE ∘CO - CLEAN OUT CONC - CONCRETE P&M - PLAT & MEASURED POB - POINT OF BEGINNING - CONCRETE PAD CW - CONCRETE WALKWAY D&M - DEED/DESC & MEASURED - DRAINAGE FASEMENT # PS - PARKING SPACES PSM - PROFESSIONAL SURVEYOR DESC - DESCRIPTION - DOT INLET DOC# - DOCUMENT# - DUMPSTER PAI DWM - DETECTABLE WARNING MAT - EASEMENT NUMBER - ELECTRIC METER - ELECTRICAL BOX ESMT - EASEMENT SWF - STOCK WIRE FENCE EP - EDGE OF PAVEMEN x00.00 - SPOT ELEVATION FDC - FIRE DEPARTMENT CONNECTION FIRM - FLOOD INSURANCE - FINISHED FLOOR ELEVATION ტ-FH - FIRE HYDRANT -FM- - FORCE MAIN FND - FOUND

- FIBER OPTIC LINI

- GAS LINE

HDPE - HIGH DENSITY

- IRON ROD

(V)

- GAS METER

- GAS VALVE

- GREASE TRAP

POLYETHYLENE

- INVERT ELEVATION

- IRRIGATION VALVE

- LICENSED BUSINESS

- LICENSE SURVEYOR

ARC LENGTH

- LIGHT POLE - LANDSCAPE AREA

- GUY WIRE ANCHOR

- HANDICAP PARKING

3037 W LAKE MARY BLVD

LAKE MARY, FL 32746

SURVEY DATE: 6/8/23

DATE:	JOB#	REVISION	BY:

BOUNDARY SURVEY

OAKS OUT, LLC, A FLORIDA LIMITED LIABILITY COMPANY; CHICAGO TITLE INSURANCE COMPANY; FASSETT, ANTHONY & TAYLOR, P.A.; SOUTHSTATE BANK, N.A., ISAOA ATIMA

RONALD K. SMITH, PSM 5797 "THE DATE OF SIGNATURE DOES NOT REVISE OR SUPERSEDE THE SURVEY DATE OR REVISION DATE."

THIS SURVEY MEETS THE "STANDARDS OF PRACTICE" AS REQUIRED BY CHAPTER 5J-17 FLORIDA BOARD OF LAND SURVEYORS, PURSUANT TO SECTION 472.027 OF THE FLORIDA STATUTES.

"NOT VALID WITHOUT THE ORIGINAL SIGNATURE AND SEAL OF THIS FLORIDA LICENSED SURVEYOR AND MAPPER." -OR-THE DIGITAL SEAL APPEARING ON THIS DOCUMENT WAS AUTHORIZED BY RONALD K. SMITH. PSM 5797.

S:\SEMINOLE\SC88-21 - NICKSTE\1 & 2\SC88-21LOTS1&2.dwg - Jun 12, 2023 CF# SC88-21LOTS1&2 COPYRIGHT © 1986 - 2023, ACCURIGHT SURVEYS