
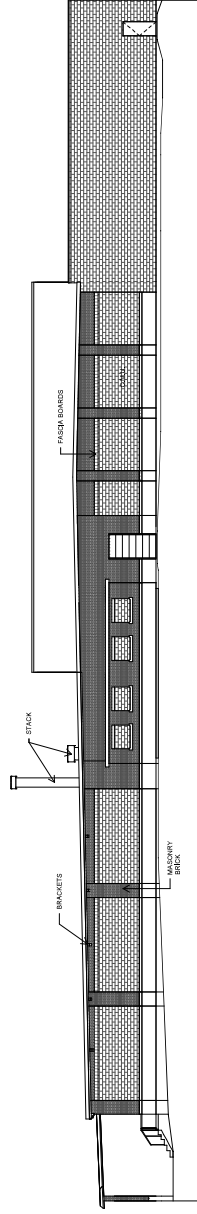
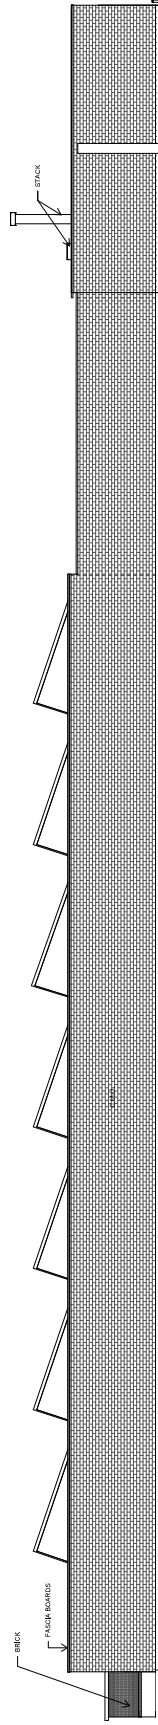


① $\frac{\text{Front Elevation}}{3'32"} = 1'-0"$


$$\textcircled{2} \frac{\text{Right Elevation}}{3'37" = 1'-0"}$$


③ Rear Elevation
3'3 1/2" = 1'-0"

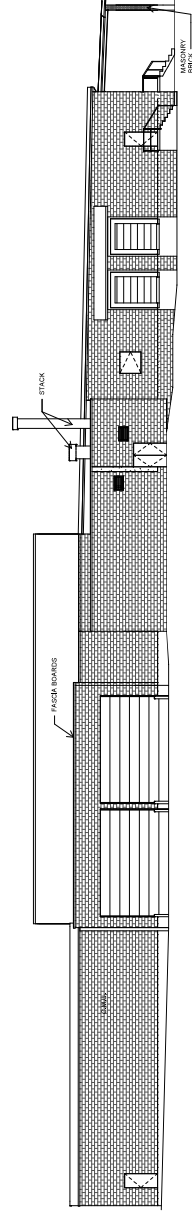

④ Left Elevation
3'32" = 1'-0"

Benny's Complex

Building 19
340 Waterman Avenue
Smithfield, RI 02917

**EXISTING
CONDITIONS**

Call us at: (617) 247 9161
info@existingconditions.com
www.existingconditions.com

**The Most Accurate
Existing Conditions Surveys and
As-Built Surveys™**

All projects are measured using the most advanced laser measuring equipment and our best standards and practices.

[illegible]

Revision Schedule		
Revision Number	Revision Description	Revision Date

Existing Exterior Elevations

Date: 6/1/2024	EX06
Scale: 3/32" = 1'-0"	
Drawn By: EC	