

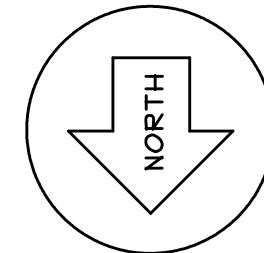
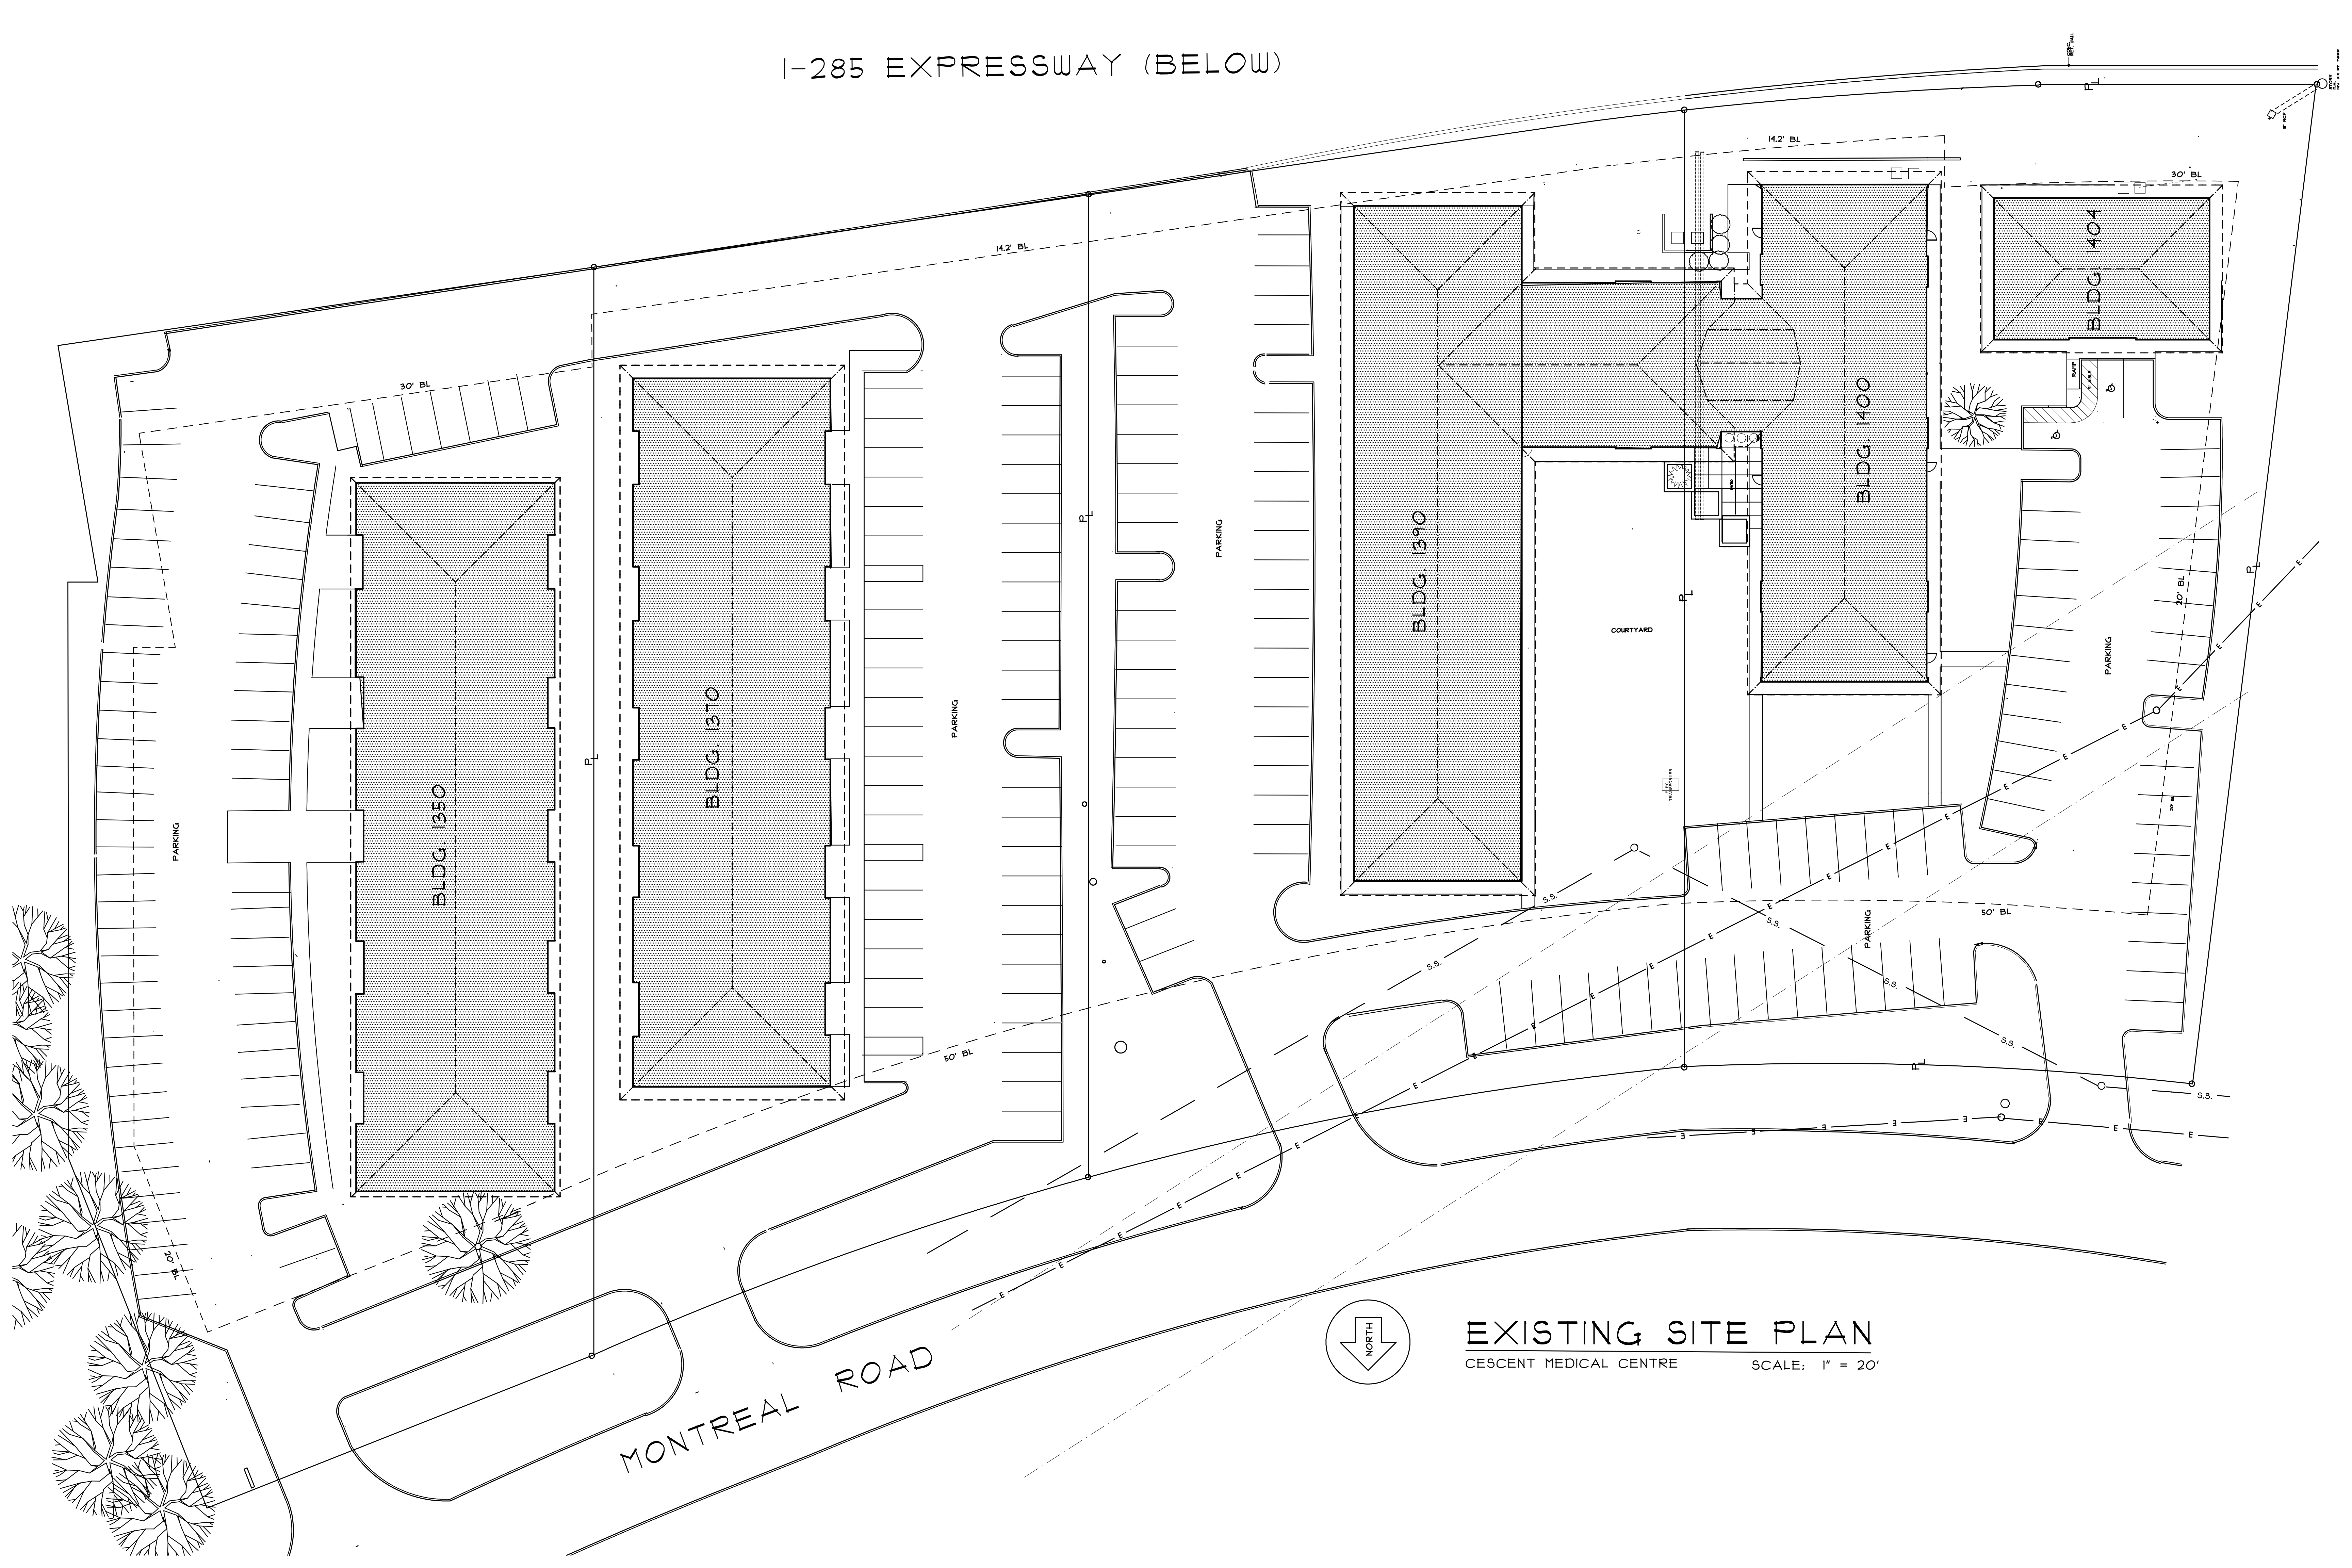


I-285 EXPRESSWAY (BELOW)

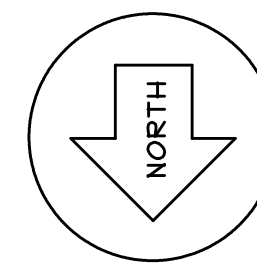

EXISTING SITE PLAN
CESCENT MEDICAL CENTRE
SCALE: 1" = 20'


1-285 EXPRESSWAY (BELOW)

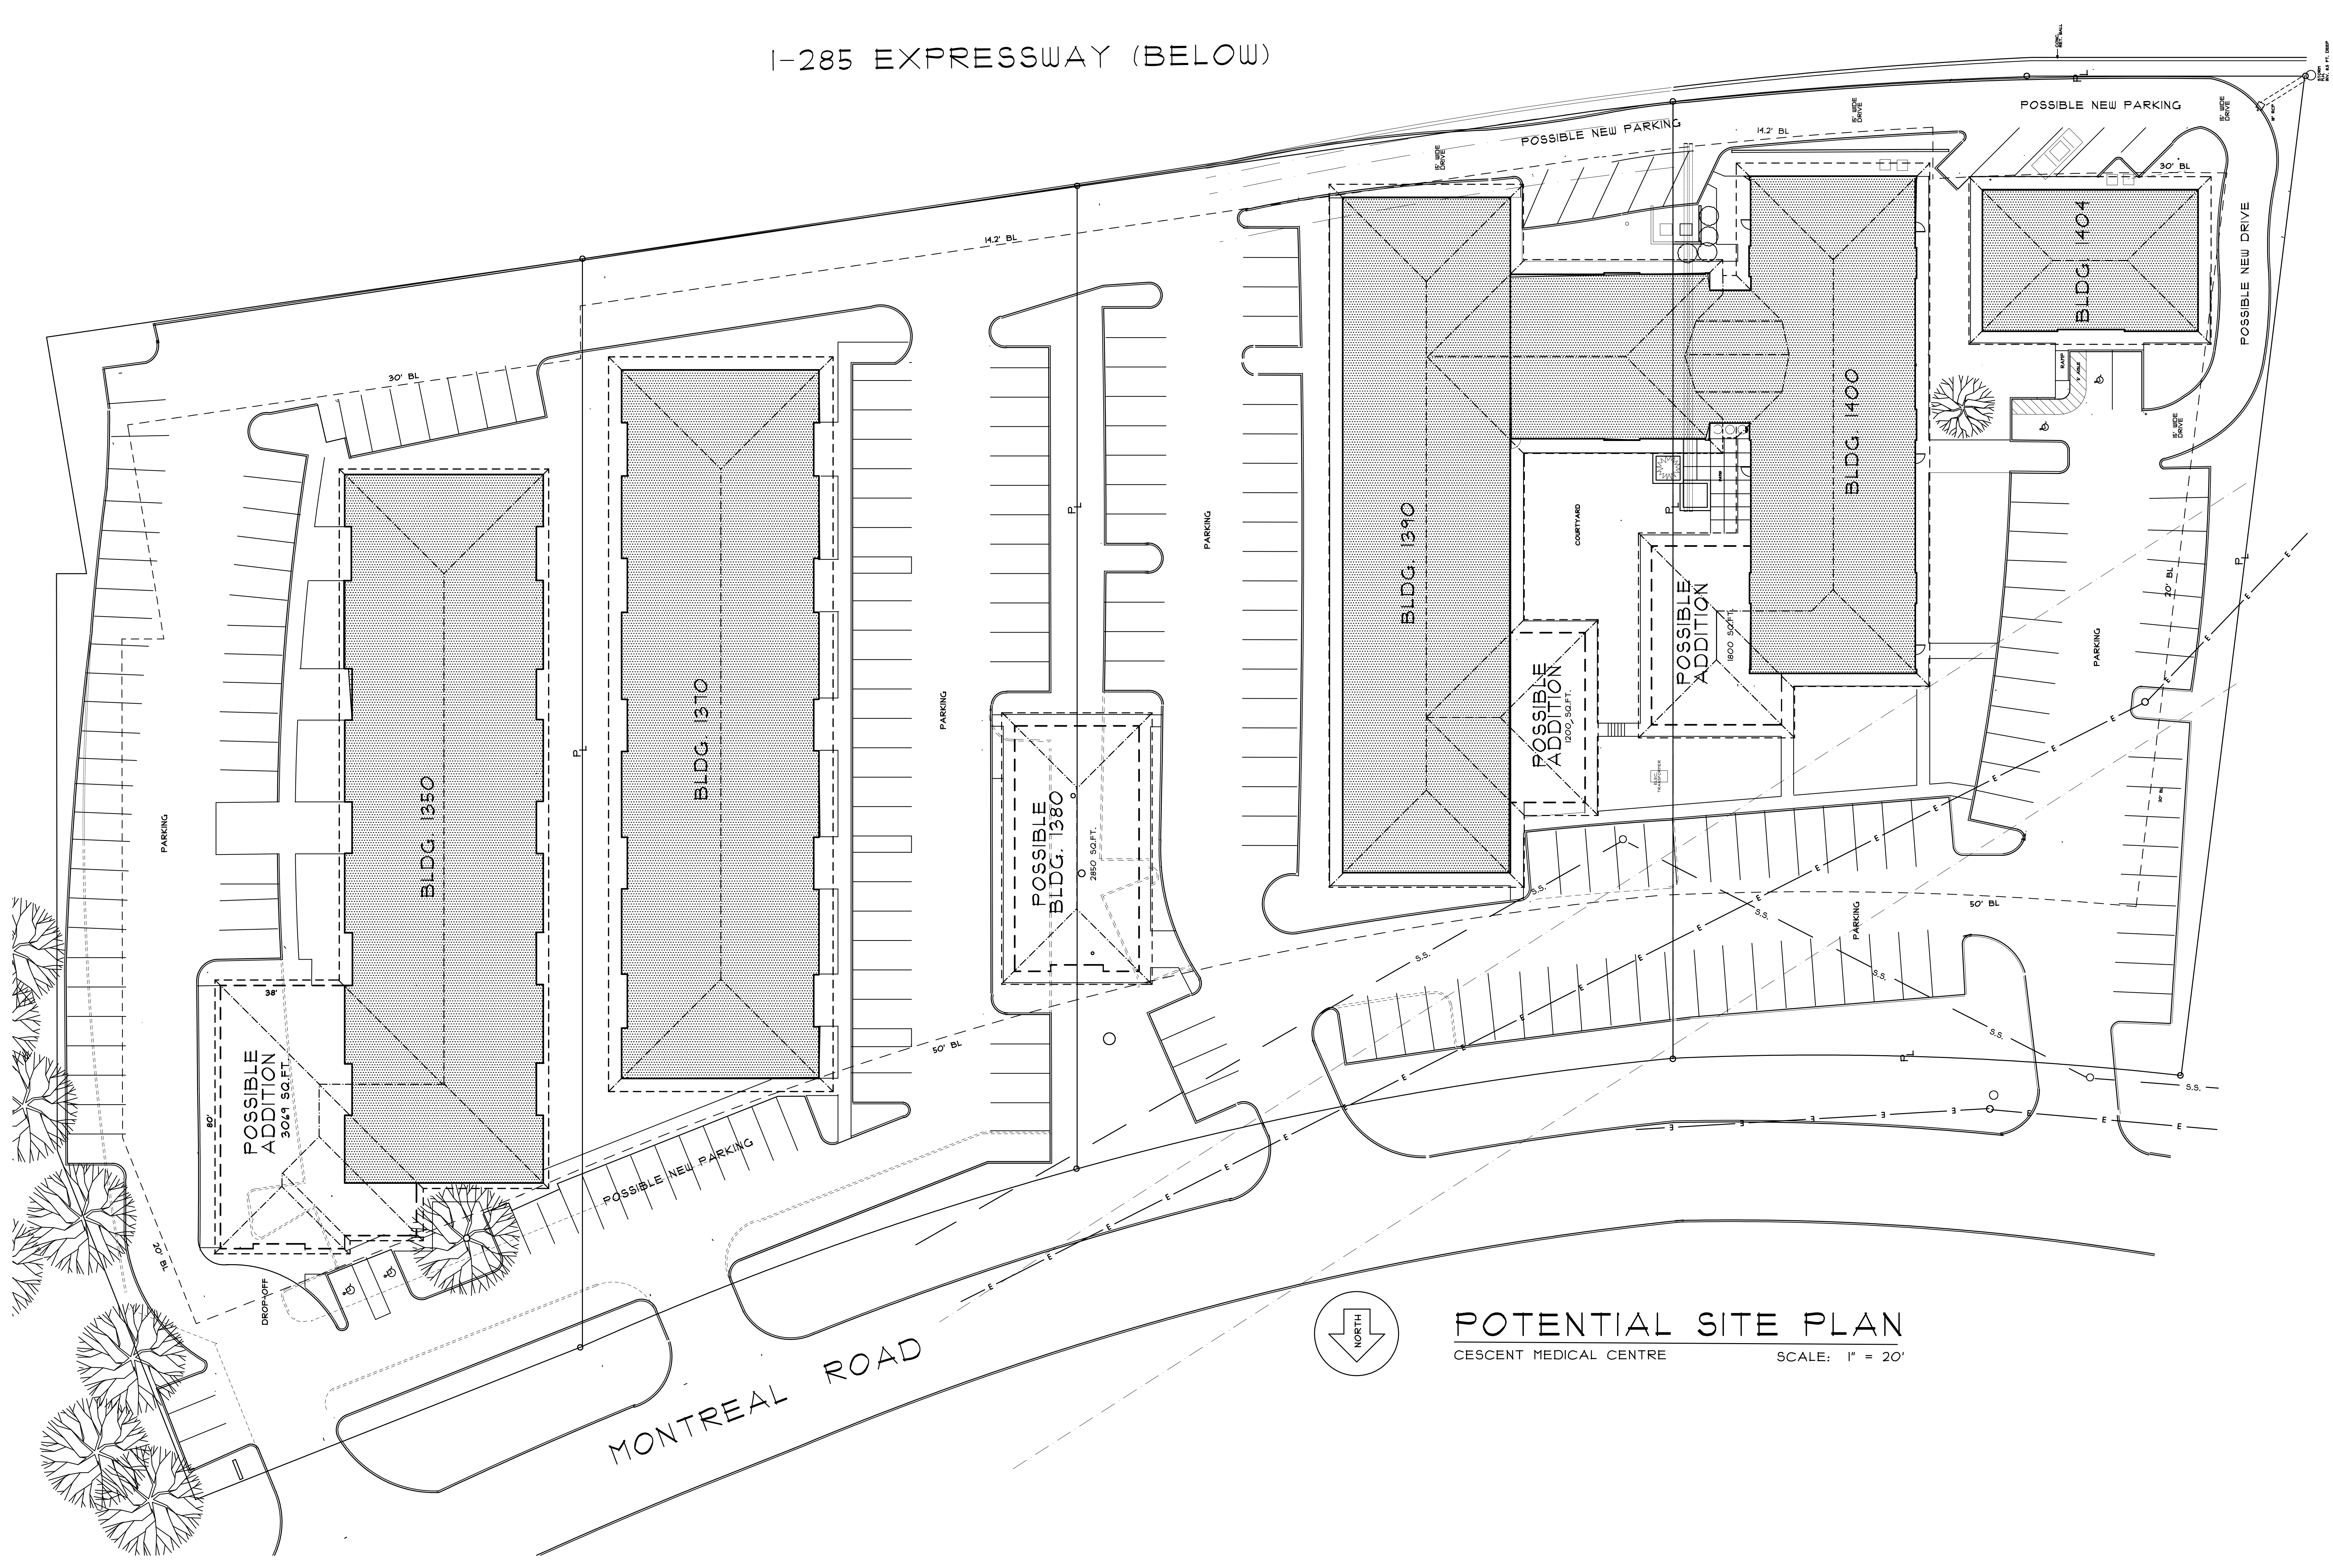


POTENTIAL SITE PLAN

CESCENT MEDICAL CENTRE

SCALE: 1" = 20'

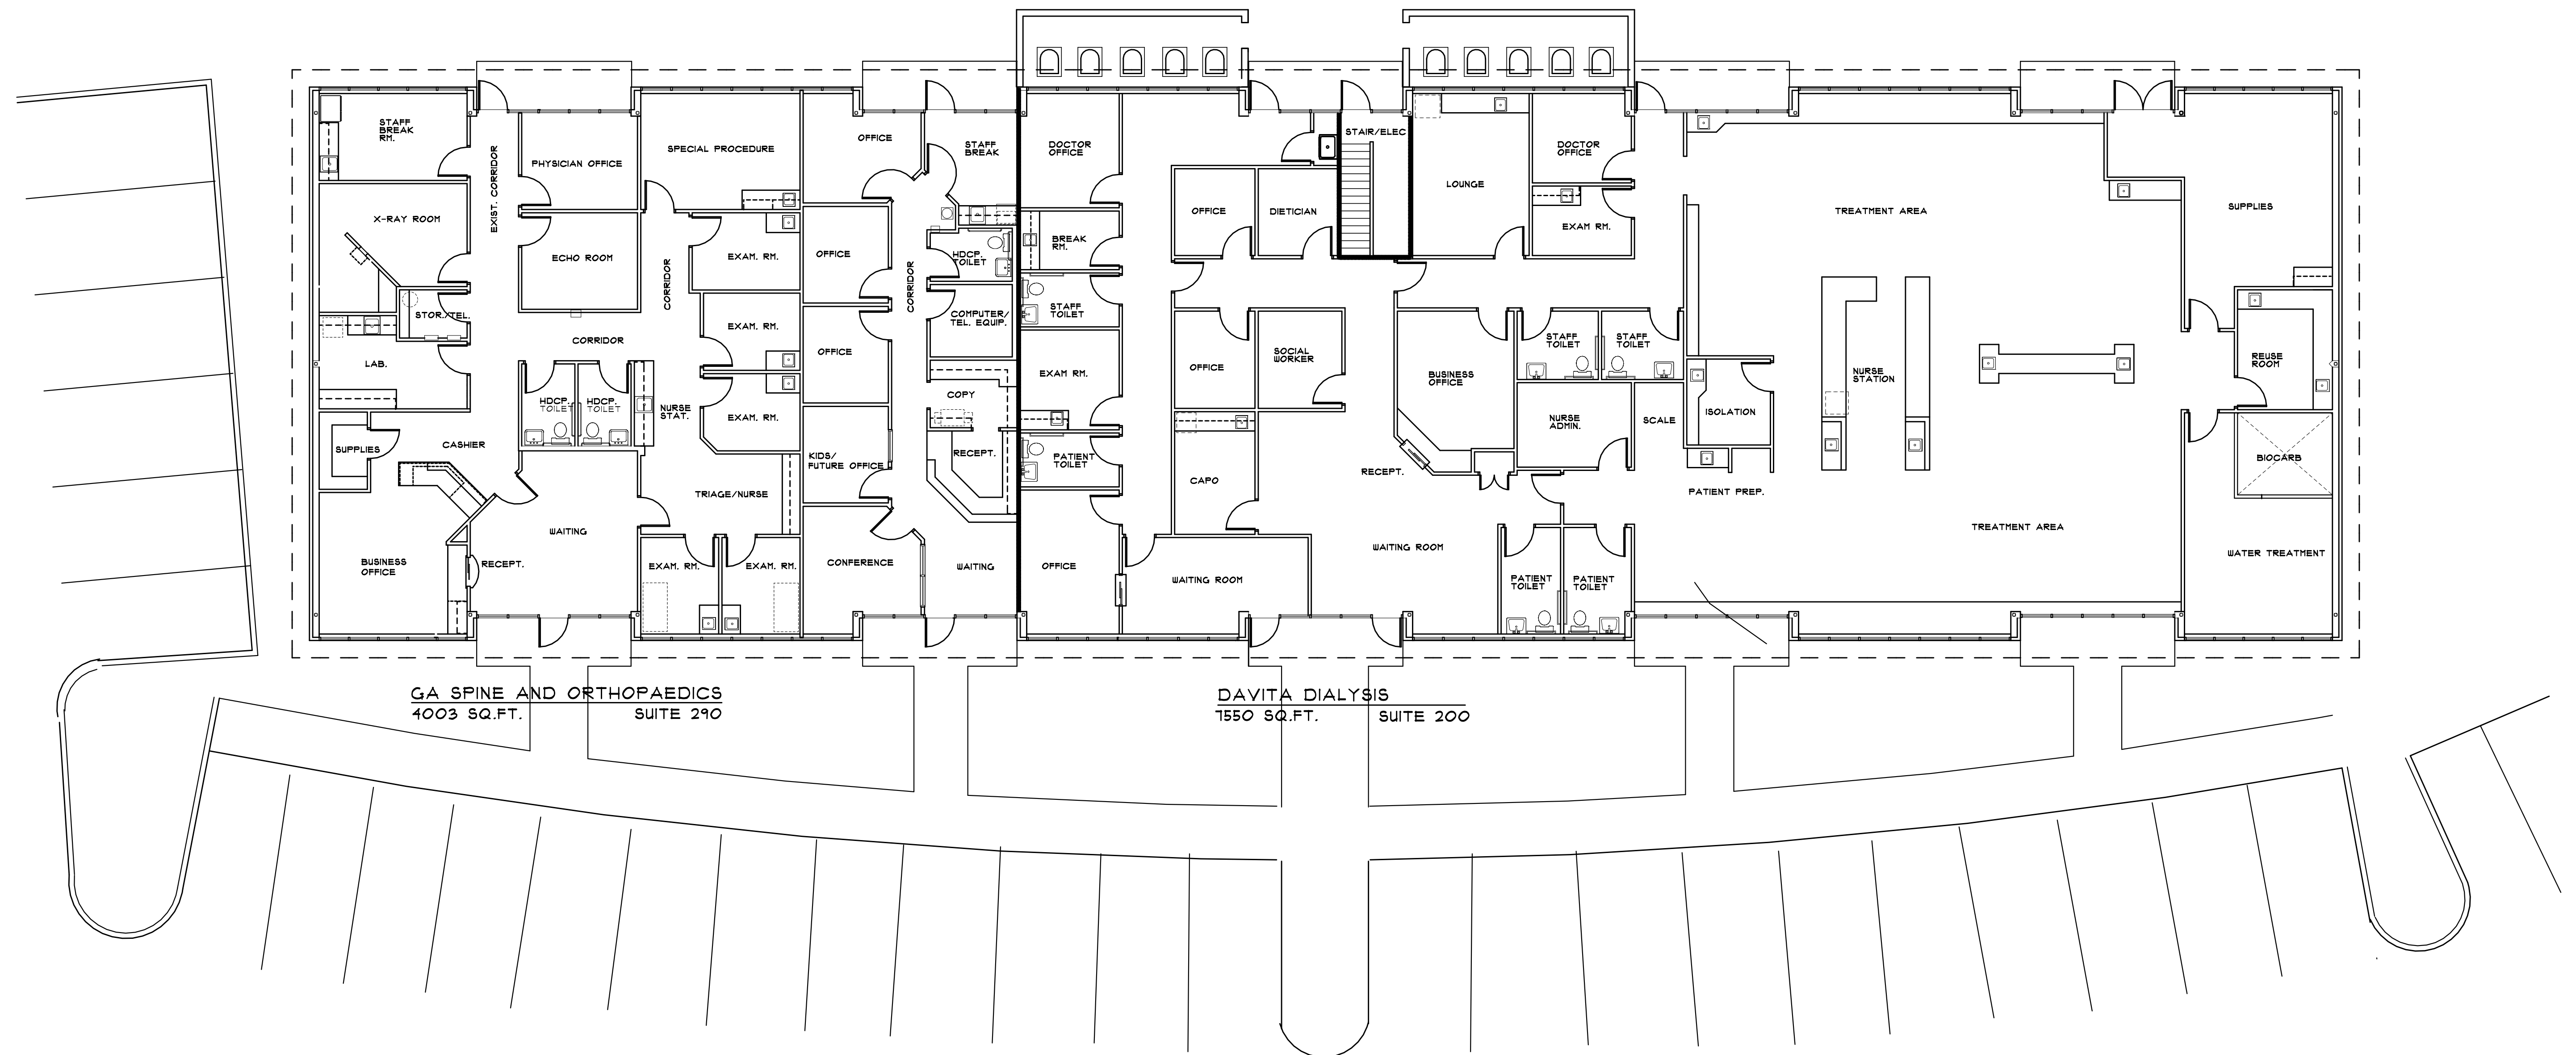

BUILDING 1350 AS-BUILT PLAN
 CRESCENT MEDICAL CENTRE SCALE: 1/8" = 1'-0"

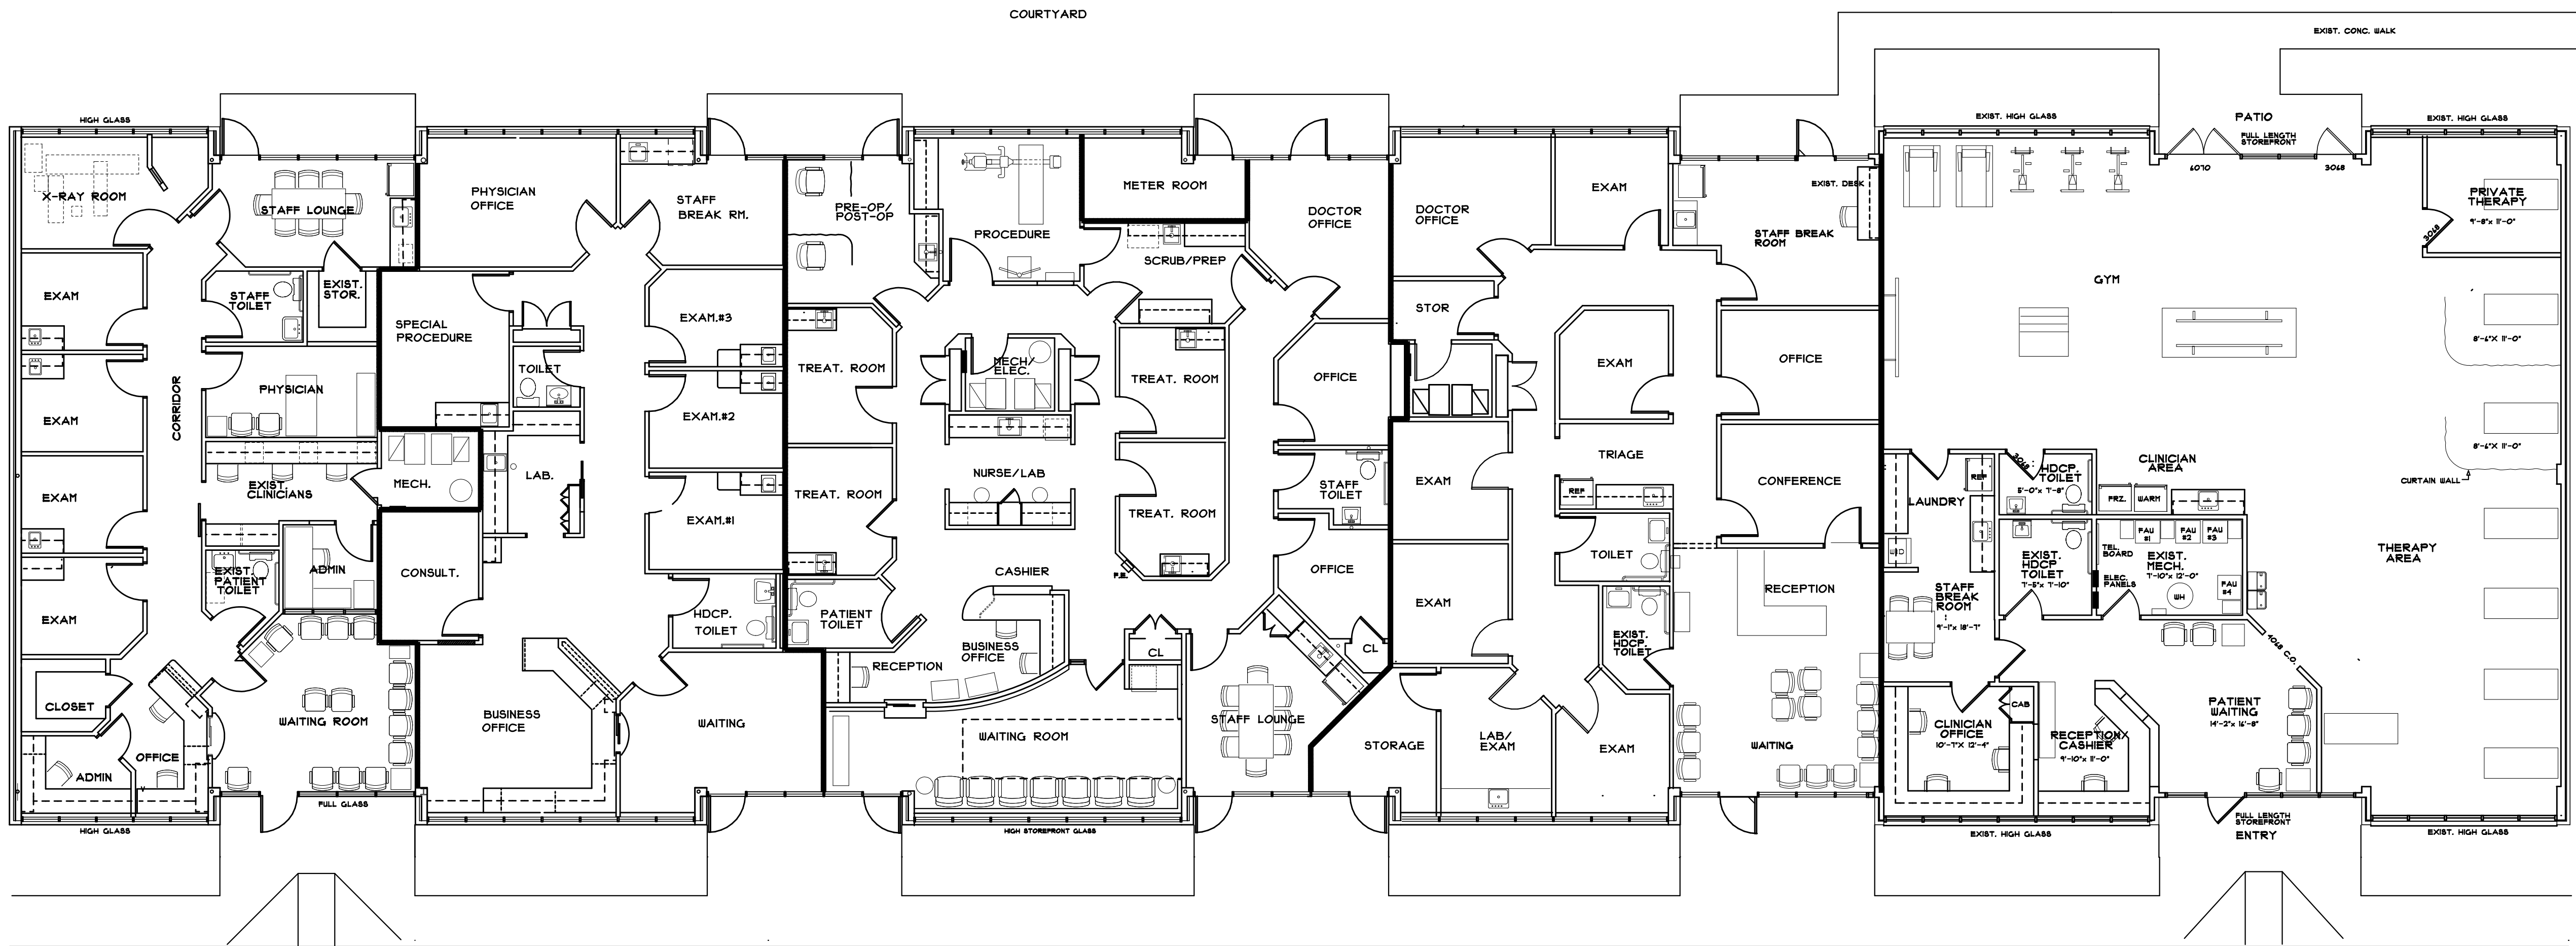

DR. KARSH ORTHOPAEDICS
1675 SQ.FT. SUITE 185

DR. JONES OBGYN
1675 SQ.FT. SUITE 170


DR. OMAR OLYMPUS MD
2650 SQ.FT. SUITE 130

DECATUR HEALTH & WELLNESS
2212 SQ.FT. SUITE 112

TEAM REHAB PHYS THERAPY
3000 SQ.FT. SUITE 100

BUILDING 1370 AS-BUILT PLAN

CRESCENT MEDICAL CENTER SCALE 1/8" = 1'-0"

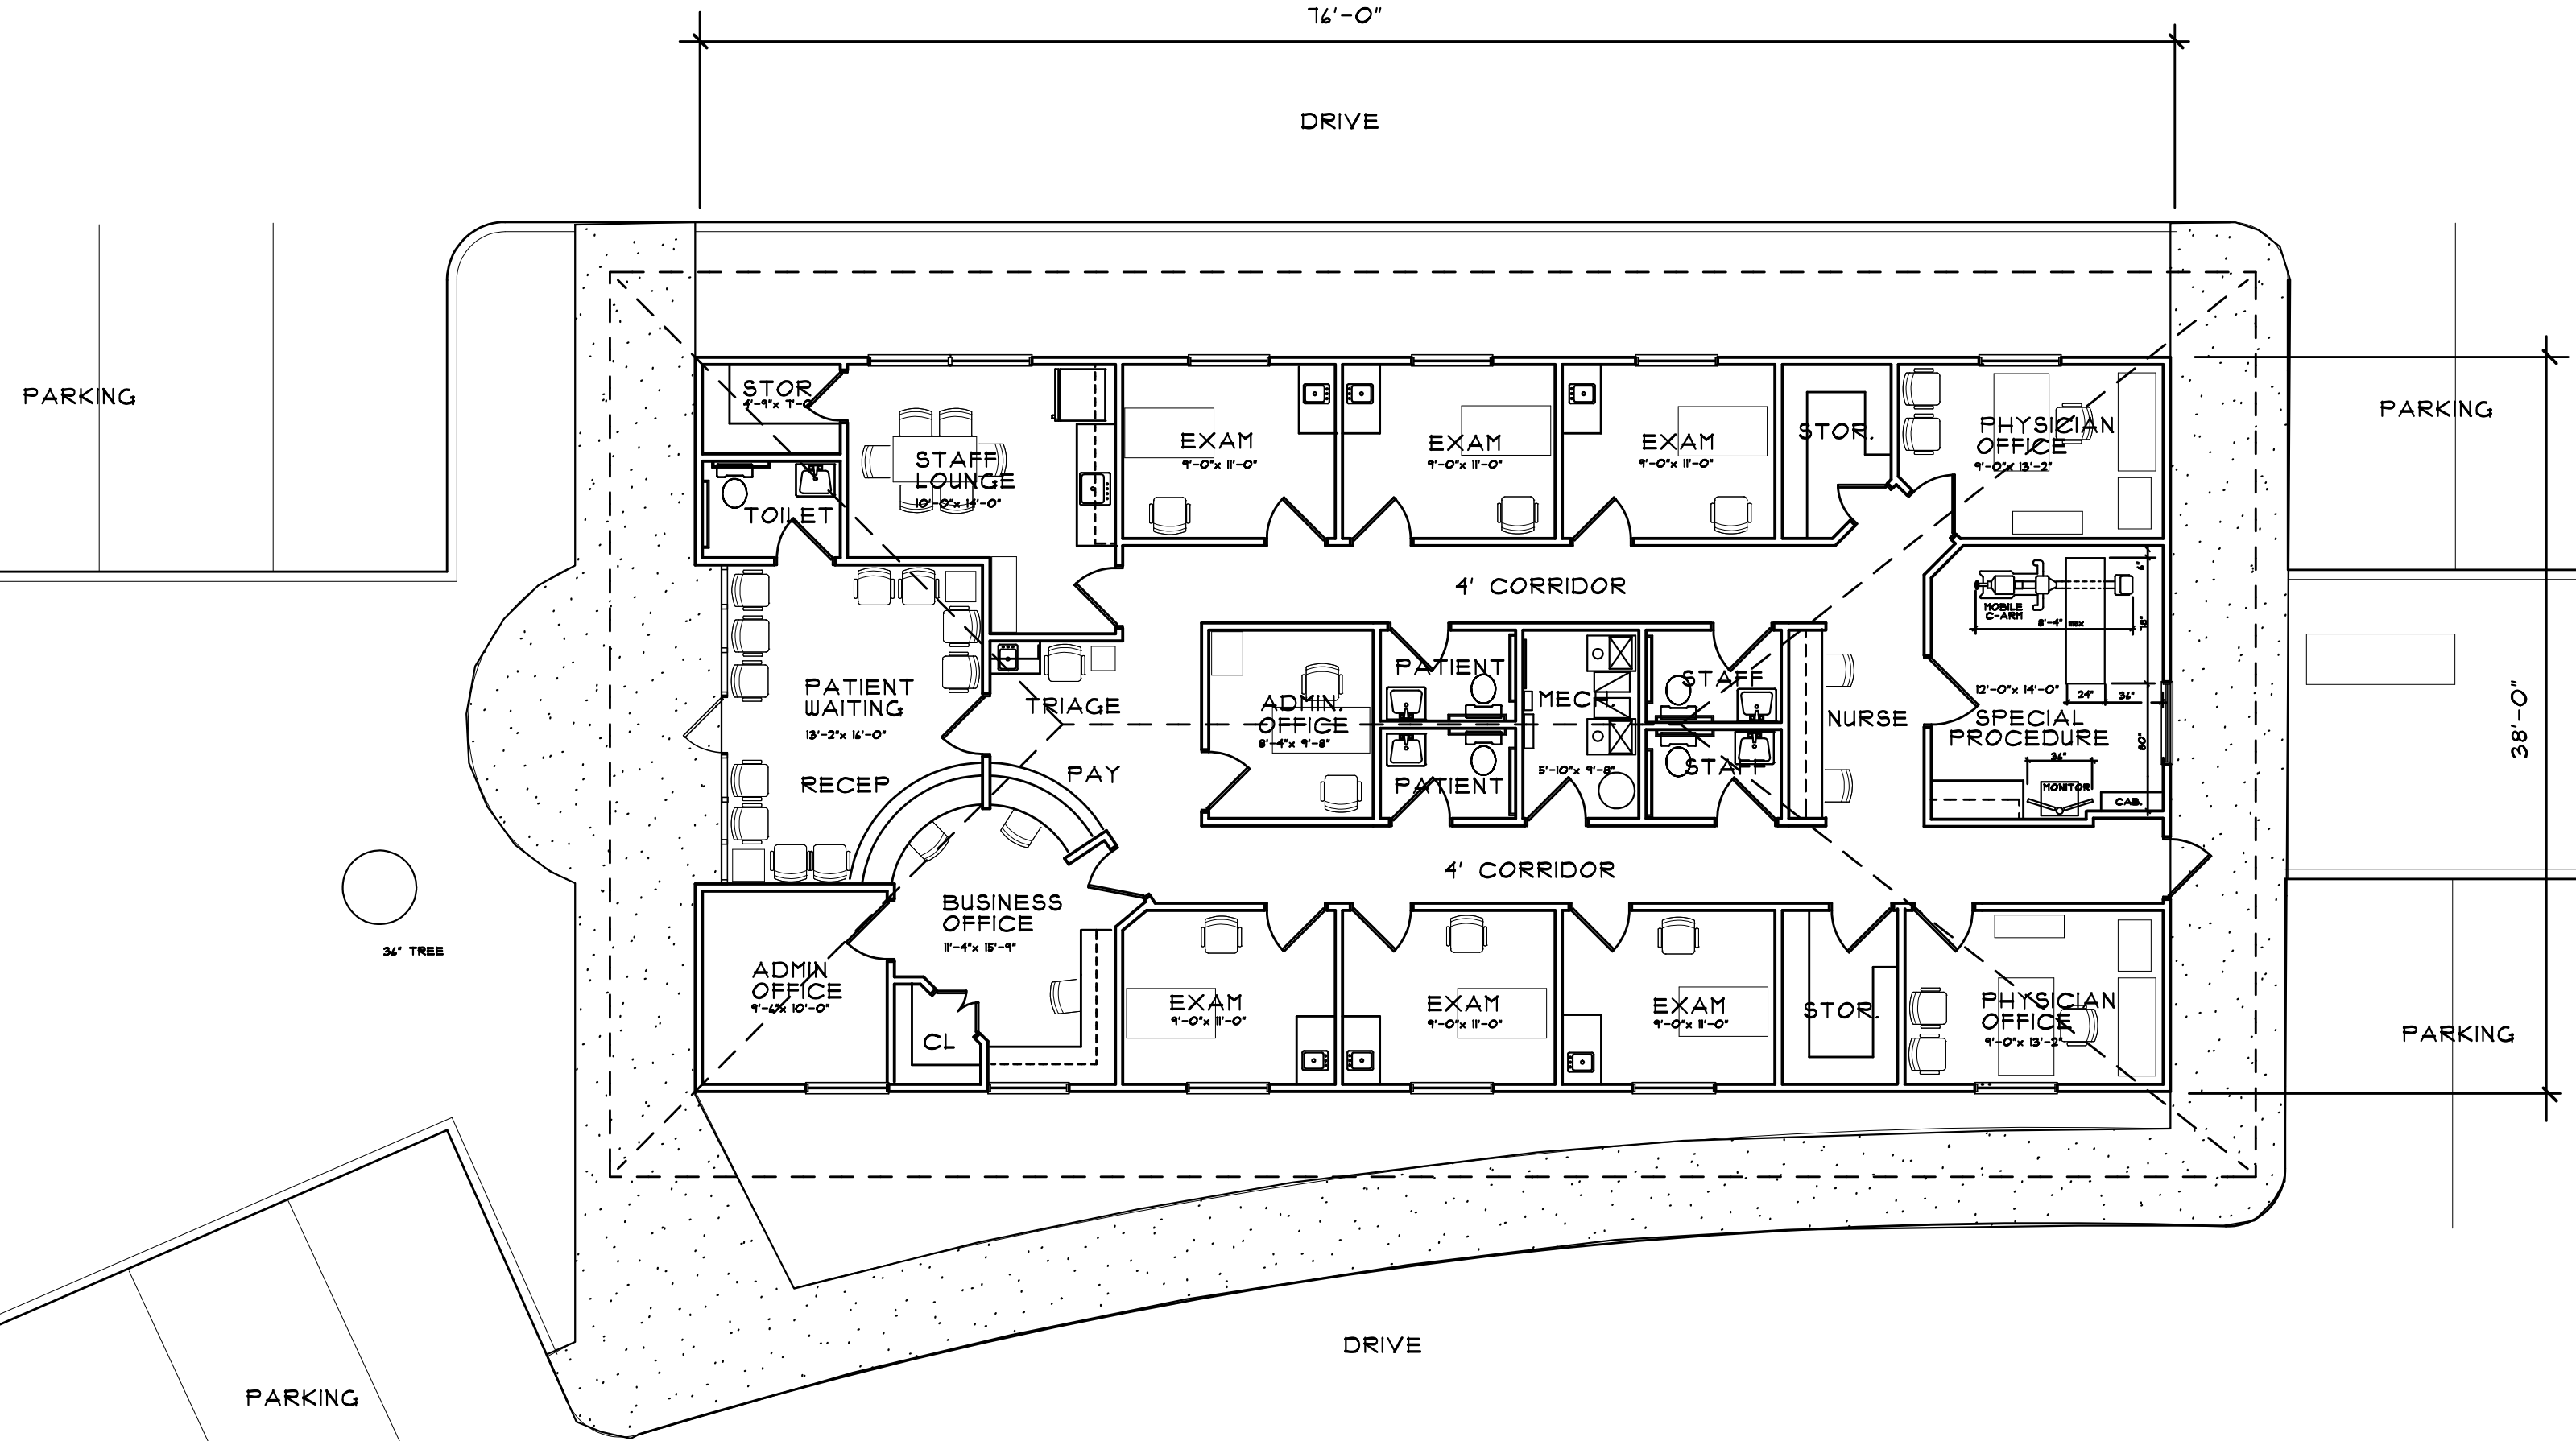


1380 BLDG. GENERIC 2 DOC SUITE

1/8"=1'-0"

2861 SQ.FT.

BLDG. 1390

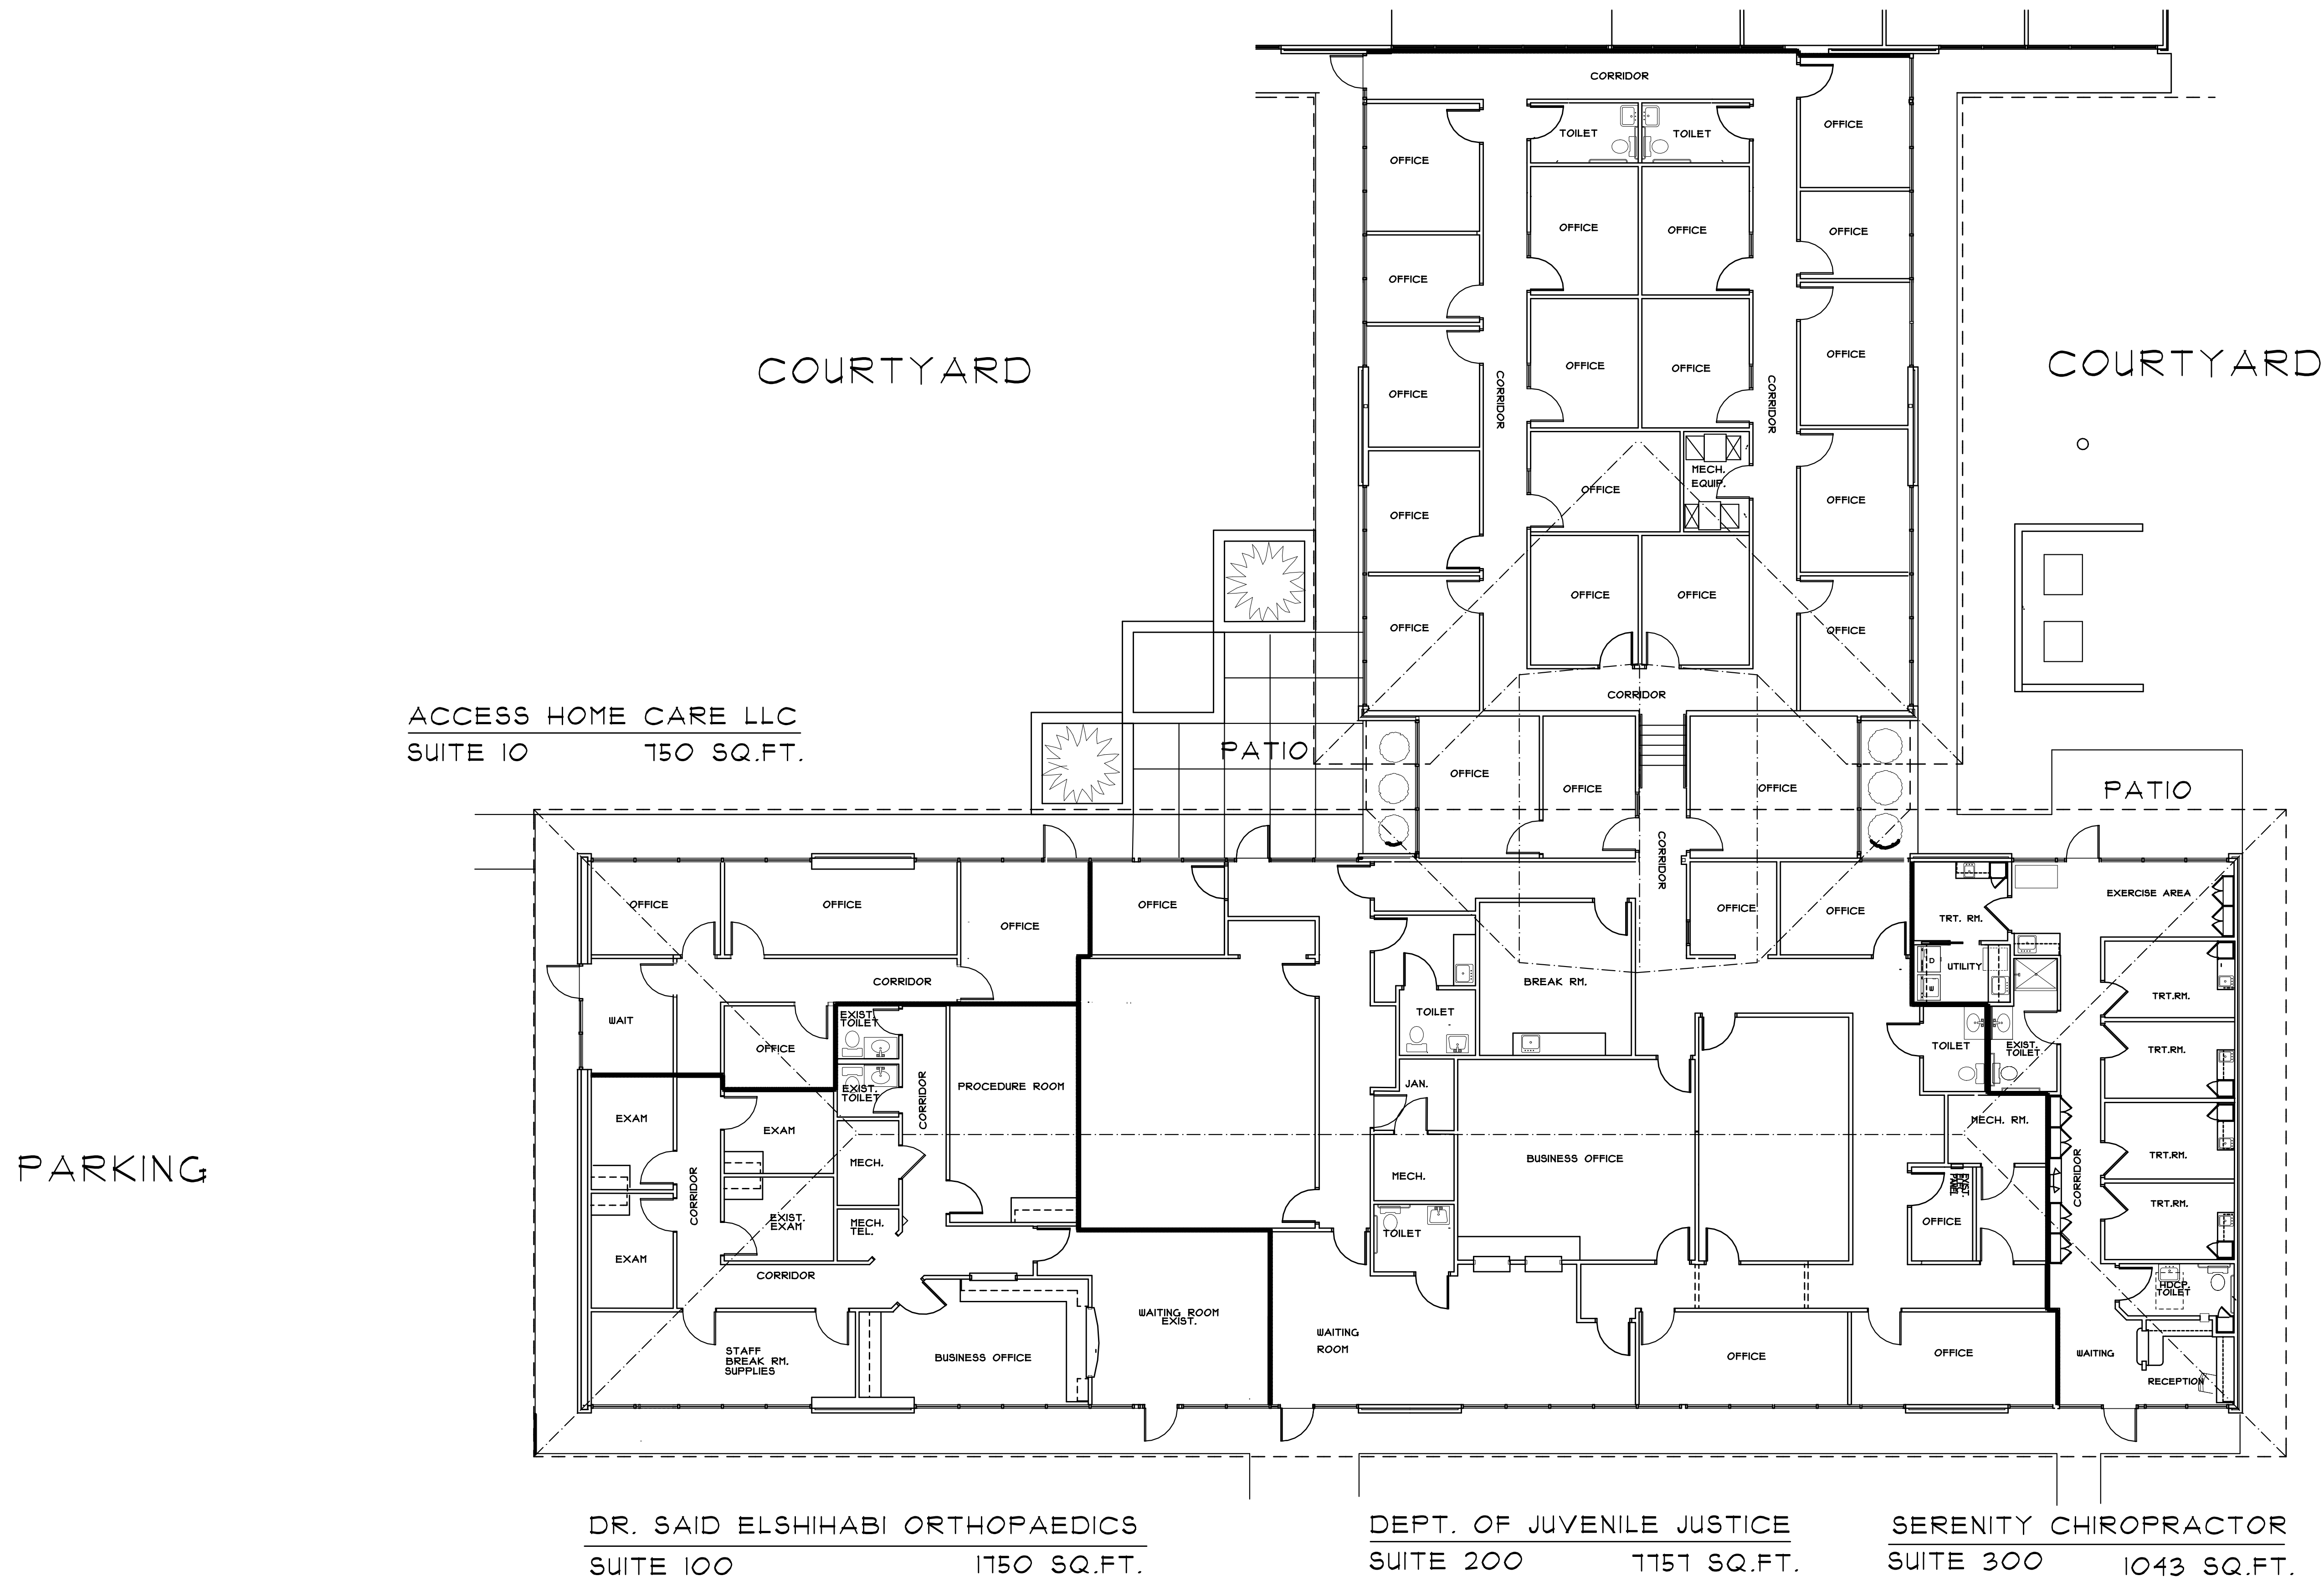


I-285

BUILDING 1400 and ANNEX AS-BUILT PLAN


CESCENT MEDICAL CENTRE

SCALE: 1/8" = 1'-0"

PARKING

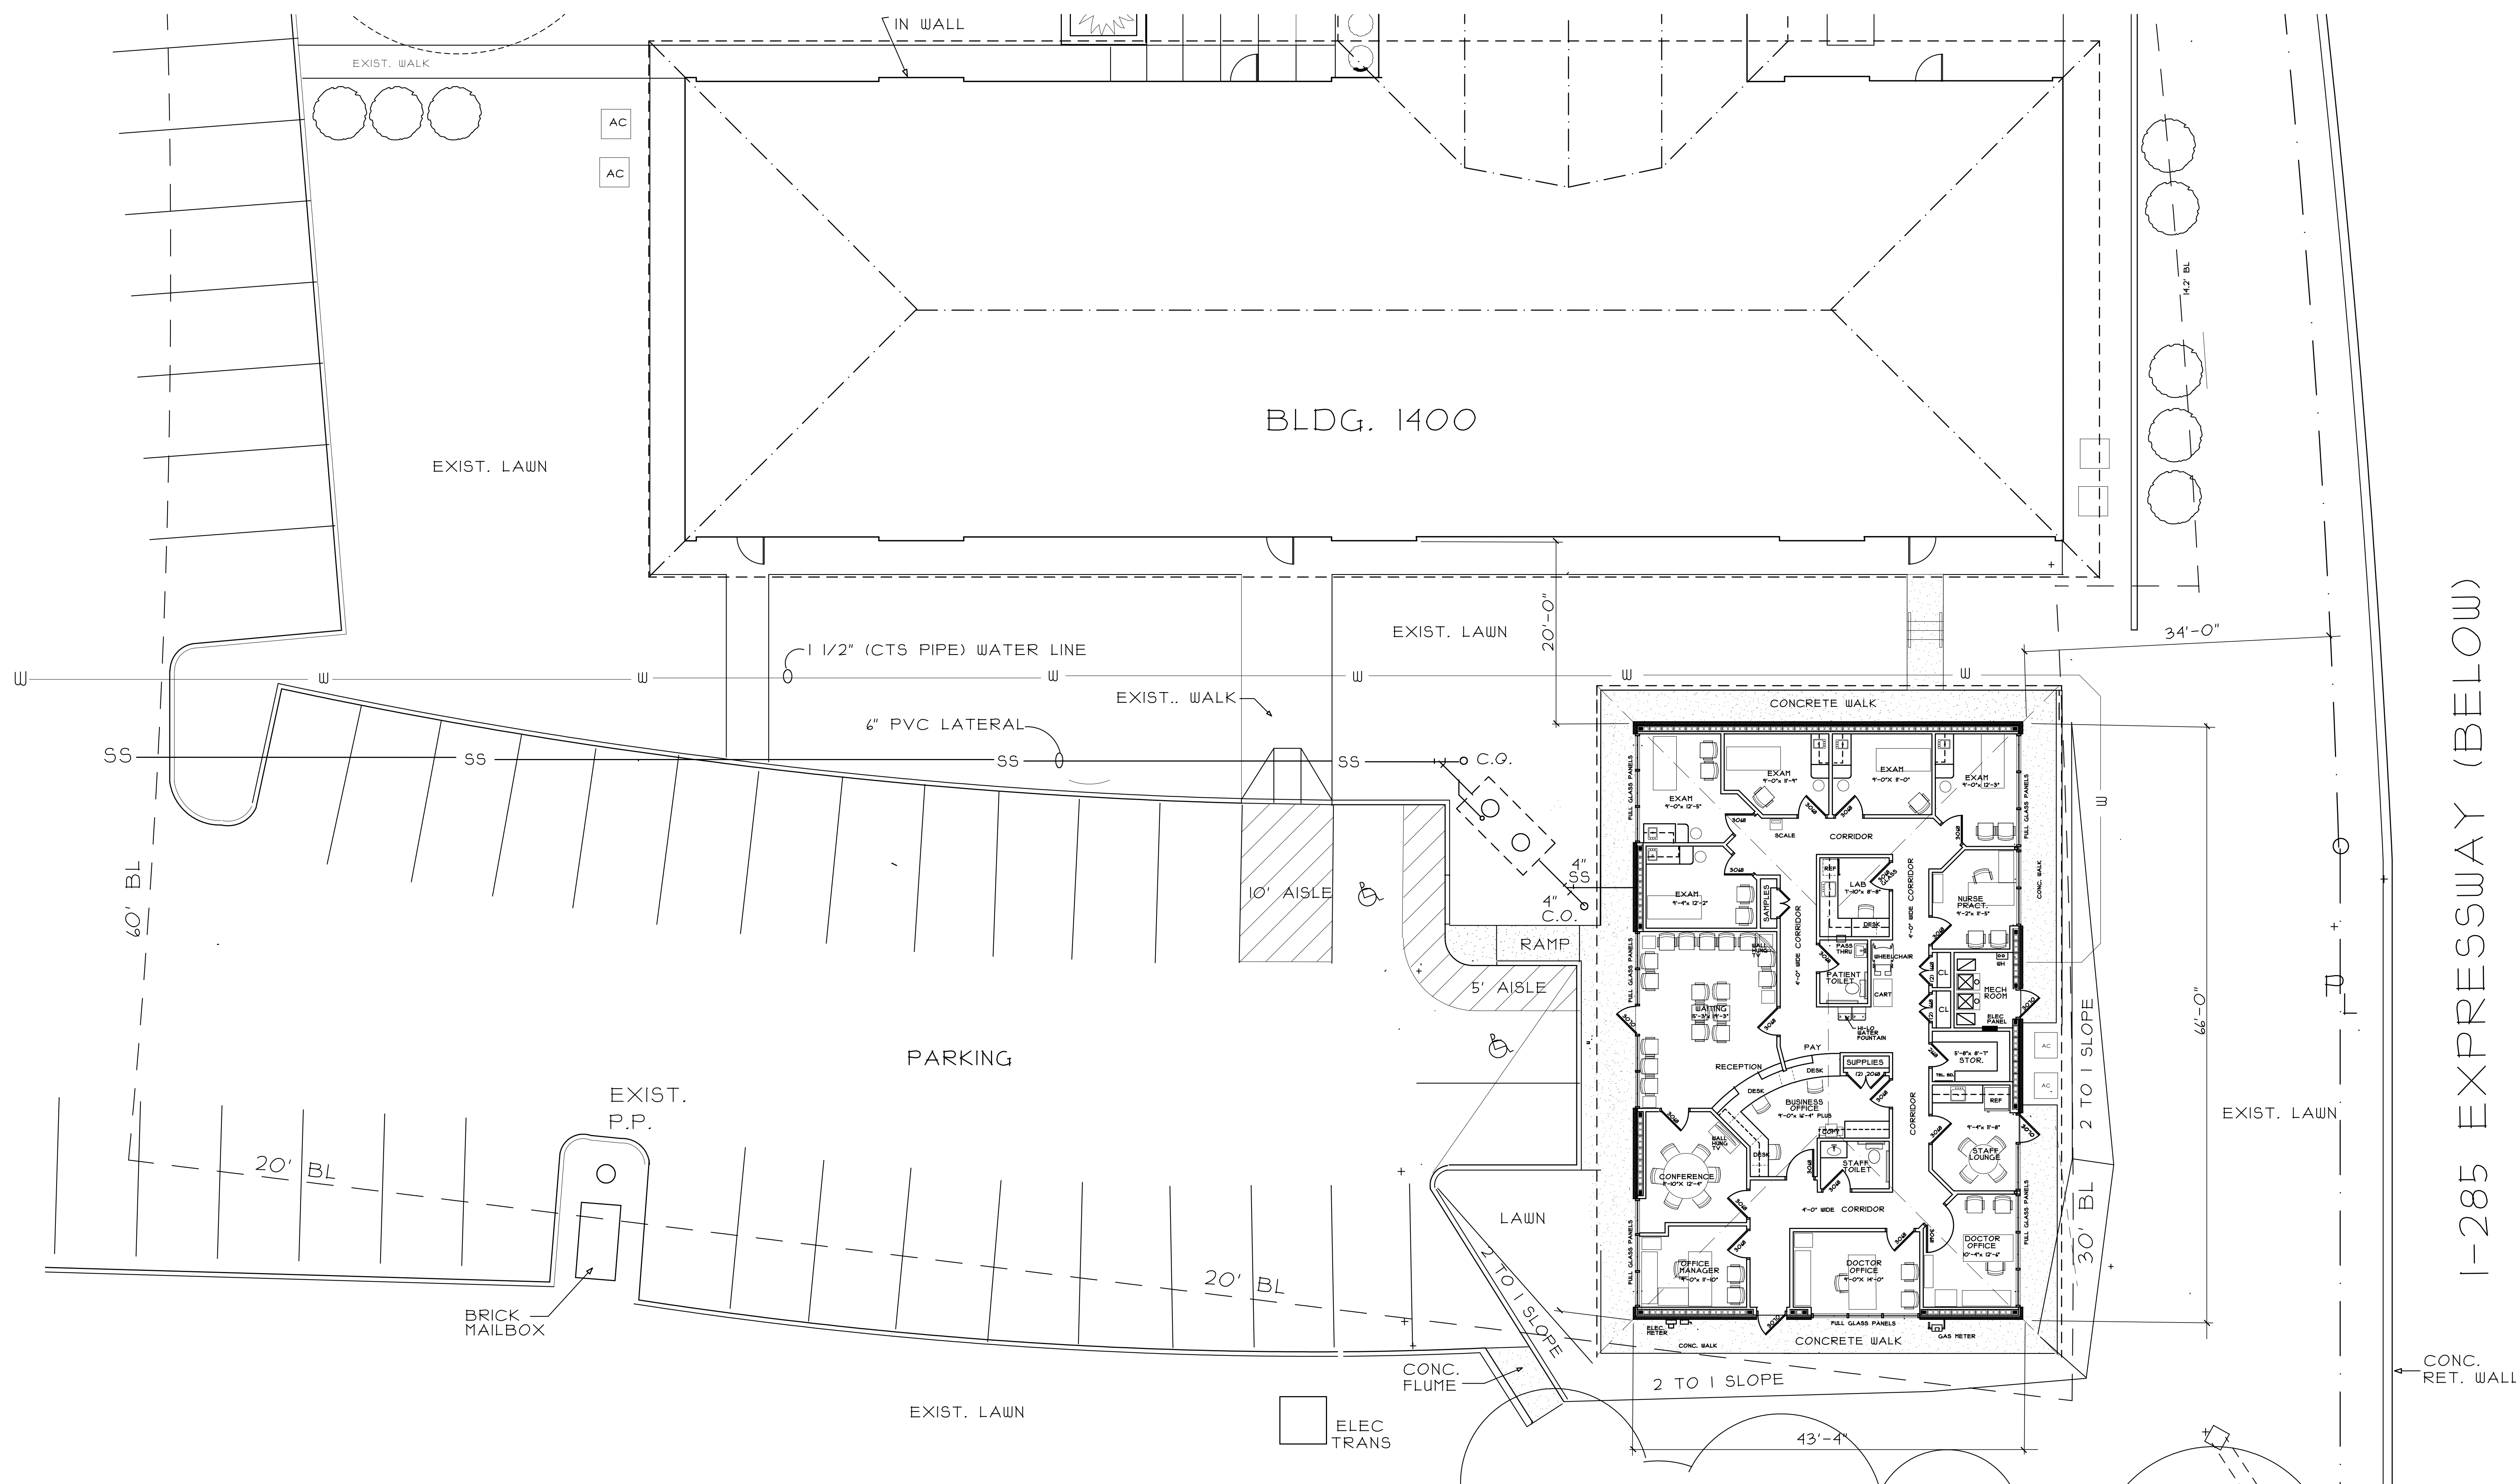

SCALE: 1/8" = 1'-0"

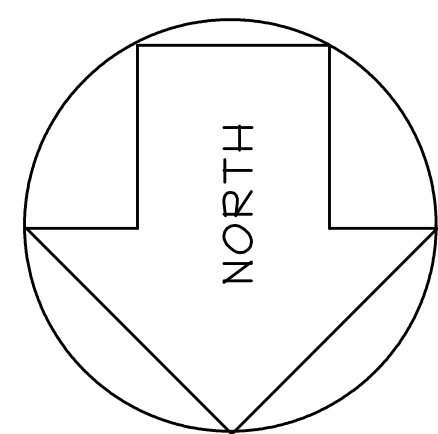

BUILDING 1404 MIDHA FAMILY MEDICINE

CESCENT MEDICAL CENTRE

2689 SQ. FT.

STORM
M.H.
INV. 8.5 FT. DEEP


I-285 EXPRESSWAY (BELOW)

PARKING

CMC 1390 DENTAL
2124 SQ.FT. SUITE 115

DEKALB PEDIATRICS
3150 SQ.FT. SUITE 180

ENT and VOICE CARE of ATLANTA
3418 SQ.FT. SUITE 120

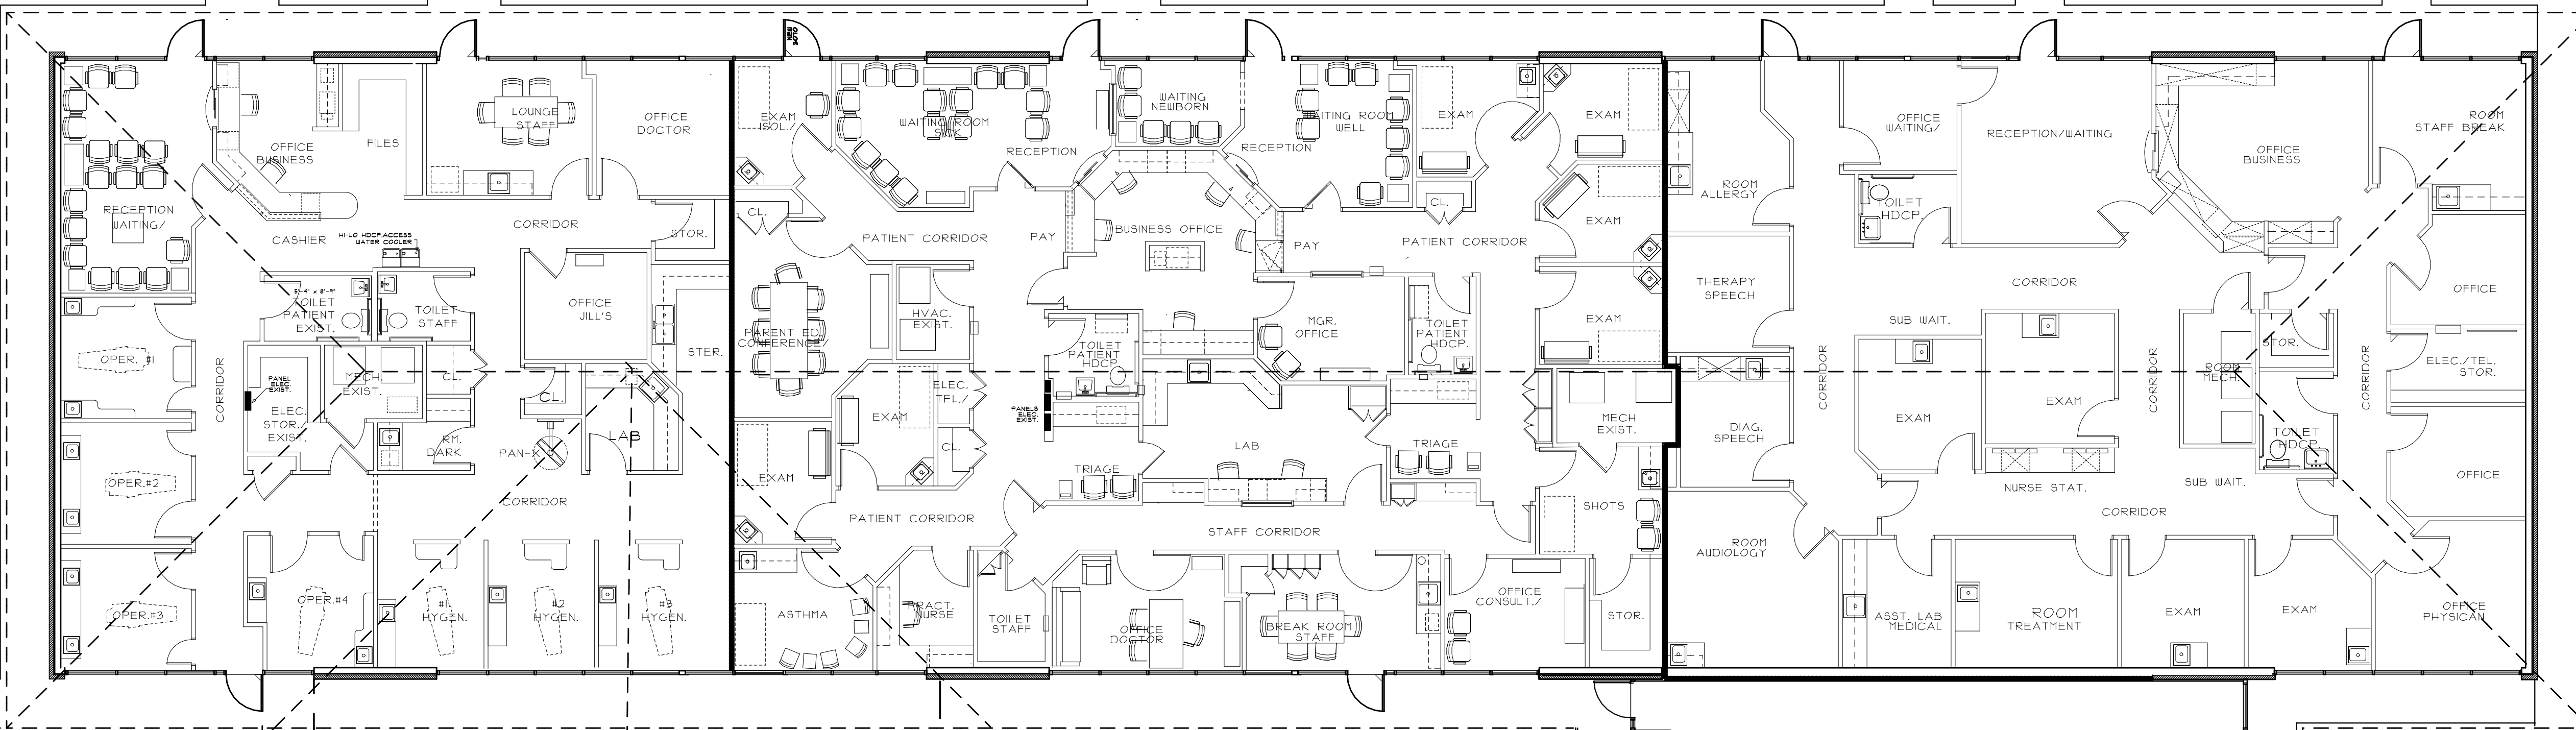

BLDG. 1400
ANNEX

PARKING

(5) POTENTIAL
NEW SPACES

1560 sq. ft.
POTENTIAL
ADDITION

COURTYARD

COURTYARD

PROPERTY LINE

BUILDING 1390 AS-BUILT PLAN

CESCENT MEDICAL CENTRE

SCALE: 1/8" = 1'-0"