


# AREA TABULATION

UNIT 155 LEASABLE SPACE =

2689 S.F.

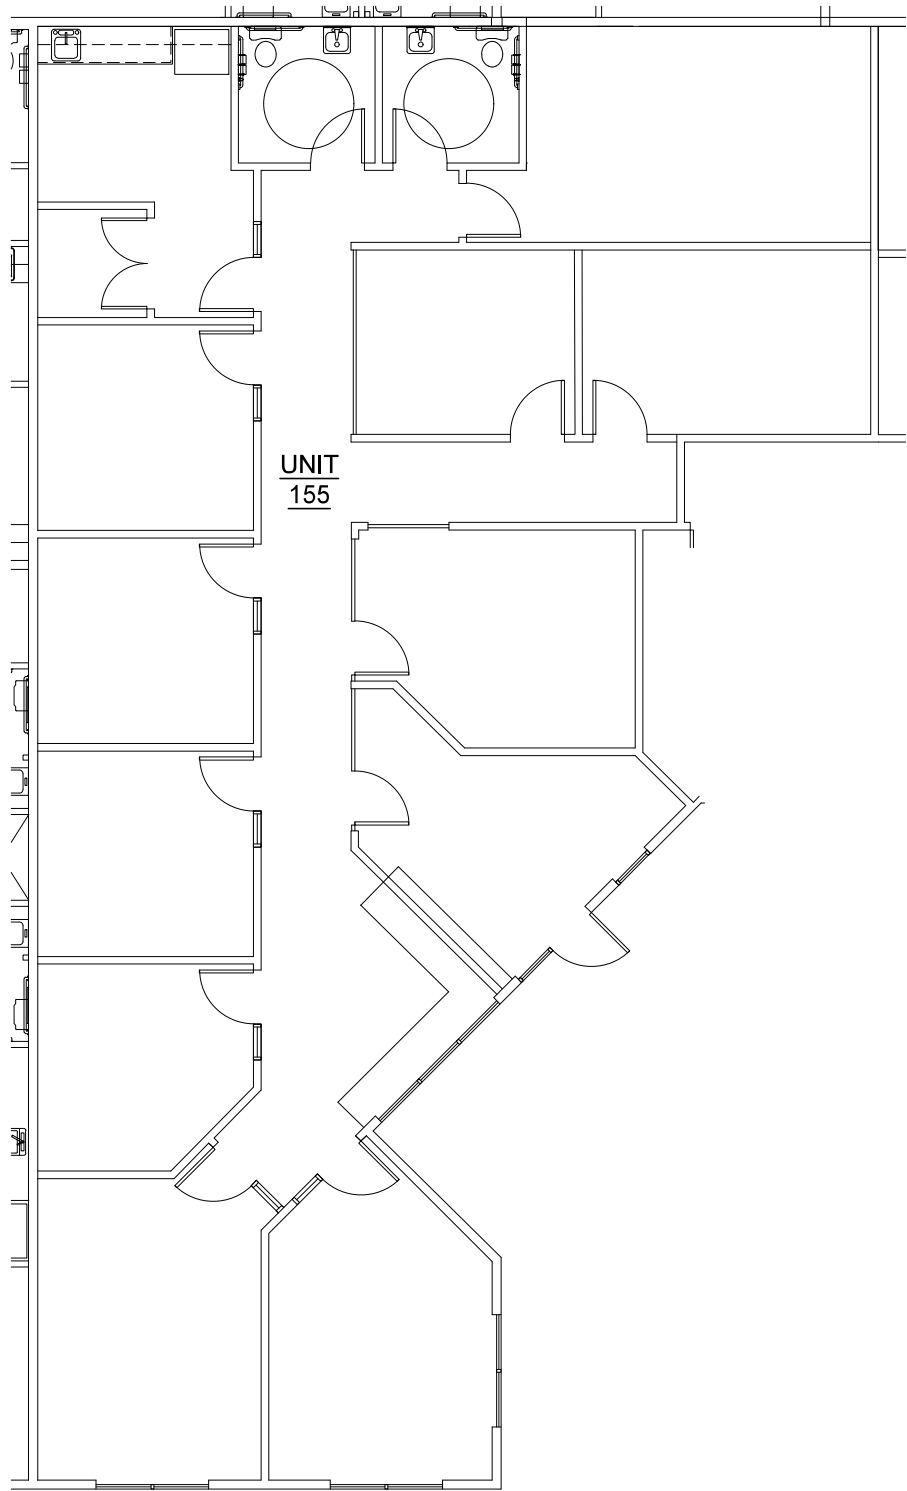

**1** UNIT 155 AS-BUILT PLAN  
**A1.00** SCALE: 3/32" = 1'-0"

REVISIONS	#	DATE	DESCRIPTION	DRAFTER INFORMATION	PROPERTY OWNER:	PROJECT INFORMATION	PROJECT NAME:	DRAWING INFORMATION	PLOT DATE:
					<b>RENO JONES, LLC</b>		<b>RENO JONES OFFICE SUITES</b>		<b>09-17-2024</b>
					COMPANY ADDRESS: 5052 SOUTH JONES BOULEVARD LAS VEGAS, NEVADA 89118		PROJECT ADDRESS: 5052 SOUTH JONES BOULEVARD LAS VEGAS, NEVADA 89118		PHASE AS-BUILT SUBMITTAL
					COMPANY CONTACT: LOUIS CARNESALE 702-466-0444		PROJECT NUMBER: <b>002-01-24-002</b>		SHEET NAME AS-BUILT FLOOR PLAN
									SHEET NO. <b>A1.00</b>