


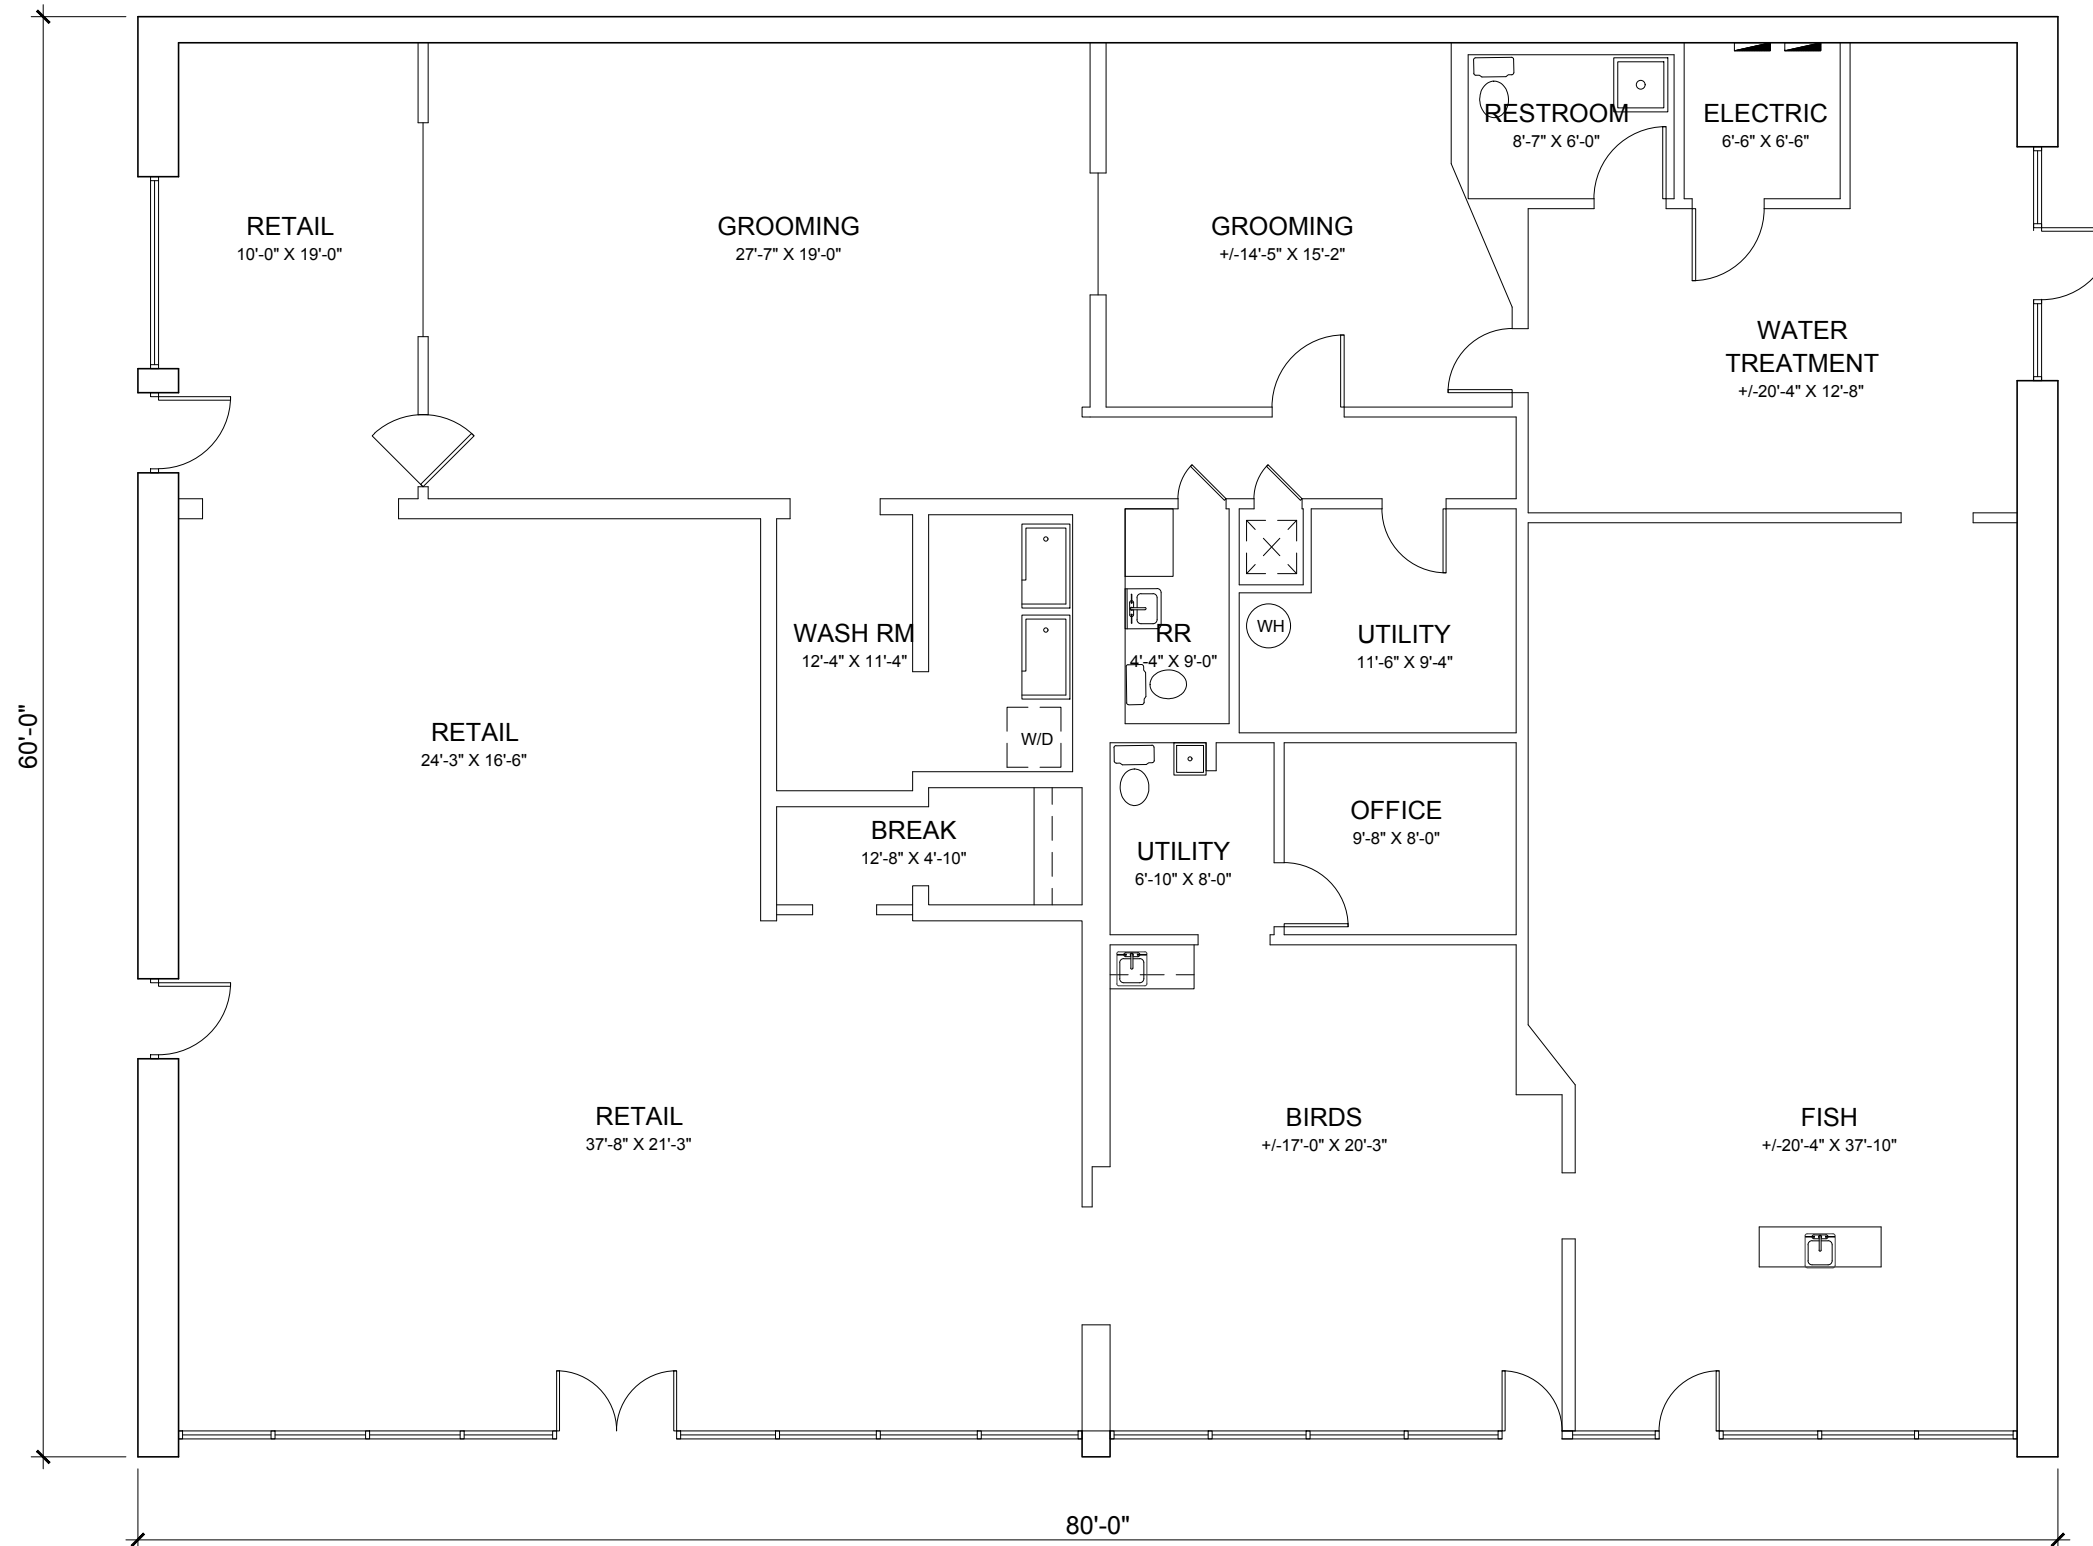

PET VILLAGE

AS-BUILT PLAN
200 N MAIN STREET,
DUNCANVILLE, TEXAS 75116



NORTH
SCALE: 1/8" = 1'-0"
PRINT ON 11X17 SHEET



351 W JEFFERSON
BOULEVARD, SUITE 601
DALLAS, TEXAS 75208
214.293.3498
THRASHERWORKS.COM

