
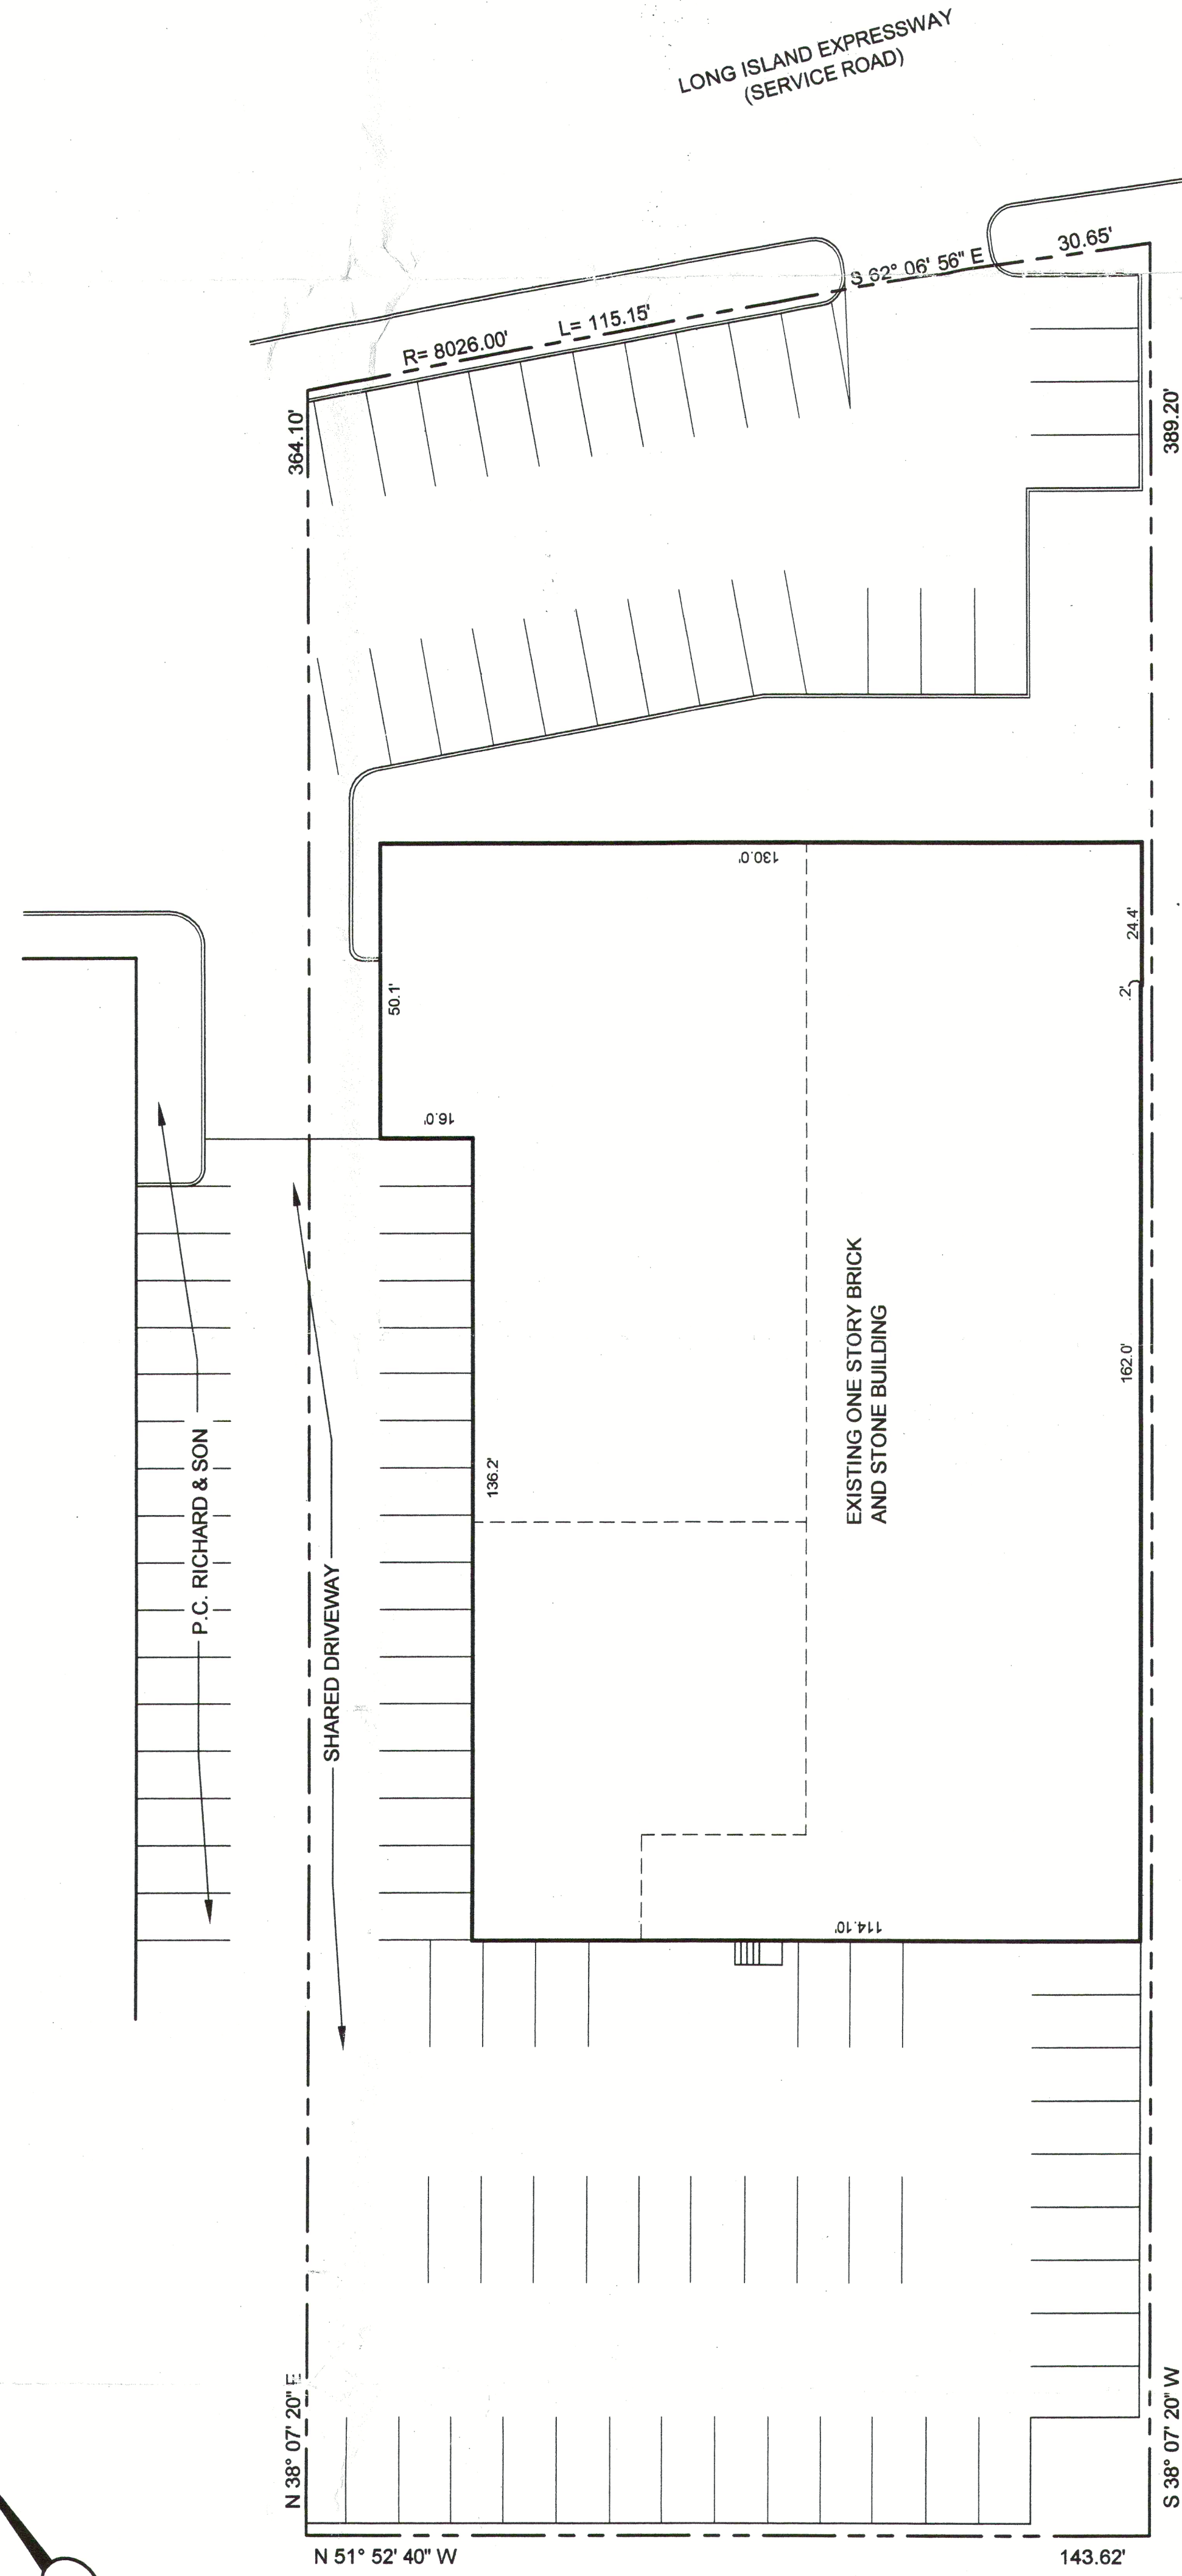


NOTE: ALL AREAS SHALL BE FIRE SPRINKLED
IN ACCORDANCE WITH NFPA-13 AND THE
NASSAU COUNTY FIRE MARSHAL

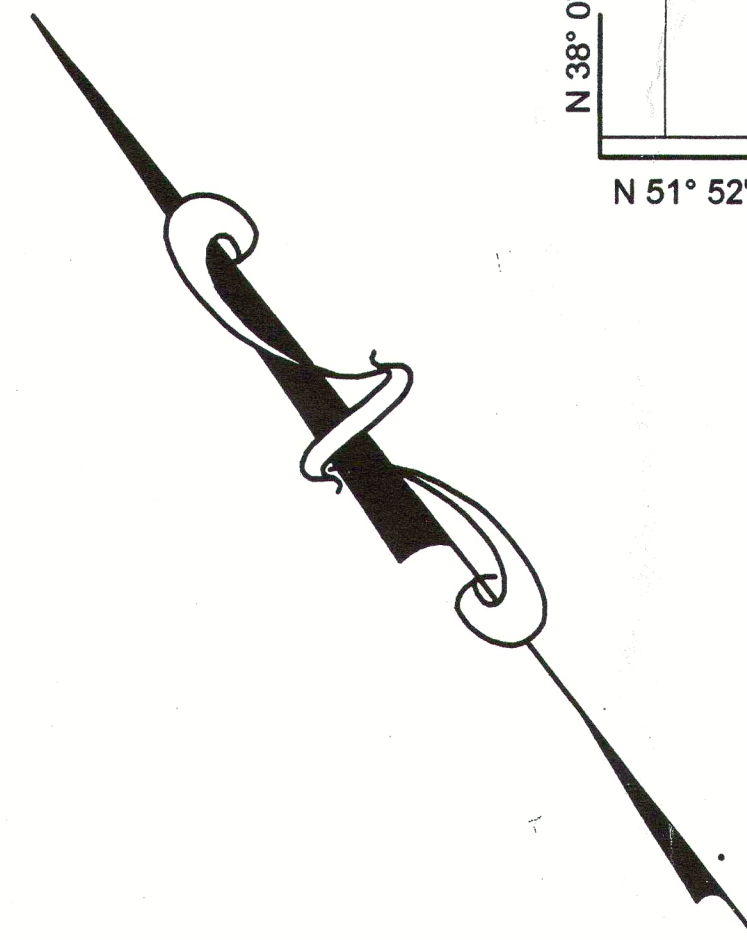

OFFICE AND SHOWROOM = 4,343 Sq. Ft. ± 20%
= 4,343 Sq. Ft. ± 200/CAR = 22 CARS

STOCK AREA / WAREHOUSE = 17,732 Sq. Ft. ± 80%
17,732 Sq. Ft. ± 500/CAR = 38 CARS
58 CARS

TOTAL PARKING REQUIRED
TOTAL PARKING PROVIDED
SHOWN ON APPROVED SURVEY
DATED FEB. 22, 1983 BY HAROLD R. BAUSCH, P. C.
78 CARS

SITE PLAN

SCALE 1" = 20'

NO OVERTIGHT ERROR OR OMISSION ON THE
PART OF THE BUILDING INSPECTOR OR THE
REPRESENTATIVE SHALL LEGALIZE THE
ERECTING CONSTRUCTION. ALTERATION,
REMOVAL, USE OR OCCUPANCY DOES NOT
PUBLISH OR STRUCTURE THE CODES NOT
CONFORM TO THE PROVISIONS OF THE
BUILDING CODE AND THE BUILDING ZONE
ORDINANCE.

TOWN OF GLENVIEW APPROVED PLAN
PERMIT # 15809 DATE 10/6/04

PERMIT ISSUED CONDITIONALLY PENDING
COMPLIANCE WITH COMMENTS NOTED IN RED.

4/9 MAY 11 2004