

Sheet Index	
AS Built	
.1	Main Floor Plan



PROJECT LOCATION MAP

- GENERAL NOTES:
 1. DO NOT USE AS A BLUEPRINTS WITHOUT MR LLC PERMISSION.
 2. PLEASE NOTE INTERIOR DIMENSIONS WERE NOT USED IN CALCULATING SQUARE FOOTAGE.
 3. SIZE OF HEATED AND NOT HEATED AREA AND OTHER INFORMATION WERE OBTAINED PER THE NC REAL ESTATE COMMISSION GUIDELINES (6" FOR EXTERNAL WALLS EXCEPT CONDOMINIUMS)
 4. FOR REMODELING QUESTIONS OR MORE DETAILED CAD DRAWINGS (INC. SITE PLAN, SECTIONS, ELEVATIONS) ALSO 3D MODEL PLEASE CONTACT ALFRED ZALYS
 MOB. 828 231 7305 E-MAIL: A.ZALYS@HOTMAIL.COM

Revision History

RevID	ChID	Change Name	Date

LEGEND MAP:

- HEATED RESIDEN.FINISHED
- HEATED COMMERC.FINISHED
- NOT HEATED/NOT FINISHED
- OPEN DECK
- COVERED PORCH

Client:
Tom GREEN
 e-mail address
828 606 6140




Company
Measure Rite LLC
 103 Poplar Spring Trail, Hendersonville
 #Contact Country NC 28739

Site Address
**445 6th Ave E, Hendersonville,
 NC 28792**

Drawing Name
**Main Level, Room Schedule,
 Generic Perspective, Camera,
 Sheet Index**

Drawing Status
AS Built


Contact Name Alfred ZALYS mob: 828 231 7305	Job Nr. MR 1068 Date 2/17/2024
Drawing Scale 1/8" = 1'-0", 1:125, 1/16" = 1'-0", 1:250	Layouts Total 1
Layout Nr. 1	Paper Size ANSI B
Layout ID .1	Revision

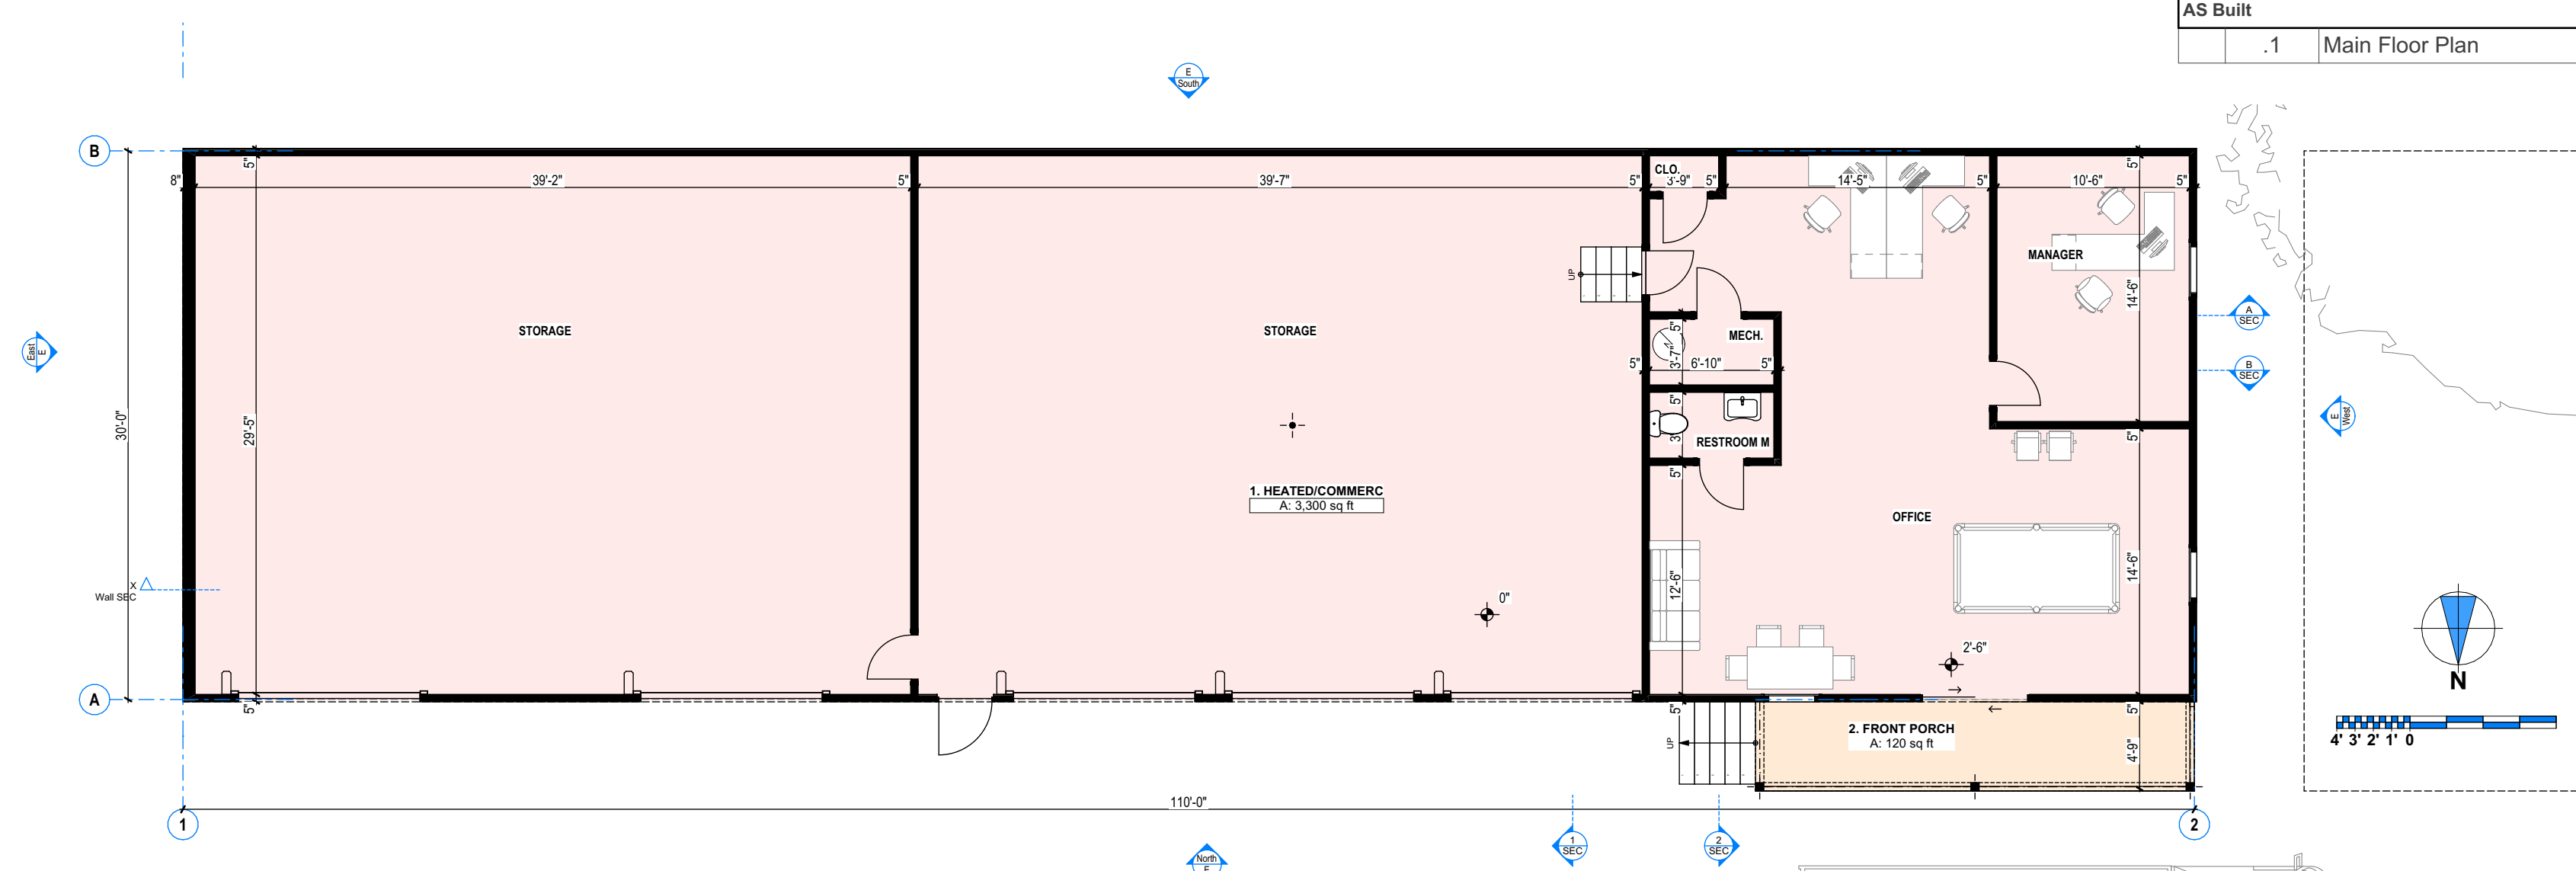

Room Schedule				
Label		Room Name	Area	Type
FLOOR AREA				
	Main Level	1. HEATED/COMMERC	3,300.00	Commercial Heated
	Main Level	2. FRONT PORCH	120.00	External / Covered
			3,420.00 sq ft	



Camera
1:2.50

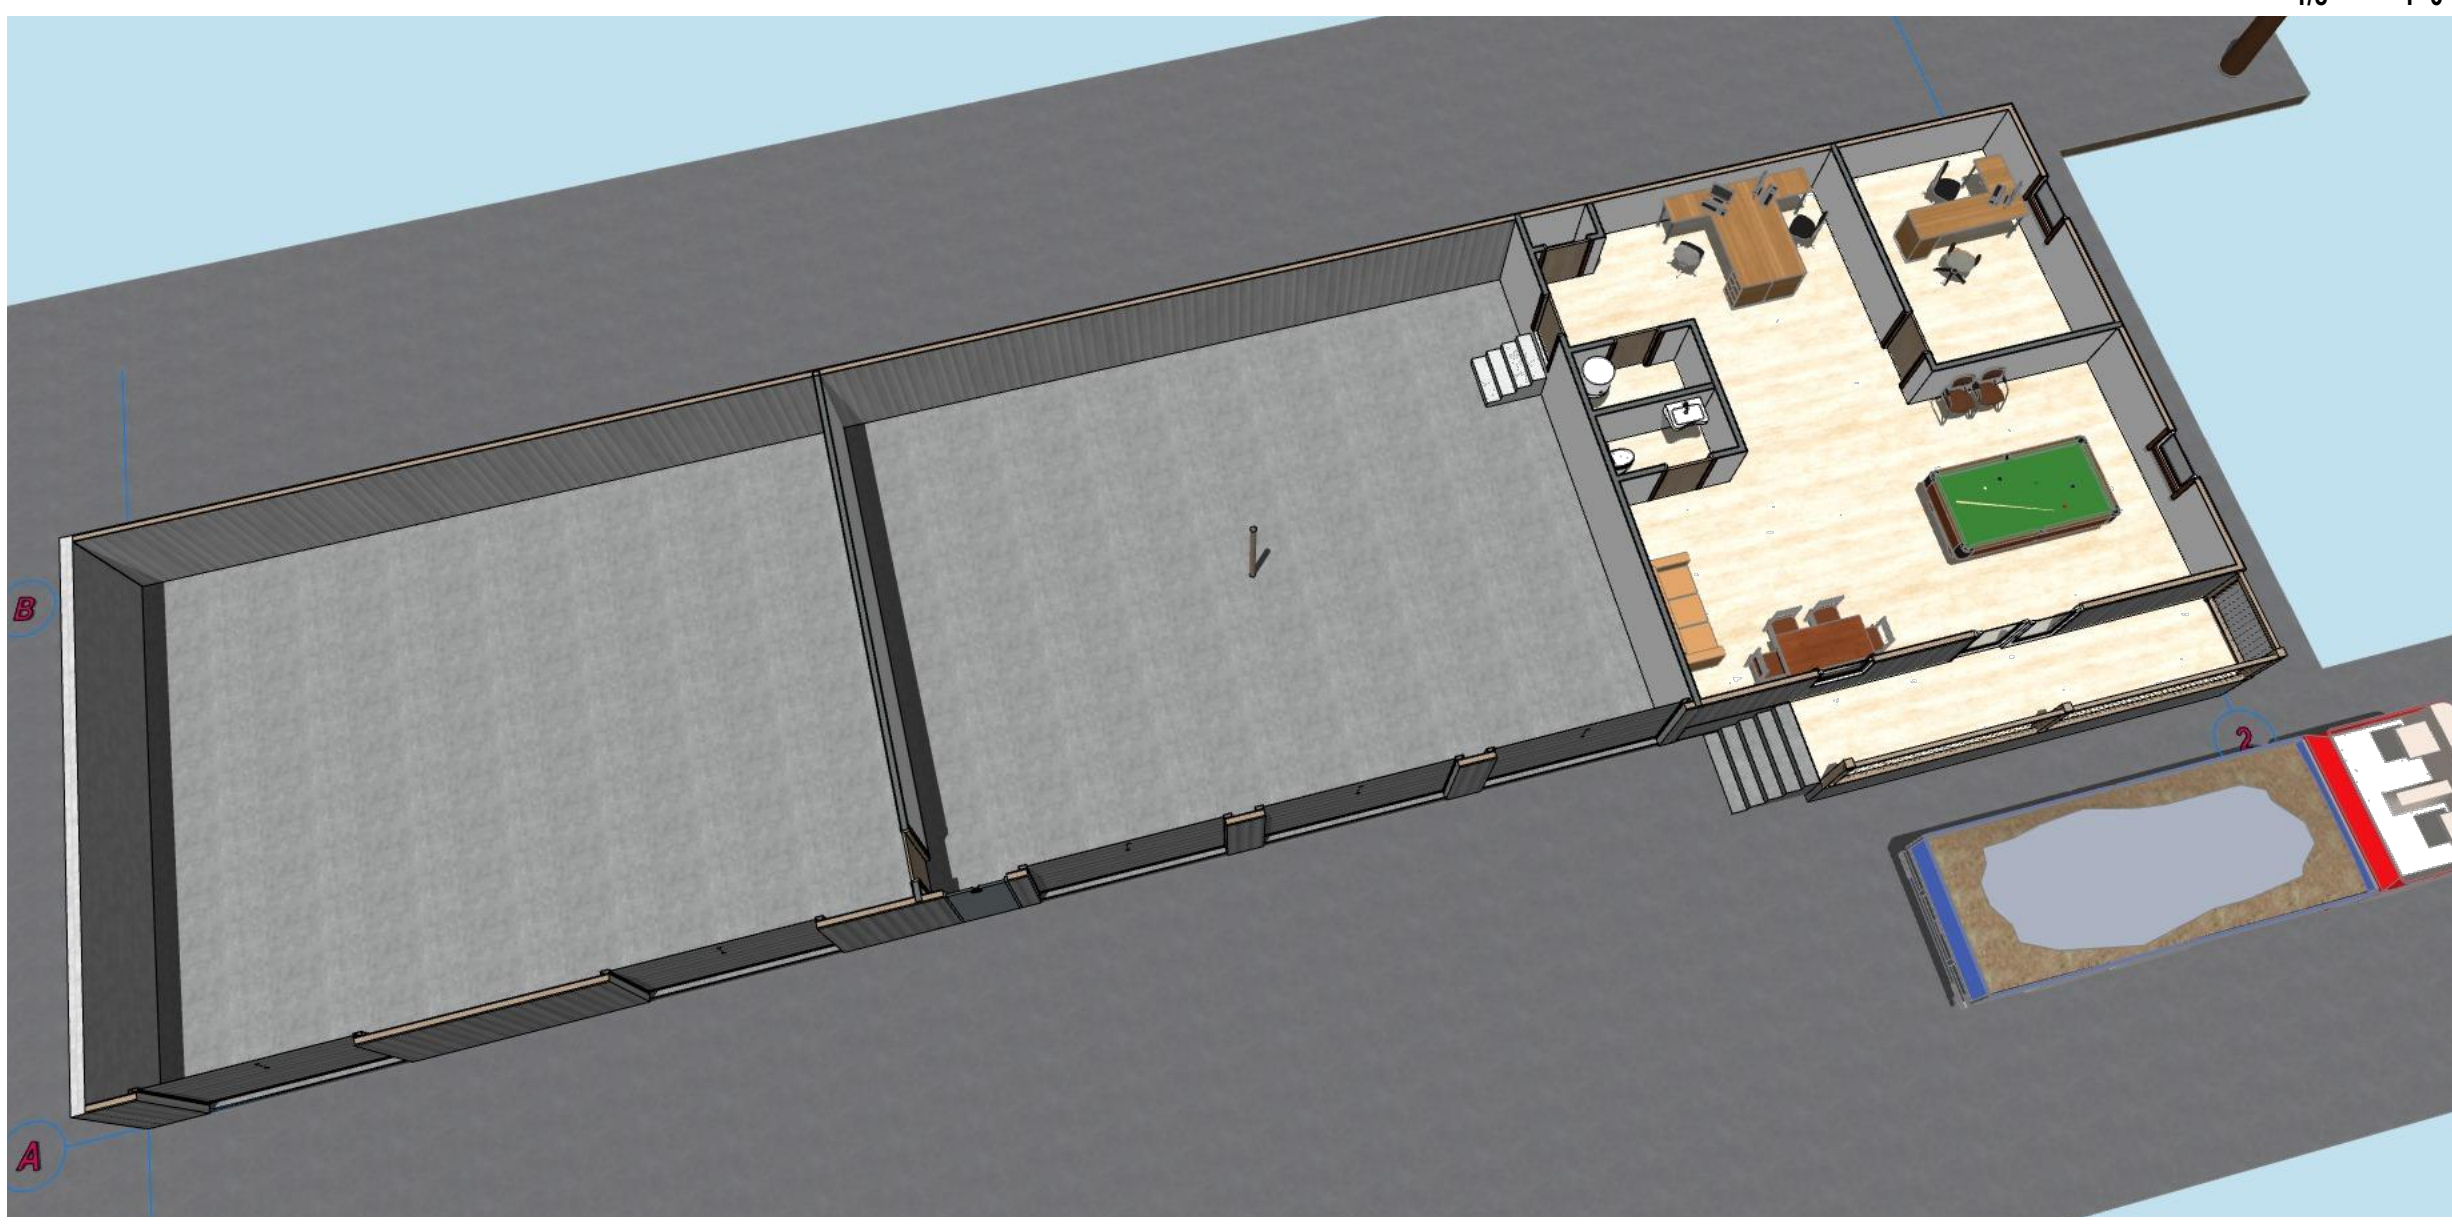

Generic Perspective
1/16" = 1'-0"