



FULL SERVICE COMMERCIAL REAL ESTATE DEVELOPMENT

9 Red Roof Lane - Salem, NH 03079
(603) 894-1104 www.BrooksProperties.com

Brooks Properties
9 Red Roof Lane
Salem, NH 03079


2nd Floor
13 Red Roof Lane
Salem, NH 03079

DATE: **March 7, 2020**
REVISIONS:

2nd Floor As Built

SCALE: 3/16" = 1'-0"
DRAWN BY: LL

EX.2

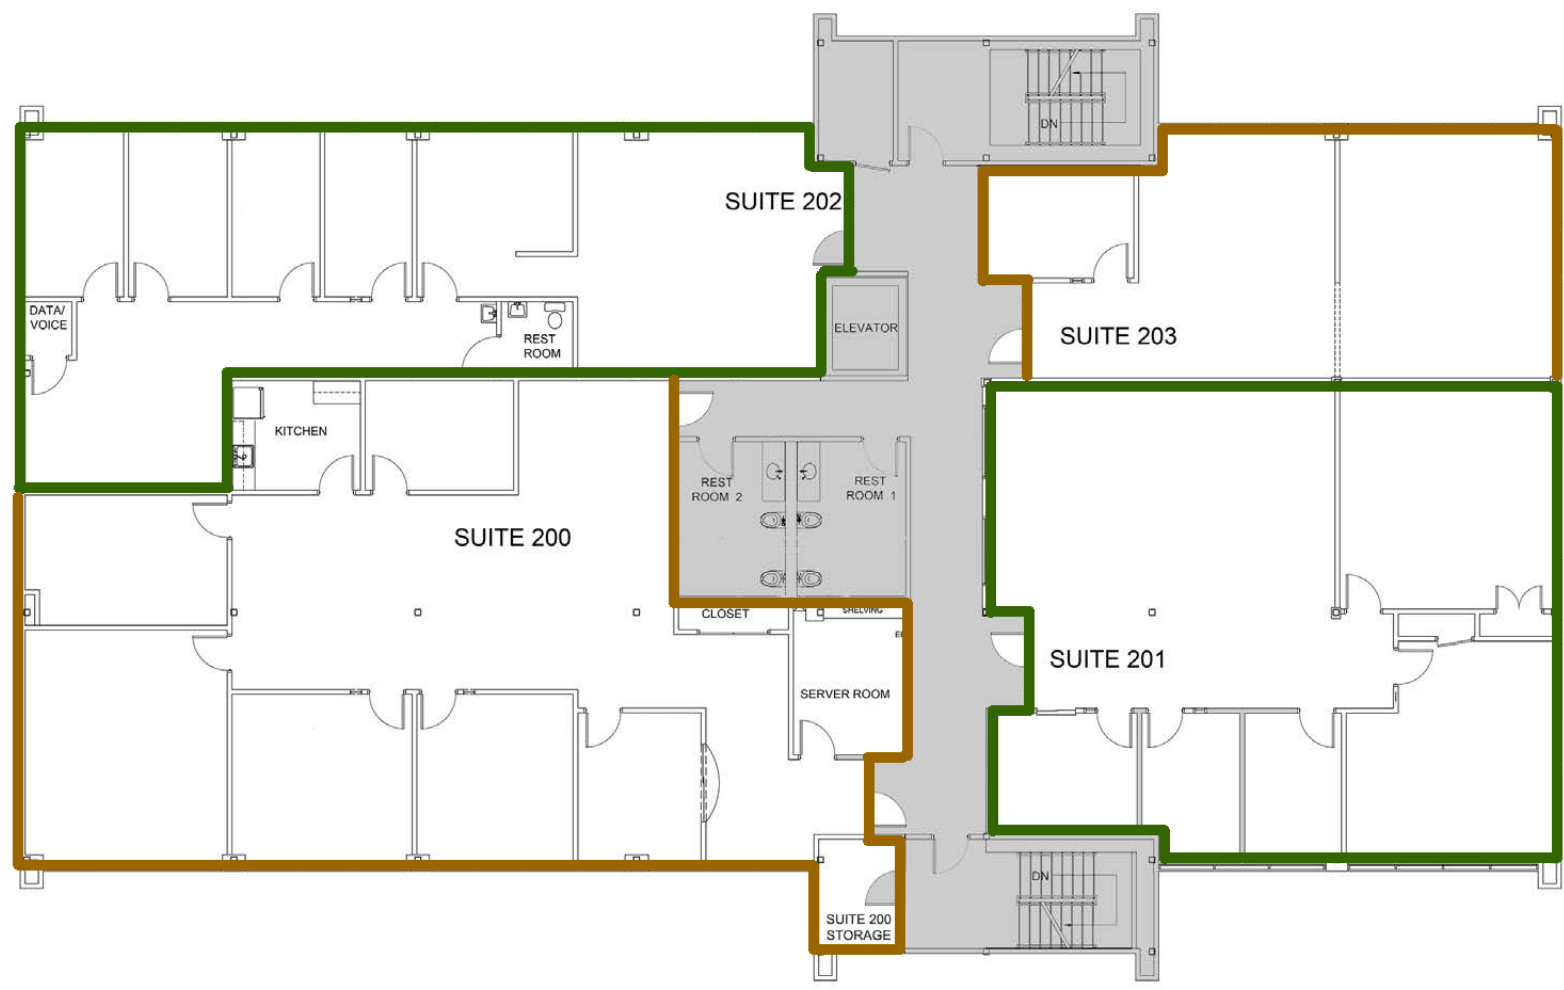

COMMON SPACE