


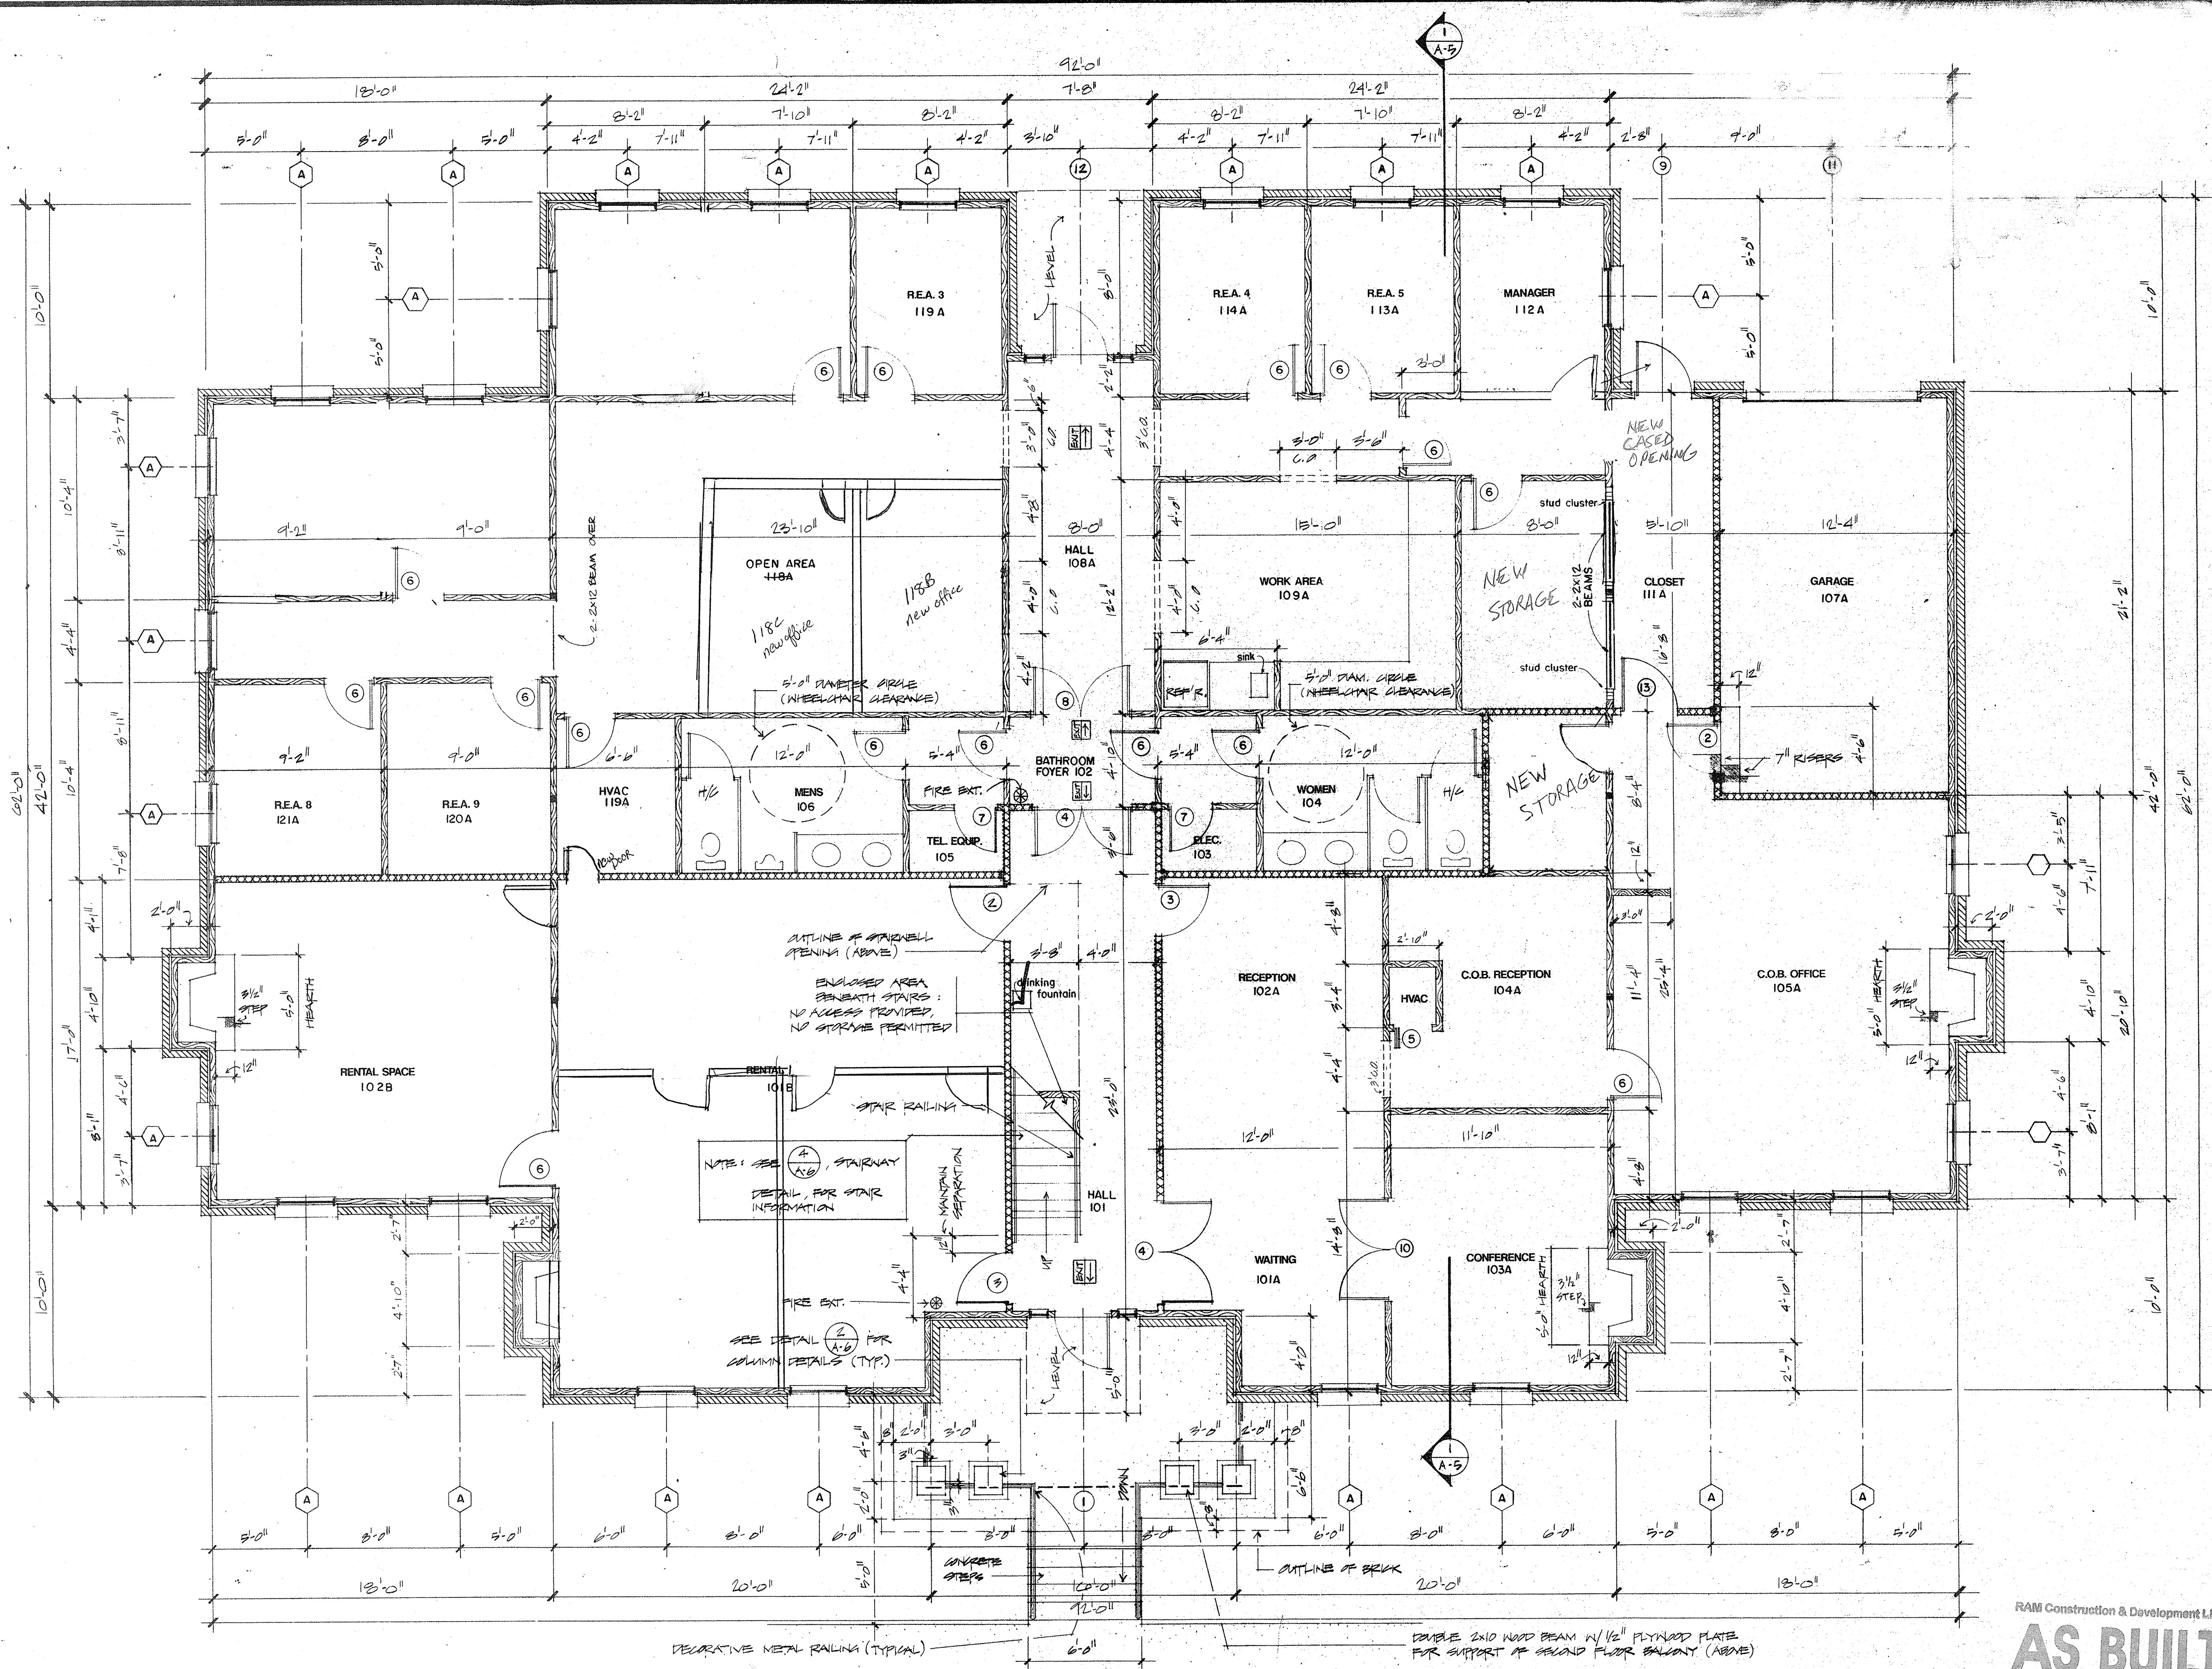

FIRST FLOOR PLAN

1/4" = 1'-0"

RAM Construction & Development LLC
AS BUILT

DATE: 15 DECEMBER 88
SCALE: 1/4" = 1'-0"
DRAWN BY: B. R. N. / P. S. V. / V.
REVISED: 1-3-89

PROJECT: Office Building for JOSEPH SERPICO REALTY, INC.
Capital Circle North East Tallahassee, Florida

TITLE: FIRST FLOOR PLAN

Conn & Associates
Architects
2855 Benjamin Cross Circle, Suite 203
Tallahassee, Fla. 32305 (904) 385-7454

Michael A. Conn
Fla. Reg. Architect
Cert. No. 11530
Date:

JOB NUMBER:
88-149

SHEET NUMBER:
A-1