



PROJECT LOCATION MAP

- GENERAL NOTES:
 1. DO NOT USE AS A BLUEPRINTS WITHOUT MR LLC PERMISSION.
 2. PLEASE NOTE INTERIOR DIMENSIONS WERE NOT USED IN CALCULATING SQUARE FOOTAGE.
 3. SIZE OF HEATED AND NOT HEATED AREA AND OTHER INFORMATION WERE OBTAINED PER THE NC REAL ESTATE COMMISSION GUIDELINES (6" FOR EXTERNAL WALLS EXCEPT CONDOMINIUMS)
 4. FOR REMODELING QUESTIONS OR MORE DETAILED CAD DRAWINGS (INC SITE PLAN, SECTIONS, ELEVATIONS) ALSO 3D MODEL PLEASE CONTACT ALFRED ZALYS
 MOB. 828 231 7305 E-MAIL: A.ZALYS@HOTMAIL.COM

Revision History

RevID	ChID	Change Name	Date


- LEGEND MAP:

 HEATED RESIDEN.FINISHED
 HEATED COMMERC.FINISHED
 NOT HEATED/NOT FINISHED
 OPEN DECK
 COVERED PORCH

Client:

e-mail address
phone number

Company Title

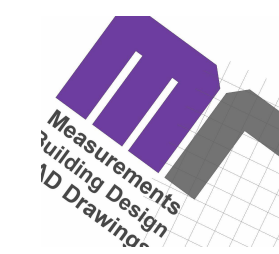

Company

Measure Rite LLC
 103 Poplar Spring Trail, Hendersonville
 #Contact Country NC 28739

Site Address

**57 S Mills River Rd, Mills River,
 NC 28759**

Drawing Name

**Room Schedule, Main Level,
 Sheet Index**

Drawing Status

AS Built

Contact Name

Alfred ZALYS
 mob. 828 231 7305

Job Nr.

MR 1140

Date

9/23/2024

Drawing Scale

1:1.25, 1/4" = 1'-0", 1" = 1'-0"

Layouts Total

3

Layout Nr.

1


Paper Size

ANSI B

Layout ID

.1

Revision

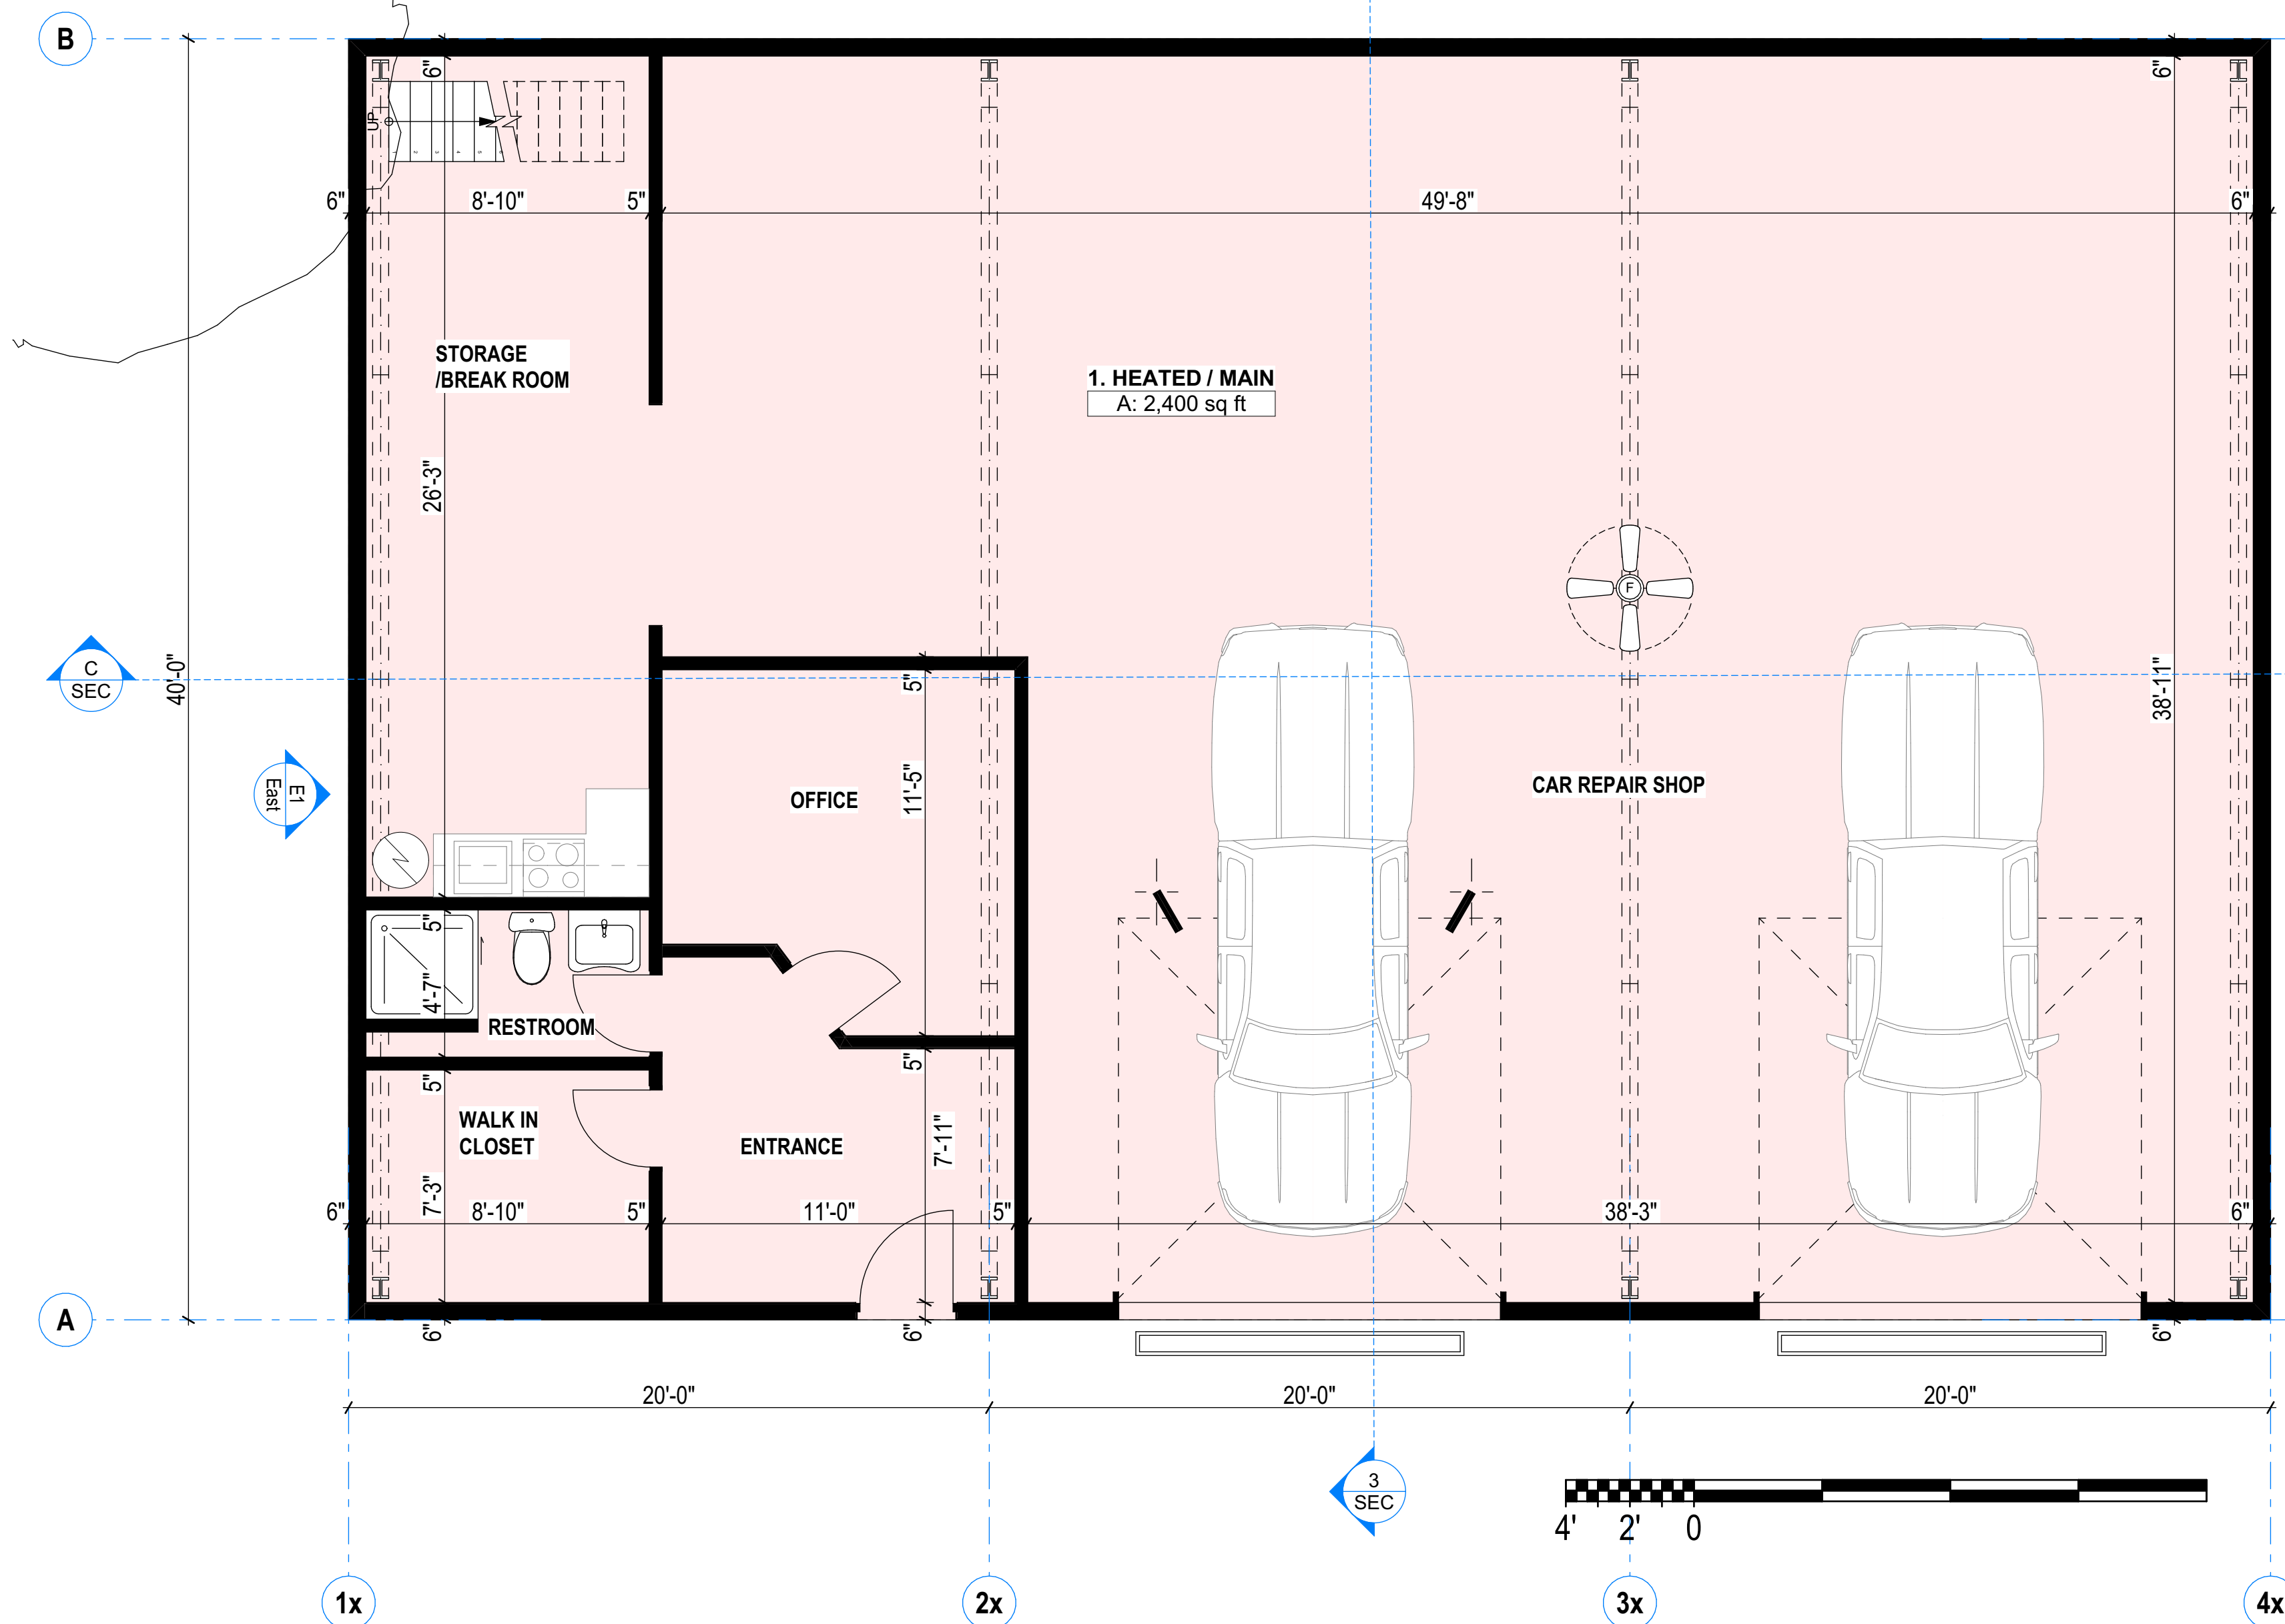

Room Schedule				
Label		Room Name	Area	Type
FLOOR AREA				
	Main Level	1. HEATED / MAIN	2,400.00	Commercial Heated
	Upper Level	1. HEATED / UPPER	627.82	Commercial Heated
			3,027.82 ft²	

Sheet Index	
AS Built	
.1	Main Floor Plan
.2	Upper Floor Plan
.3	Generic Perspectives



PROJECT LOCATION MAP

- GENERAL NOTES:
- DO NOT USE AS A BLUEPRINTS WITHOUT MR LLC PERMISSION.
 - PLEASE NOTE INTERIOR DIMENSIONS WERE NOT USED IN CALCULATING SQUARE FOOTAGE.
 - SIZE OF HEATED AND NOT HEATED AREA AND OTHER INFORMATION WERE OBTAINED PER THE NC REAL ESTATE COMMISSION GUIDELINES (6" FOR EXTERNAL WALLS EXCEPT CONDOMINIUMS)
 - FOR REMODELING QUESTIONS OR MORE DETAILED CAD DRAWINGS (INC.SITE PLAN, SECTIONS, ELEVATIONS) ALSO 3D MODEL PLEASE CONTACT ALFRED ZALYS
MOB. 828 231 7305 E-MAIL: A.ZALYS@HOTMAIL.COM

Revision History


RevID	ChID	Change Name	Date

- LEGEND MAP:
- HEATED RESIDEN.FINISHED
 - HEATED COMMERC.FINISHED
 - NOT HEATED/NOT FINISHED
 - OPEN DECK
 - COVERED PORCH

Client:

e-mail address
phone number

Company Title

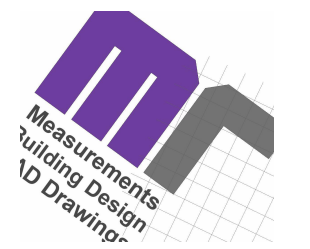

Company

Measure Rite LLC
103 Poplar Spring Trail, Hendersonville
#Contact Country NC 28739

Site Address

57 S Mills River Rd, Mills River, NC 28759

Drawing Name

Upper Level, Room Schedule, Sheet Index

Drawing Status

AS Built

Contact Name
Alfred ZALYS
mob. 828 231 7305

Job Nr.
MR 1140
Date
9/23/2024

Drawing Scale
1/4" = 1'-0", 1:1.25, 1" = 1'-0"


Layouts Total
3

Layout Nr.
2

Paper Size
ANSI B

Layout ID
.2

Revision

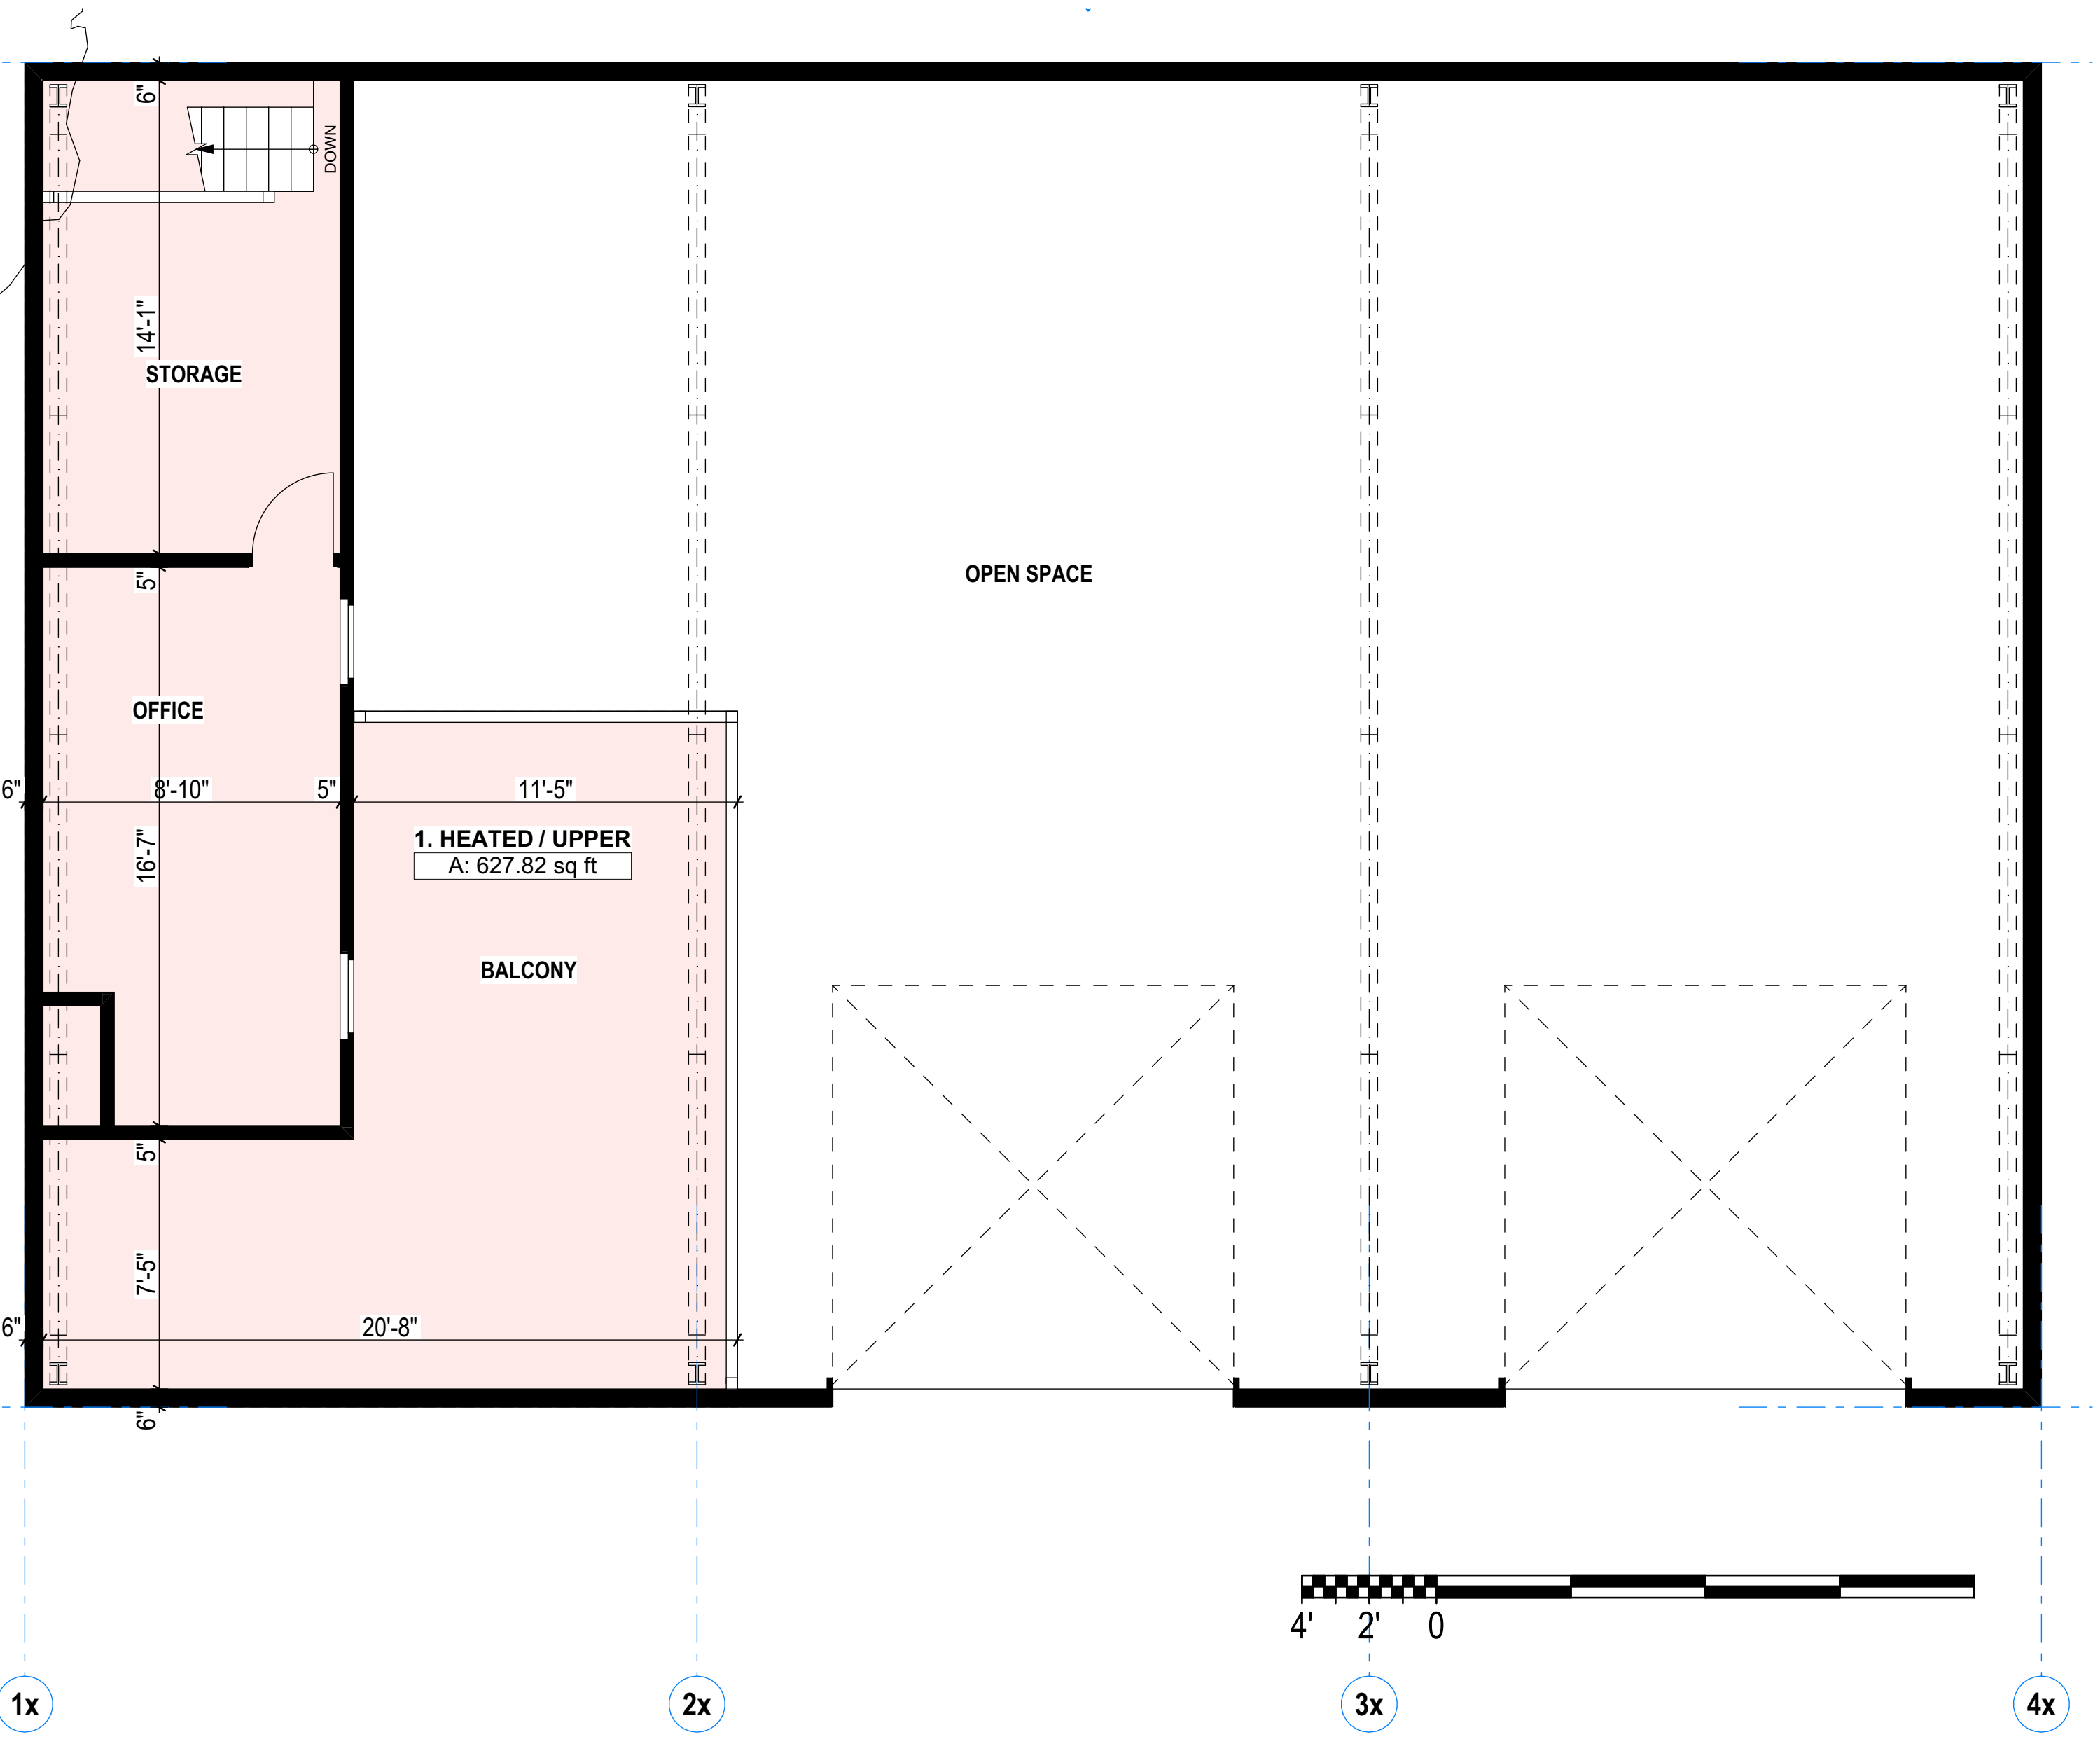

OPEN SPACE

1. HEATED / UPPER
A: 627.82 sq ft

BALCONY

STORAGE

OFFICE

Room Schedule

Label	Room Name	Area	Type
FLOOR AREA			
Main Level	1. HEATED / MAIN	2,400.00	Commercial Heated
Upper Level	1. HEATED / UPPER	627.82	Commercial Heated
		3,027.82 ft²	

Sheet Index

AS Built	
.1	Main Floor Plan
.2	Upper Floor Plan
.3	Generic Perspectives

Upper Level

1/4" = 1'-0"



PROJECT LOCATION MAP

GENERAL NOTES:
 1. DO NOT USE AS A BLUEPRINTS WITHOUT MR LLC PERMISSION.
 2. PLEASE NOTE INTERIOR DIMENSIONS WERE NOT USED IN CALCULATING SQUARE FOOTAGE.
 3. SIZE OF HEATED AND NOT HEATED AREA AND OTHER INFORMATION WERE OBTAINED PER THE NC REAL ESTATE COMMISSION GUIDELINES (6" FOR EXTERNAL WALLS EXCEPT CONDOMINIUMS)
 4. FOR REMODELING QUESTIONS OR MORE DETAILED CAD DRAWINGS (INC SITE PLAN, SECTIONS, ELEVATIONS) ALSO 3D MODEL PLEASE CONTACT ALFRED ZALYS
 MOB. 828 231 7305 E-MAIL: A.ZALYS@HOTMAIL.COM


Revision History

RevID	ChID	Change Name	Date

LEGEND MAP:

 HEATED RESIDEN.FINISHED
 HEATED COMMERC.FINISHED
 NOT HEATED/NOT FINISHED
 OPEN DECK
 COVERED PORCH

Client:
 e-mail address
 phone number

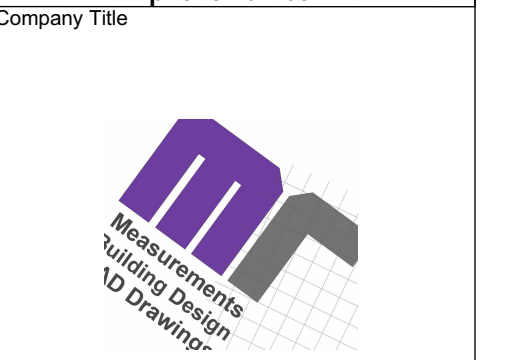


Company
Measure Rite LLC
 103 Poplar Spring Trail, Hendersonville
 #Contact Country NC 28739

Site Address
57 S Mills River Rd, Mills River, NC 28759


Drawing Name
**Generic Perspective/MAIN,
 Generic Perspective/UPPER**

Drawing Status
AS Built

Contact Name Alfred ZALYS mob: 828 231 7305	Job Nr. MR 1140 Date 9/23/2024
Drawing Scale 1:1.33, 3/32" = 1'-0"	Layouts Total 3
Layout Nr. 3	Paper Size ANSI B
Layout ID .3	Revision

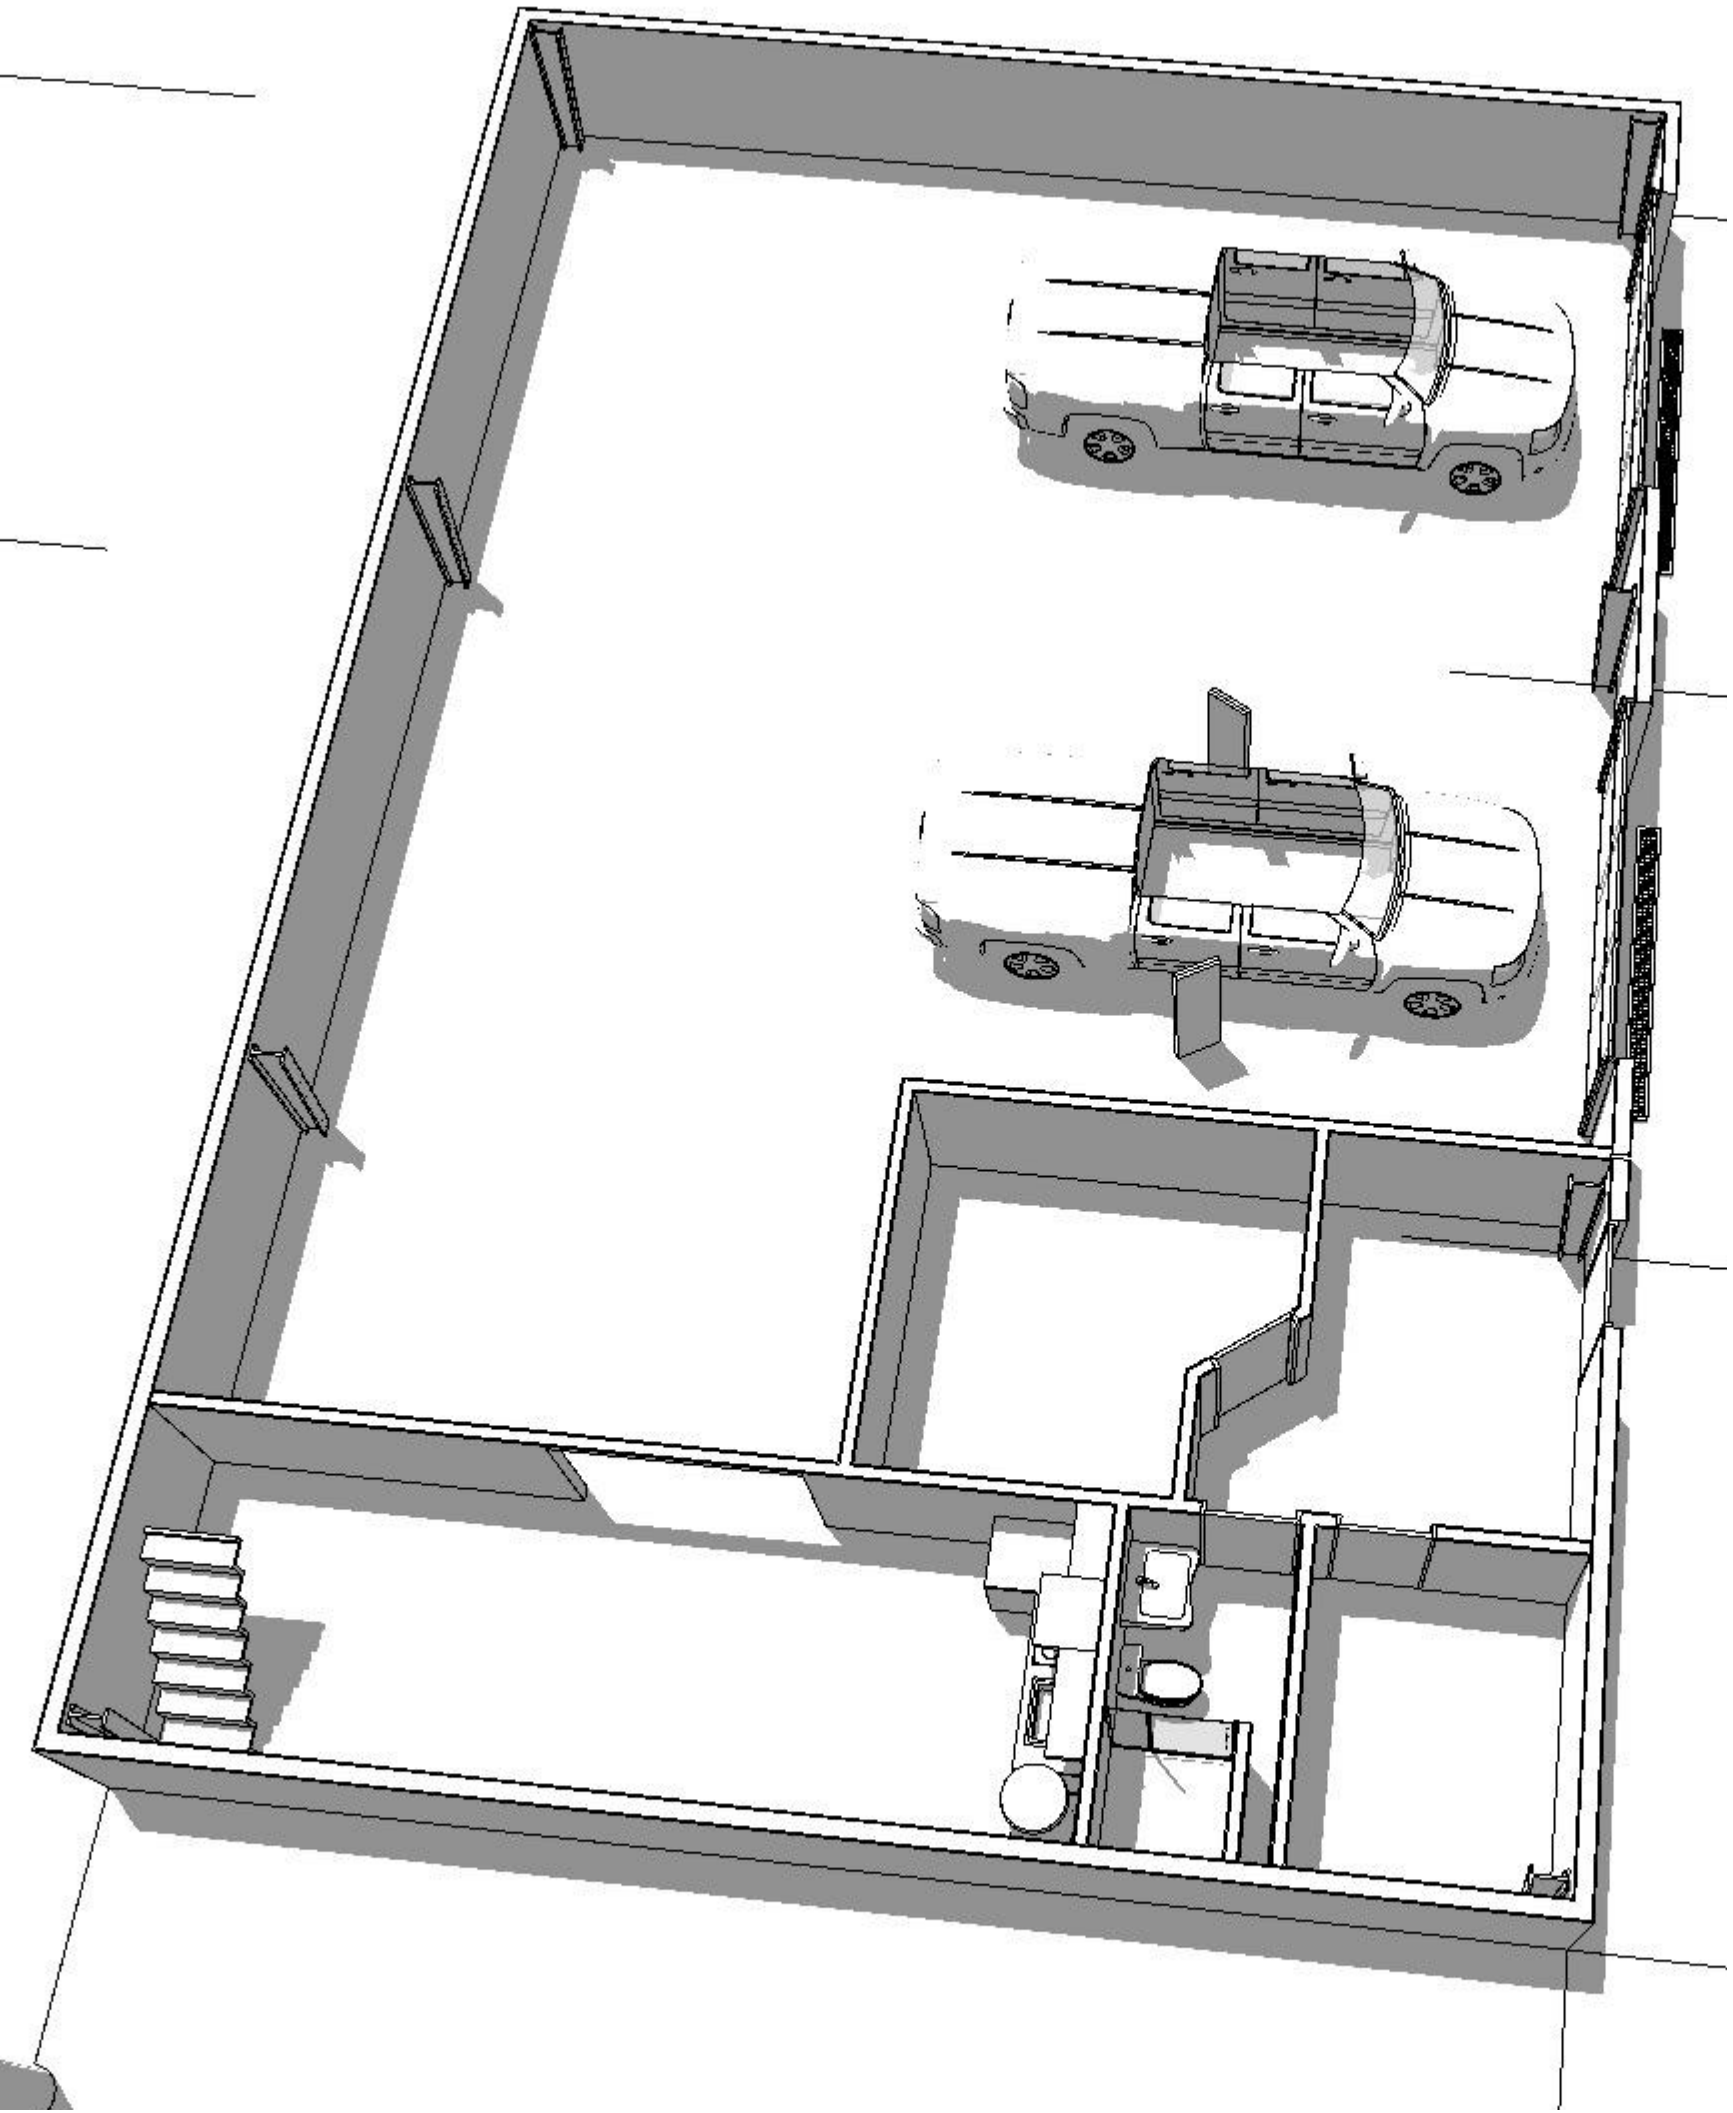

1 Generic Perspective/MAIN

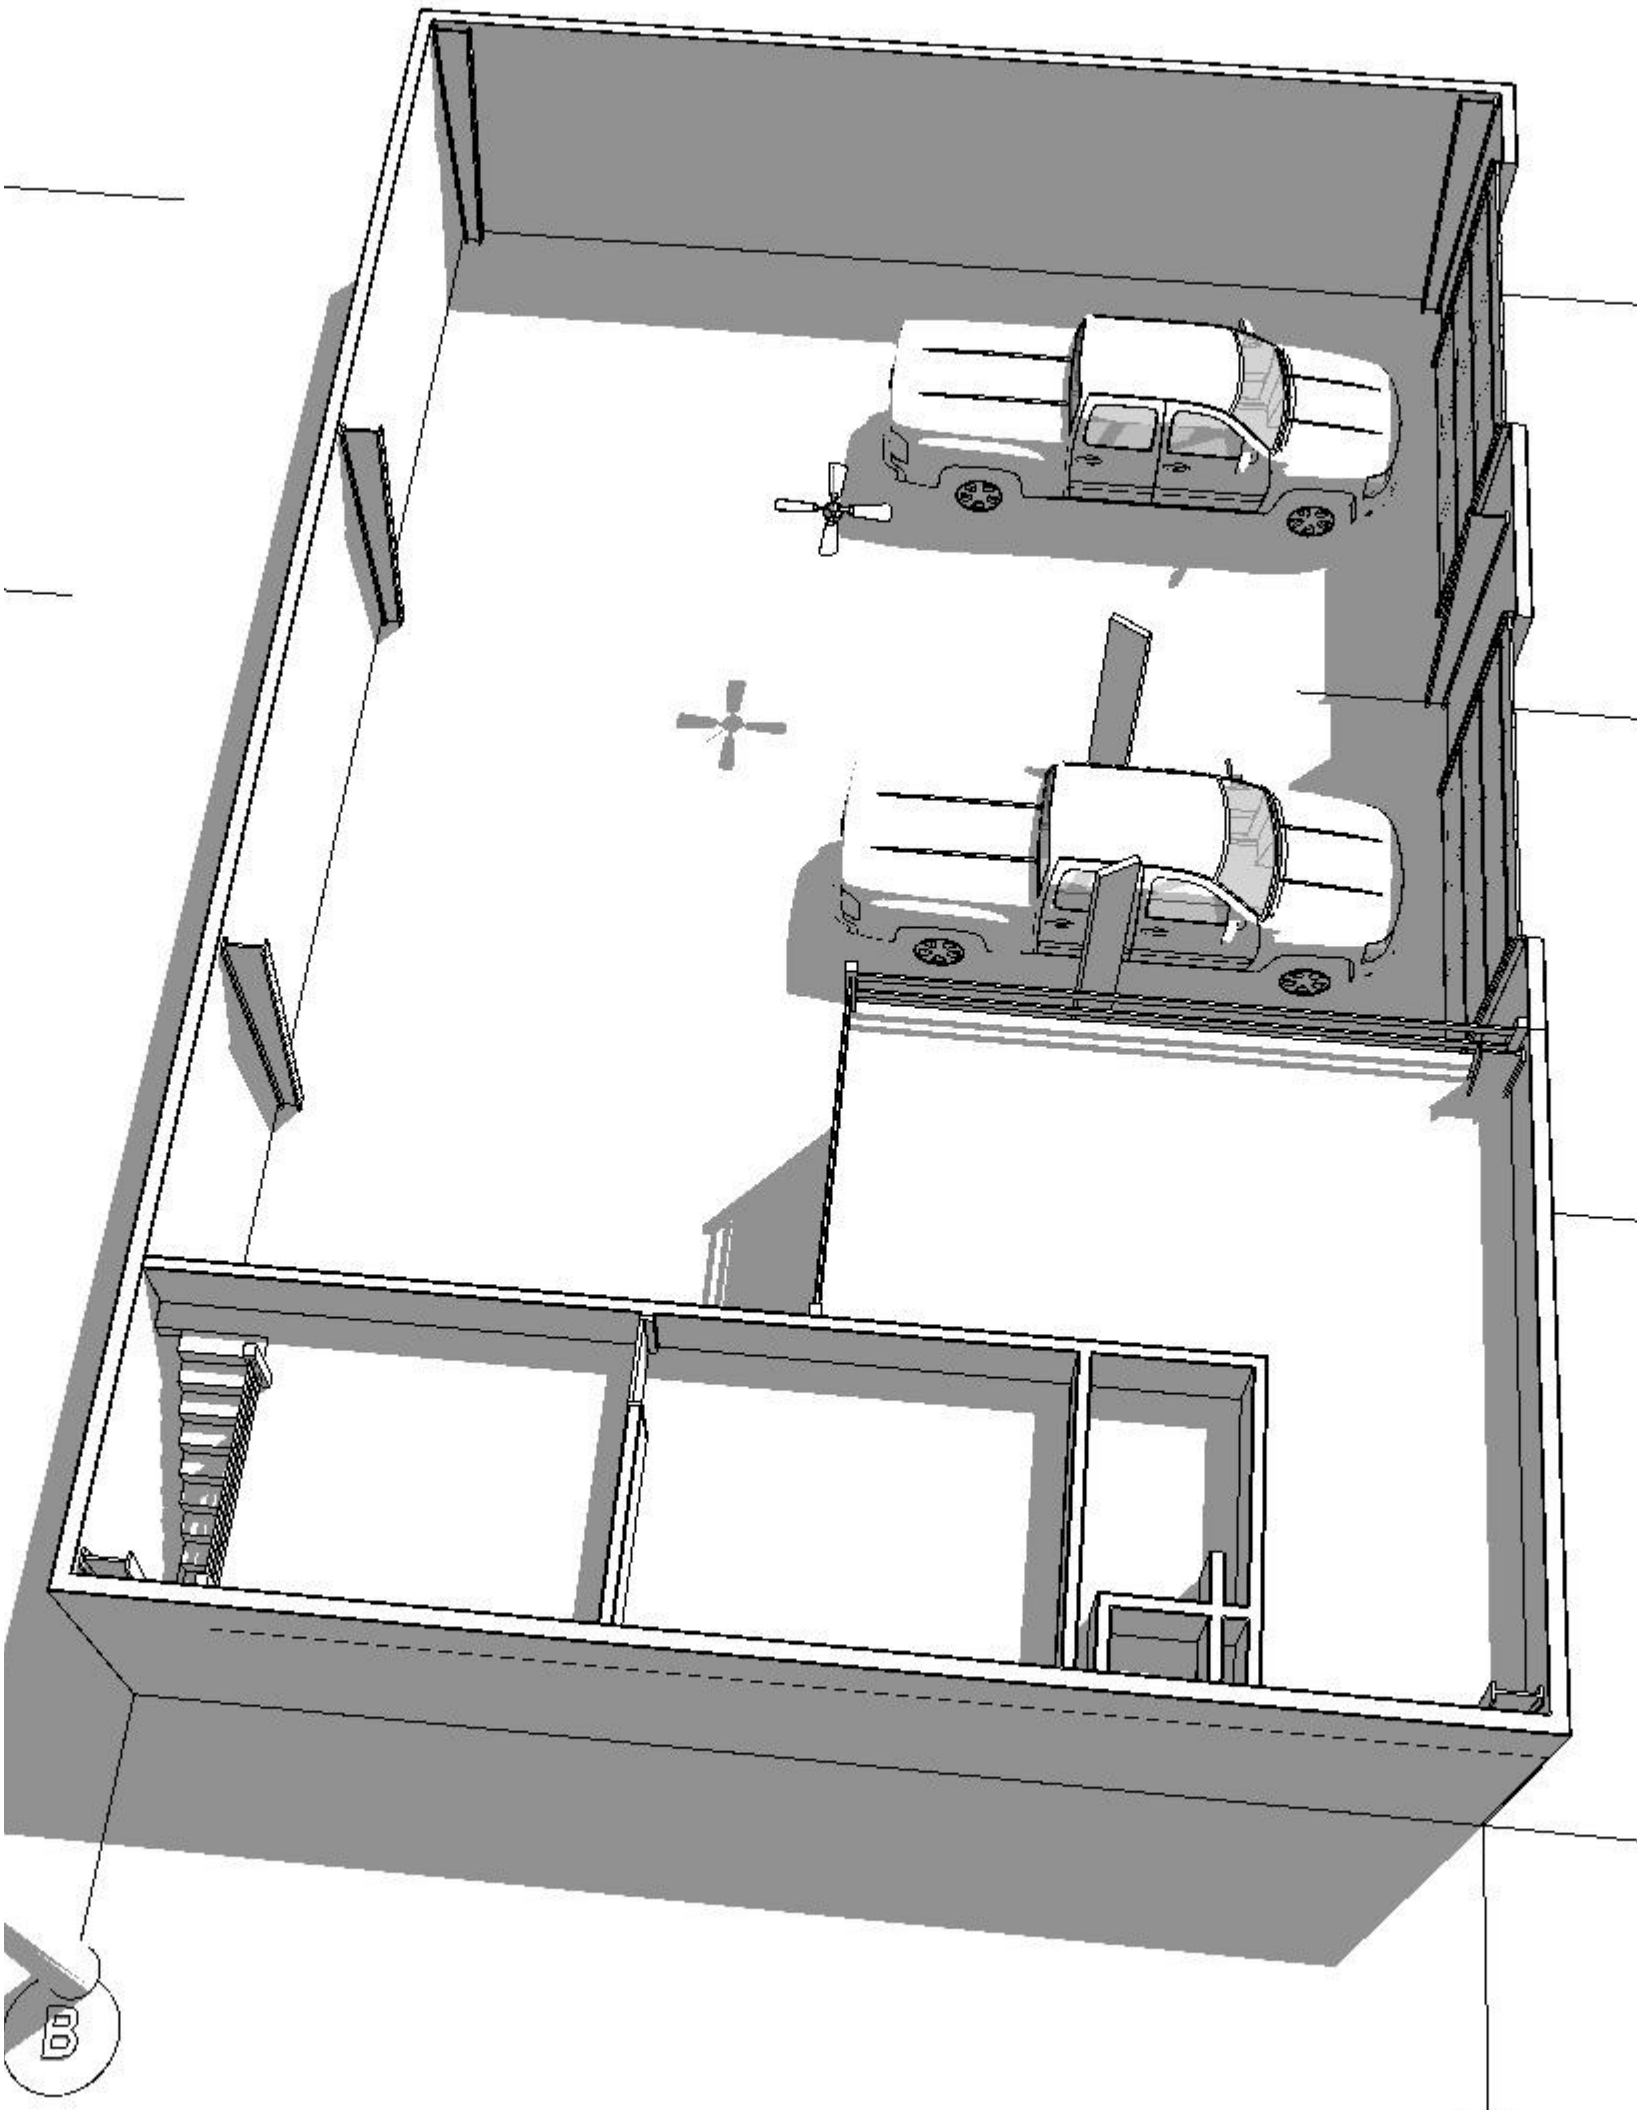

2 Generic Perspective/UPPER