


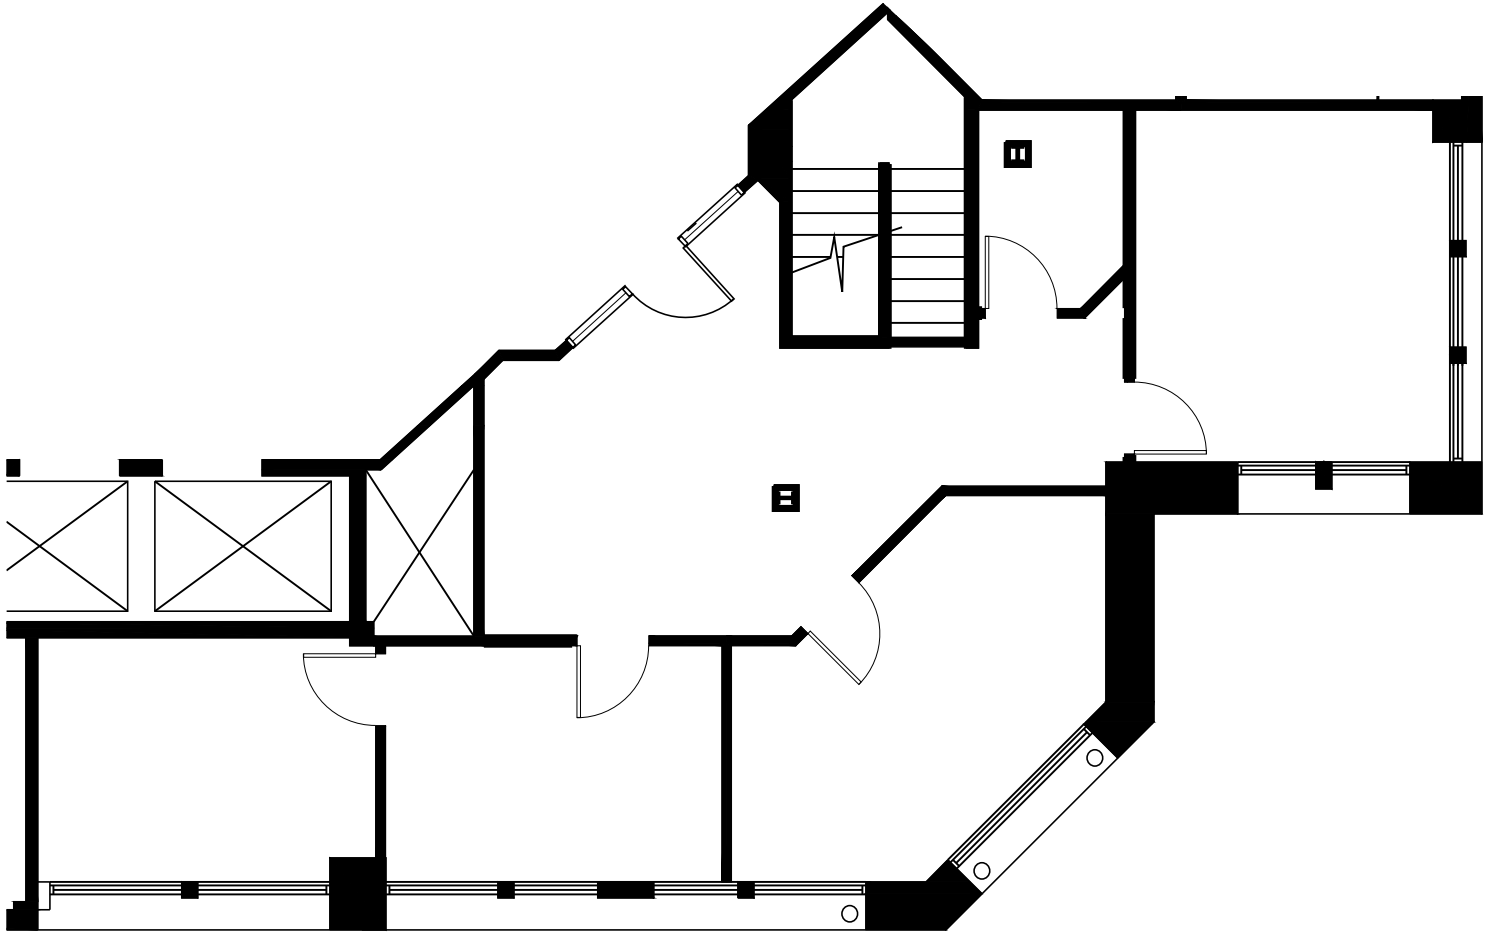

1

As-Built Floor Plan


Suite 380

1,356 RSF (Approx.)

Scale: 1/8" = 1'-0"



North

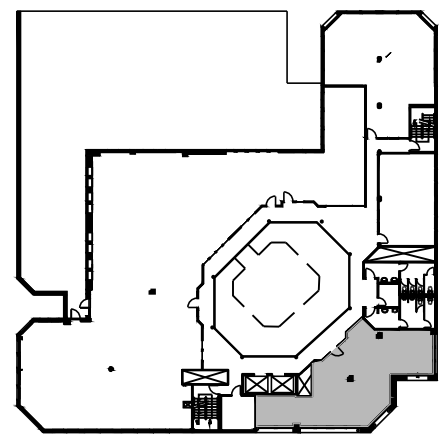

Proximity Plan

Siena Square

Suite 380

As-Built Floor Plan
Issued: 20June2023
Drawn by: MCP / MCP
TPS Project #: 450

Siena Square
Level Three; Suite 380
2060 Broadway
Boulder, Colorado 80302

TPS
1660 Lincoln St, Ste. 100
Denver, Colorado 80264
(303) 861-4800
www.TPS.design