

T. J. TITZMANN
 ENGINEERING ASSOCIATES, INC.
 P.O. BOX 71429, FAIRBANKS, AK 99701
 (907) 452-4094 (C 627)

SALCHA, ALASKA

LOCATION:

FOR: AK COMMERCIAL PROPERTIES

ASBUILT FLOOR PLAN

MOOSE CREEK BUS BARN

DRAWN: JS


CHECKED:

DATE: 8/9/2024

V1

ARCHITECT/CONTRACTOR SHOULD FIELD VERIFY FLOOR PLAN
 PRIOR TO REMODEL/INTERIOR DESIGN

OLD BUS BARN BUILDING

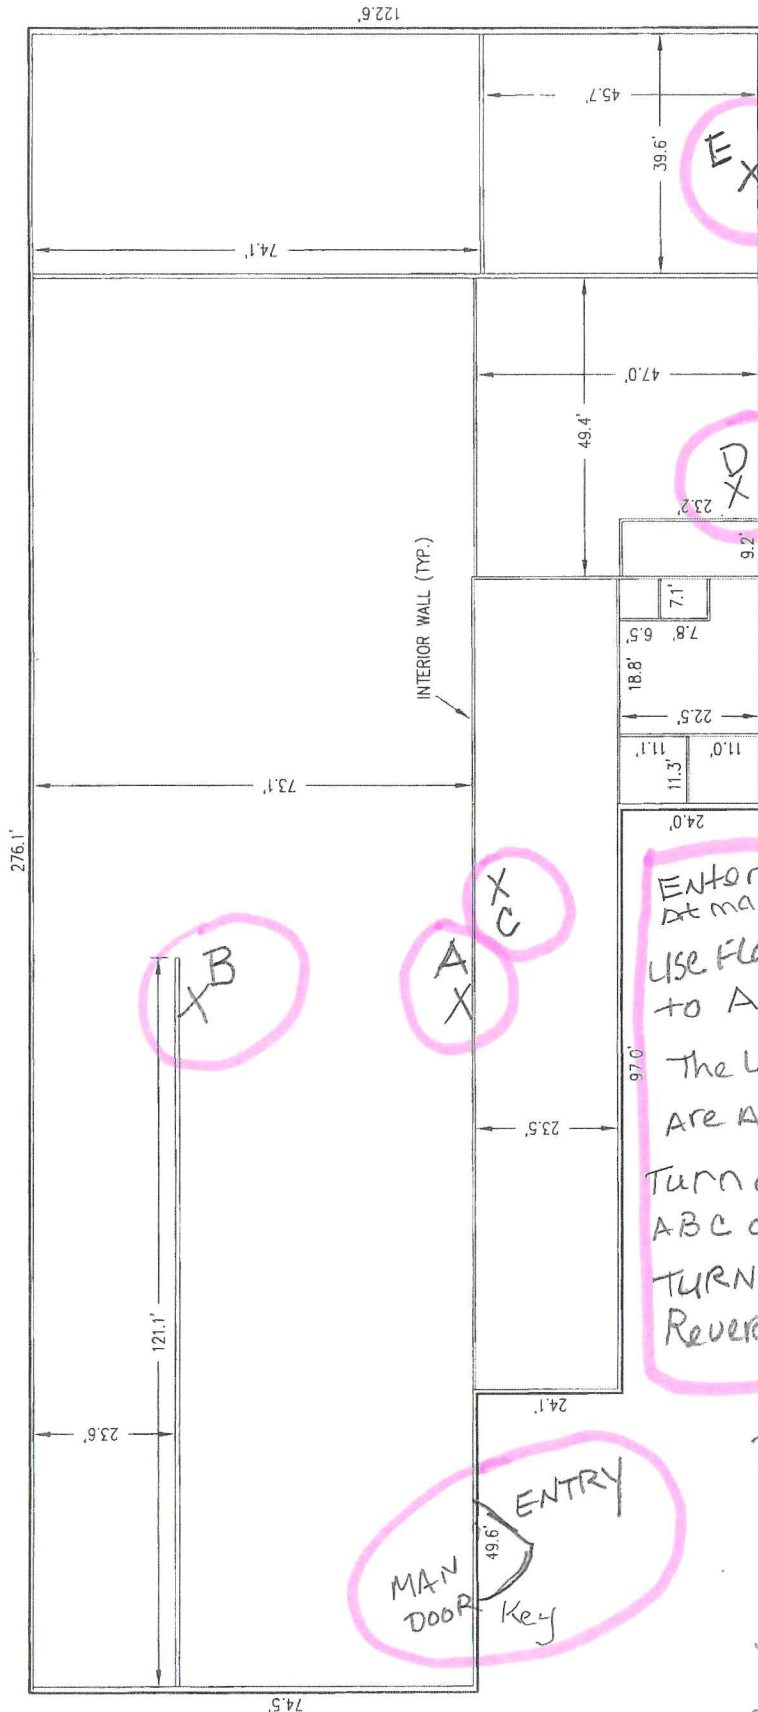

X:\Drawings\RT\Halls\02-014 Moose Creek Bus Barn.dwg