



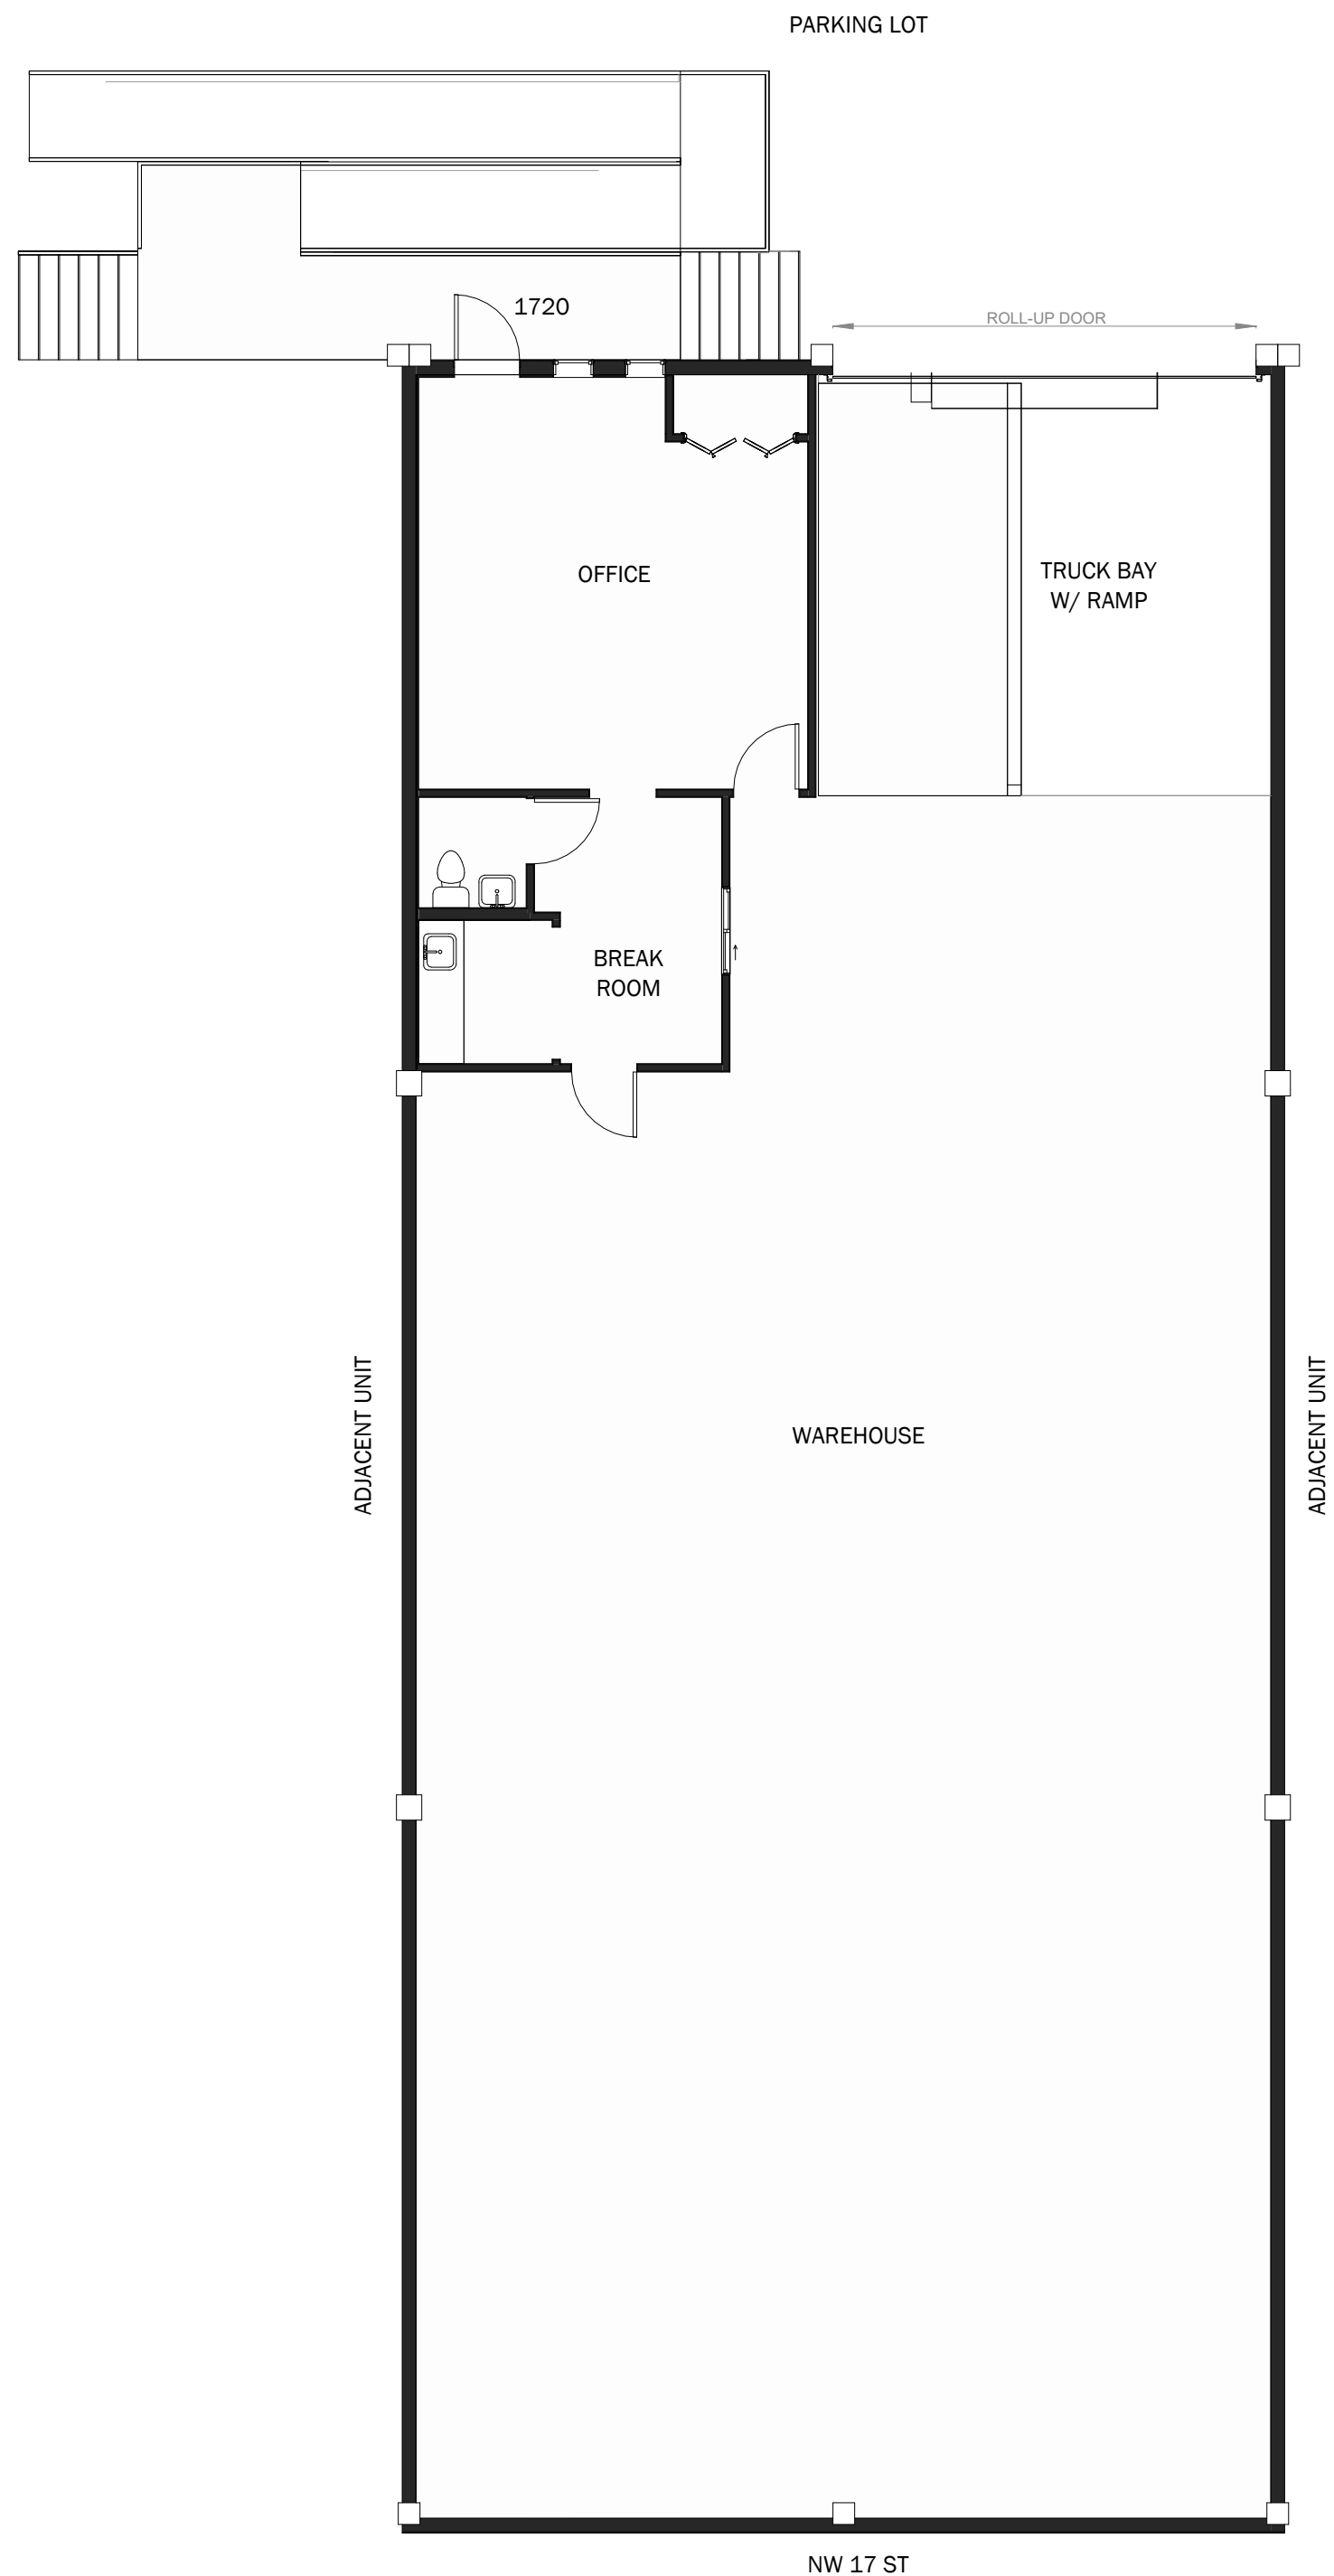

1 GROUND LEVEL FLOOR PLAN
1/8" = 1'-0"

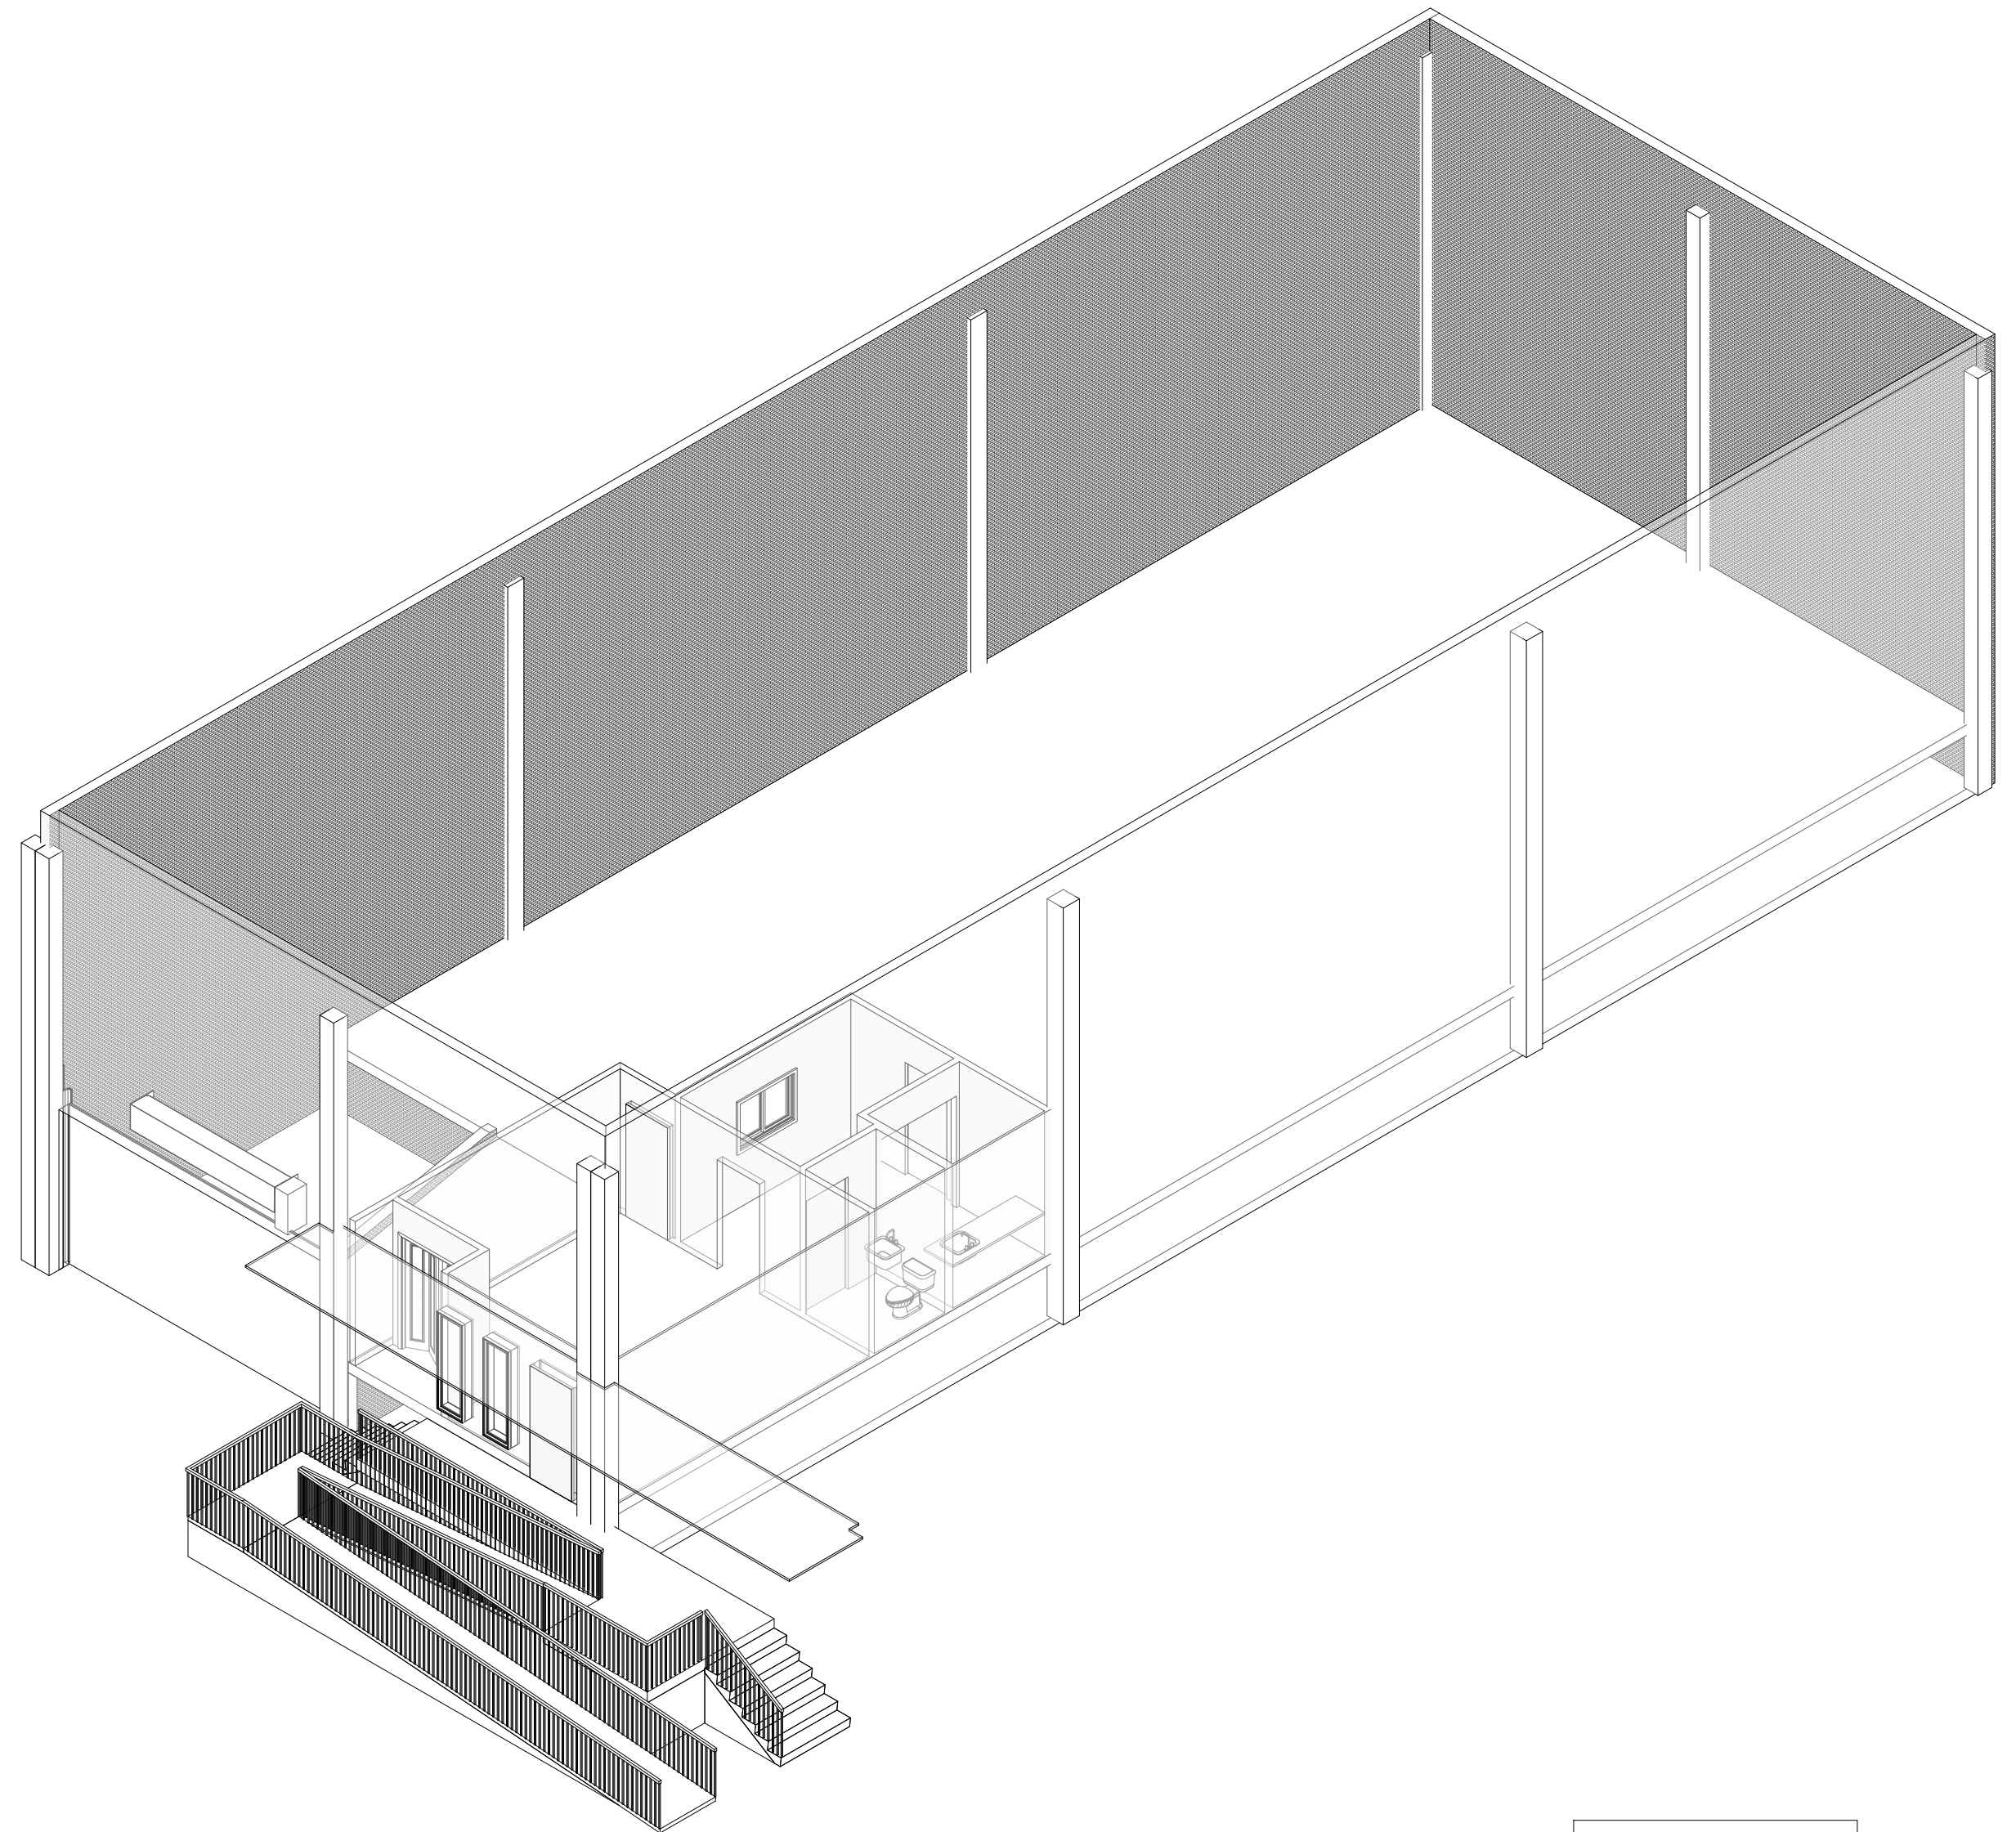

2 3D VIEW1

ADDRESS: 1720 NW 82 AVE
FOLIO: 35-3034-007-0020


1720 NW 82 AVE	
NAME	AREA
WAREHOUSE	3438 SF
OFFICE	555 SF
	3993 SF

FEATURES:
• ONE SINGLE-STALL BATHROOM. • ONE 19.5' WIDE ROLL-UP DOOR. • ONE WAREHOUSE SPACE. • ONE OFFICE SPACE. • ONE BREAK ROOM. • ONE TRUCK BAY W/ RAMP.

AS-BUILT CONDITIONS

1720 NW 82 AVE

DATE PRODUCED: 10/27/23

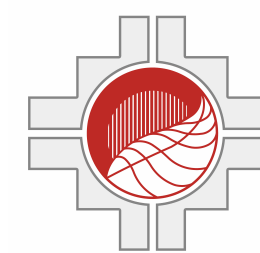

RUKAN

7925 NW 12 STREET, STE 312
DORAL, FL 33126

786.547.0363