

RIRI

RICHANIRINCON
ARCHITECTURE

BUILDING 1ST FLOOR PLAN - COLUMN GRID

2921 SANFORD DRIVE SUITE 150

As Built
Drawings

Project Number 24-010


Date Issue Date

Drawn By MR

Checked By MR

A1b

Scale As indicated

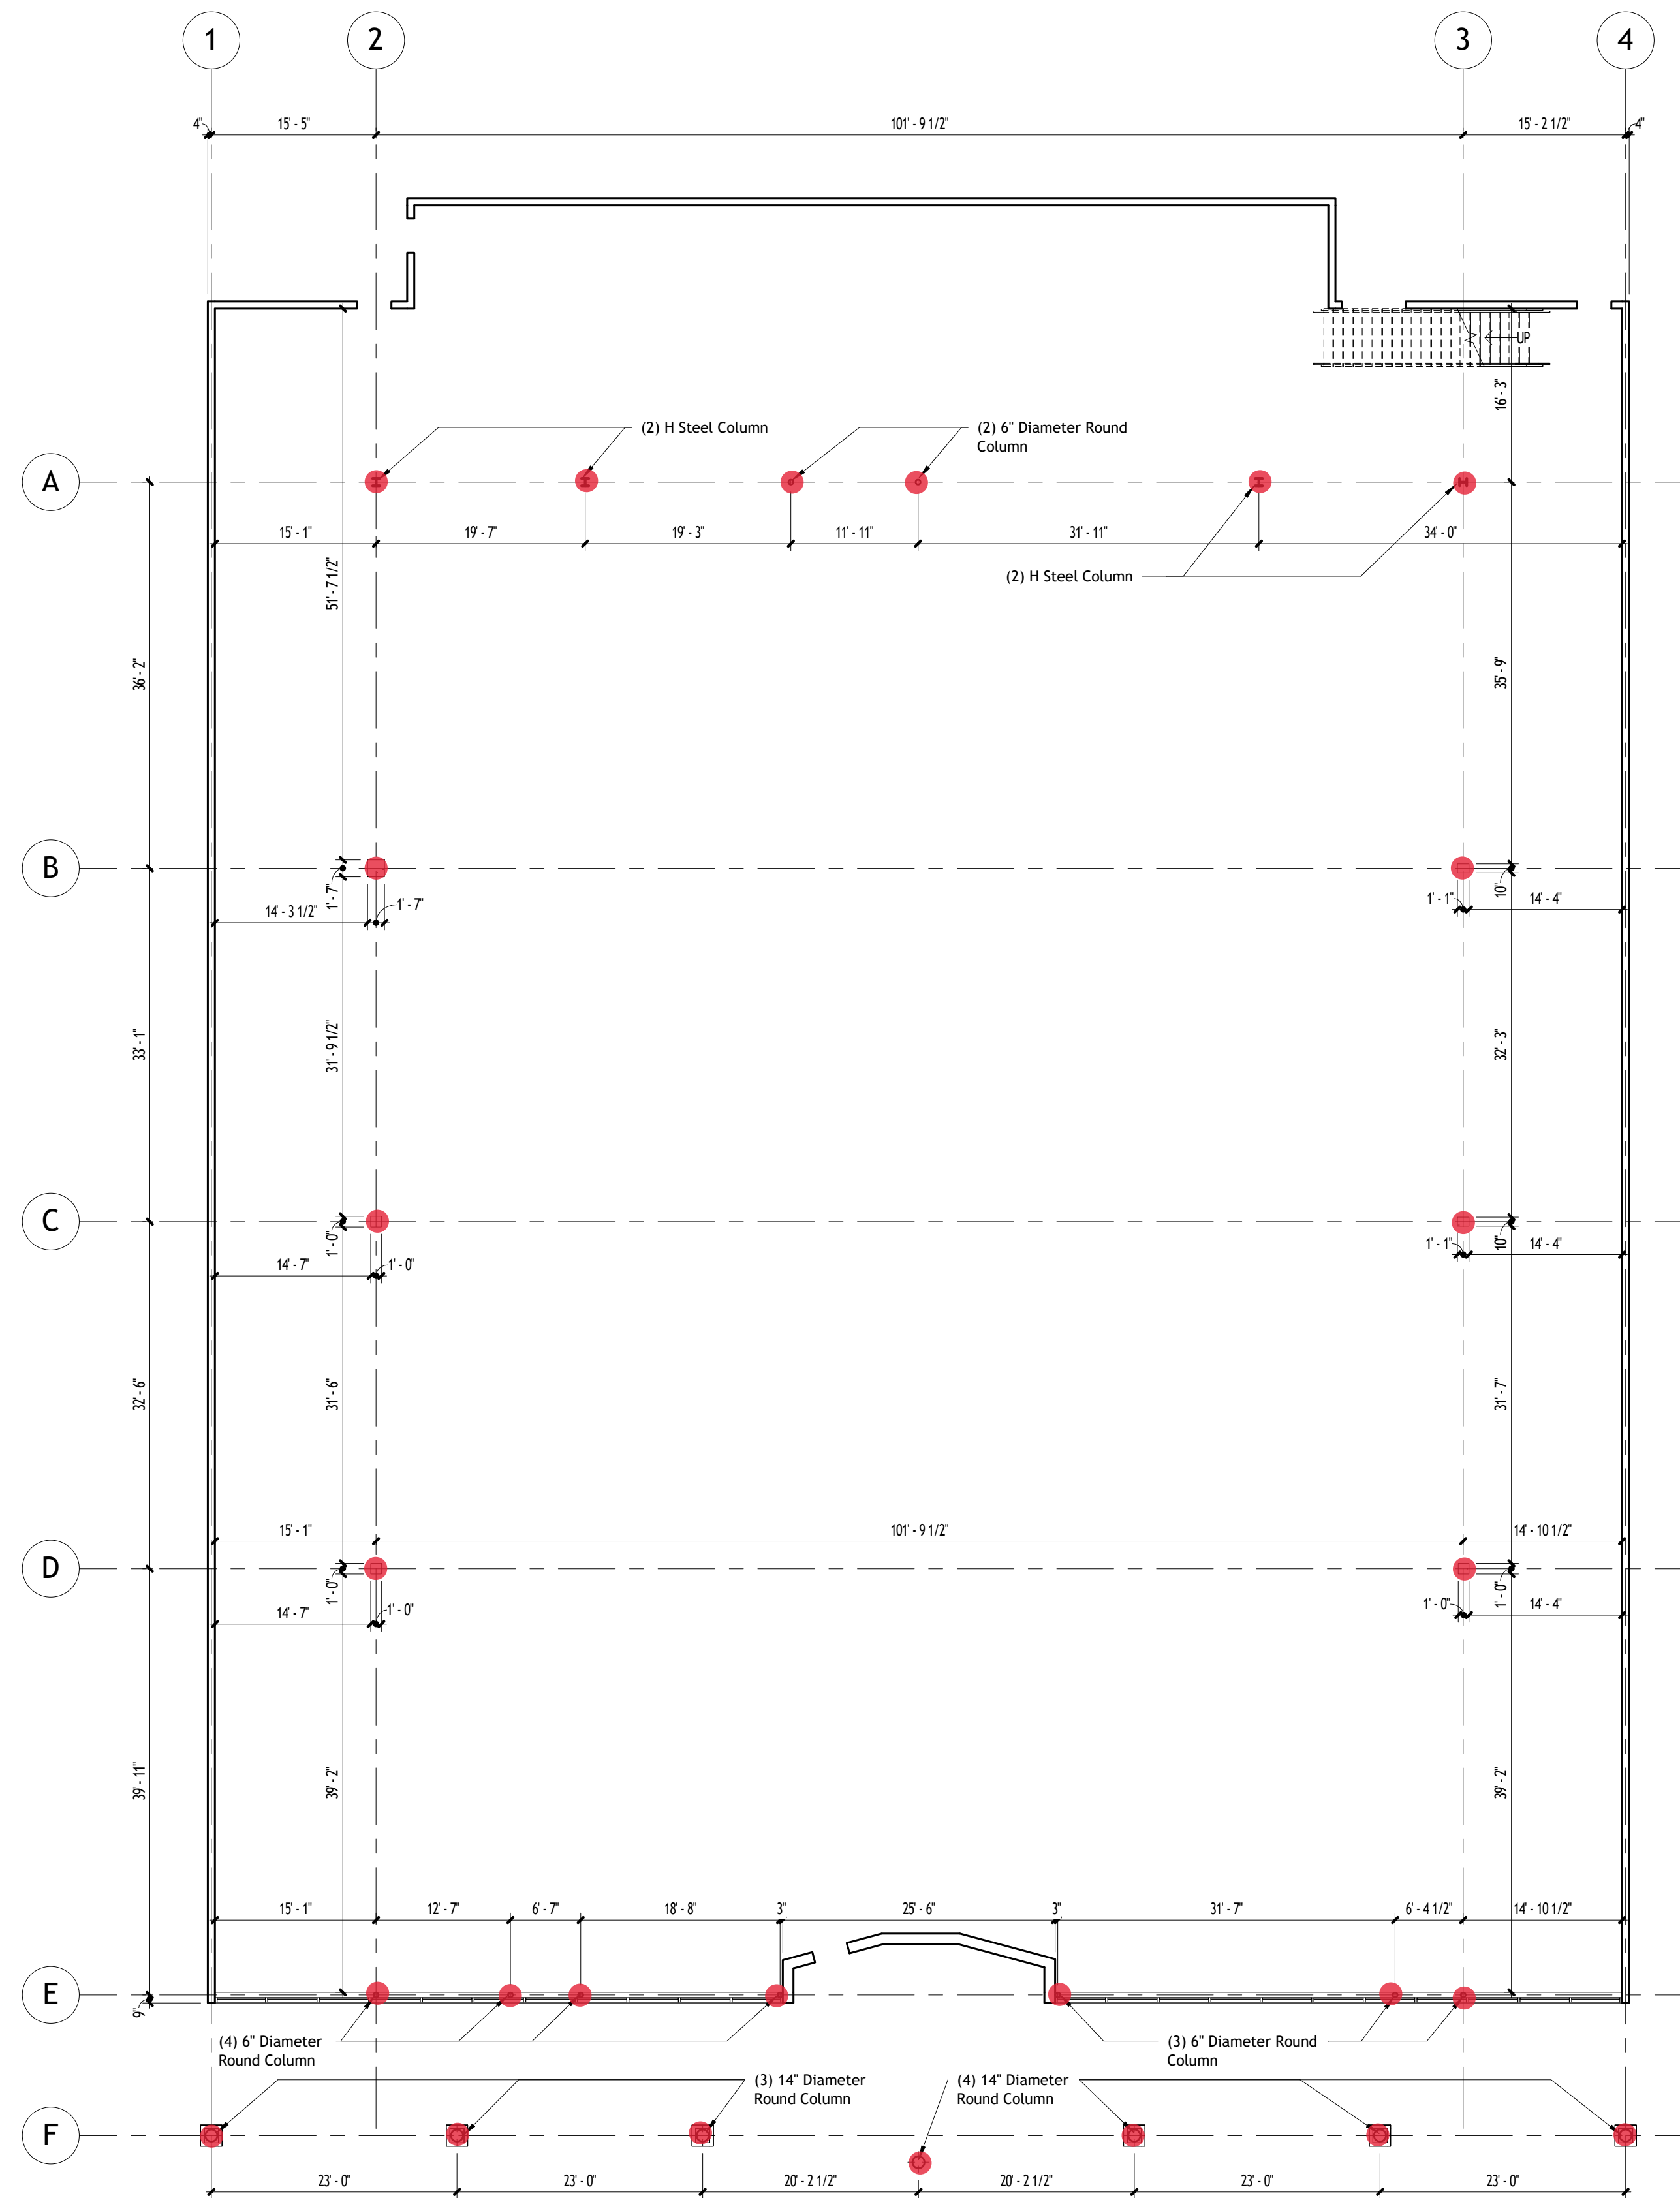

1 BUILDING 1ST FLOOR PLAN - COLUMN GRID
3/32" = 1'-0"

GENERAL NOTES:
- BUILDER TO REVIEW AND VERIFY ALL EXISTING CONDITIONS OF PROJECT DOCUMENTS, INCLUDING ALL EXISTING DIMENSIONS. IF DISCREPANCIES ARE DISCOVERED, OWNER MUST BE NOTIFIED PRIOR TO CONSTRUCTION EXECUTION.
- CONTRACTOR TO EVALUATE AND INSPECT ALL EXISTING CONDITIONS AND BECOME FAMILIAR WITH THE EXISTING CONDITIONS PRIOR TO COMMENCEMENT OF CONSTRUCTION.