


342 E THOMAS RD
±1,784 SF

RENT

- \$26.50/sf/yr, MG
- Term: 5-10 years



Hypothetical Plan

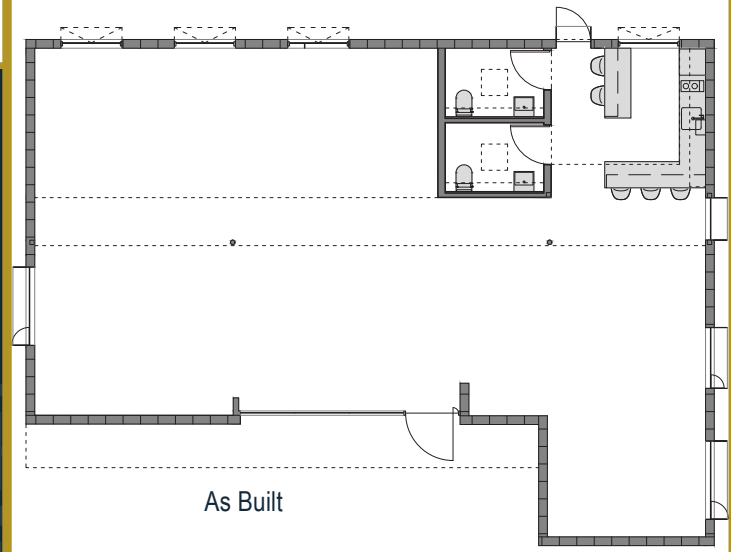

As Built

FURNITURE NOT INCLUDED