


2A FIRST FLOOR EXISTING AS-BUILT PLAN  
SCALE: 1/4" = 1'-0"

**Existing Conditions  
As-Built**  
3039 Main Street  
Glastonbury, CT 06033

THIS IS AN ORIGINAL DOCUMENT AND IS NOT TO BE COPIED OR REPLICATED IN ANY WAY. DRAWINGS AND DESIGNS ARE PROPERTY OF PEGARCH LLC AND ARE PROTECTED BY TERMS AND BYLAWS. DRAWINGS ARE NOT VALID UNLESS STAMPED WITH SEAL IN AREA BELOW. PLEASE CONTACT ARCHITECT FOR ADDITIONAL COPIES OR MORE INFORMATION. DRAWINGS ARE PROTECTED BY 2021 COPYRIGHT.

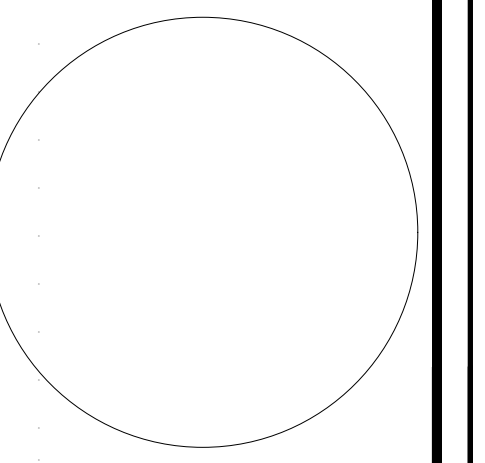

SHEET NAME  
**AS-BUILT  
DRAWINGS**

SHEET ID  
**A-100**