


877 YGNACIO VALLEY RD
SUITE 220
WALNUT CREEK, CA

SUITE 220 AS-BUILT PLAN

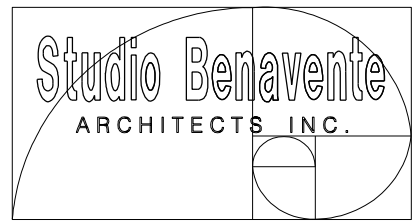


580 LENNON LANE, WALNUT CREEK CA 94598
TEL 925.934.7778 FAX 925.934.7902 studioark@aol.com



2/27/15

DRAWN:

SAR

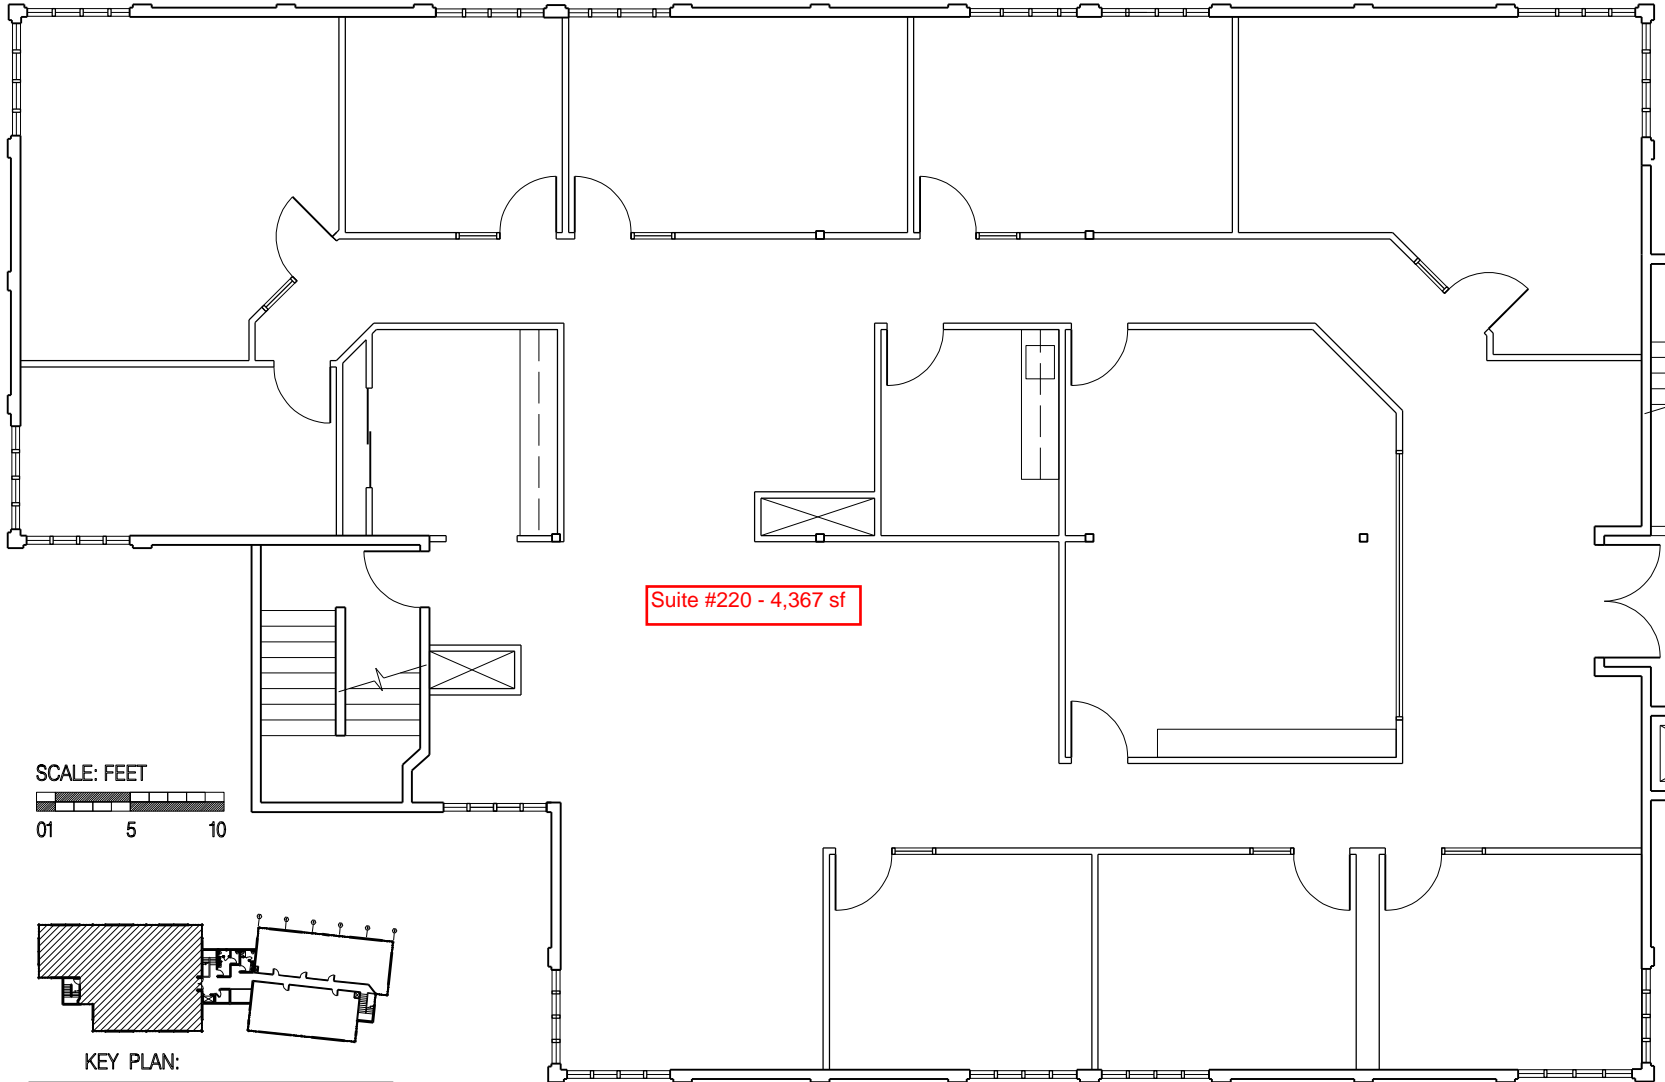

SCALE: FEET

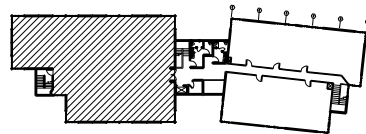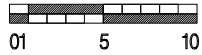

KEY PLAN: