


1
A2.1

FLOOR PLAN - PRELIMINARY

SCALE: 1/4" = 1'-0"

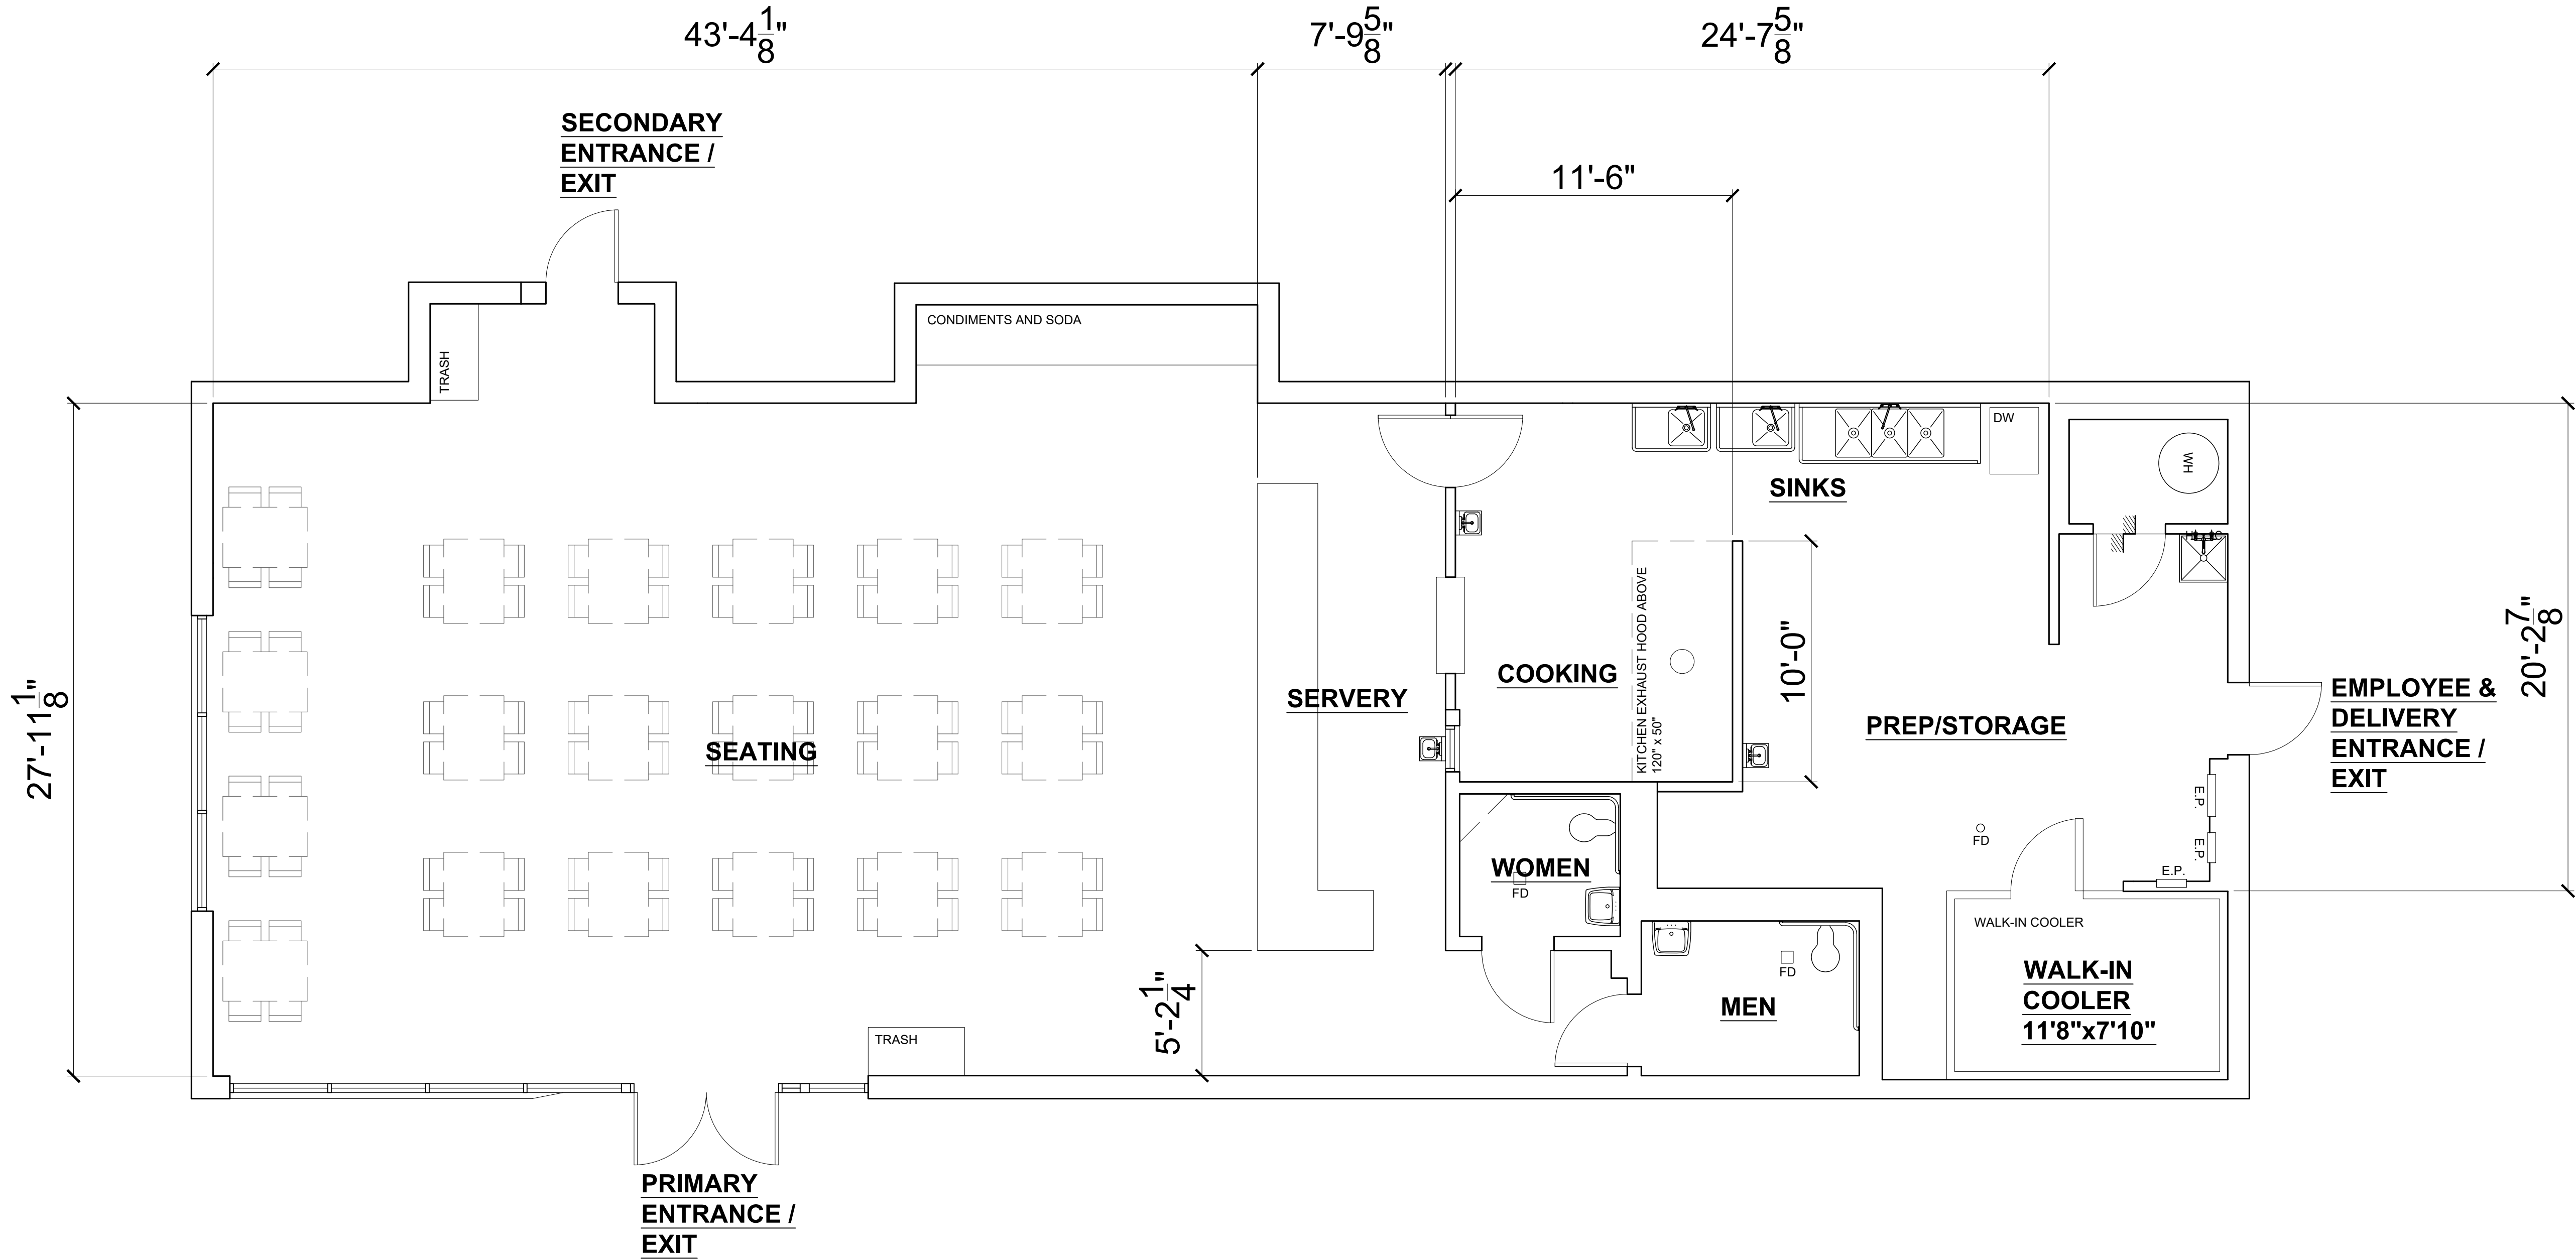

REVISONS	NO	DATE

COPYRIGHT
THIS DRAWING AND ALL
REPRODUCTIONS ARE
THE PROPERTY OF
ALL ARCHITECTURE, LLC AND
MAY NOT BE USED IN ANY WAY
WITHOUT THEIR PERMISSION.

PROJECT TITLE:
4346 FULTON INDUSTRIAL BLVD
AS-BUILTS
4346 FULTON INDUSTRIAL BLVD SW
ATLANTA, GEORGIA 30336

SEAL:

PRELIMINARY

DRAWN: JCA	CHECKED: JCA
APPROVED: JCA	ISSUE DATE: 01/20/24

CAD FILE NAME:
24001.dwg

SHEET TITLE:
PRELIMINARY
FLOOR PLAN

PROJECT NUMBER:
24001

SHEET NO:

A2.1

SHEET 2 OF 2