

RECEIVED
 FEB 20 12 07 PM '91
 SUFFOLK COUNTY
 HEALTH DEPARTMENT

SUFFOLK COUNTY DEPARTMENT OF HEALTH SERVICES

Approval of Constructed Works


H.D. Ref. No. C02-88-197

The sewage disposal and water supply facilities at this location have been satisfactorily inspected by this Department and are in compliance with these as-built plans

MAY 01 1991
 DATE

Stephen A. Costa, P.E.

CHIEF OF GENERAL
 ENGINEERING SERVICES

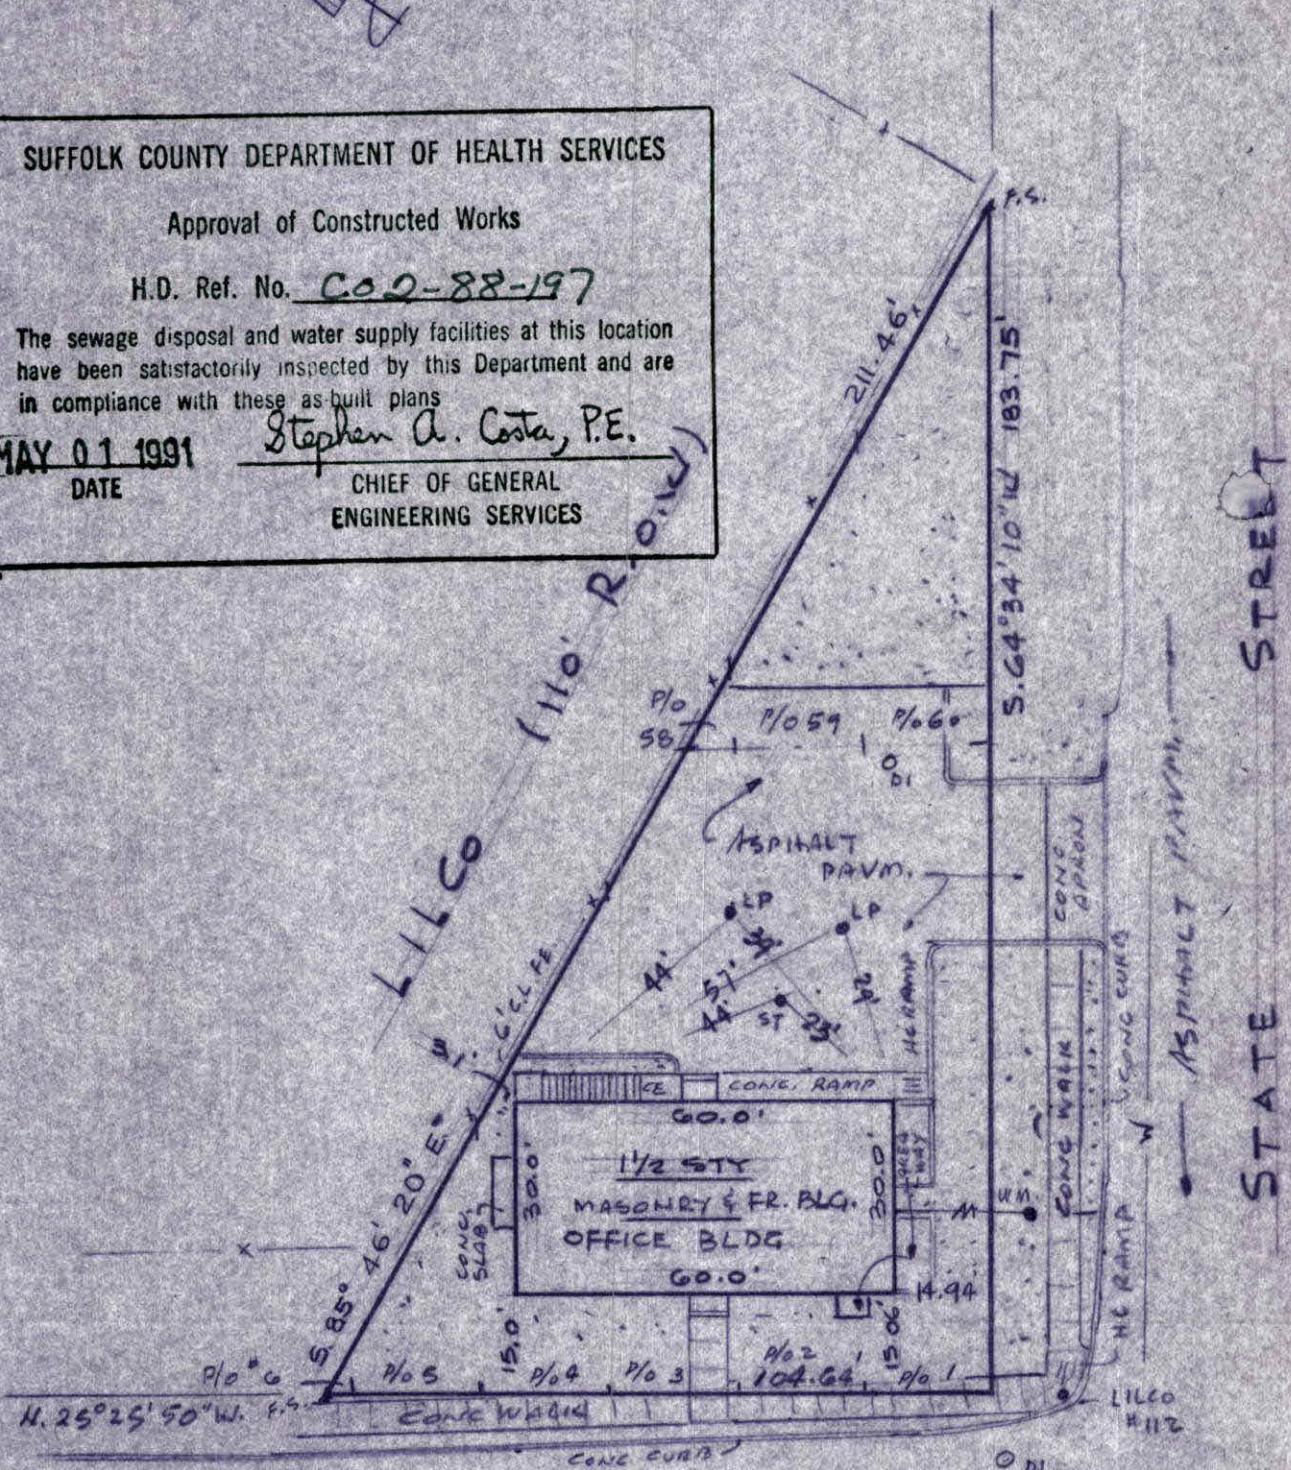

N.Y.S. ROUTE 112

GUARANTEED ONLY TO
 SYNDICATED TITLE AGENCY
 SUFFOLK COUNTY NATIONAL BANK
 FRANK & CAROL ANZINI

FINAL 12-8-90
 S.C. TAX MAP NO 200-182-4-16,34



1-17-28
 # 49
 P/O MAP OF PORT JEFFERSON VILLAS
 LOCATED IN PORT JEFFERSON STA.
 TOWN OF BROOKHAVEN,
 COUNTY OF SUFFOLK, N.Y.

LOUIS T. ROMEO
 ENGINEER-LAND SURVEYOR

CONSULTING ENGINEER
 781 N.Y.S. ROUTE 25A, P.O. BOX 1106
 SETAUKET, N.Y., 11733
 516-941-4252

DATE	REVISED	PROJECT NUMBER	SCALE	SHEET OF
2/5/86	10-20-90	1948-85	1" = 30'	() OF ()
10-31-90	12-10-90			

Convenience Rescan