


BRIAN DE VRIESE
ARCHITECT
ERICA GEES AIA
12 Main Street P.O. Box 145
Shillington Falls, MA 01370
Phone/ Fax: (413) 625-8888

Date: November 20, 2010
Scale: as noted
Drawn: E.G.
Reviewed:

Title:
Floor Plan/Second Level
AS-BUILT

STIEBEL PROPERTIES
Renovations and
Improvements
to the
UNITY PRESS BUILDING
Suffolk Street
Holyoke, MA

Sheet No.
A-2

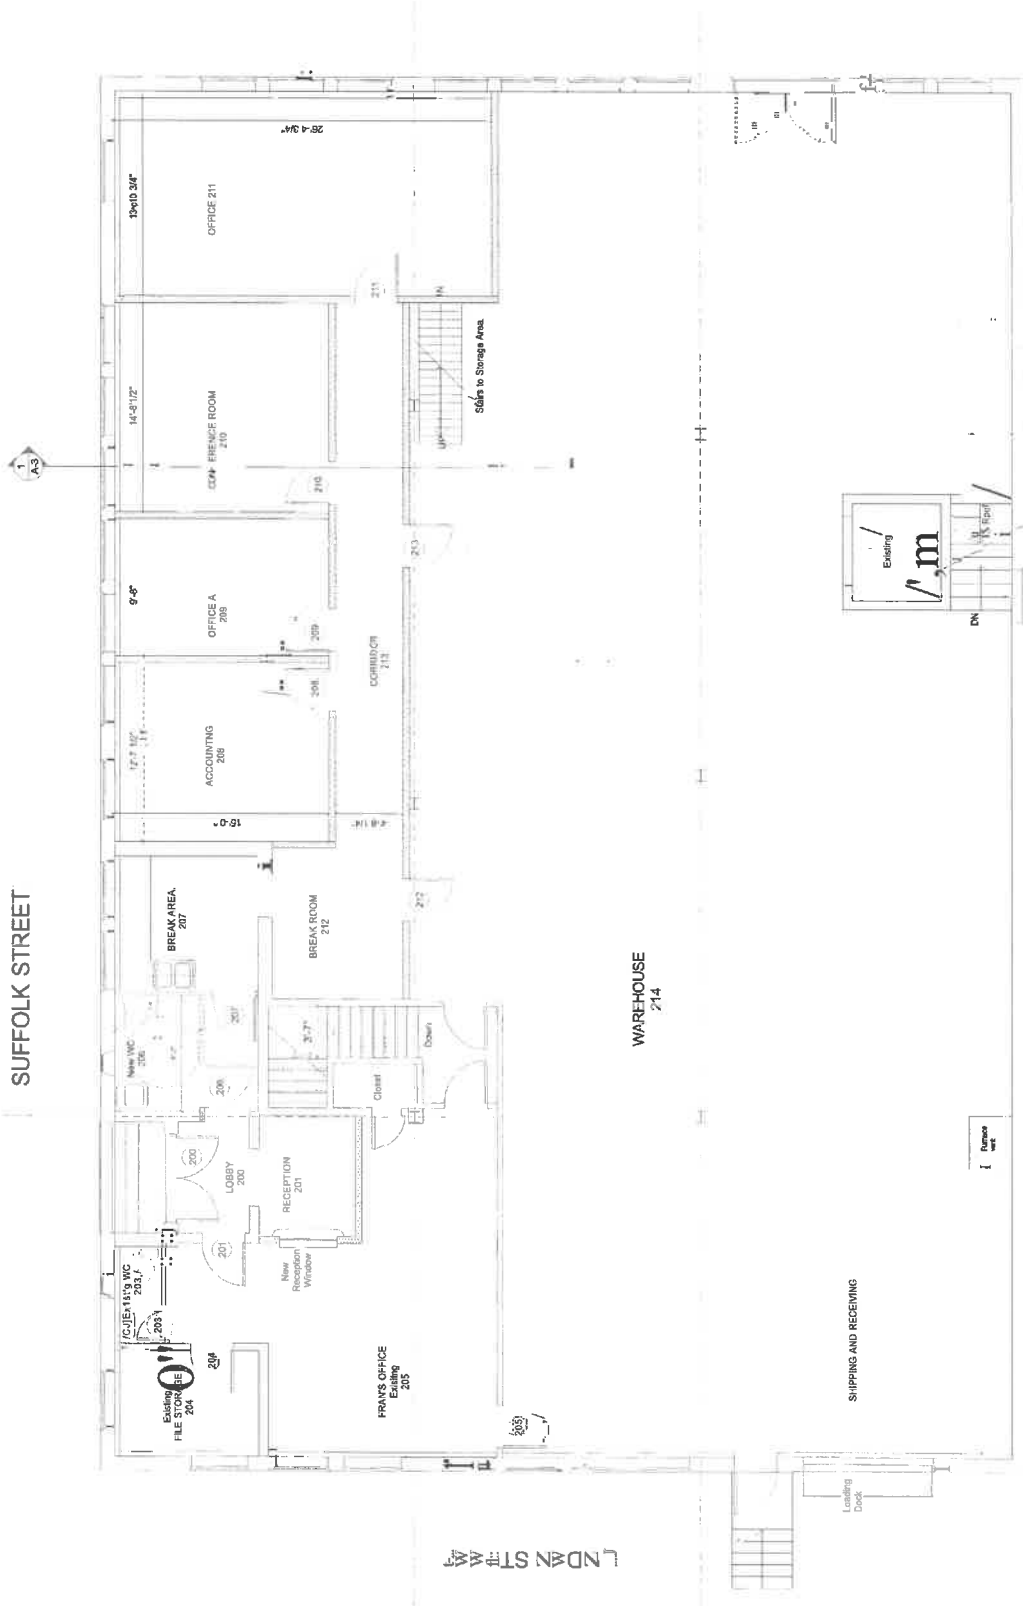

1 | Level Two Plan
Scale = 1/4" = 10"