

36700 Woodward Avenue

Suite 203

BIRMINGHAM, MICHIGAN



2075 West Big Beaver, Suite 100

Troy, Michigan 48084

Telephone 248.341.3999

Facsimile 248.646.3744


www.dietzpropertygroup.com

FLOOR PLAN


FOR LEASING INFORMATION,
CONTACT: BRIAN SALLIOTTE
(248) 341-3320

22-590

11/17/22

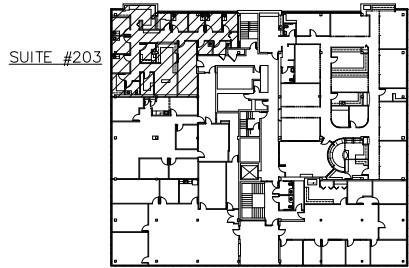

SECOND FLOOR KEYPLAN
NOT TO SCALE

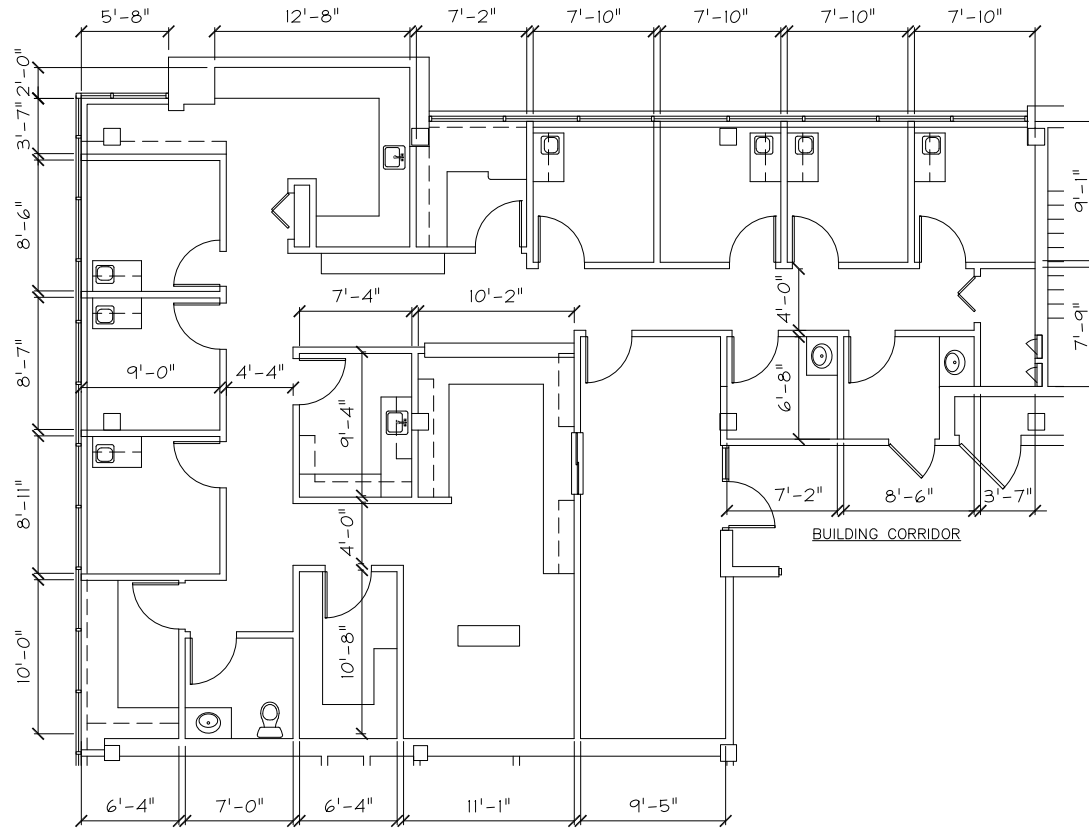

BUILDING CORRIDOR

AS-BUILT FLOOR PLAN
2,400 RSF



GRAPHIC SCALE

NOTE: INTERIOR DIMENSIONS ARE SHOWN FOR GENERAL REFERENCE ONLY.