
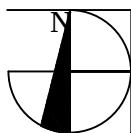



127 West Pepper Place
Mesa . Arizona
Suite 101 - 1,130 SF

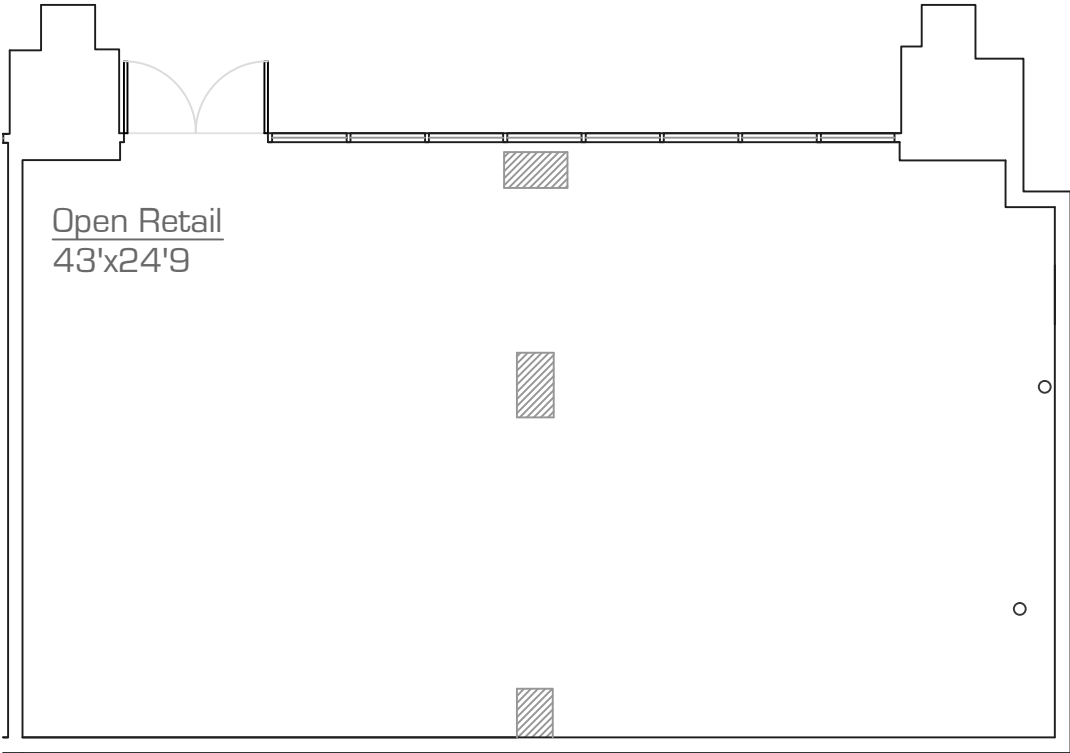

As-Built - floor plan

scale: 1/8" = 1'-0"
9.December.2024

*All dimensions are approximate at ± 3"
*All information is of general nature

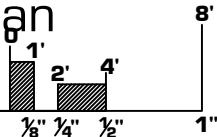

precisionDIMENSIONS

as-built & survey
602.790.6412

