

PRICE: \$18.00 - 24.00 SF/YR

WALL TOWERS | EAST & WEST

201-203 W Wall St, Midland, TX 79701

Stephanie Gauthier

Agent | Marketing Specialist
214.450.9398
stephanie@moriahrealestate.com

Wes Gotcher

Broker | President
432.682.2510
wes@moriahrealestate.com

Trey Dennis

Broker
432.236.7500
trey@moriahrealestate.com

PRICE: \$18.00 - 24.00 SF/YR

WALL TOWERS | EAST & WEST

201-203 W Wall St, Midland, TX 79701



Property Description

The East Tower built in 1963 consists of 9 stories for a total of 66,000 SF. The West Tower built in 1968 consists of 12 stories for a total of 123,513 SF. Tenants have access to Sweat Equity Gym on 2nd Floor for \$35/month.

Location Description

Located in Downtown Midland, the two Wall Towers (East and West) are full of history and character. With recent downtown development, these office buildings are within walking distance to the newly built Centennial Park, Pi Social, Opal's Table, and Cancun Bar and Grill.

Offering Summary

Lease Rate:	\$17.00 - 45.00 SF/yr
Available SF:	333 - 7,478 SF
Lot Size:	0.55 Acres

Stephanie Gauthier

Agent | Marketing Specialist
214.450.9398
stephanie@moriahrealstate.com

Wes Gotcher

Broker | President
432.682.2510
wes@moriahrealstate.com

Trey Dennis

Broker
432.236.7500
trey@moriahrealstate.com



PRICE: \$18.00 - 24.00 SF/YR

WALL TOWERS | EAST & WEST

201-203 W Wall St, Midland, TX 79701



Stephanie Gauthier
Agent | Marketing Specialist
214.450.9398
stephanie@moriahrealstate.com

Wes Gotcher
Broker | President
432.682.2510
wes@moriahrealstate.com

Trey Dennis
Broker
432.236.7500
trey@moriahrealstate.com

MORIAH
BROKERAGE SERVICES, LLC

PRICE: \$18.00 - 24.00 SF/YR

WALL TOWERS | EAST & WEST

201-203 W Wall St, Midland, TX 79701

AVAILABLE SPACES

Suite	Tenant	Size (SF)	Lease Type	Lease Rate
West Tower Suite 320	Available	1,009 SF	Modified Gross	\$20.00 SF/yr
West Tower Suite 328	Available	333 SF	Modified Gross	\$20.00 SF/yr
West Tower Suite 330	Available	1,453 SF	Modified Gross	\$18.00 SF/yr
West Tower Suite 524	Available	2,557 SF	Modified Gross	\$19.00 SF/yr
West Tower Suite 601	Available	2,657 SF	Modified Gross	\$18.00 SF/yr
West Tower Suite 700	Available	2,651 SF	Modified Gross	\$24.00 SF/yr
West Tower Suite 808	Available	5,616 SF	Modified Gross	\$20.00 SF/yr
West Tower Suite 904	Available	4,351 SF	Modified Gross	\$20.00 SF/yr
West Tower Suite 920	Available	1,910 SF	Modified Gross	\$18.00 SF/yr
West Tower Suite 1004	Available	1,056 SF	Modified Gross	\$19.00 SF/yr
West Tower Suite 1006	Available	1,801 SF	Modified Gross	\$19.00 SF/yr
East Tower Suite 400	Available	1,857 SF	Modified Gross	\$19.00 SF/yr
East Tower Suite 401	Available	993 SF	Modified Gross	\$19.00 SF/yr
East Tower Suite 520	Available	1,547 SF	Modified Gross	\$20.00 SF/yr
East Tower Suite 530	Available	2,181 SF	Modified Gross	\$18.00 SF/yr
East Tower Suite 600	Available	7,478 SF	Modified Gross	\$20.00 SF/yr
East Tower Suite 700	Available	7,478 SF	Modified Gross	\$20.00 SF/yr
East Tower Suite 804	Available	2,322 SF	Modified Gross	\$20.00 SF/yr

Stephanie Gauthier

Agent | Marketing Specialist
214.450.9398
stephanie@moriahrealstate.com

Wes Gotcher

Broker | President
432.682.2510
wes@moriahrealstate.com

Trey Dennis

Broker
432.236.7500
trey@moriahrealstate.com




PRICE: \$18.00 - 24.00 SF/YR

WALL TOWERS | WEST 3RD FLOOR | SUITE 320

201-203 W Wall St, Midland, TX 79701

#320
100a st.

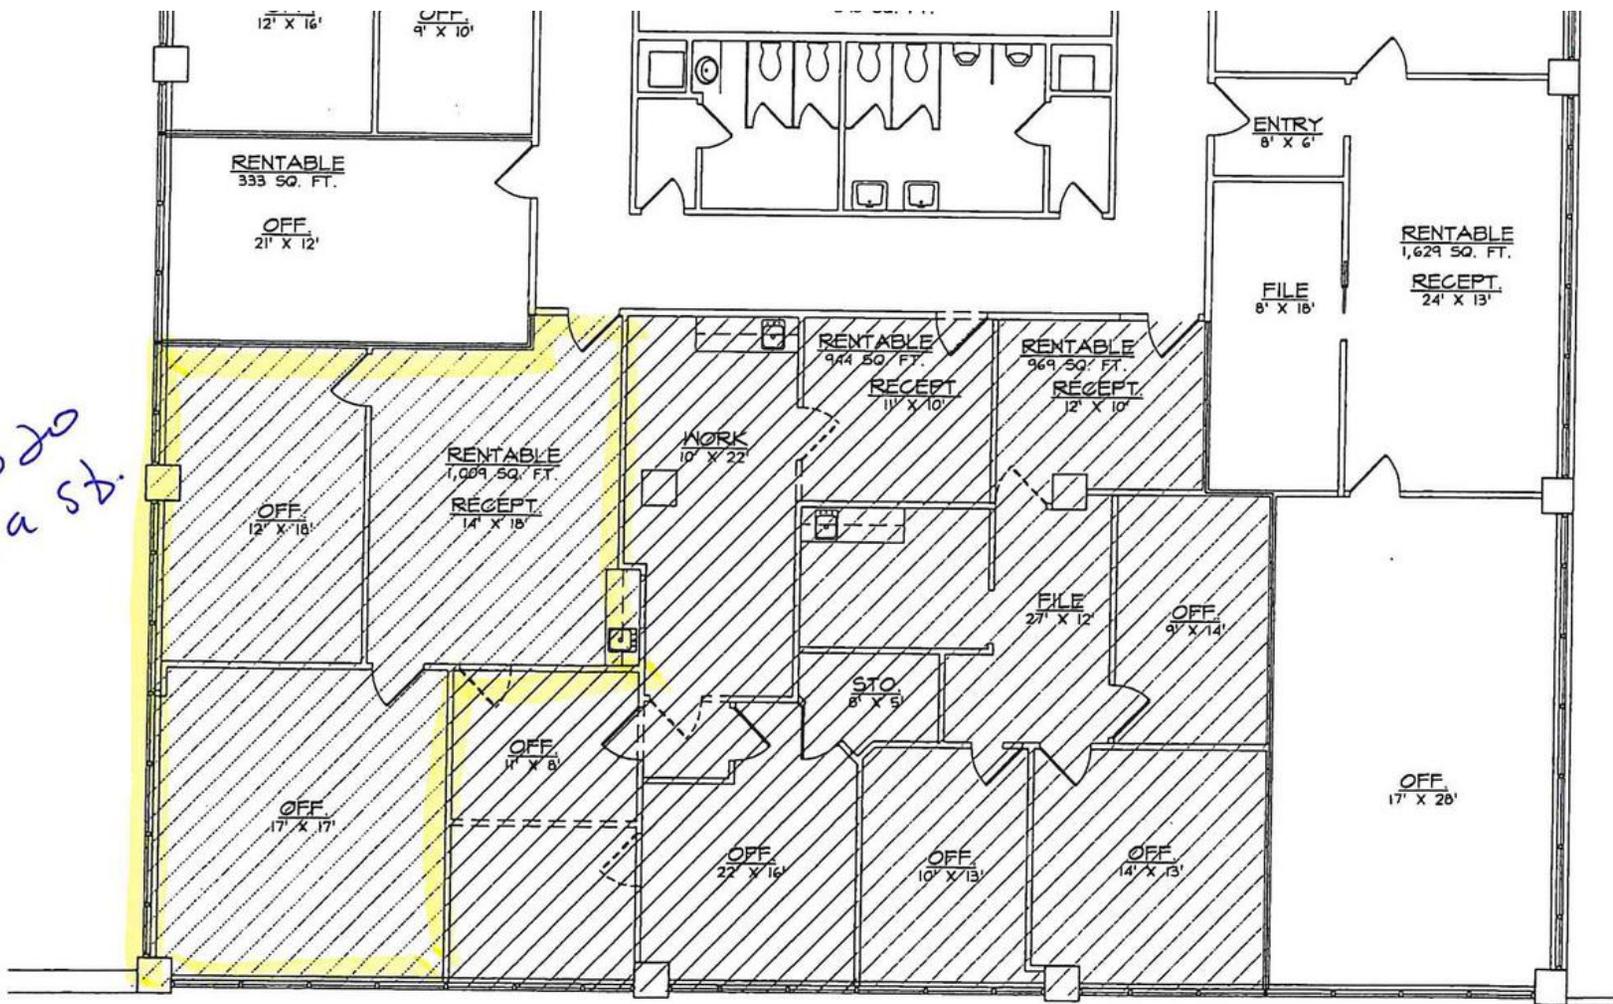

A AS-BUILT FLOOR PLAN

10TH FLOOR

3/16" = 1'-0"

PREPARED BY:

MDRAFTING & DESIGN

Stephanie Gauthier

Agent | Marketing Specialist
214.450.9398
stephanie@moriahrealstate.com

Wes Gotcher

Broker | President
432.682.2510
wes@moriahrealstate.com

Trey Dennis


Broker
432.236.7500
trey@moriahrealstate.com

MORIAH
BROKERAGE SERVICES, LLC

PRICE: \$18.00 - 24.00 SF/YR

WALL TOWERS | WEST 3RD FLOOR | SUITE 328

201-203 W Wall St, Midland, TX 79701

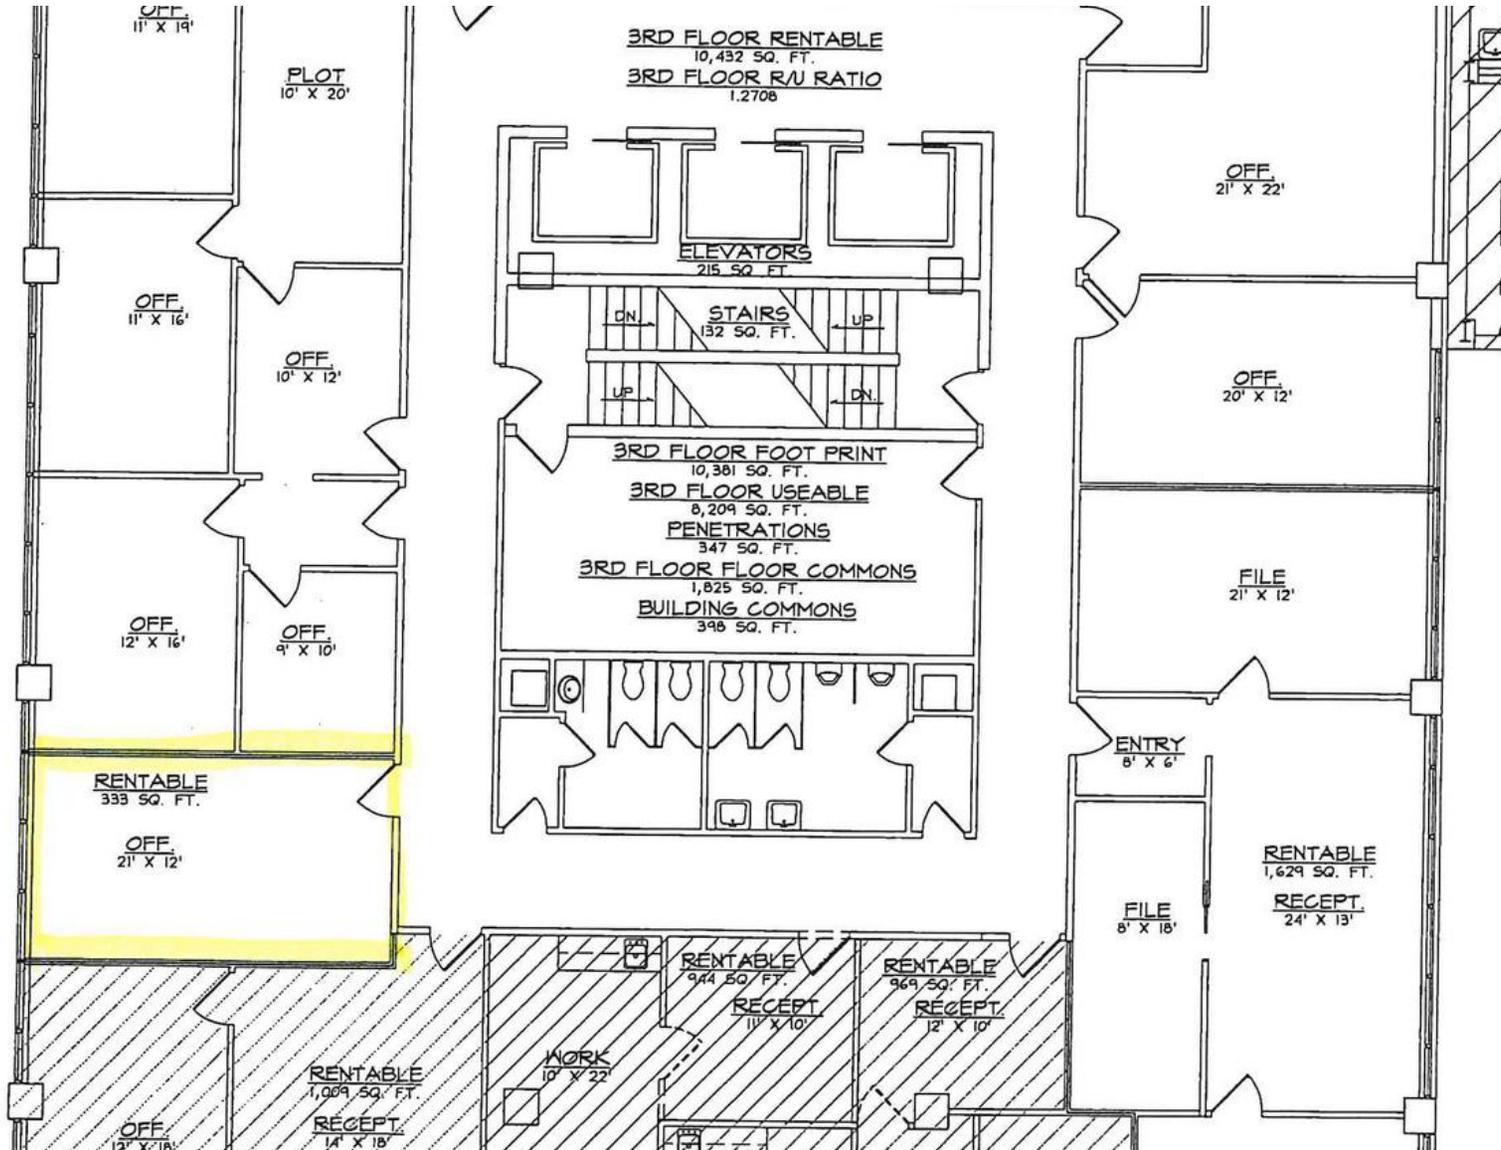

Stephanie Gauthier
Agent | Marketing Specialist
214.450.9398
stephanie@moriahrealstate.com

Wes Gotcher
Broker | President
432.682.2510
wes@moriahrealstate.com

Trey Dennis
Broker
432.236.7500
trey@moriahrealstate.com

PRICE: \$18.00 - 24.00 SF/YR

WALL TOWERS | WEST 3RD FLOOR | SUITE 328

201-203 W Wall St, Midland, TX 79701



Stephanie Gauthier

Agent | Marketing Specialist
214.450.9398
stephanie@moriahrealstate.com

Wes Gotcher

Broker | President
432.682.2510
wes@moriahrealstate.com

Trey Dennis


Broker
432.236.7500
trey@moriahrealstate.com



PRICE: \$18.00 - 24.00 SF/YR

WALL TOWERS | WEST 3RD FLOOR | SUITE 330

201-203 W Wall St, Midland, TX 79701

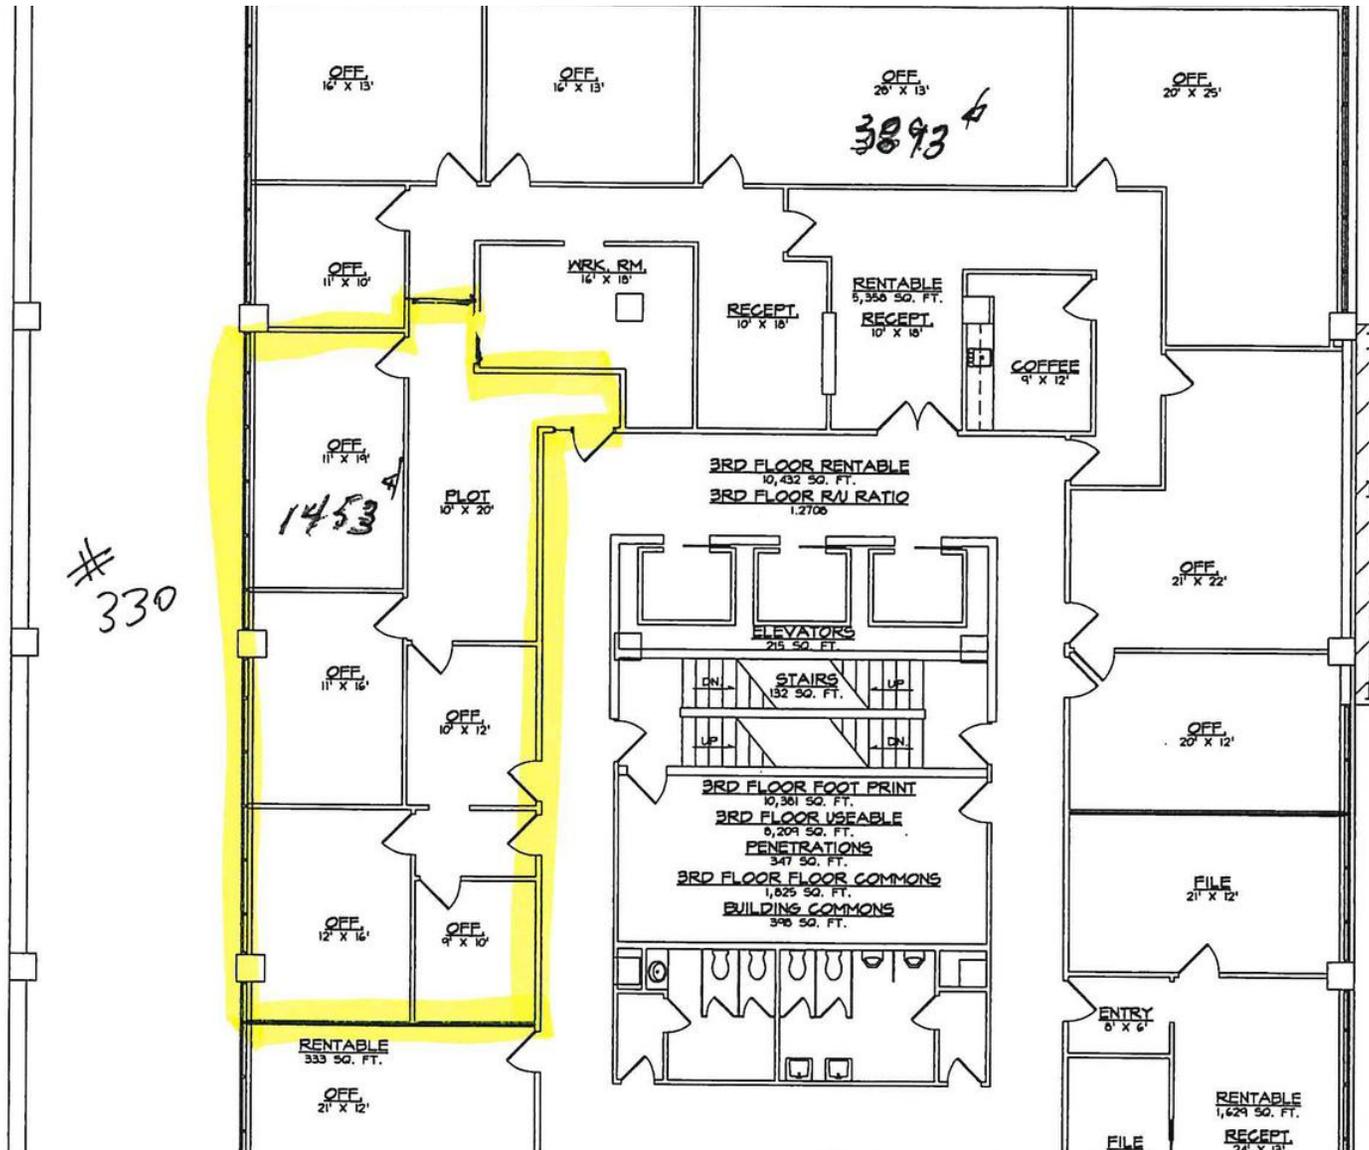

Stephanie Gauthier

Agent | Marketing Specialist
214.450.9398
stephanie@moriahrealstate.com

Wes Gotcher

Broker | President
432.682.2510
wes@moriahrealstate.com

Trey Dennis

Broker
432.236.7500
trey@moriahrealstate.com

MORIAH
BROKERAGE SERVICES, LLC

PRICE: \$18.00 - 24.00 SF/YR

WALL TOWERS | WEST 3RD FLOOR | SUITE 330

201-203 W Wall St, Midland, TX 79701



Stephanie Gauthier

Agent | Marketing Specialist
214.450.9398
stephanie@moriahrealstate.com

Wes Gotcher

Broker | President
432.682.2510
wes@moriahrealstate.com

Trey Dennis


Broker
432.236.7500
trey@moriahrealstate.com

 **MORIAH**
BROKERAGE SERVICES, LLC

PRICE: \$18.00 - 24.00 SF/YR

WALL TOWERS | WEST 5TH FLOOR | SUITE 524

201-203 W Wall St, Midland, TX 79701

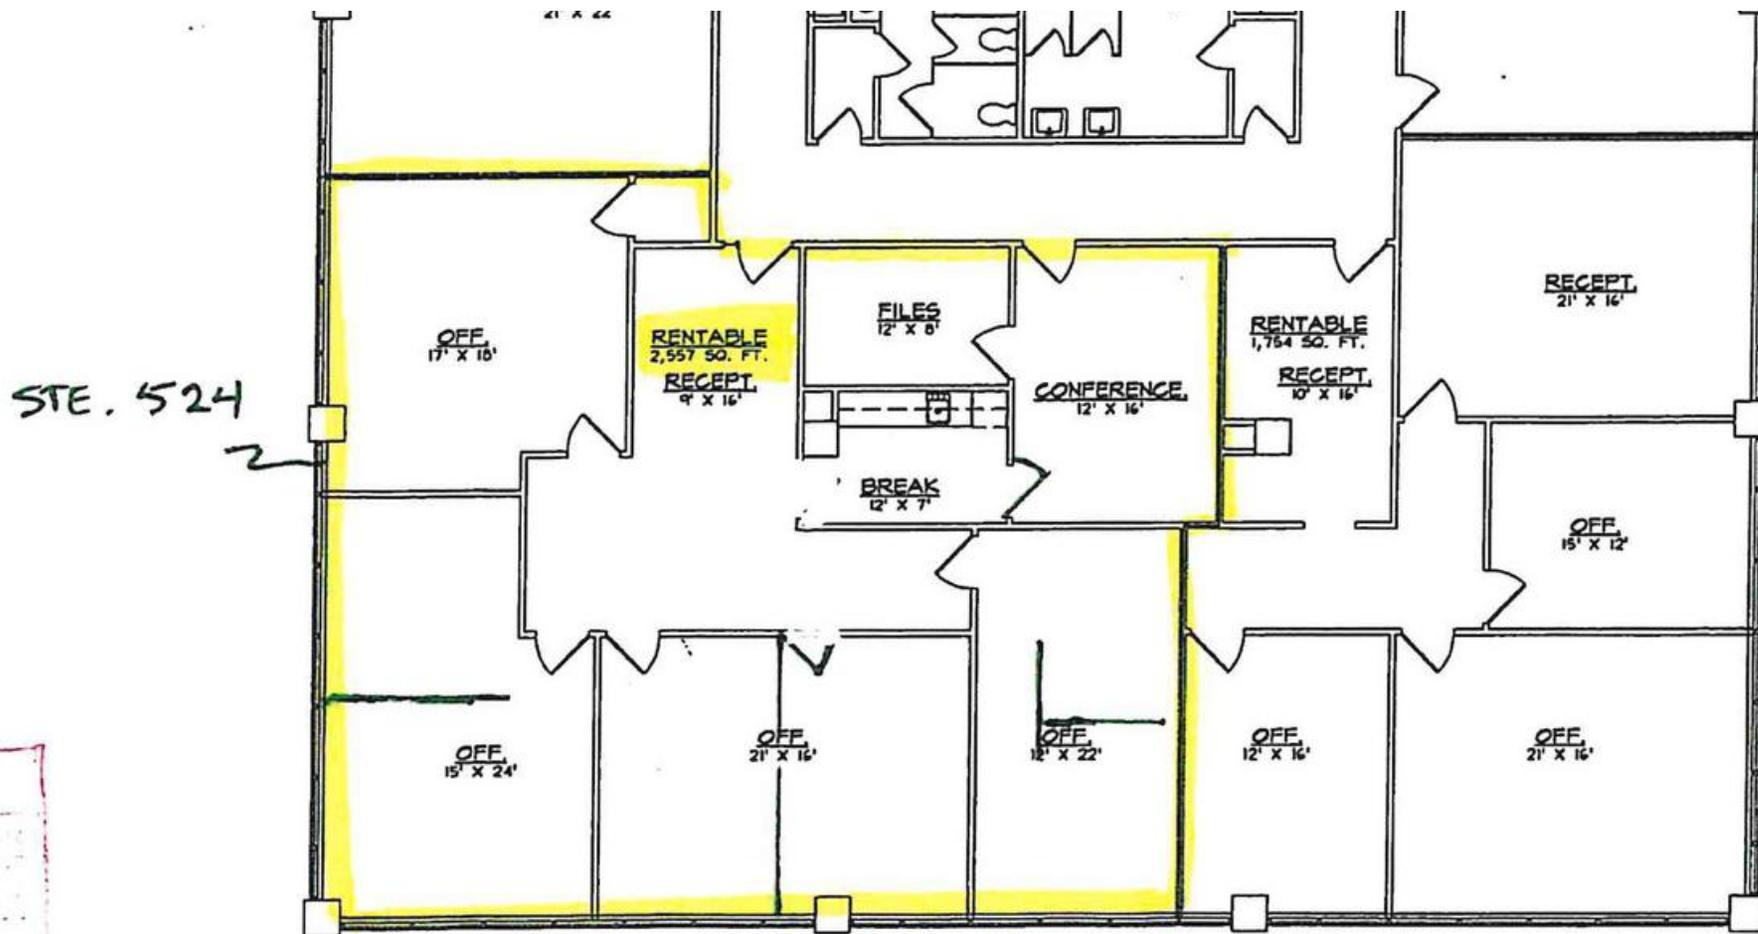

AS-BUILT FLOOR PLAN

5TH FLOOR

N. T. S.



PREPARED BY:

J M DRAFTING & DESIGN

COPYRIGHT, J M DRAFTING & DESIGN
2017 FEDERAL COPYRIGHT PRO-
TECTION, EXTENDING TO DERIVATIVE

Stephanie Gauthier

Agent | Marketing Specialist
214.450.9398
stephanie@moriahrealstate.com

Wes Gotcher

Broker | President
432.682.2510
wes@moriahrealstate.com

Trey Dennis

Broker
432.236.7500
trey@moriahrealstate.com

MORIAH
BROKERAGE SERVICES, LLC

PRICE: \$18.00 - 24.00 SF/YR

WALL TOWERS | WEST 5TH FLOOR | SUITE 524

201-203 W Wall St, Midland, TX 79701



Stephanie Gauthier

Agent | Marketing Specialist
214.450.9398
stephanie@moriahrealstate.com

Wes Gotcher

Broker | President
432.682.2510
wes@moriahrealstate.com

Trey Dennis


Broker
432.236.7500
trey@moriahrealstate.com



PRICE: \$18.00 - 24.00 SF/YR

WALL TOWERS | WEST 6TH FLOOR | SUITE 601

201-203 W Wall St, Midland, TX 79701

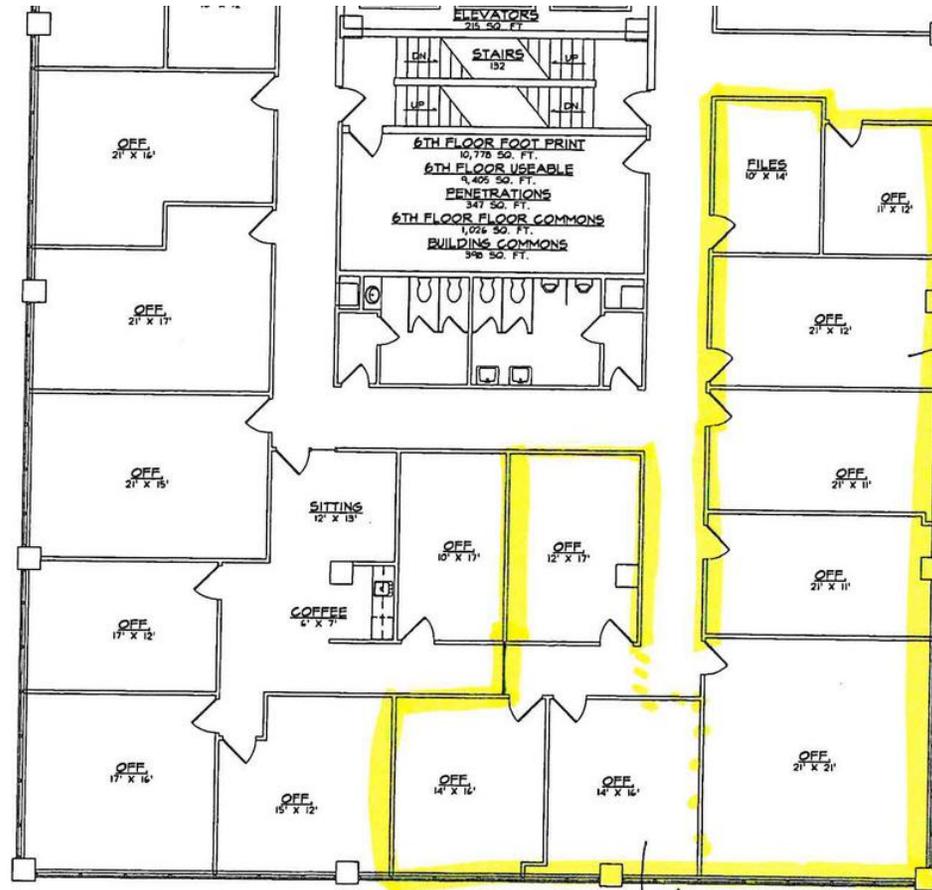

(A) AS-BUILT FLOOR PLAN
6TH FLOOR N. T. S.

PREPARED BY:
J M DRAFTING & DESIGN
NEW BUILDING FOR:
WALL TOWERS WEST
203 WALL STREET
MIDLAND TEXAS

© COPYRIGHT, J M DRAFTING & DESIGN
2017 FEDERAL COPYRIGHT PROTECTION - EXTENDING TO DERIVATIVE PLANS, IS APPLICABLE TO INTENTIONAL AND UNINTENTIONAL INFRINGEMENTS AND PROVIDES FOR SPECIFIC STATUTORY DAMAGES BOTH CIVIL AND CRIMINAL. UNAUTHORIZED REPRODUCTION IN ANY FORM IS STRICTLY PROHIBITED AND FORBIDDEN.

DATE:
MARCH 10, 2017
JOB = J16000

Stephanie Gauthier
Agent | Marketing Specialist
214.450.9398
stephanie@moriahrealstate.com

Wes Gotcher
Broker | President
432.682.2510
wes@moriahrealstate.com

Trey Dennis
Broker
432.236.7500
trey@moriahrealstate.com

MORIAH
BROKERAGE SERVICES, LLC

PRICE: \$18.00 - 24.00 SF/YR

WALL TOWERS | WEST 6TH FLOOR | SUITE 601

201-203 W Wall St, Midland, TX 79701



Stephanie Gauthier

Agent | Marketing Specialist
214.450.9398
stephanie@moriahrealstate.com

Wes Gotcher

Broker | President
432.682.2510
wes@moriahrealstate.com

Trey Dennis


Broker
432.236.7500
trey@moriahrealstate.com

 **MORIAH**
BROKERAGE SERVICES, LLC

PRICE: \$18.00 - 24.00 SF/YR

WALL TOWERS | WEST 7TH FLOOR | SUITE 700

201-203 W Wall St, Midland, TX 79701

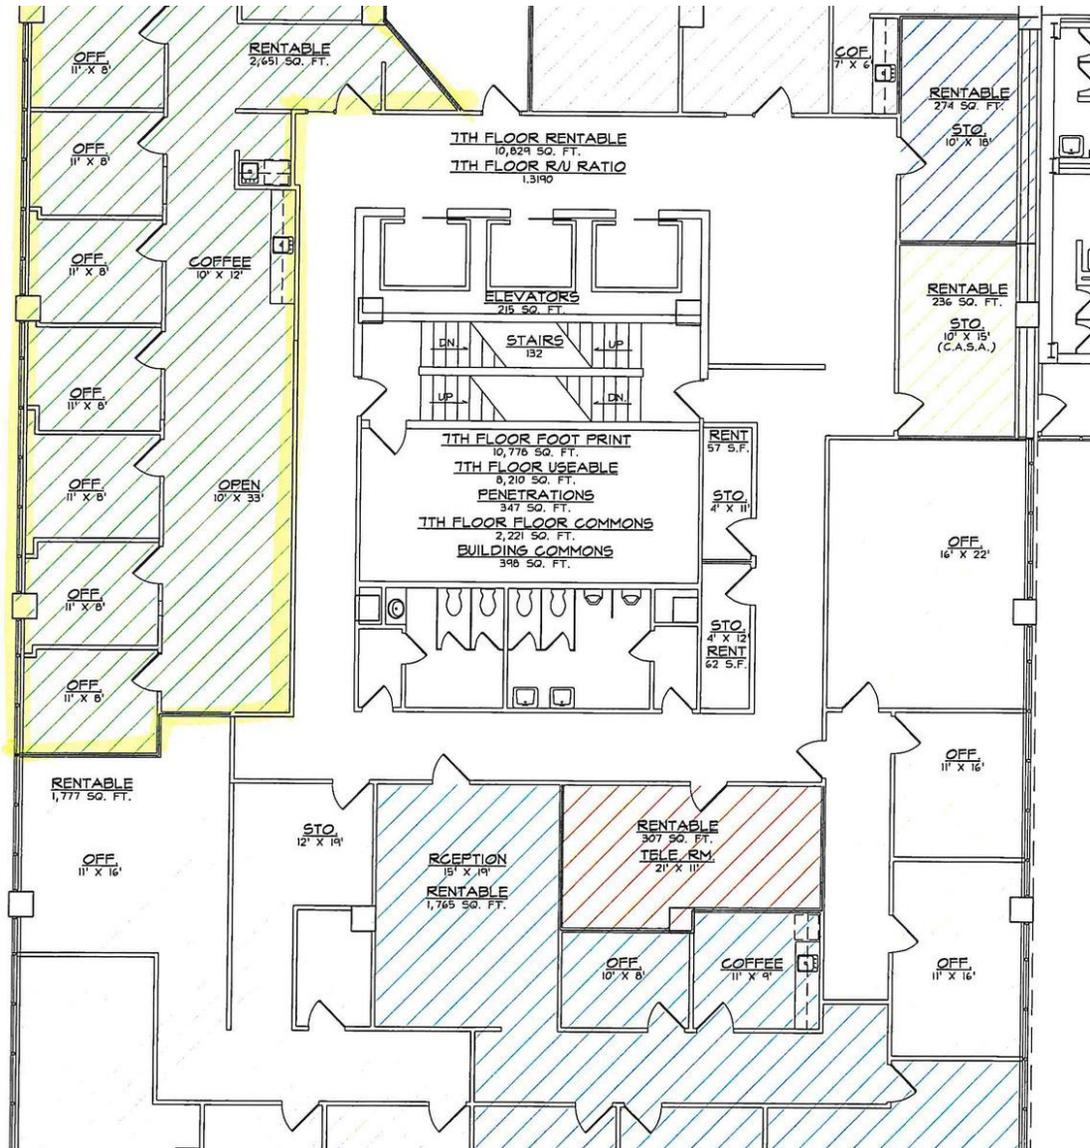

Stephanie Gauthier

Agent | Marketing Specialist
214.450.9398
stephanie@moriahrealstate.com

Wes Gotcher

Broker | President
432.682.2510
wes@moriahrealstate.com

Trey Dennis

Broker
432.236.7500
trey@moriahrealstate.com

MORIAH
BROKERAGE SERVICES, LLC

PRICE: \$18.00 - 24.00 SF/YR

WALL TOWERS | WEST 7TH FLOOR | SUITE 700

201-203 W Wall St, Midland, TX 79701



Stephanie Gauthier

Agent | Marketing Specialist
214.450.9398
stephanie@moriahrealstate.com

Wes Gotcher

Broker | President
432.682.2510
wes@moriahrealstate.com

Trey Dennis

Broker
432.236.7500
trey@moriahrealstate.com

MORIAH
BROKERAGE SERVICES, LLC

PRICE: \$18.00 - 24.00 SF/YR

WALL TOWERS | WEST 8TH FLOOR | SUITE 808

201-203 W Wall St, Midland, TX 79701



Stephanie Gauthier

Agent | Marketing Specialist
214.450.9398
stephanie@moriahrealstate.com

Wes Gotcher

Broker | President
432.682.2510
wes@moriahrealstate.com

Trey Dennis


Broker
432.236.7500
trey@moriahrealstate.com

MORIAH
BROKERAGE SERVICES, LLC

PRICE: \$18.00 - 24.00 SF/YR

WALL TOWERS | WEST 9TH FLOOR | SUITE 904

201-203 W Wall St, Midland, TX 79701

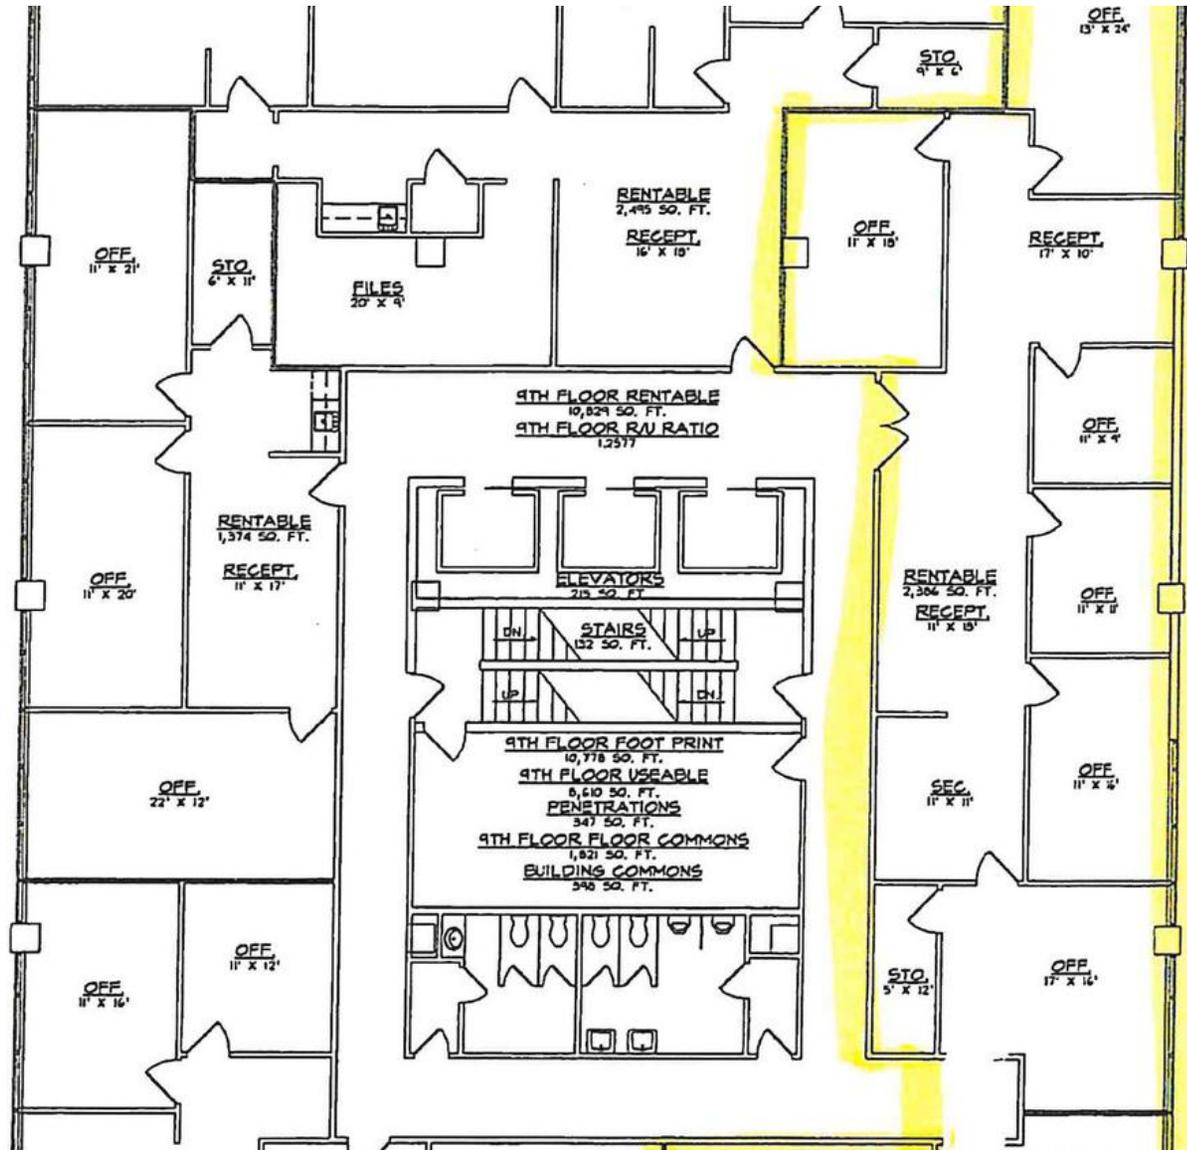

#904

PLEASE INITIAL

Stephanie Gauthier
Agent | Marketing Specialist
214.450.9398
stephanie@moriahrealstate.com

Wes Gotcher
Broker | President
432.682.2510
wes@moriahrealstate.com

Trey Dennis
Broker
432.236.7500
trey@moriahrealstate.com

MORIAH
BROKERAGE SERVICES, LLC

PRICE: \$18.00 - 24.00 SF/YR

WALL TOWERS | WEST 9TH FLOOR | SUITE 904

201-203 W Wall St, Midland, TX 79701



Stephanie Gauthier

Agent | Marketing Specialist
214.450.9398
stephanie@moriahrealstate.com

Wes Gotcher

Broker | President
432.682.2510
wes@moriahrealstate.com

Trey Dennis


Broker
432.236.7500
trey@moriahrealstate.com

MORIAH
BROKERAGE SERVICES, LLC

PRICE: \$18.00 - 24.00 SF/YR

WALL TOWERS | WEST 9TH FLOOR | SUITE 920

201-203 W Wall St, Midland, TX 79701

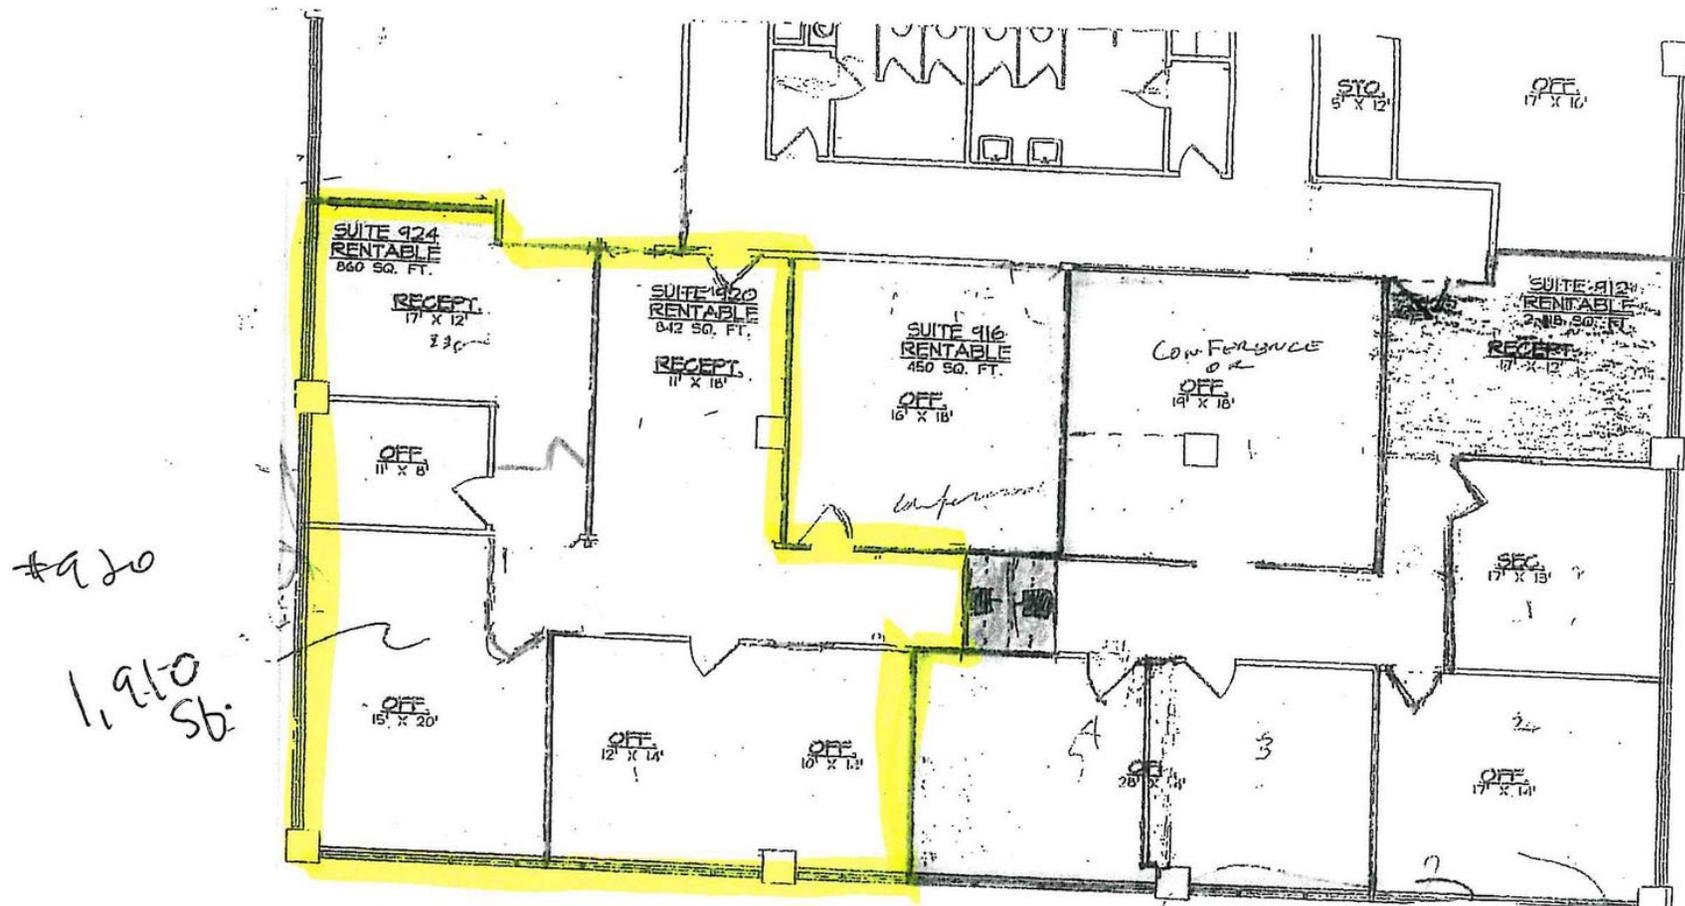

(A) AS-BUILT FLOOR PLAN
9TH FLOOR SE CORNER
N. Y. S.

PREPARED BY:
JM DRAFTING & DESIGN
NEW BUILDING FOR:
WALL TOWERS

© COPYRIGHT, J M DRAFTING & DESIGN
2011 FEDERAL COPYRIGHT PRO-
TECTION EXTENDING TO DERIVATIVE
PLANS, IS APPLICABLE TO INTEN-
TIONAL AND UNINTENTIONAL

Stephanie Gauthier
Agent | Marketing Specialist
214.450.9398
stephanie@moriahrealstate.com

Wes Gotcher
Broker | President
432.682.2510
wes@moriahrealstate.com

Trey Dennis
Broker
432.236.7500
trey@moriahrealstate.com



PRICE: \$18.00 - 24.00 SF/YR

WALL TOWERS | WEST 9TH FLOOR | SUITE 920

201-203 W Wall St, Midland, TX 79701



Stephanie Gauthier

Agent | Marketing Specialist
214.450.9398
stephanie@moriahrealstate.com

Wes Gotcher

Broker | President
432.682.2510
wes@moriahrealstate.com

Trey Dennis


Broker
432.236.7500
trey@moriahrealstate.com



PRICE: \$18.00 - 24.00 SF/YR

WALL TOWERS | WEST 10TH FLOOR | SUITE 1004

201-203 W Wall St, Midland, TX 79701

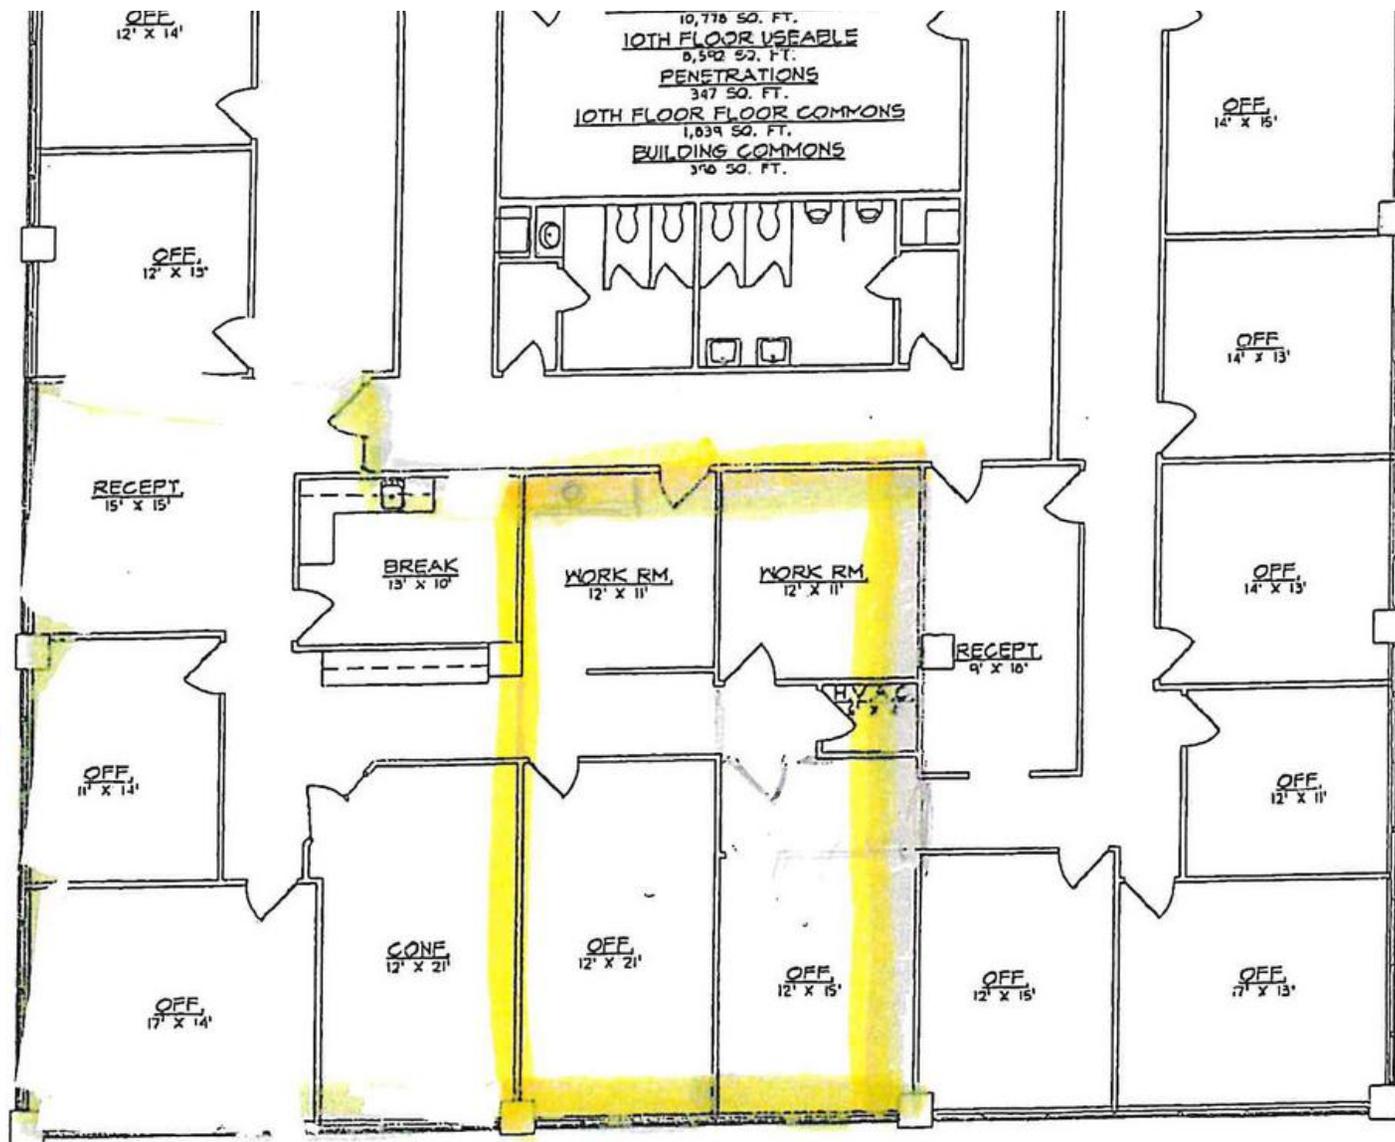

*10th floor
1004
1056 sq. ft.*

Stephanie Gauthier
Agent | Marketing Specialist
214.450.9398
stephanie@moriahrealstate.com

Wes Gotcher
Broker | President
432.682.2510
wes@moriahrealstate.com

Trey Dennis
Broker
432.236.7500
trey@moriahrealstate.com



PRICE: \$18.00 - 24.00 SF/YR

WALL TOWERS | WEST 10TH FLOOR | SUITE 1004

201-203 W Wall St, Midland, TX 79701



Stephanie Gauthier

Agent | Marketing Specialist
214.450.9398
stephanie@moriahrealstate.com

Wes Gotcher

Broker | President
432.682.2510
wes@moriahrealstate.com


Trey Dennis

Broker
432.236.7500
trey@moriahrealstate.com

PRICE: \$18.00 - 24.00 SF/YR

WALL TOWERS | WEST 10TH FLOOR | SUITE 1006

201-203 W Wall St, Midland, TX 79701

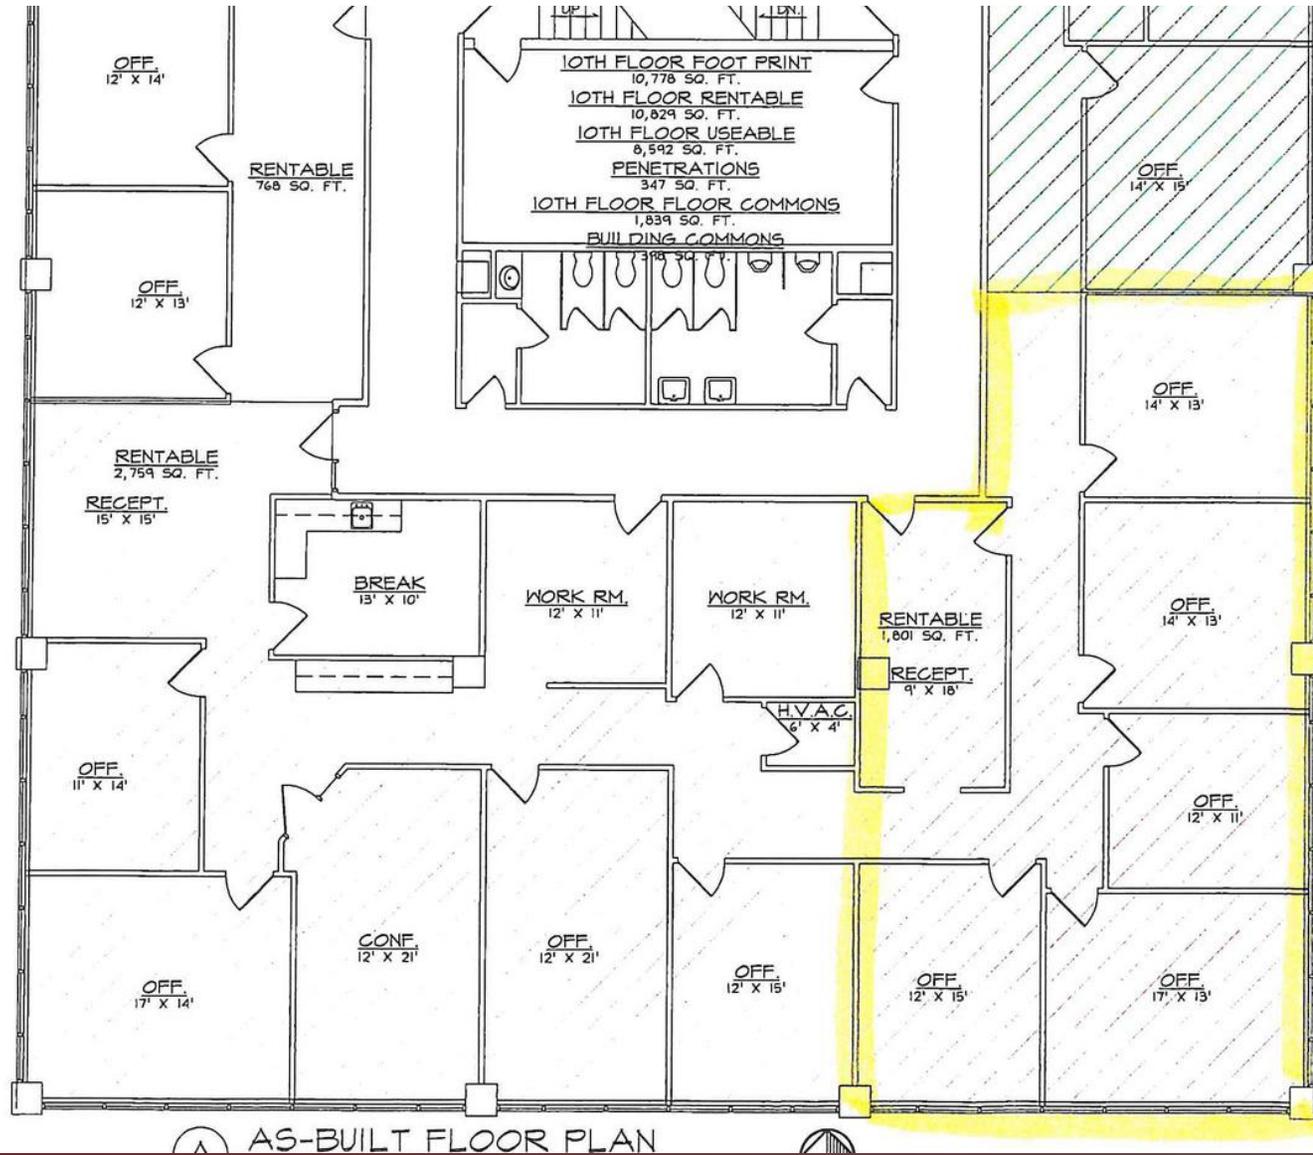

Stephanie Gauthier
Agent | Marketing Specialist
214.450.9398
stephanie@moriahrealstate.com

Wes Gotcher
Broker | President
432.682.2510
wes@moriahrealstate.com

Trey Dennis
Broker
432.236.7500
trey@moriahrealstate.com

MORIAH
BROKERAGE SERVICES, LLC

PRICE: \$18.00 - 24.00 SF/YR

WALL TOWERS | WEST 10TH FLOOR | SUITE 1006

201-203 W Wall St, Midland, TX 79701



Stephanie Gauthier

Agent | Marketing Specialist
214.450.9398
stephanie@moriahrealstate.com

Wes Gotcher

Broker | President
432.682.2510
wes@moriahrealstate.com

Trey Dennis

Broker
432.236.7500
trey@moriahrealstate.com

MORIAH
BROKERAGE SERVICES, LLC

PRICE: \$18.00 - 24.00 SF/YR

WALL TOWERS | EAST 4TH FLOOR | SUITE 400

201-203 W Wall St, Midland, TX 79701



Stephanie Gauthier

Agent | Marketing Specialist
214.450.9398
stephanie@moriahrealstate.com

Wes Gotcher

Broker | President
432.682.2510
wes@moriahrealstate.com

Trey Dennis

Broker
432.236.7500
trey@moriahrealstate.com

MORIAH
BROKERAGE SERVICES, LLC

PRICE: \$18.00 - 24.00 SF/YR

WALL TOWERS | EAST 4TH FLOOR | SUITE 400

201-203 W Wall St, Midland, TX 79701



Stephanie Gauthier

Agent | Marketing Specialist
214.450.9398
stephanie@moriahrealstate.com

Wes Gotcher

Broker | President
432.682.2510
wes@moriahrealstate.com

Trey Dennis

Broker
432.236.7500
trey@moriahrealstate.com

MORIAH
BROKERAGE SERVICES, LLC

PRICE: \$18.00 - 24.00 SF/YR

WALL TOWERS | EAST 4TH FLOOR | SUITE 401

201-203 W Wall St, Midland, TX 79701



Stephanie Gauthier

Agent | Marketing Specialist
214.450.9398
stephanie@moriahrealstate.com

Wes Gotcher

Broker | President
432.682.2510
wes@moriahrealstate.com

Trey Dennis

Broker
432.236.7500
trey@moriahrealstate.com

MORIAH
BROKERAGE SERVICES, LLC

PRICE: \$18.00 - 24.00 SF/YR

WALL TOWERS | EAST 4TH FLOOR | SUITE 401

201-203 W Wall St, Midland, TX 79701



Stephanie Gauthier

Agent | Marketing Specialist
214.450.9398
stephanie@moriahrealstate.com

Wes Gotcher

Broker | President
432.682.2510
wes@moriahrealstate.com

Trey Dennis


Broker
432.236.7500
trey@moriahrealstate.com



PRICE: \$18.00 - 24.00 SF/YR

WALL TOWERS | EAST 5TH FLOOR | SUITE 520

201-203 W Wall St, Midland, TX 79701

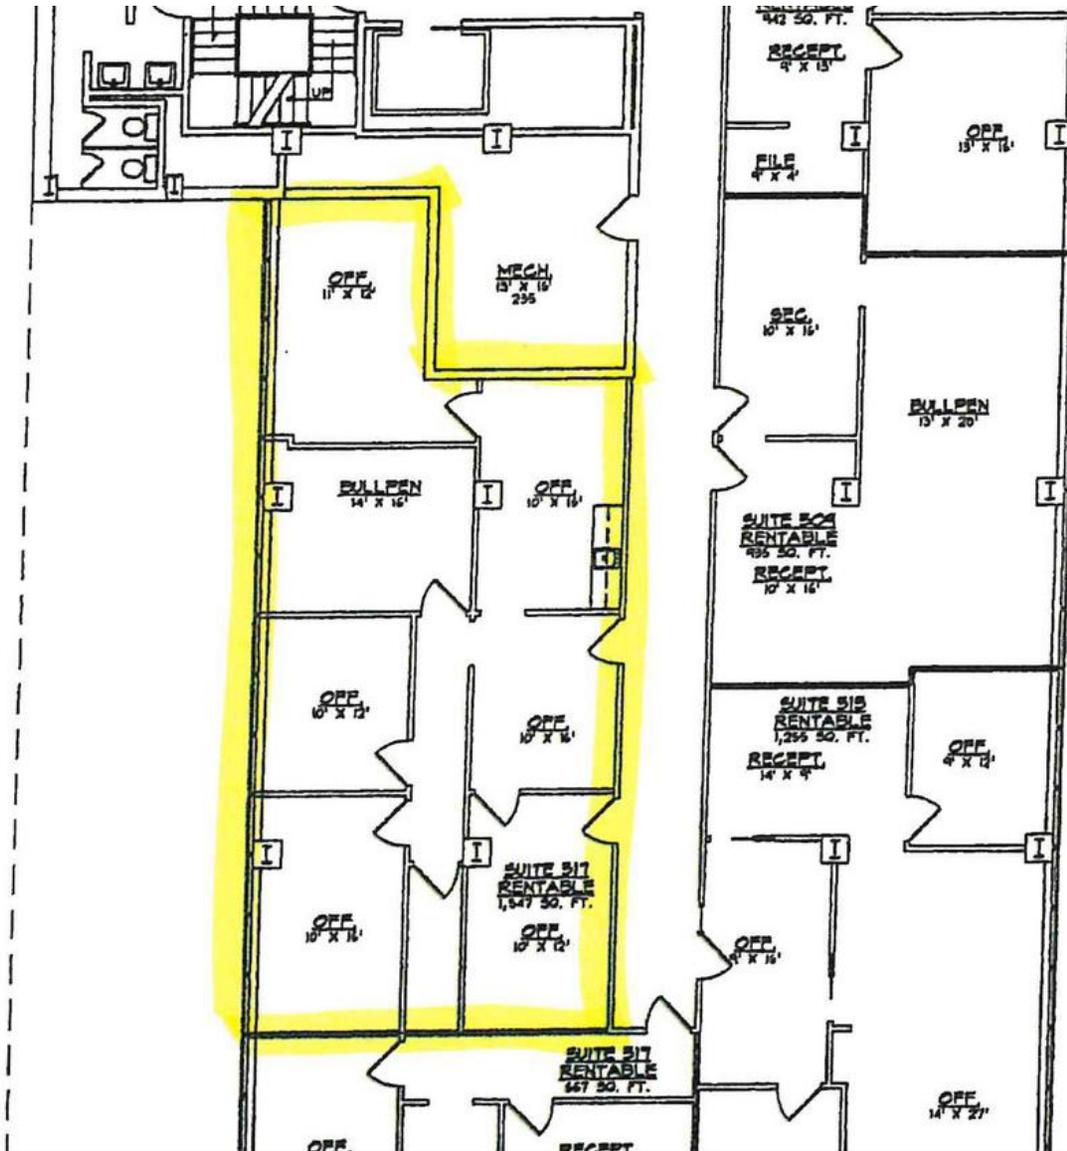

BUILDING COMMONS
544 SQ. FT.
5TH FLOOR RENTABLE
7,501 SQ. FT.
5TH FLOOR R/R RATIO
1.2754

#520
1,547 sq. ft.

PLEASE
INITIAL

Stephanie Gauthier
Agent | Marketing Specialist
214.450.9398
stephanie@moriahrealstate.com

Wes Gotcher
Broker | President
432.682.2510
wes@moriahrealstate.com


Trey Dennis
Broker
432.236.7500
trey@moriahrealstate.com

MORIAH
BROKERAGE SERVICES, LLC

PRICE: \$18.00 - 24.00 SF/YR

WALL TOWERS | EAST 5TH FLOOR | SUITE 520

201-203 W Wall St, Midland, TX 79701

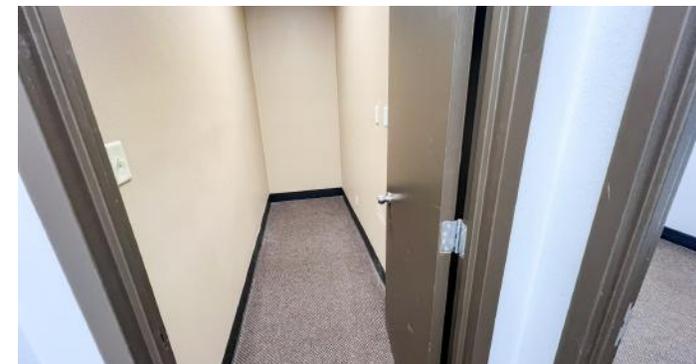

Stephanie Gauthier

Agent | Marketing Specialist
214.450.9398
stephanie@moriahrealstate.com

Wes Gotcher

Broker | President
432.682.2510
wes@moriahrealstate.com

Trey Dennis


Broker
432.236.7500
trey@moriahrealstate.com

MORIAH
BROKERAGE SERVICES, LLC

PRICE: \$18.00 - 24.00 SF/YR

WALL TOWERS | EAST 5TH FLOOR | SUITE 530

201-203 W Wall St, Midland, TX 79701

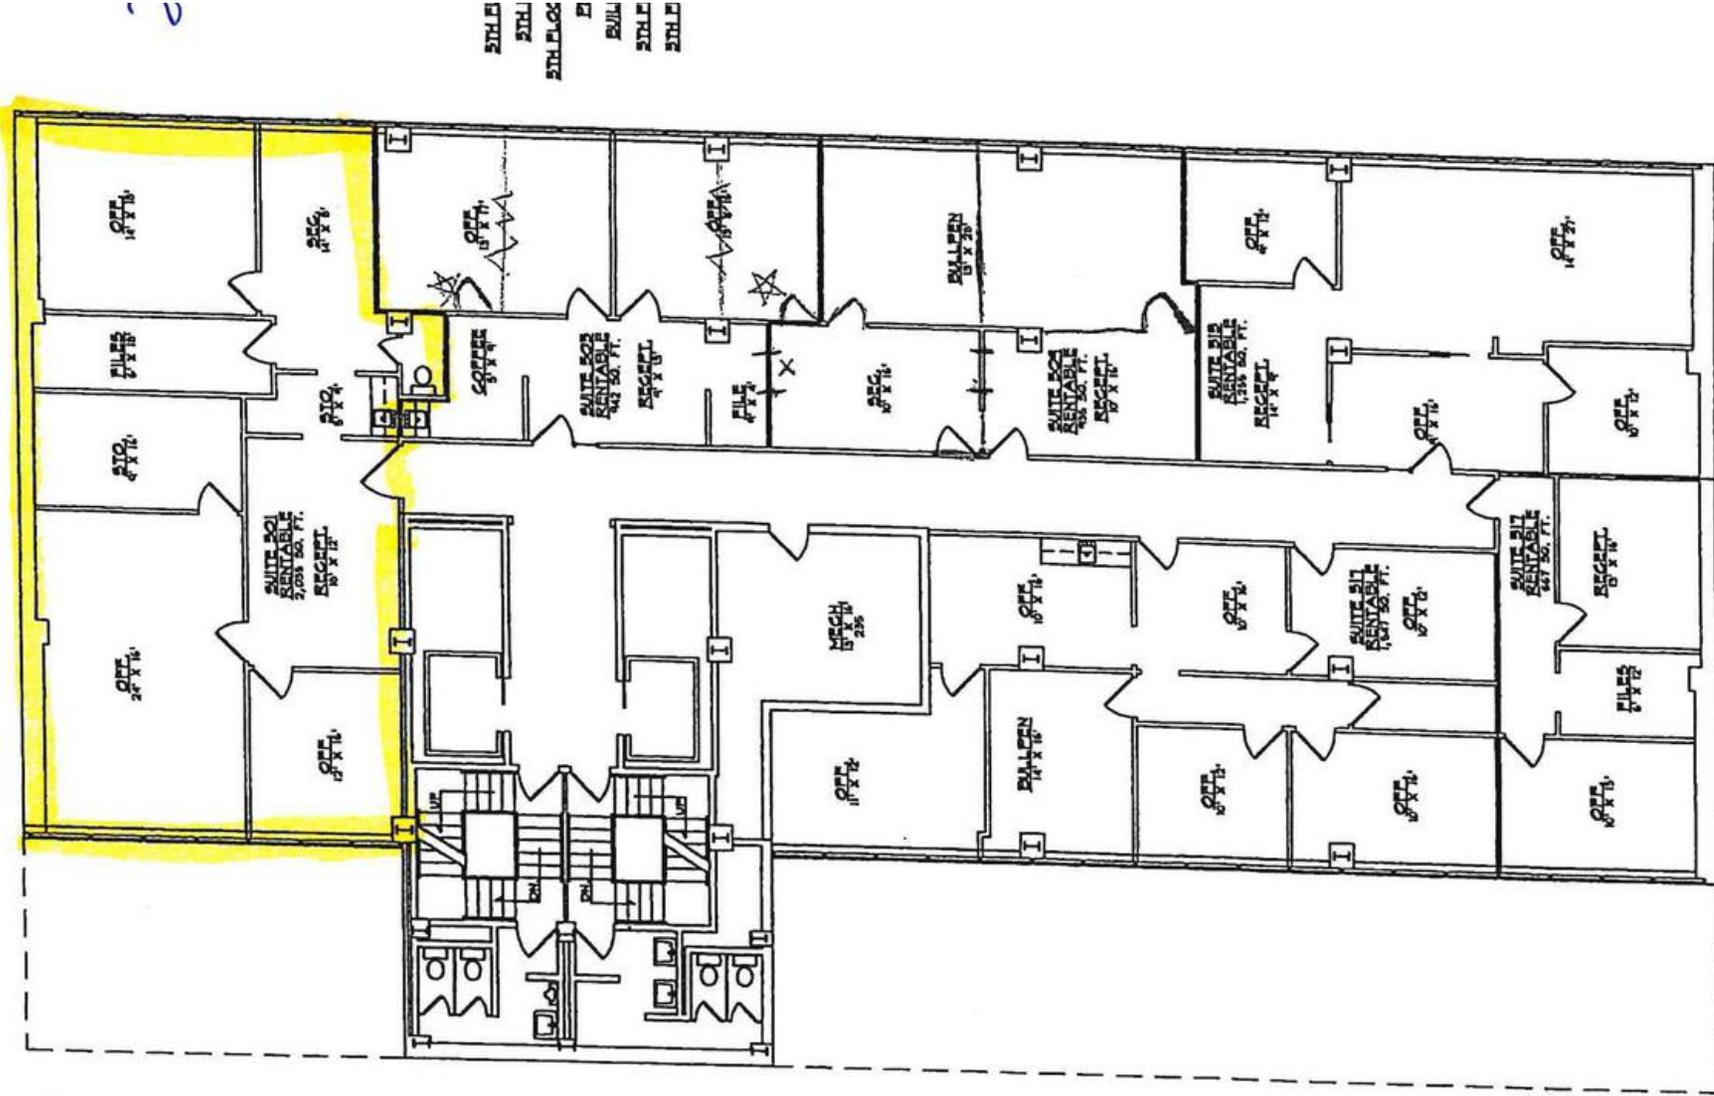

2TH FLOOR
2TH FLOOR
A AS-BUILT FLOOR PLAN
5TH FLOOR
N.T.S.

© COPYRIGHT, J. R. DRAFTING & DESIGN
2017 FEDERAL COPYRIGHT PROTECTION
THIS PLAN IS THE PROPERTY OF J. R. DRAFTING & DESIGN
AND IS NOT TO BE REPRODUCED, COPIED,
REPRODUCED, TRANSMITTED, OR OTHERWISE
DISSEMINATED IN ANY FORM OR BY ANY
MEANS, ELECTRONIC OR MECHANICAL,
INCLUDING PHOTOCOPYING, RECORDING,
OR BY ANY INFORMATION STORAGE AND
RETRIEVAL SYSTEM, WITHOUT THE WRITTEN
PERMISSION OF J. R. DRAFTING & DESIGN.
ANY VIOLATION OF THIS COPYRIGHT IS
STRICTLY PROHIBITED AND PUNISHABLE
BY LAW.

DATE
MARCH 10, 2017
JOB # JRM1608

PREPARED BY:
JR DRAFTING & DESIGN
NEW BUILDING FOR:
WALL TOWERS EAST
203 WALL STREET
MIDLAND TEXAS

Stephanie Gauthier
Agent | Marketing Specialist
214.450.9398
stephanie@moriahrealstate.com

Wes Gotcher
Broker | President
432.682.2510
wes@moriahrealstate.com


Trey Dennis
Broker
432.236.7500
trey@moriahrealstate.com



PRICE: \$18.00 - 24.00 SF/YR

WALL TOWERS | EAST 5TH FLOOR | SUITE 530

201-203 W Wall St, Midland, TX 79701

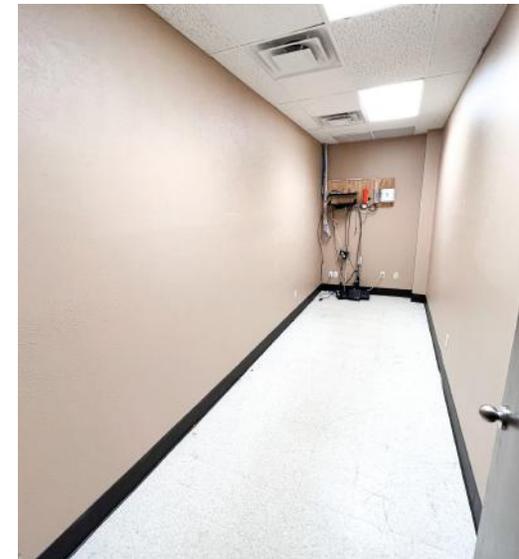

Stephanie Gauthier

Agent | Marketing Specialist
214.450.9398
stephanie@moriahrealstate.com

Wes Gotcher

Broker | President
432.682.2510
wes@moriahrealstate.com

Trey Dennis


Broker
432.236.7500
trey@moriahrealstate.com

MORIAH
BROKERAGE SERVICES, LLC

PRICE: \$18.00 - 24.00 SF/YR

WALL TOWERS | EAST 6TH FLOOR | SUITE 600

201-203 W Wall St, Midland, TX 79701

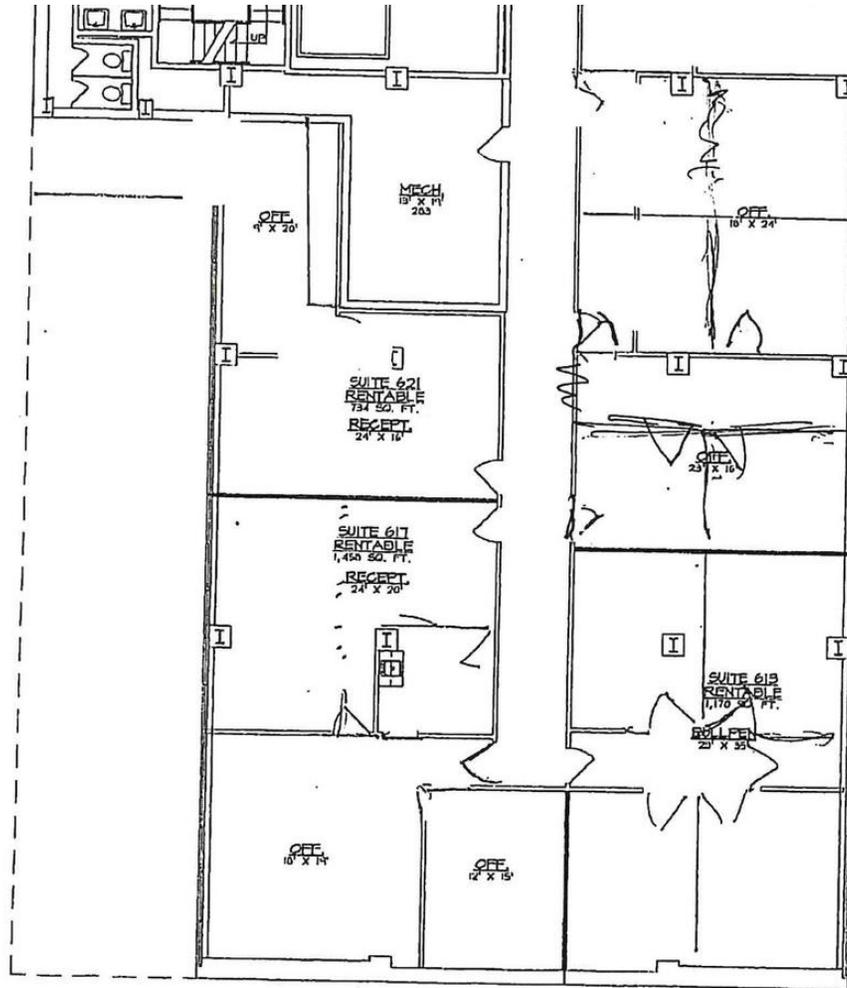

7,721 sq
(Includes Bridge)

(A) AS-BUILT FLOOR PLAN
6TH FLOOR
N. T. S.

PREPARED BY:
JM DRAFTING & DESIGN
NEW BUILDING FOR:

© COPYRIGHT, J M DRAFTING & DESIGN
2011 FEDERAL COPYRIGHT PRO-
TECTION, EXTENDING TO DERIVATIVE
PLANS, IS APPLICABLE TO THIS

Stephanie Gauthier
Agent | Marketing Specialist
214.450.9398
stephanie@moriahrealstate.com

Wes Gotcher
Broker | President
432.682.2510
wes@moriahrealstate.com

Trey Dennis
Broker
432.236.7500
trey@moriahrealstate.com

MORIAH
BROKERAGE SERVICES, LLC

PRICE: \$18.00 - 24.00 SF/YR

WALL TOWERS | EAST 6TH FLOOR | SUITE 600

201-203 W Wall St, Midland, TX 79701



Stephanie Gauthier

Agent | Marketing Specialist
214.450.9398
stephanie@moriahrealstate.com

Wes Gotcher

Broker | President
432.682.2510
wes@moriahrealstate.com

Trey Dennis

Broker
432.236.7500
trey@moriahrealstate.com

MORIAH
BROKERAGE SERVICES, LLC

PRICE: \$18.00 - 24.00 SF/YR

WALL TOWERS | EAST 7TH FLOOR | SUITE 700

201-203 W Wall St, Midland, TX 79701



Stephanie Gauthier

Agent | Marketing Specialist
214.450.9398
stephanie@moriahrealstate.com

Wes Gotcher

Broker | President
432.682.2510
wes@moriahrealstate.com

Trey Dennis

Broker
432.236.7500
trey@moriahrealstate.com


MORIAH
BROKERAGE SERVICES, LLC

PRICE: \$18.00 - 24.00 SF/YR

WALL TOWERS | EAST 8TH FLOOR | SUITE 804

201-203 W Wall St, Midland, TX 79701

#804
23rd st

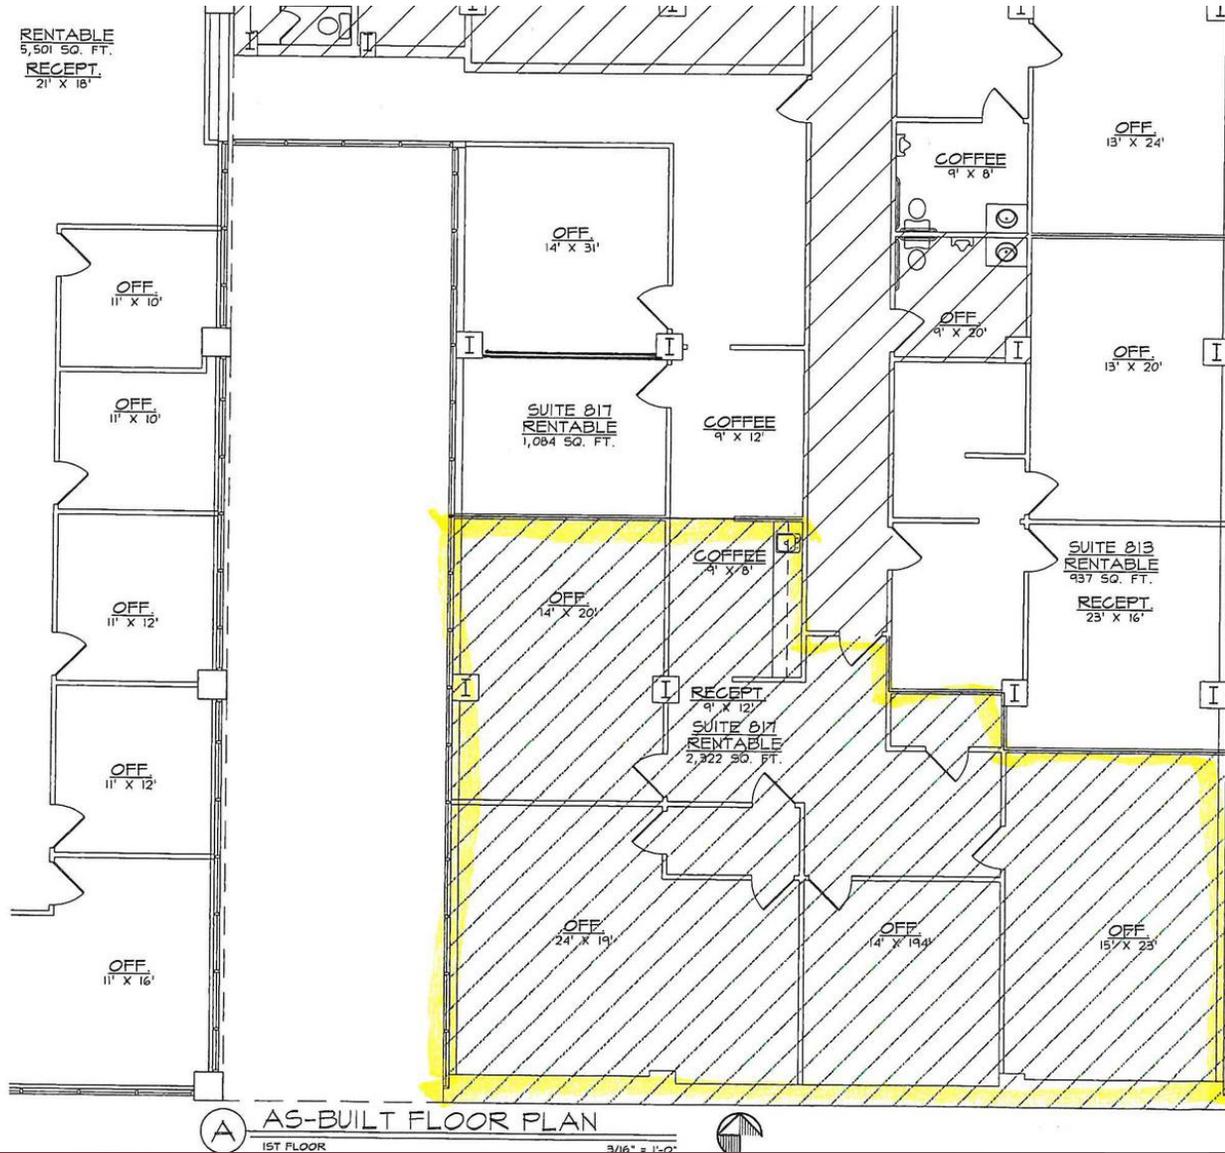

Stephanie Gauthier
Agent | Marketing Specialist
214.450.9398
stephanie@moriahrealstate.com

Wes Gotcher
Broker | President
432.682.2510
wes@moriahrealstate.com

Trey Dennis
Broker
432.236.7500
trey@moriahrealstate.com



PRICE: \$18.00 - 24.00 SF/YR

WALL TOWERS | EAST 8TH FLOOR | SUITE 804

201-203 W Wall St, Midland, TX 79701



Stephanie Gauthier

Agent | Marketing Specialist
214.450.9398
stephanie@moriahrealstate.com

Wes Gotcher

Broker | President
432.682.2510
wes@moriahrealstate.com

Trey Dennis

Broker
432.236.7500
trey@moriahrealstate.com

MORIAH
BROKERAGE SERVICES, LLC

WALL TOWERS | EAST & WEST

201-203 W Wall St, Midland, TX 79701

Contact Brokers:

Stephanie Gauthier

Agent | Marketing Specialist
214.450.9398
stephanie@moriahrealestate.com

Wes Gotcher

Broker | President
432.682.2510
wes@moriahrealestate.com

Trey Dennis

Broker
432.236.7500
trey@moriahrealestate.com



15 Smith Road, Suite 6004, Midland, TX 79705
432.682.2510 | moriahbrokerageservices.com