


7/27/2020 3:40:22 PM

A  
B  
C  
D  
E  
F  
G  
H

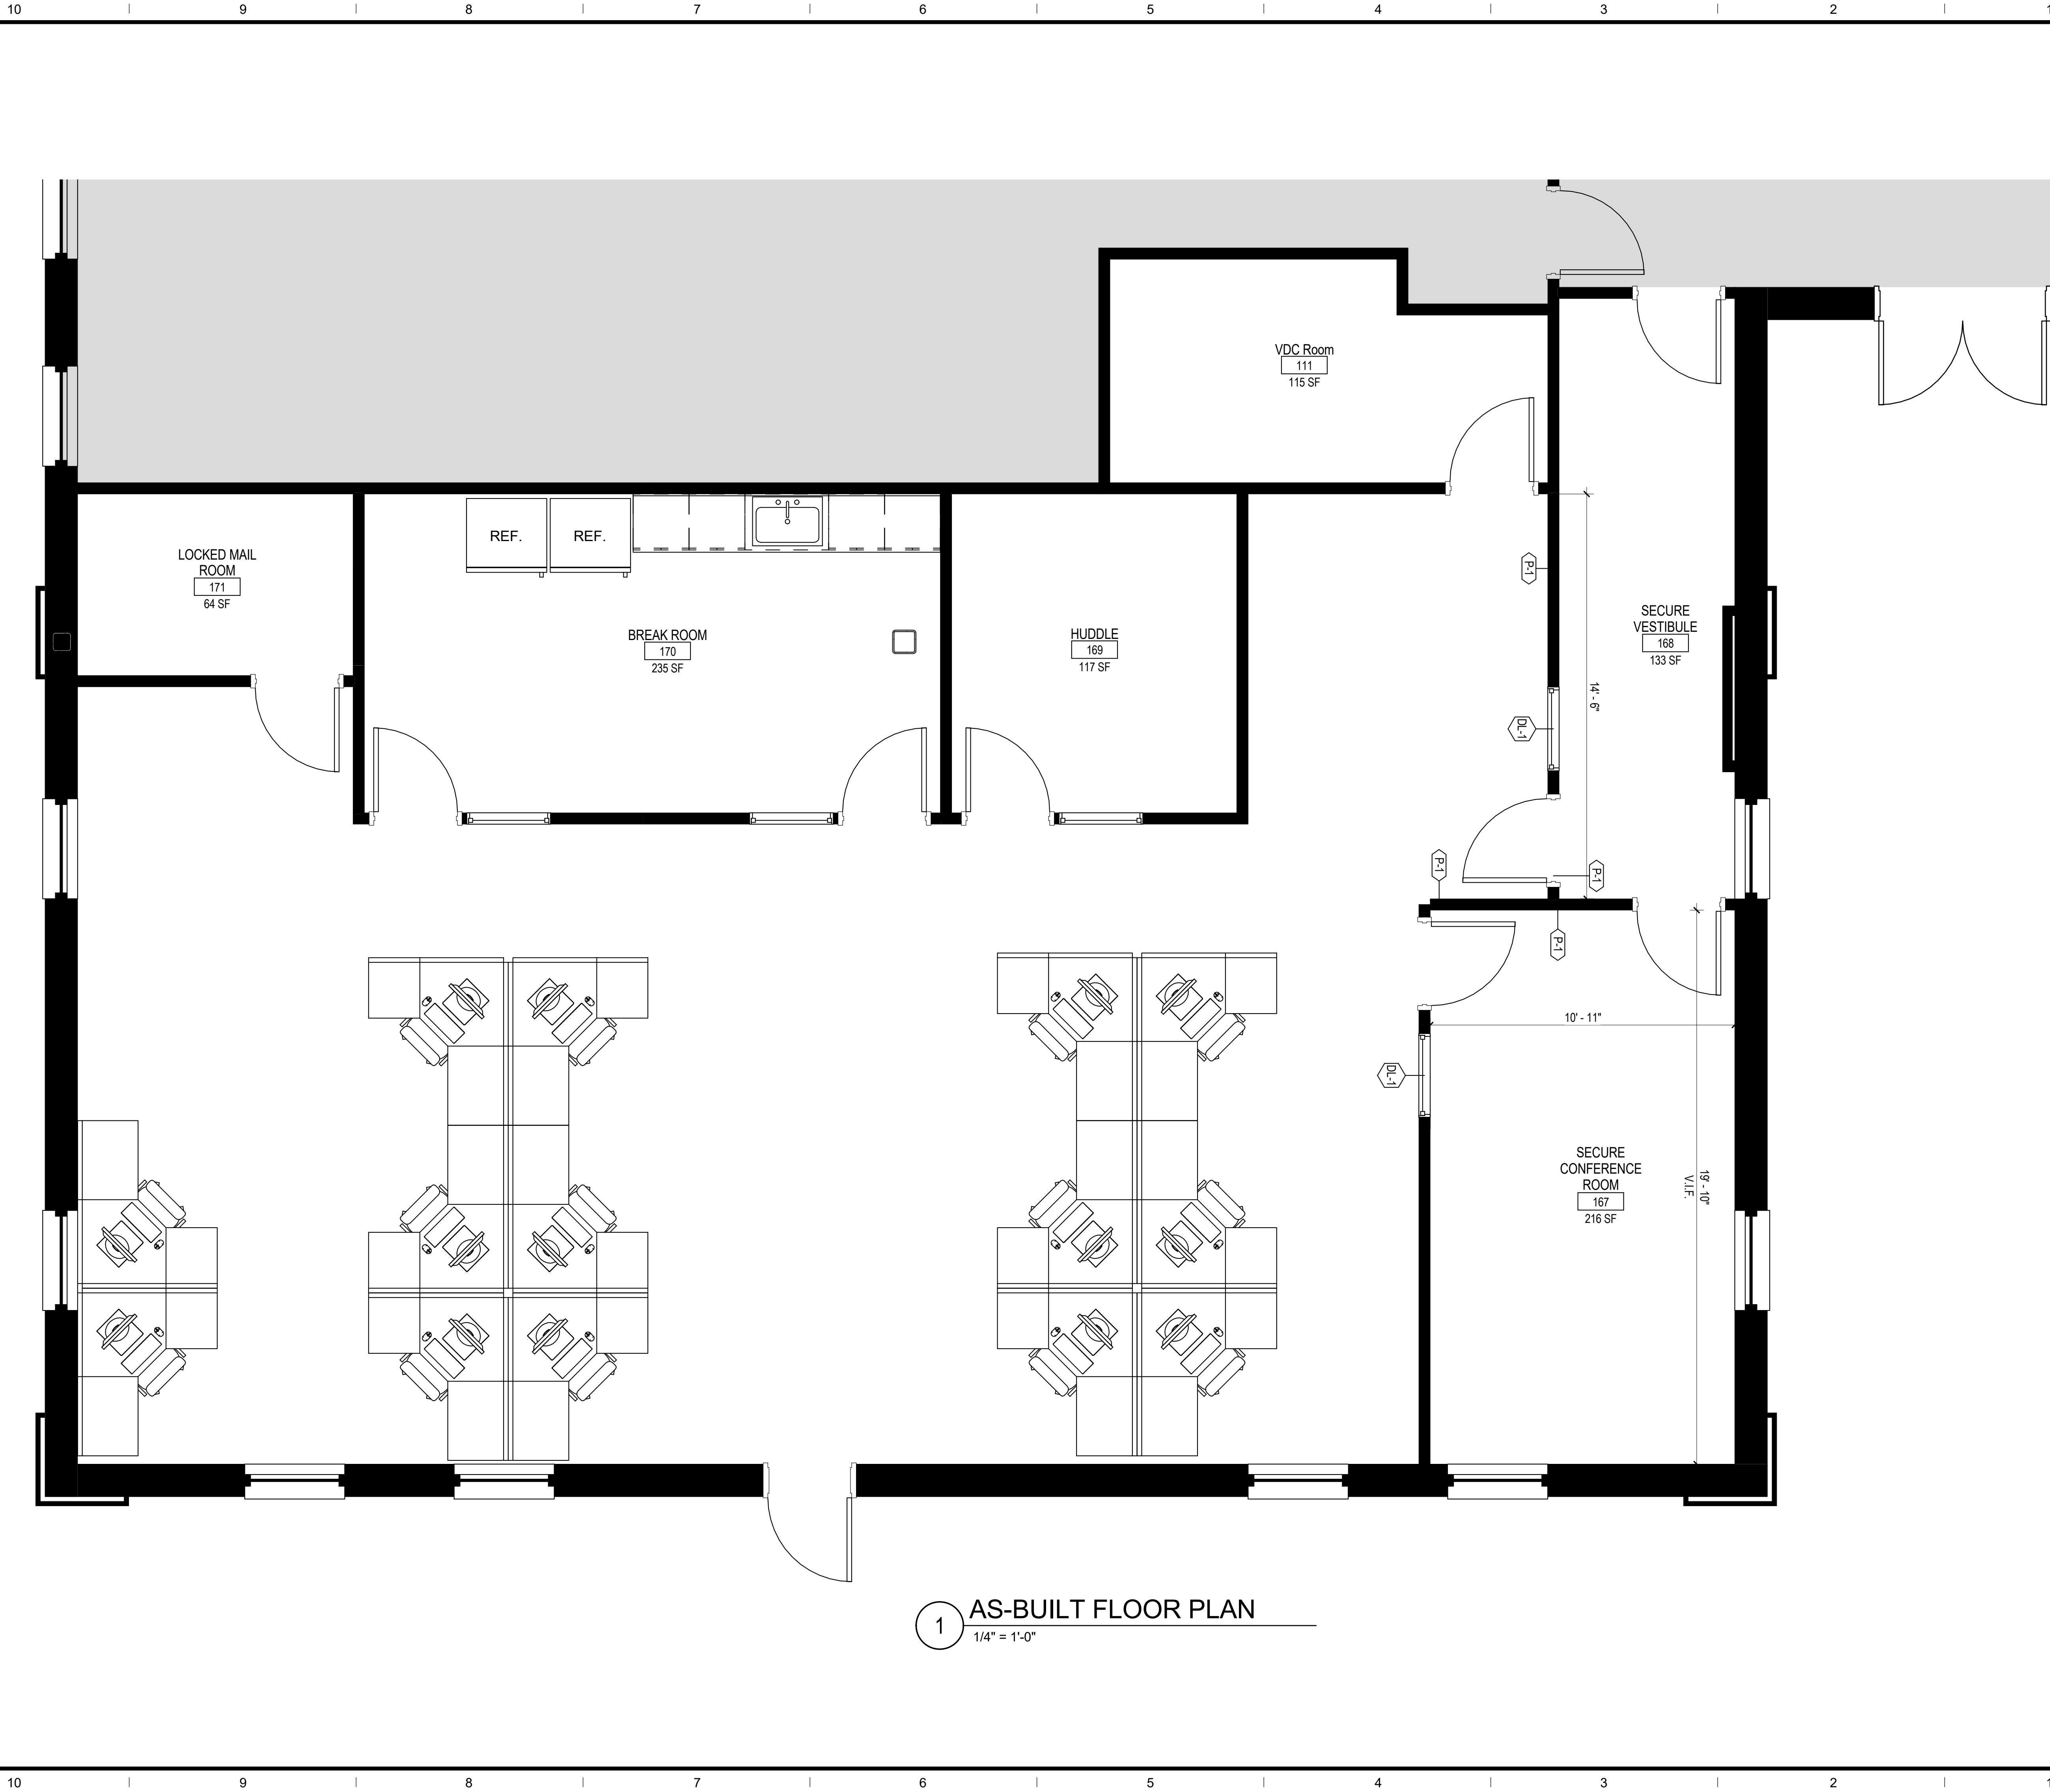

1 AS-BUILT FLOOR PLAN  
1/4" = 1'-0"



Brady Sullivan Properties  
670 N. Commercial Street  
Manchester, nh 03101  
603.622.6223




Owner  
8 COMMERCE DRIVE

BEDFORD  
NH

Project  
SUITE 102  
2,978 SF

CALLLED NORTH

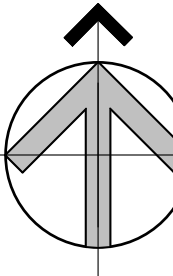

Seals

Issues	
Date	Description

Revisions	
No.	Date

Drawing Title  
AS-BUILT FLOOR  
PLAN

Issue Date: 7-27-2020


Project No: TRV-0633 Scale: 1/4" = 1'-0"

Project Manager: Production Leader: MJH

Project Architect: Peer Reviewer: CL

Drawing Number

C1-7

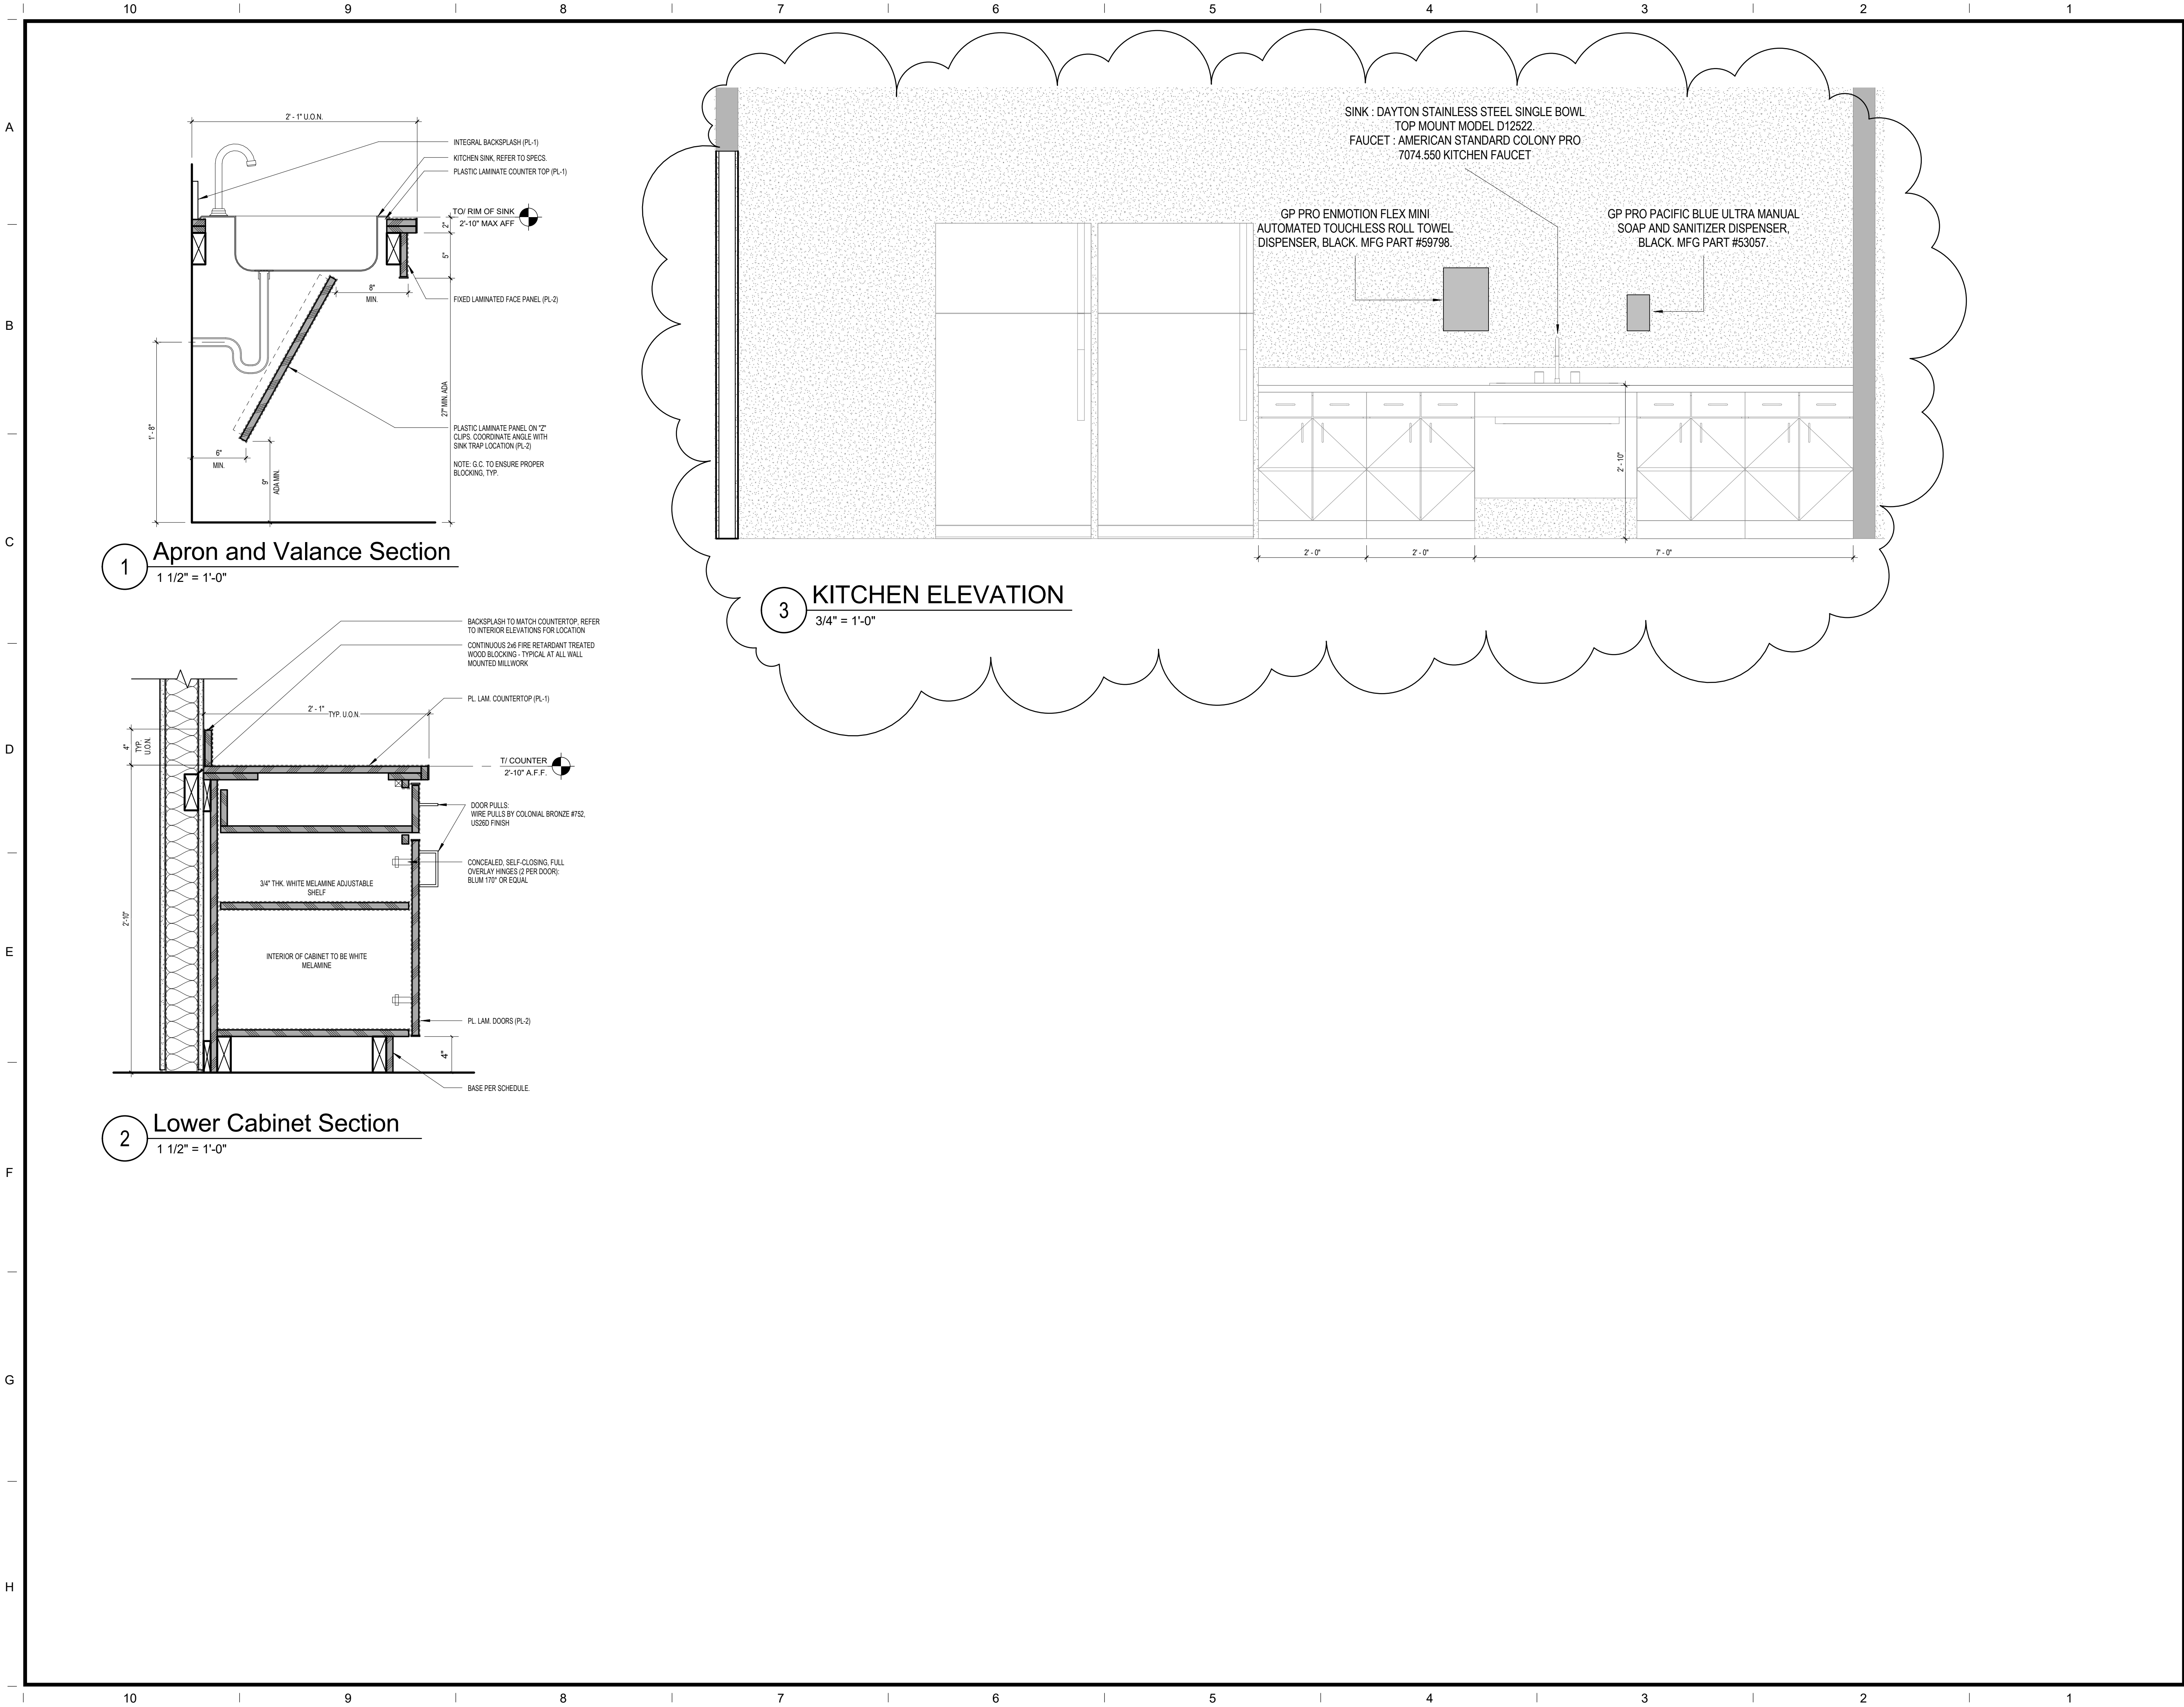

Brady Sullivan Properties  
670 N. Commercial Street  
Manchester, nh 03101  
603.622.6223



Owner  
8 COMMERCE DRIVE

BEDFORD  
NH

Project

Seals  
CONSTRUCTION SET

Issues	
Date	Description

Revisions		
No.	Date	Description
1	5-12-2020	Kitchen Revision

Drawing Title  
DETAILED  
DRAWINGS

Issue Date: 7-27-2020

Project No: TRV-0633 Scale: As indicated

Project Manager: Production Leader: MJH

Project Architect: Peer Reviewer: CL

Drawing Number

C1-6