

Bloomfield Professional Building

50 West Big Beaver, Suite 215

Birmingham, Michigan



2075 West Big Beaver, Suite 100


Troy, Michigan 48084

Telephone 248.341.3999

Facsimile 248.646.3744

www.dietzpropertygroup.com

FLOOR PLAN

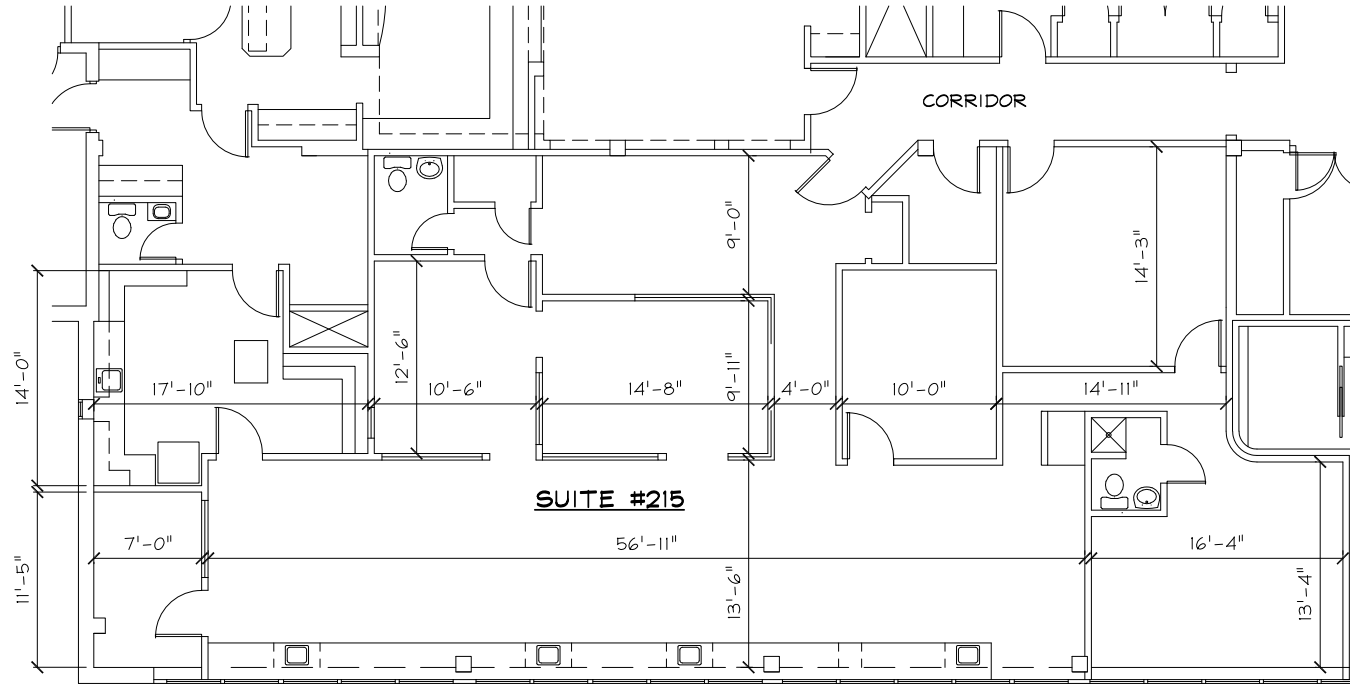

AS-BUILT FLOOR PLAN

2,450 USF


2,744 RSF

0 4' 8' 16'



GRAPHIC SCALE

NOTE: INTERIOR DIMENSIONS ARE SHOWN FOR GENERAL REFERENCE ONLY.

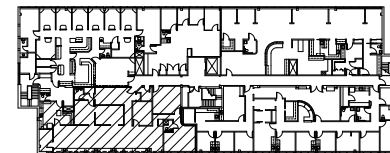

SECOND FLOOR KEYPLAN

NOT TO SCALE