


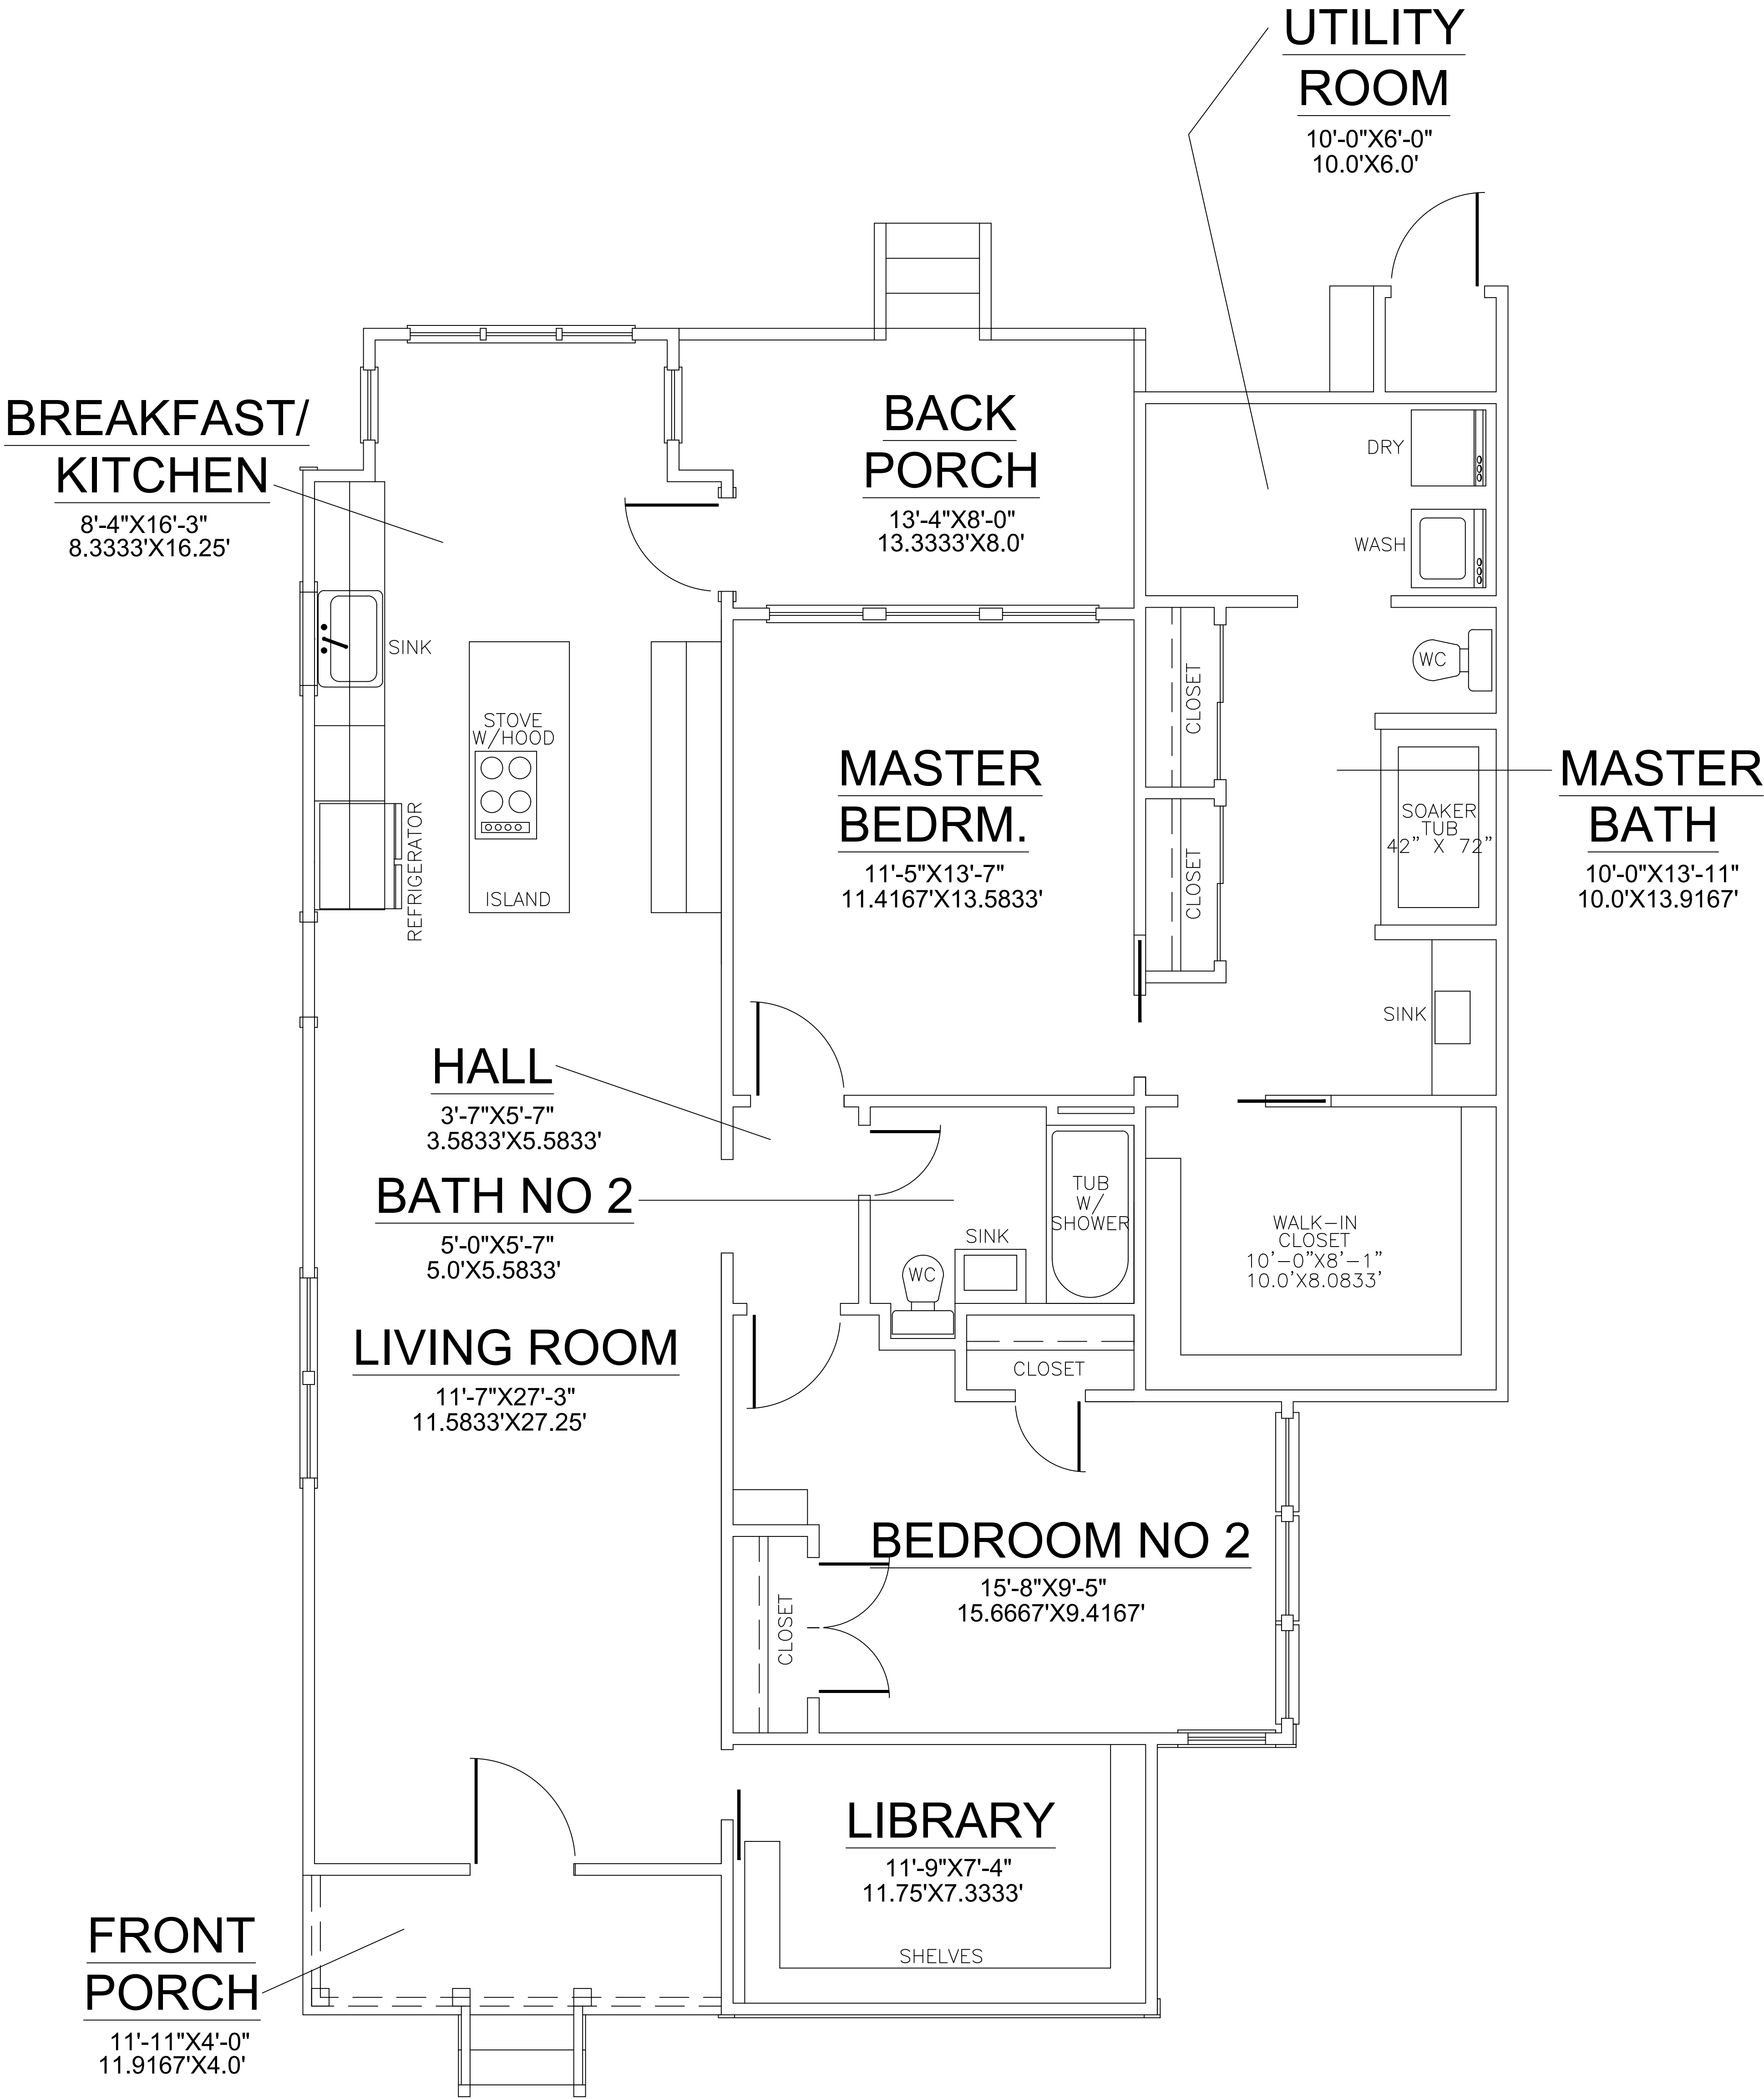

FLOOR PLAN

555 S. FOSTER

BATON ROUGE, LA.

AS-BUILT

SQUARE FOOTAGE	
LIVING AREA	1361 SQ.FT.
FRONT PORCH	48 SQ.FT.
BACK PORCH	98 SQ.FT.
TOTAL	1507 SQ.FT.