


**BASEMENT LEVEL**

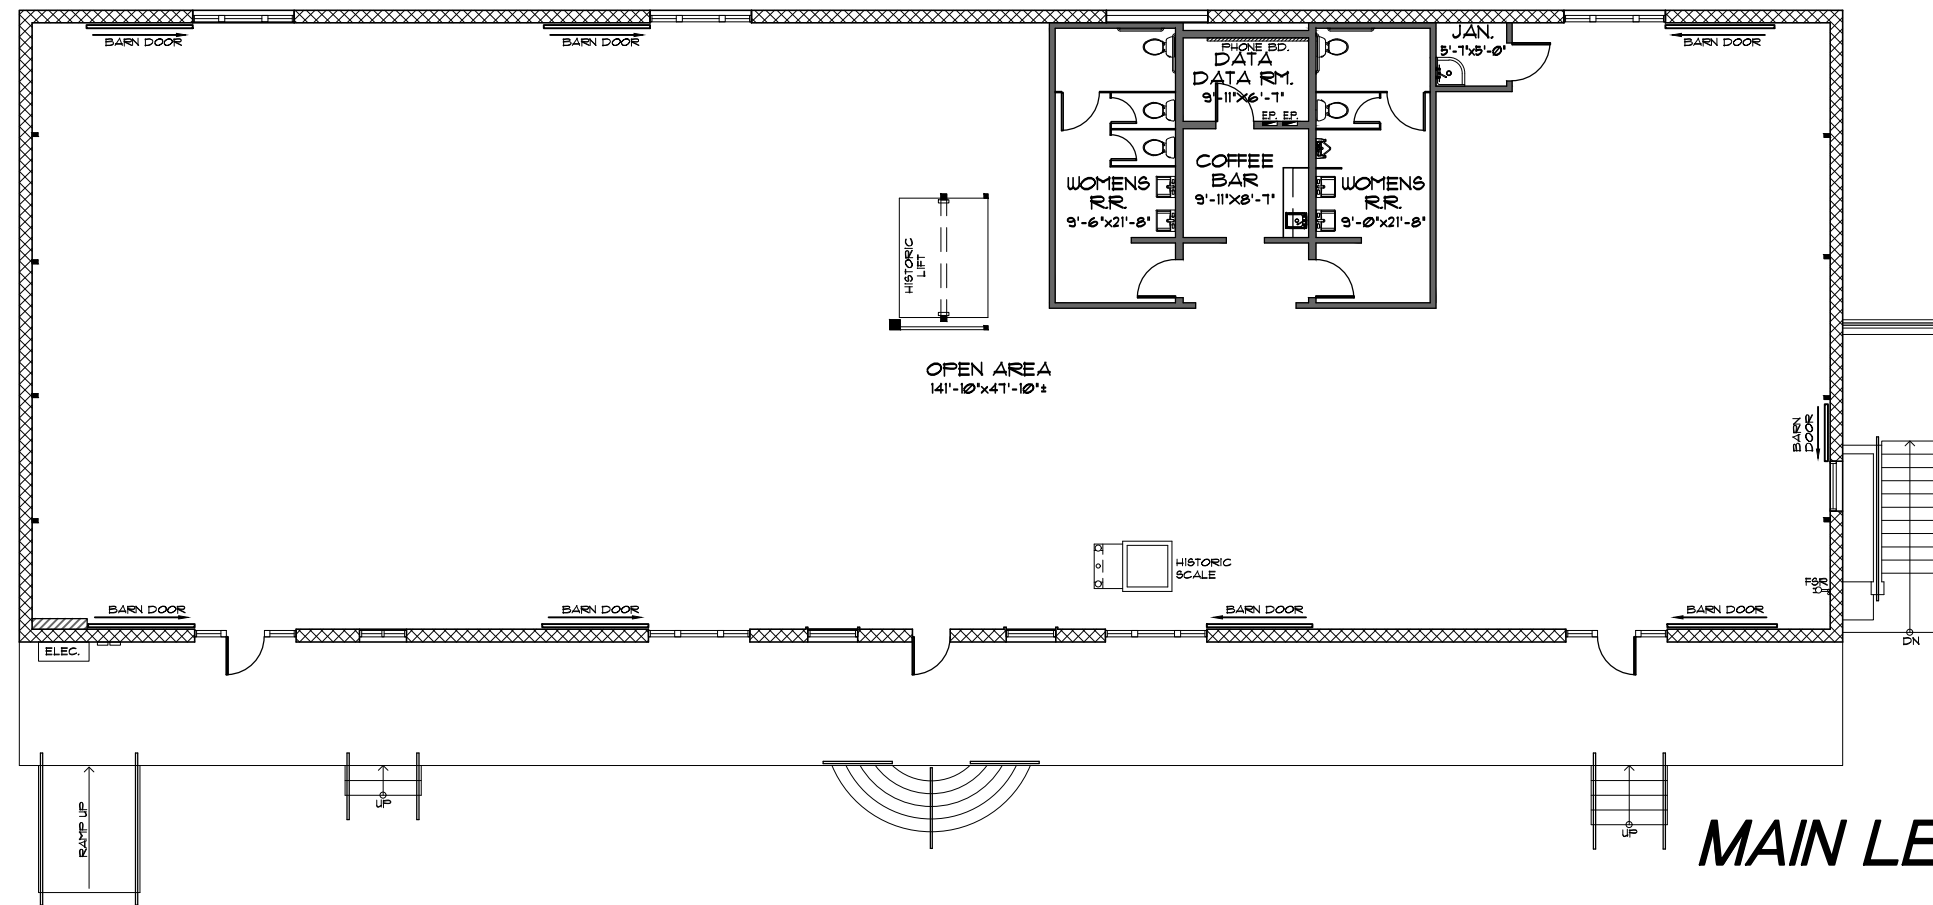

**MAIN LEVEL**

21 W. STUART AVE.  
 REDLANDS  
 CALIFORNIA 92374  
 DATE: 05/26/2021  
 SCALE: NONE  
 SDG JN: S235-21100

**MAIN BUILDING  
 AS-BUILT  
 FLOOR PLAN**

3100 East Cedar Street, Suite 26  
 Ontario, CA 91761  
 Telephone No. (909) 930-2444  
 Facsimile No. (909) 930-2229  
[www.sissondesign.com](http://www.sissondesign.com)

