




N. Y. S. & W. R. R.

JOB AND JOB REBAR SET ±260' DEED 260.42' (CALC. & MEAS.) S 11°18'13" W (CALC. & MEAS.)

EXISTING SITE IMPROVEMENT NOT SHOWN

REA (60' R.O.W.) AVENUE

FOURTH (50' R.O.W.) AVENUE

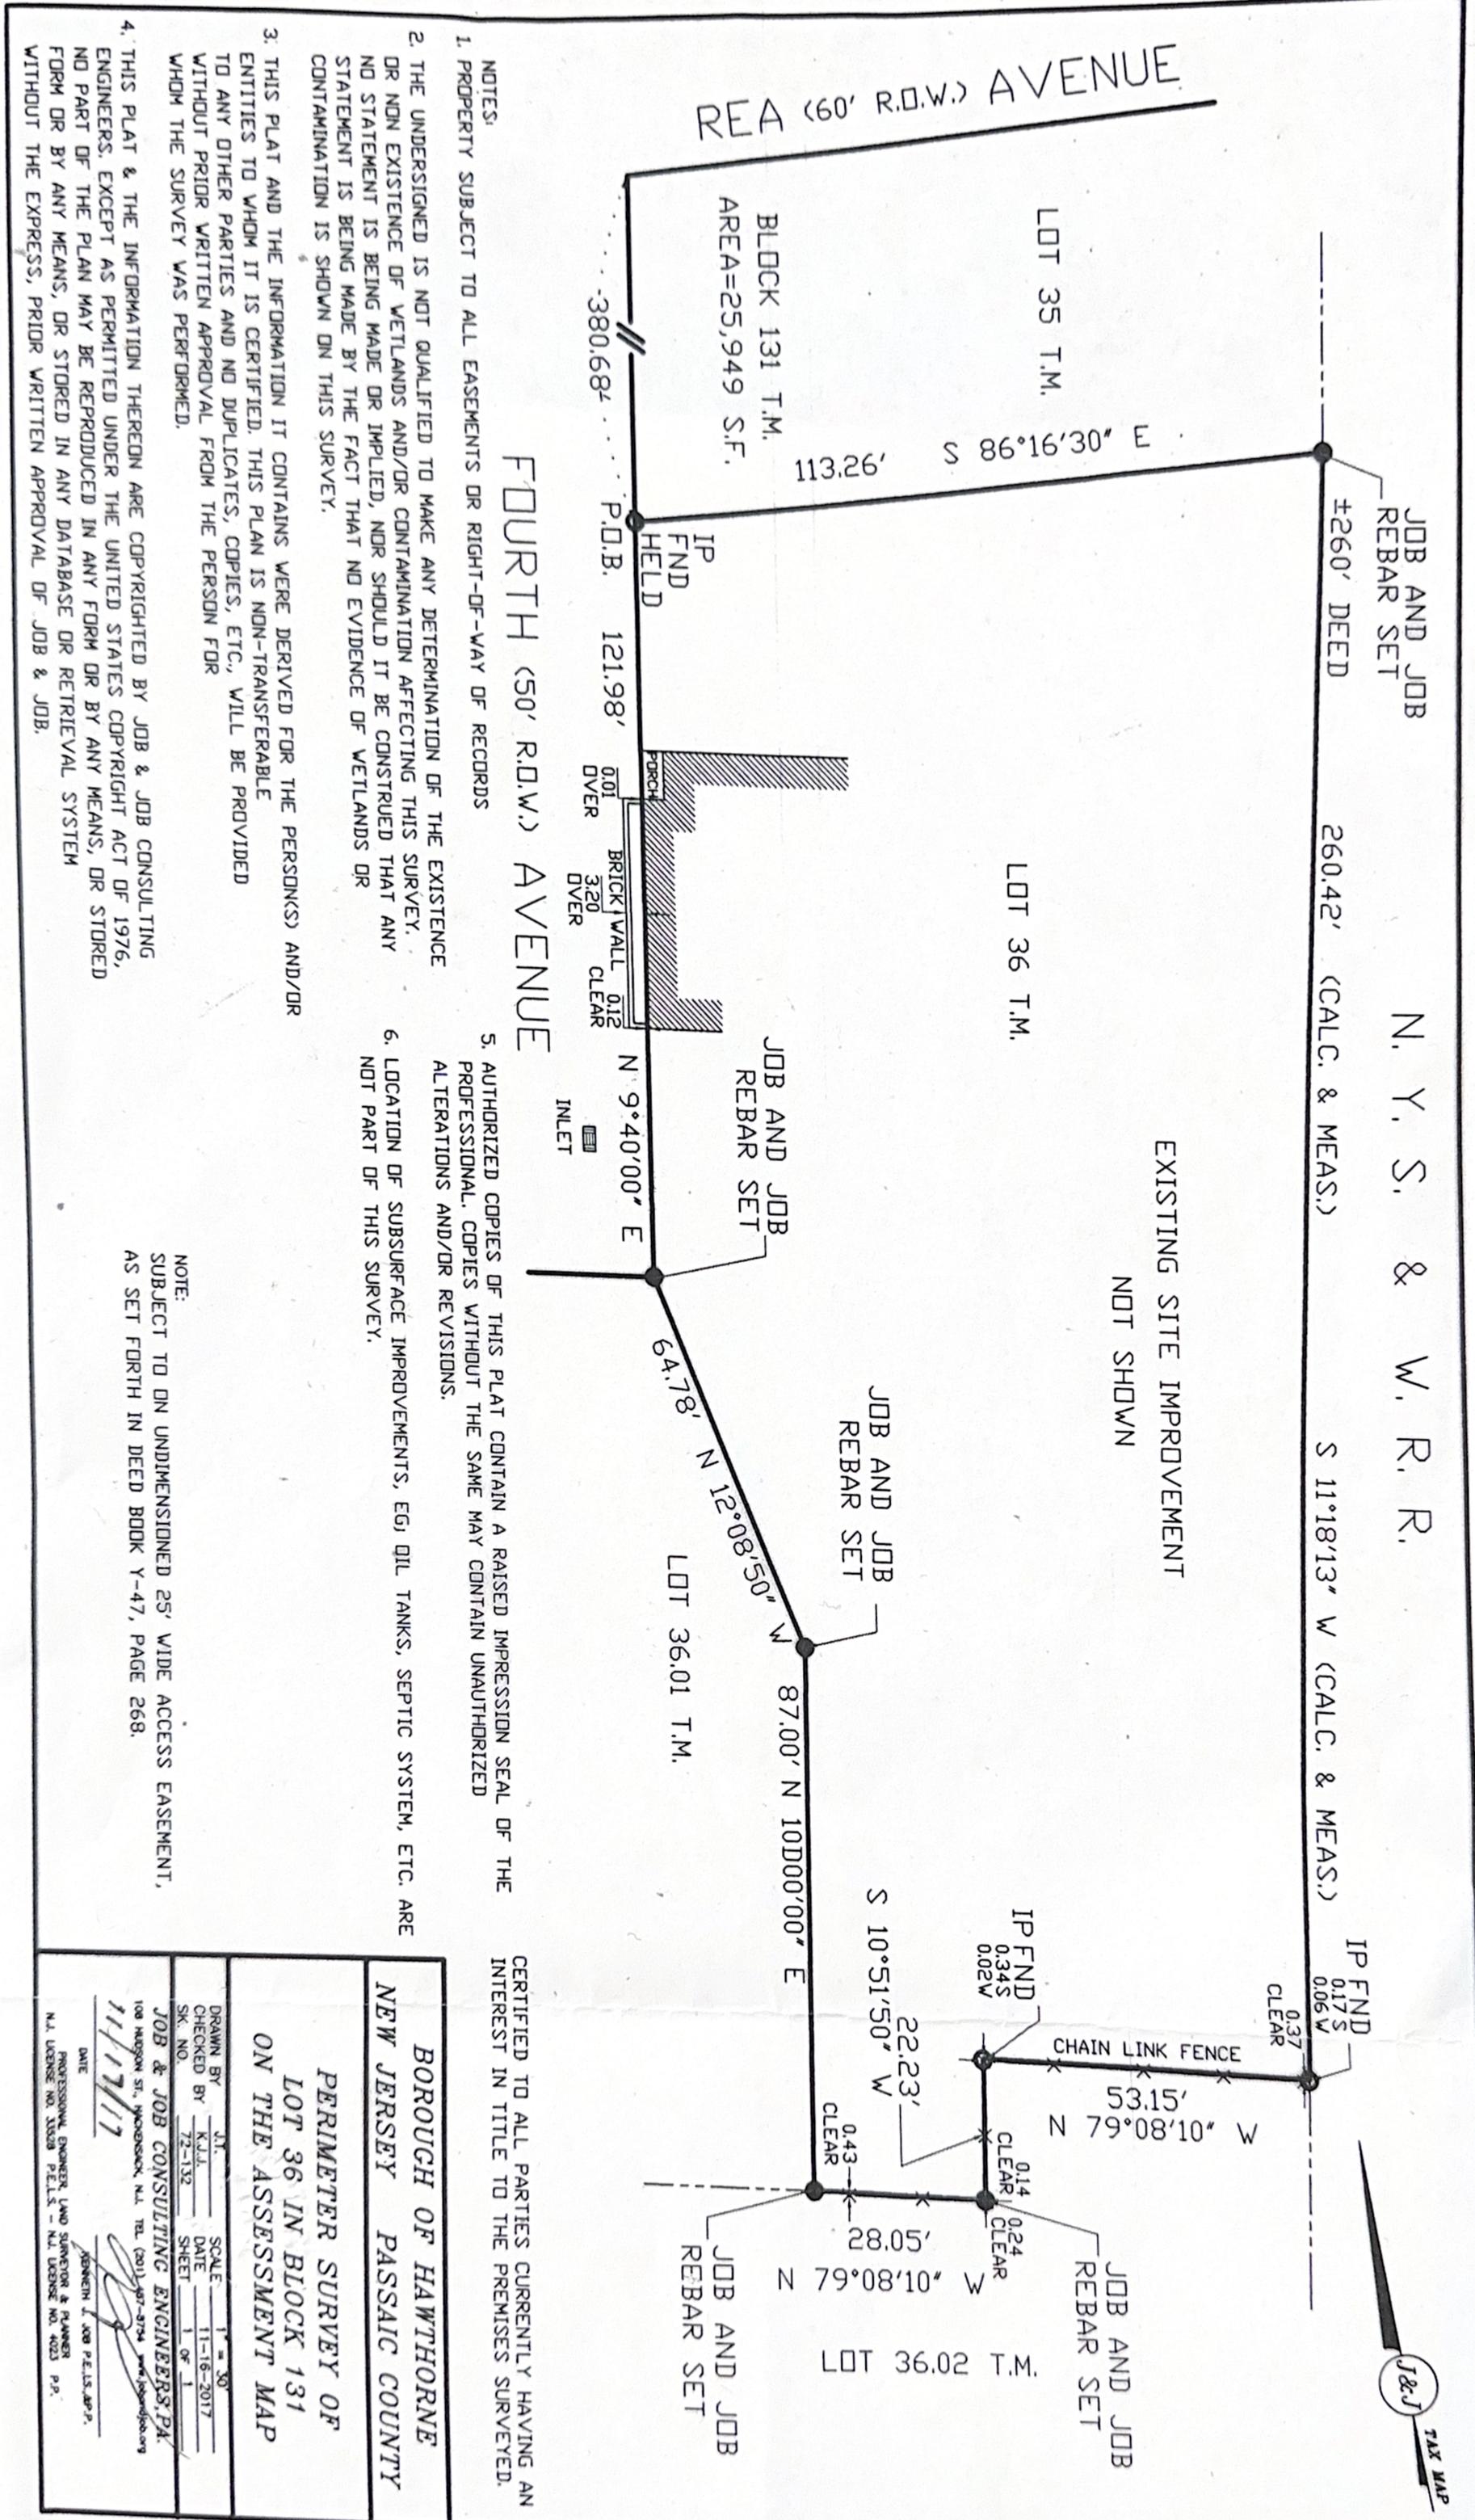

CERTIFIED TO ALL PARTIES CURRENTLY HAVING AN INTEREST IN TITLE TO THE PREMISES SURVEYED.

BOROUGH OF HAWTHORNE
NEW JERSEY PASSAIC COUNTY

PERIMETER SURVEY OF
LOT 36 IN BLOCK 131
ON THE ASSESSMENT MAP

JOB & JOB CONSULTING ENGINEERS, P.A.
100 MADISON ST., WOODBRIDGE, N.J. TEL: (201) 987-9794
N.J. LICENSE NO. 33039 P.E.L.S. - N.J. LICENSE NO. 4023 P.P.

DATE: 11/17/17
SCALE: 1" = 30'
DRAWN BY: J.T.
CHECKED BY: K.J.L.
SK. NO.: 72-132

- NOTES:
1. PROPERTY SUBJECT TO ALL EASEMENTS OR RIGHT-OF-WAY OF RECORDS
 2. THE UNDERSIGNED IS NOT QUALIFIED TO MAKE ANY DETERMINATION OF THE EXISTENCE OR NON EXISTENCE OF WETLANDS AND/OR CONTAMINATION AFFECTING THIS SURVEY. NO STATEMENT IS BEING MADE OR IMPLIED, NOR SHOULD IT BE CONSTRUED THAT ANY STATEMENT IS BEING MADE BY THE FACT THAT NO EVIDENCE OF WETLANDS OR CONTAMINATION IS SHOWN ON THIS SURVEY.
 3. THIS PLAT AND THE INFORMATION IT CONTAINS WERE DERIVED FOR THE PERSON(S) AND/OR ENTITIES TO WHOM IT IS CERTIFIED. THIS PLAN IS NON-TRANSFERABLE TO ANY OTHER PARTIES AND NO DUPLICATES, COPIES, ETC., WILL BE PROVIDED WITHOUT PRIOR WRITTEN APPROVAL FROM THE PERSON FOR WHOM THE SURVEY WAS PERFORMED.
 4. THIS PLAT & THE INFORMATION THEREON ARE COPYRIGHTED BY JOB & JOB CONSULTING ENGINEERS. EXCEPT AS PERMITTED UNDER THE UNITED STATES COPYRIGHT ACT OF 1976, NO PART OF THE PLAN MAY BE REPRODUCED IN ANY FORM OR BY ANY MEANS, OR STORED FORM OR BY ANY MEANS, OR STORED IN ANY DATABASE OR RETRIEVAL SYSTEM WITHOUT THE EXPRESS, PRIOR WRITTEN APPROVAL OF JOB & JOB.

5. AUTHORIZED COPIES OF THIS PLAT CONTAIN A RAISED IMPRESSION SEAL OF THE PROFESSIONAL. COPIES WITHOUT THE SAME MAY CONTAIN UNAUTHORIZED ALTERATIONS AND/OR REVISIONS.
6. LOCATION OF SUBSURFACE IMPROVEMENTS, E.G. OIL TANKS, SEPTIC SYSTEM, ETC. ARE NOT PART OF THIS SURVEY.

NOTE:
SUBJECT TO ON UNDIMENSIONED 25' WIDE ACCESS EASEMENT,
AS SET FORTH IN DEED BOOK Y-47, PAGE 268.