


Lisa Benson
EASTLAND LOFTS
400 W Main Street
Eastland, TX 76448

NOT FOR CONSTRUCTION

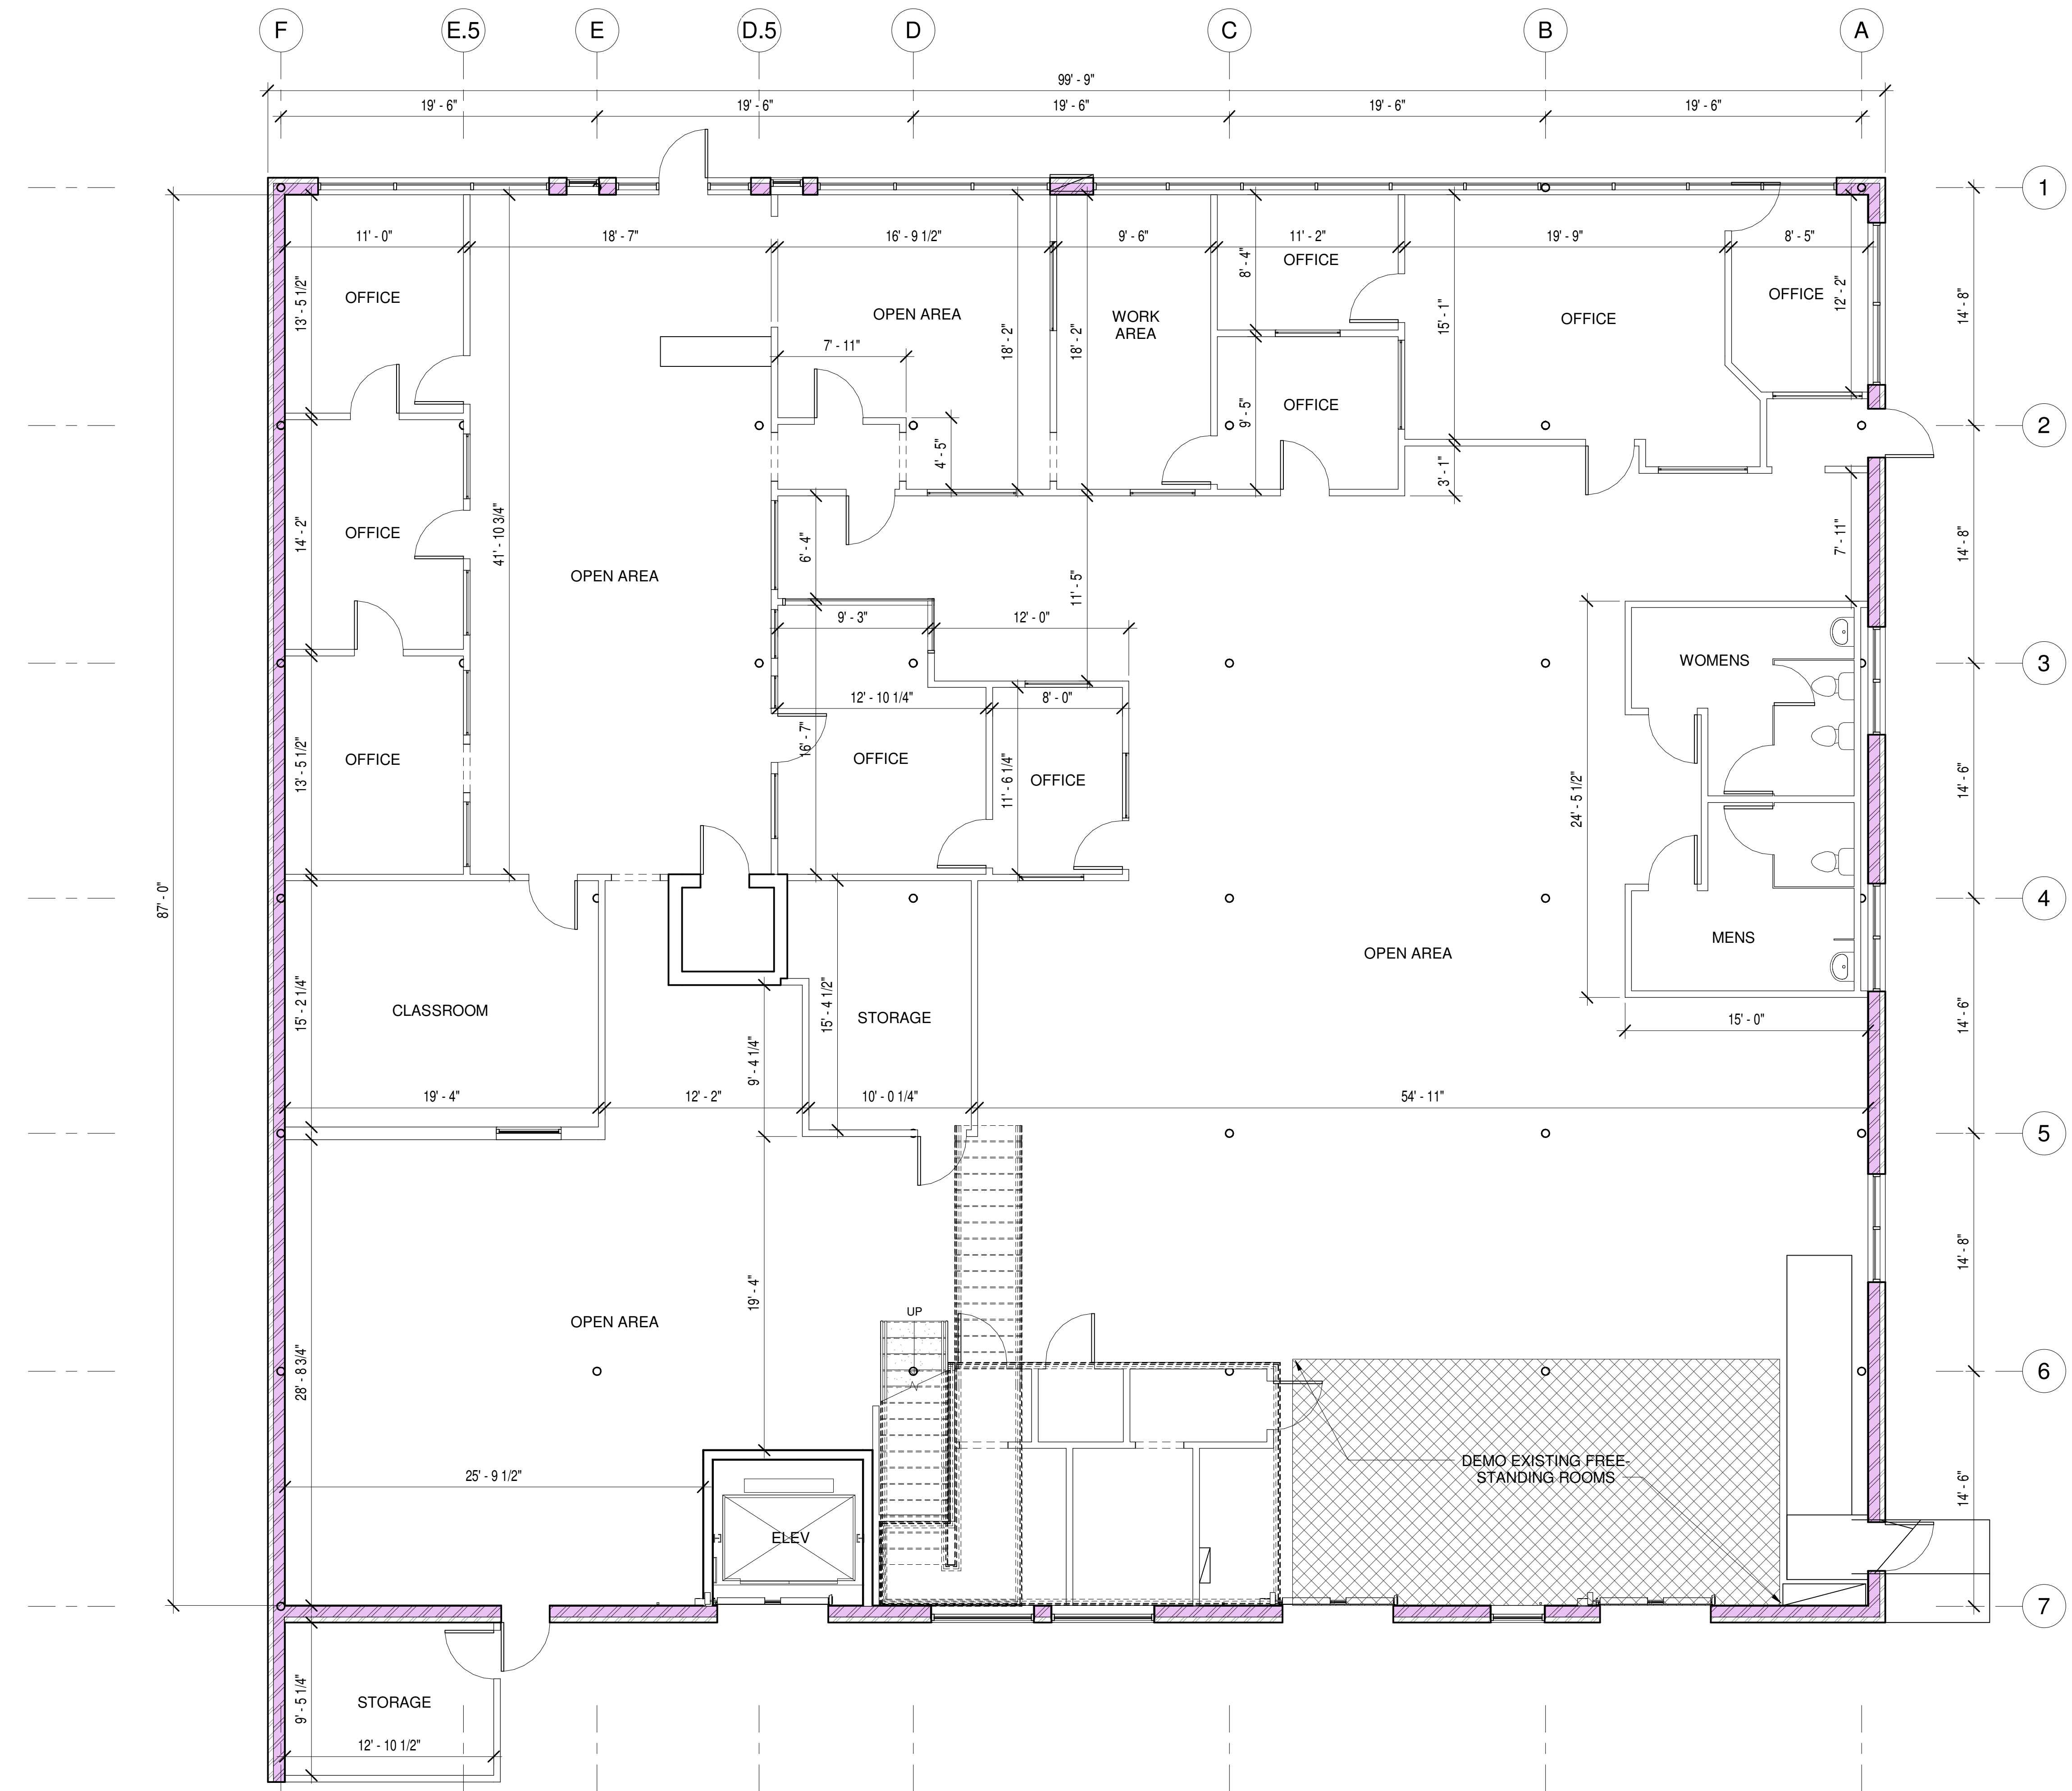

ALL DIMENSIONS AND SQUARE FOOTAGES ARE APPROXIMATE

1 LEVEL 1
3/16" = 1'-0"

This Document is Released For The Purpose Of: Design Review Under The Authority Of: MARK BROHARD, FA #21901 on MARCH 15, 2021 It Is NOT To Be Used For: Construction, Bidding Or Permit Purposes.

PROJECT NUMBER: 21006

DATE: 03-16-2021


SHEET TITLE: AS-BUILT - LEVEL 1

SHEET NUMBER:

A2.1

Lisa Benson
EASTLAND LOFTS
400 W Main Street
Eastland, TX 76448

NOT FOR CONSTRUCTION

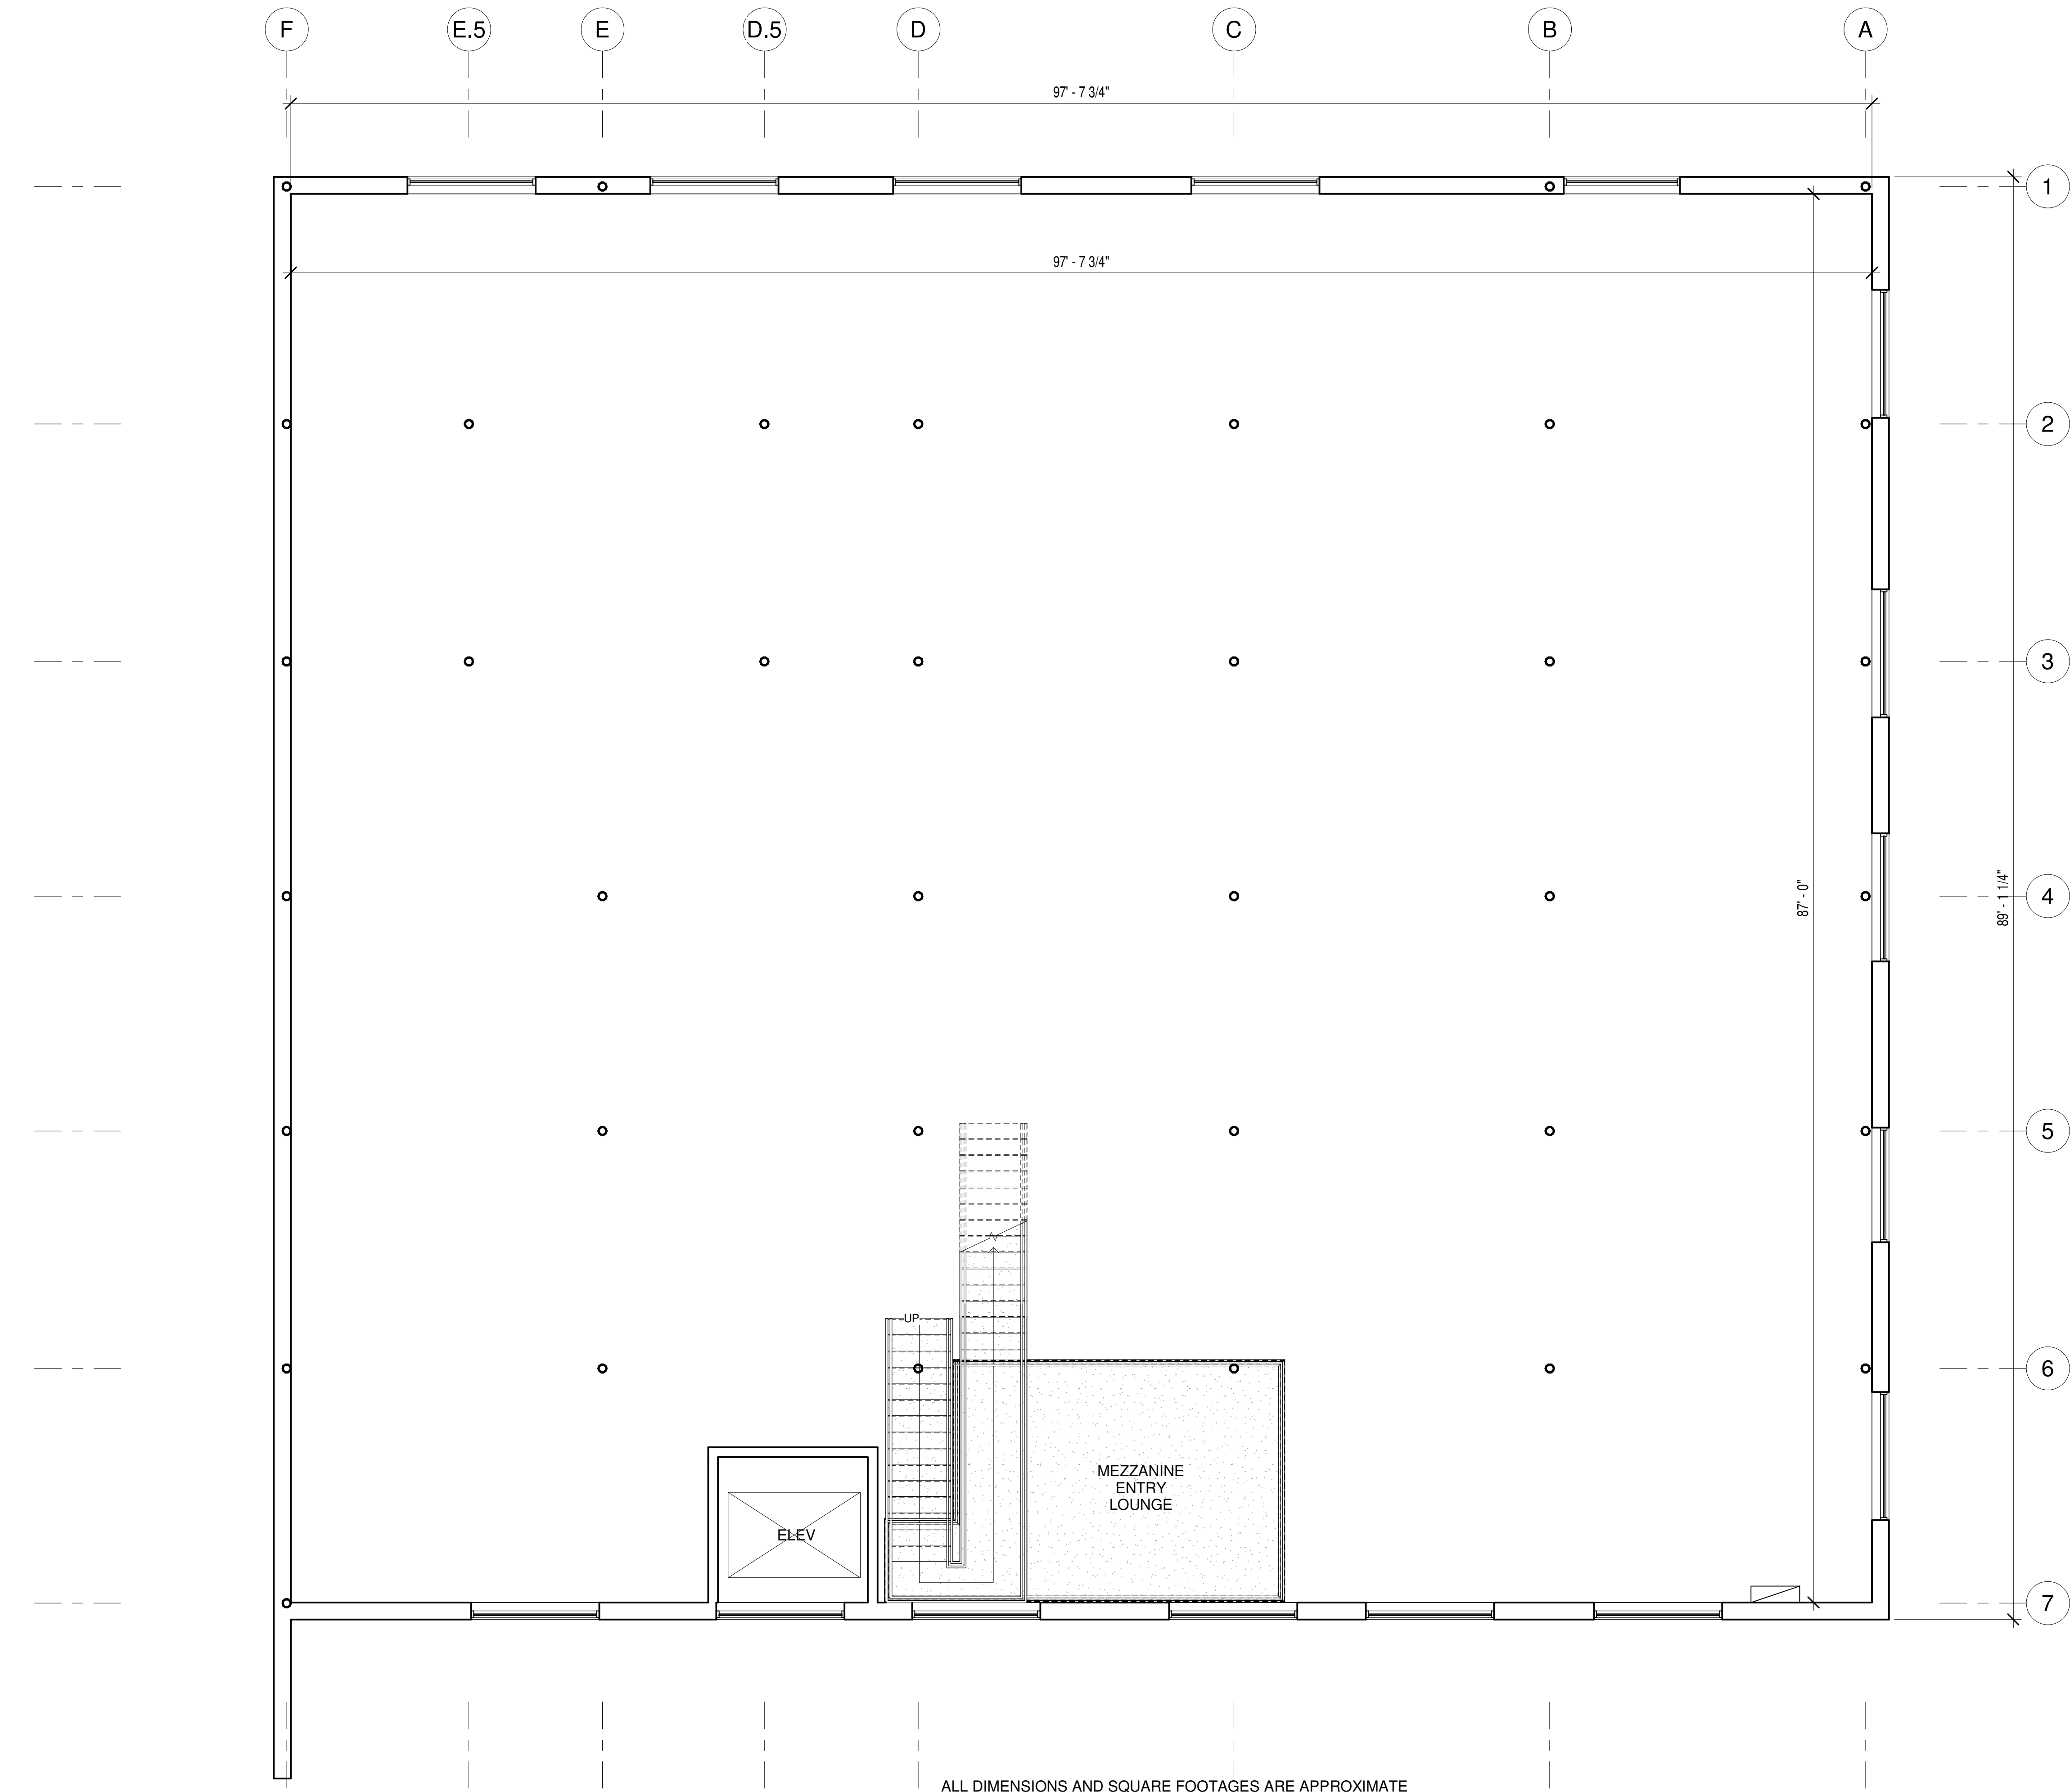

1 LEVEL 2
3/16" = 1'-0"

ALL DIMENSIONS AND SQUARE FOOTAGES ARE APPROXIMATE

This Document is Released For The Purpose Of: Design Review Under The Authority Of: MARK BROHARD, FA #21901 on MARCH 15, 2021 It is NOT To Be Used For: Construction, Bidding Or Permit Purposes.

PROJECT NUMBER: 21006

DATE: 03-16-2021

SHEET TITLE: AS-BUILT - LEVEL 2

SHEET NUMBER:

A2.2