


As-built Plans for
256 E. CAWSON STREET
Hopewell, Virginia 23860

REVISIONS:

DATE: 4/20/24

A-1

BASEMENT PLAN
(AS-BUILT)

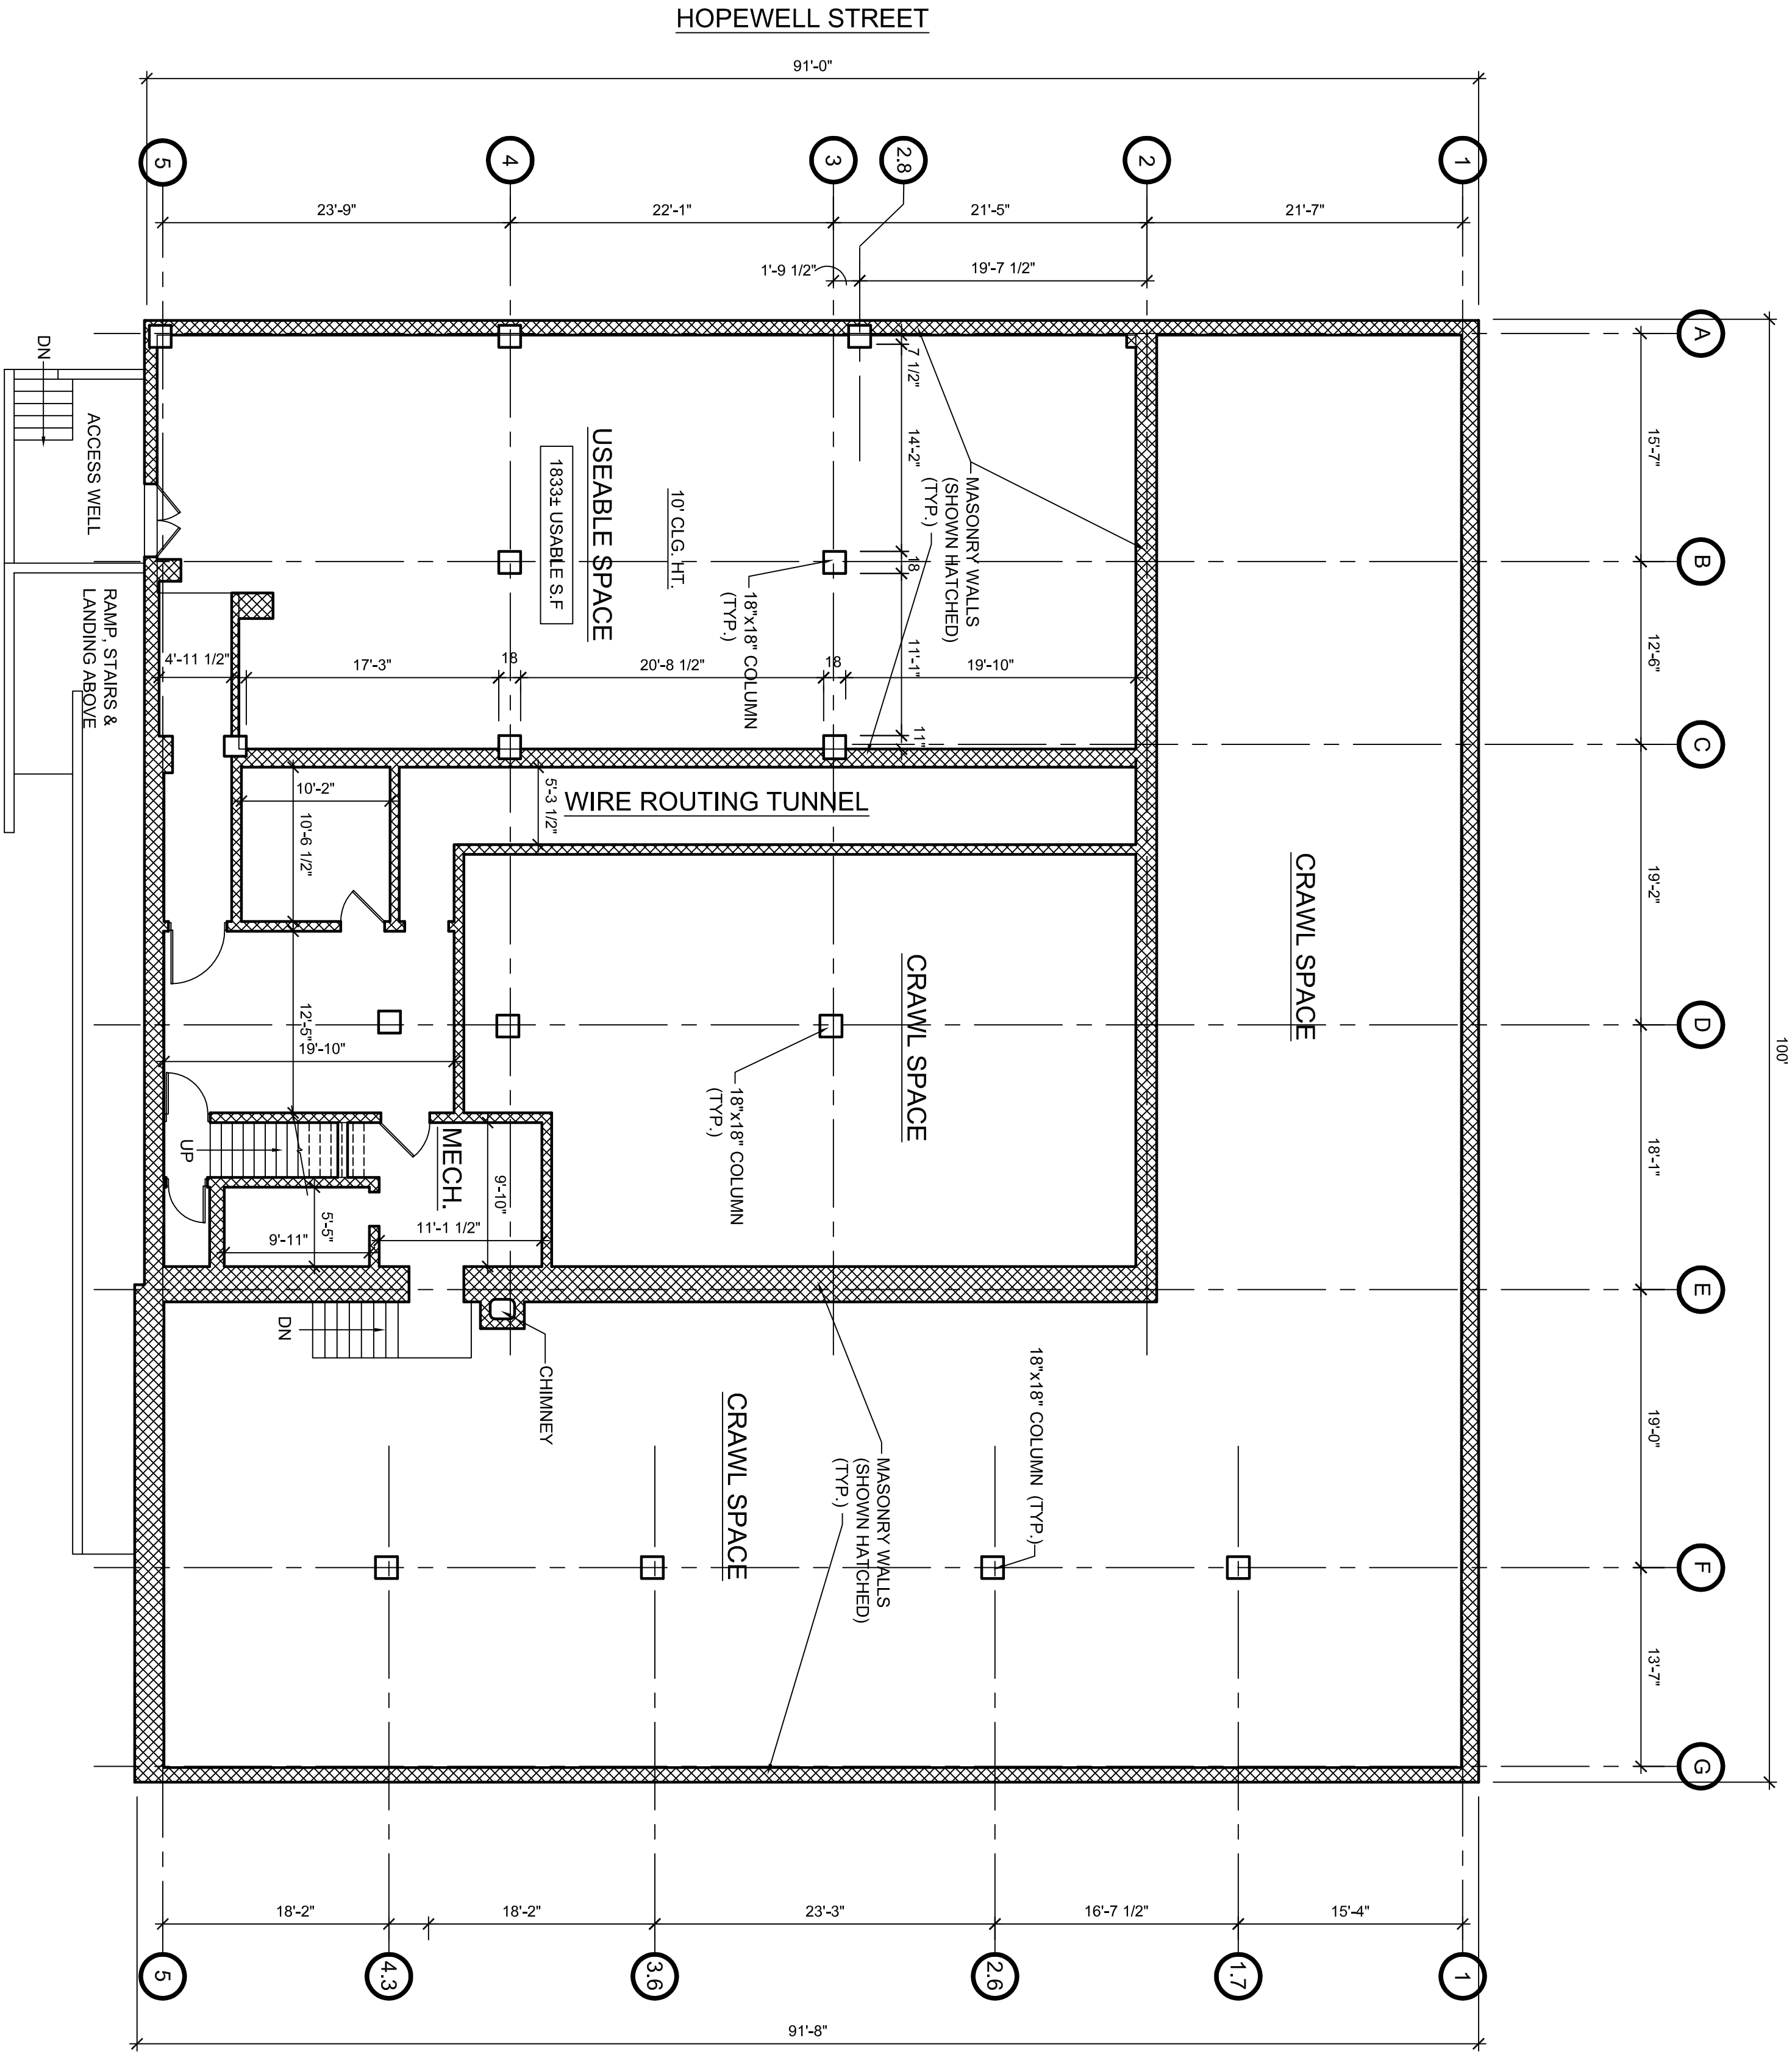

BASEMENT PLAN (AS-BUILT)

0' 4' 8' 16'

1/8" = 1'-0"

EAST CAWSON STREET