

INDUSTRIAL


12304 MCCANN DRIVE
SANTA FE SPRINGS, CA 90670

AS-BUILT DOCUMENTATION


PROJECT LINKS



CLICK HERE TO VIEW YOUR PLANS USING
PPM'S WEB VIEWER POWERED BY

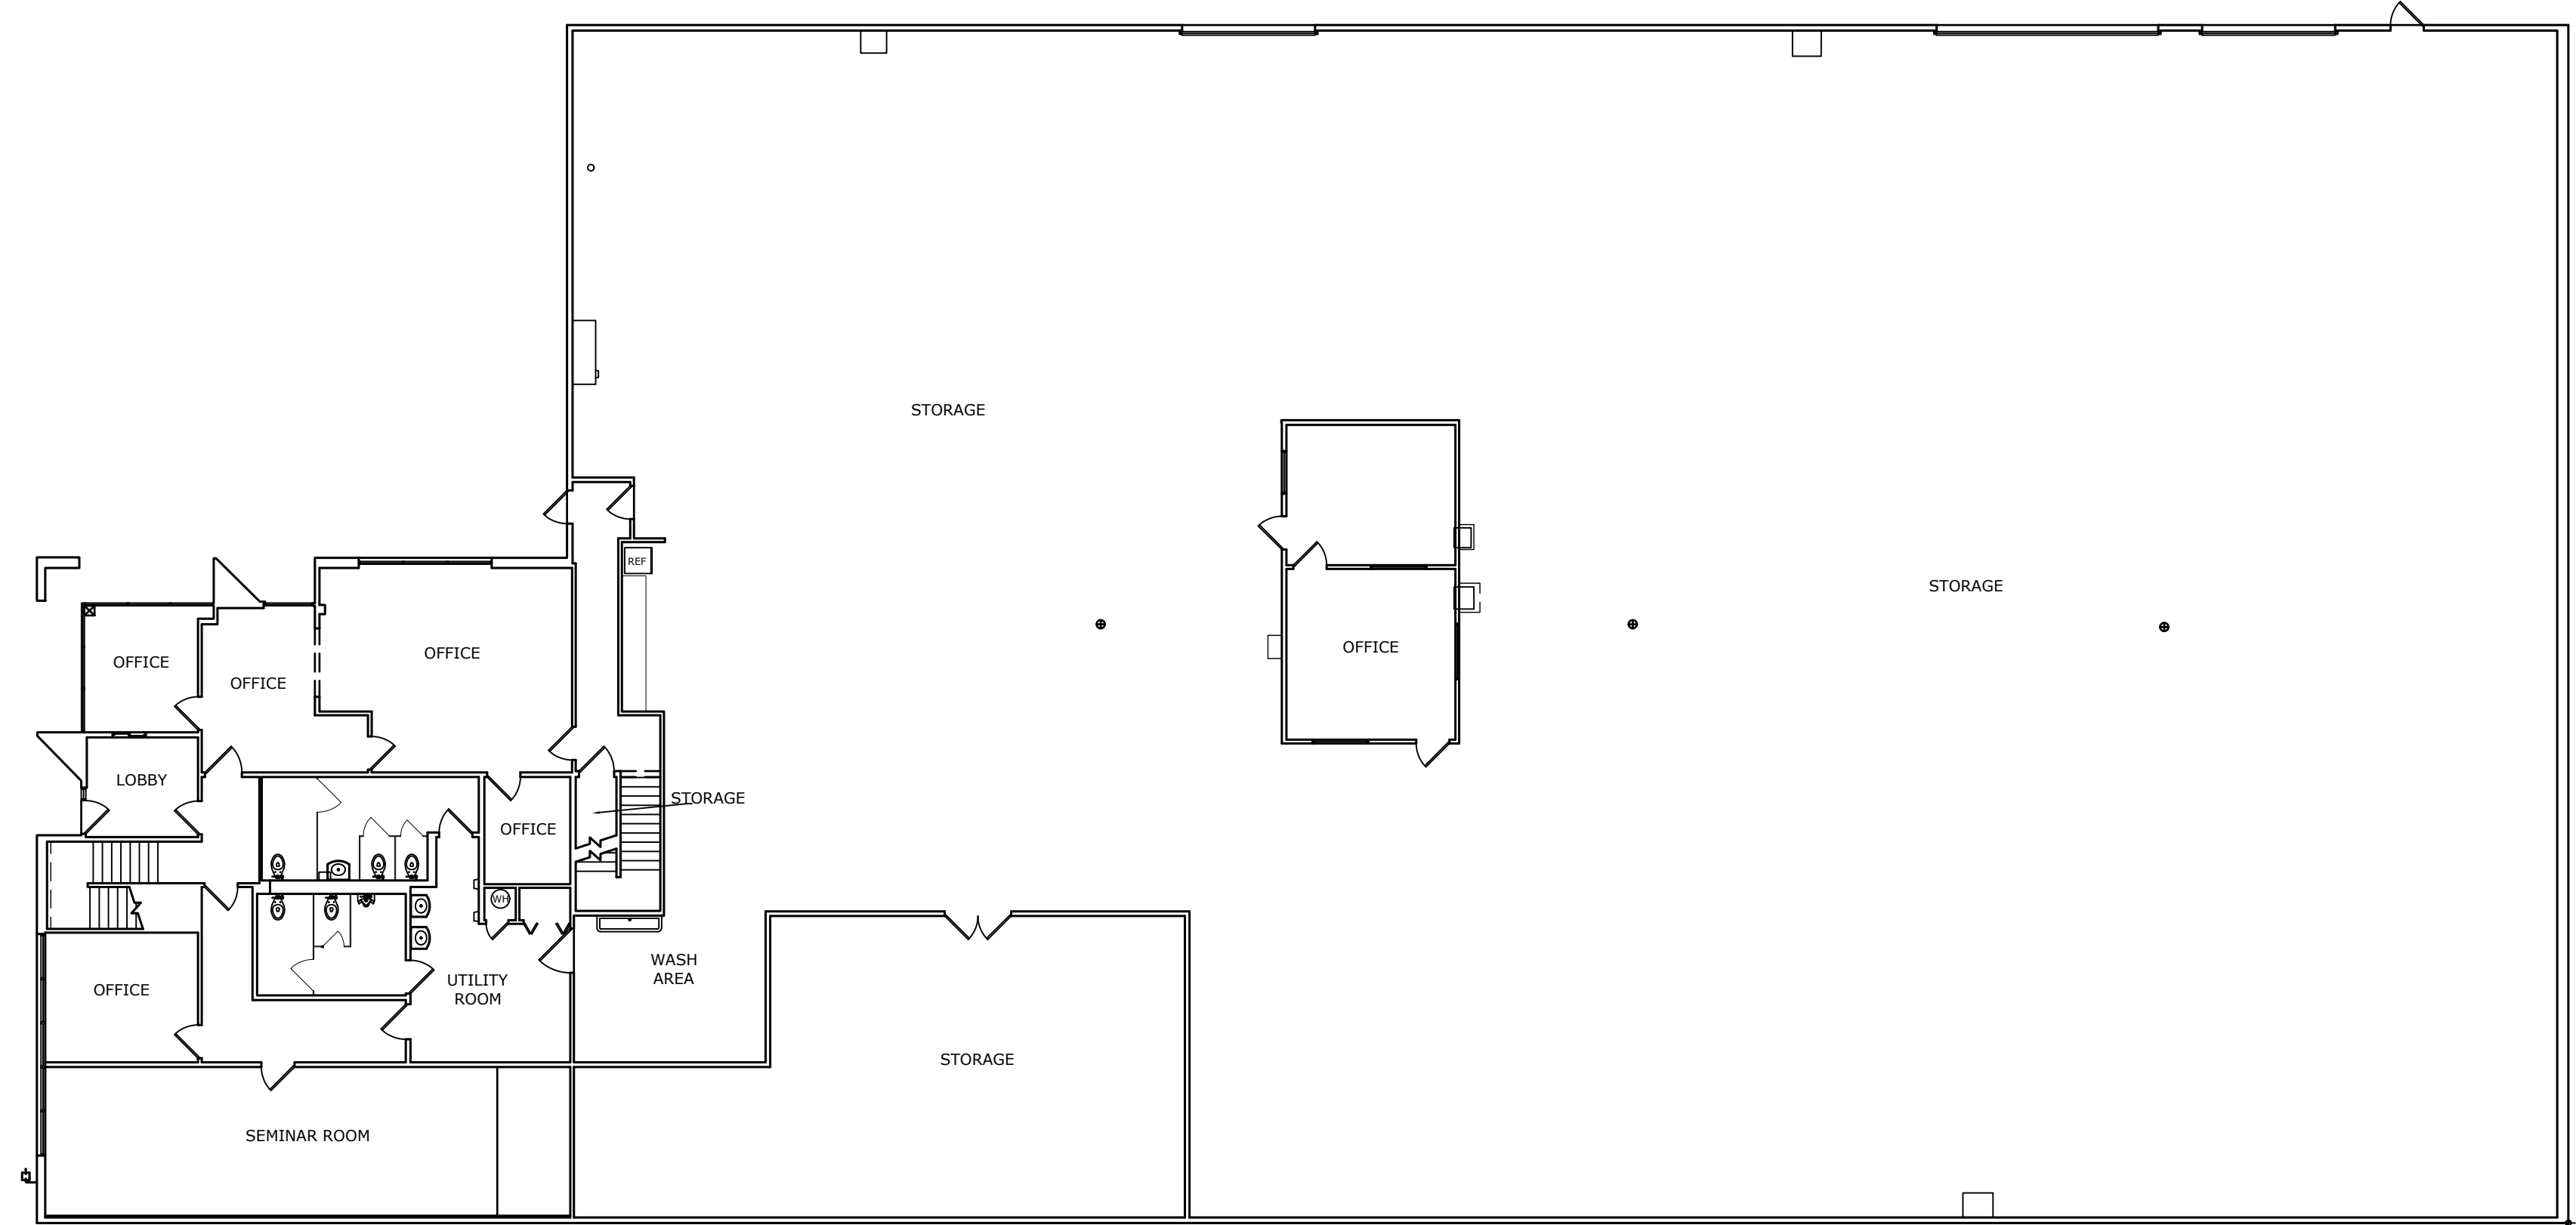

VICINITY MAP

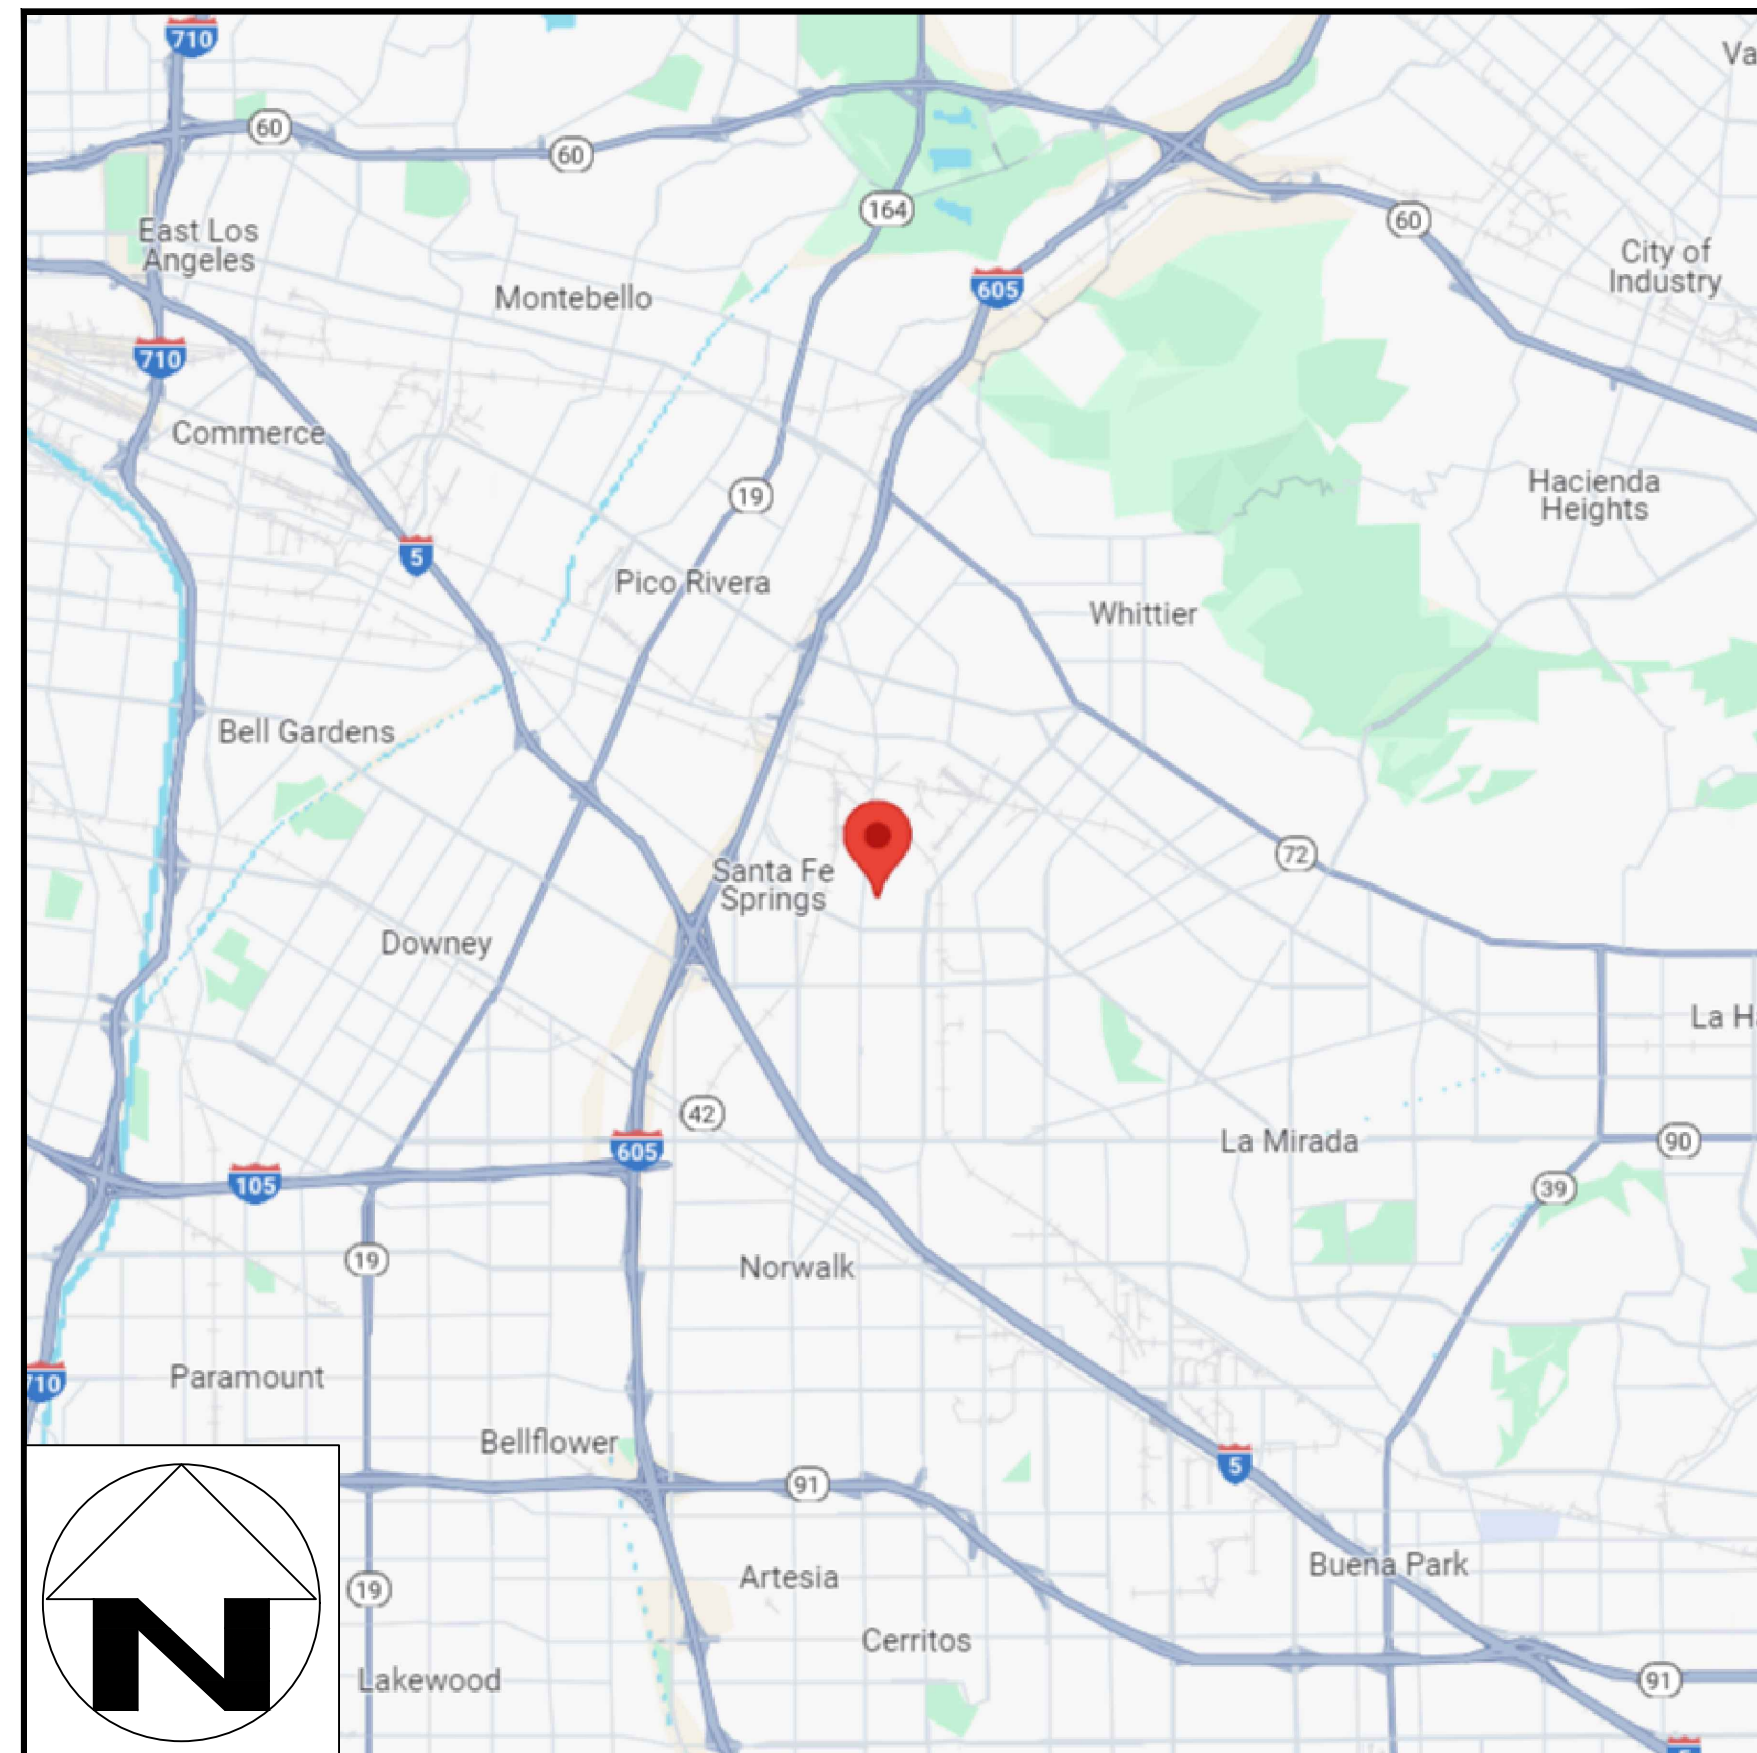

AERIAL VIEW



PPM PROJECT CONTACTS

LOS ANGELES REGIONAL OFFICE

CAMERON SLATTERBECK
REGIONAL DIRECTOR
CAMERON@PPMCO.NET
(562) 621-9100 EXT. 201


BEN JONES
PROJECT MANAGER
BJONES@PPMCO.NET
(562) 621-9100 EXT. 204

CORPORATE OFFICE
OFFICE@PPMCO.NET
(855) 272-8458 EXT. 100
[HTTPS://PPMCO.NET/CONTACT/](https://ppmco.net/contact/)

SHEET INDEX

SHEET	NAME
1	COVER PAGE
2	1ST FLOOR PLAN
3	2ND FLOOR PLAN


LEGEND			
[Symbol]	= RANGE	[Symbol]	= TANKLESS WATER HEATER
[Symbol]	= LOW CASEWORK	[Symbol]	= REFRIGERATOR
[Symbol]	= UPPER CASEWORK	[Symbol]	= OVEN
[Symbol]	= FULL HEIGHT CASEWORK	[Symbol]	= W/D = WASHER/DRYER COMBO
[Symbol]	= W = WASHER	[Symbol]	= DW = DISH WASHER
[Symbol]	= D = DRYER	[Symbol]	= TC = TRASH COMPACTOR
[Symbol]	= FUR = FURNACE	[Symbol]	= WM = WATER HEATER
[Symbol]	= WS = WATER SOFTNER	[Symbol]	= FD = FLOOR DRAIN
[Symbol]	= REF = REFRIGERATOR	[Symbol]	= GM = GAS METER
[Symbol]	= OV = OVEN	[Symbol]	= EM = ELECTRIC METER
[Symbol]	= WH = WATER HEATER	[Symbol]	= EP = ELECTRICAL PANEL
[Symbol]	= WS = WATER SOFTNER	[Symbol]	= WH = WALL HEATER
[Symbol]	= FD = FLOOR DRAIN	[Symbol]	= DP = DATUM POINT
[Symbol]	= GM = GAS METER	[Symbol]	= CLG = CEILING HEIGHT
[Symbol]	= EM = ELECTRIC METER	[Symbol]	= HH = HEADER HEIGHT

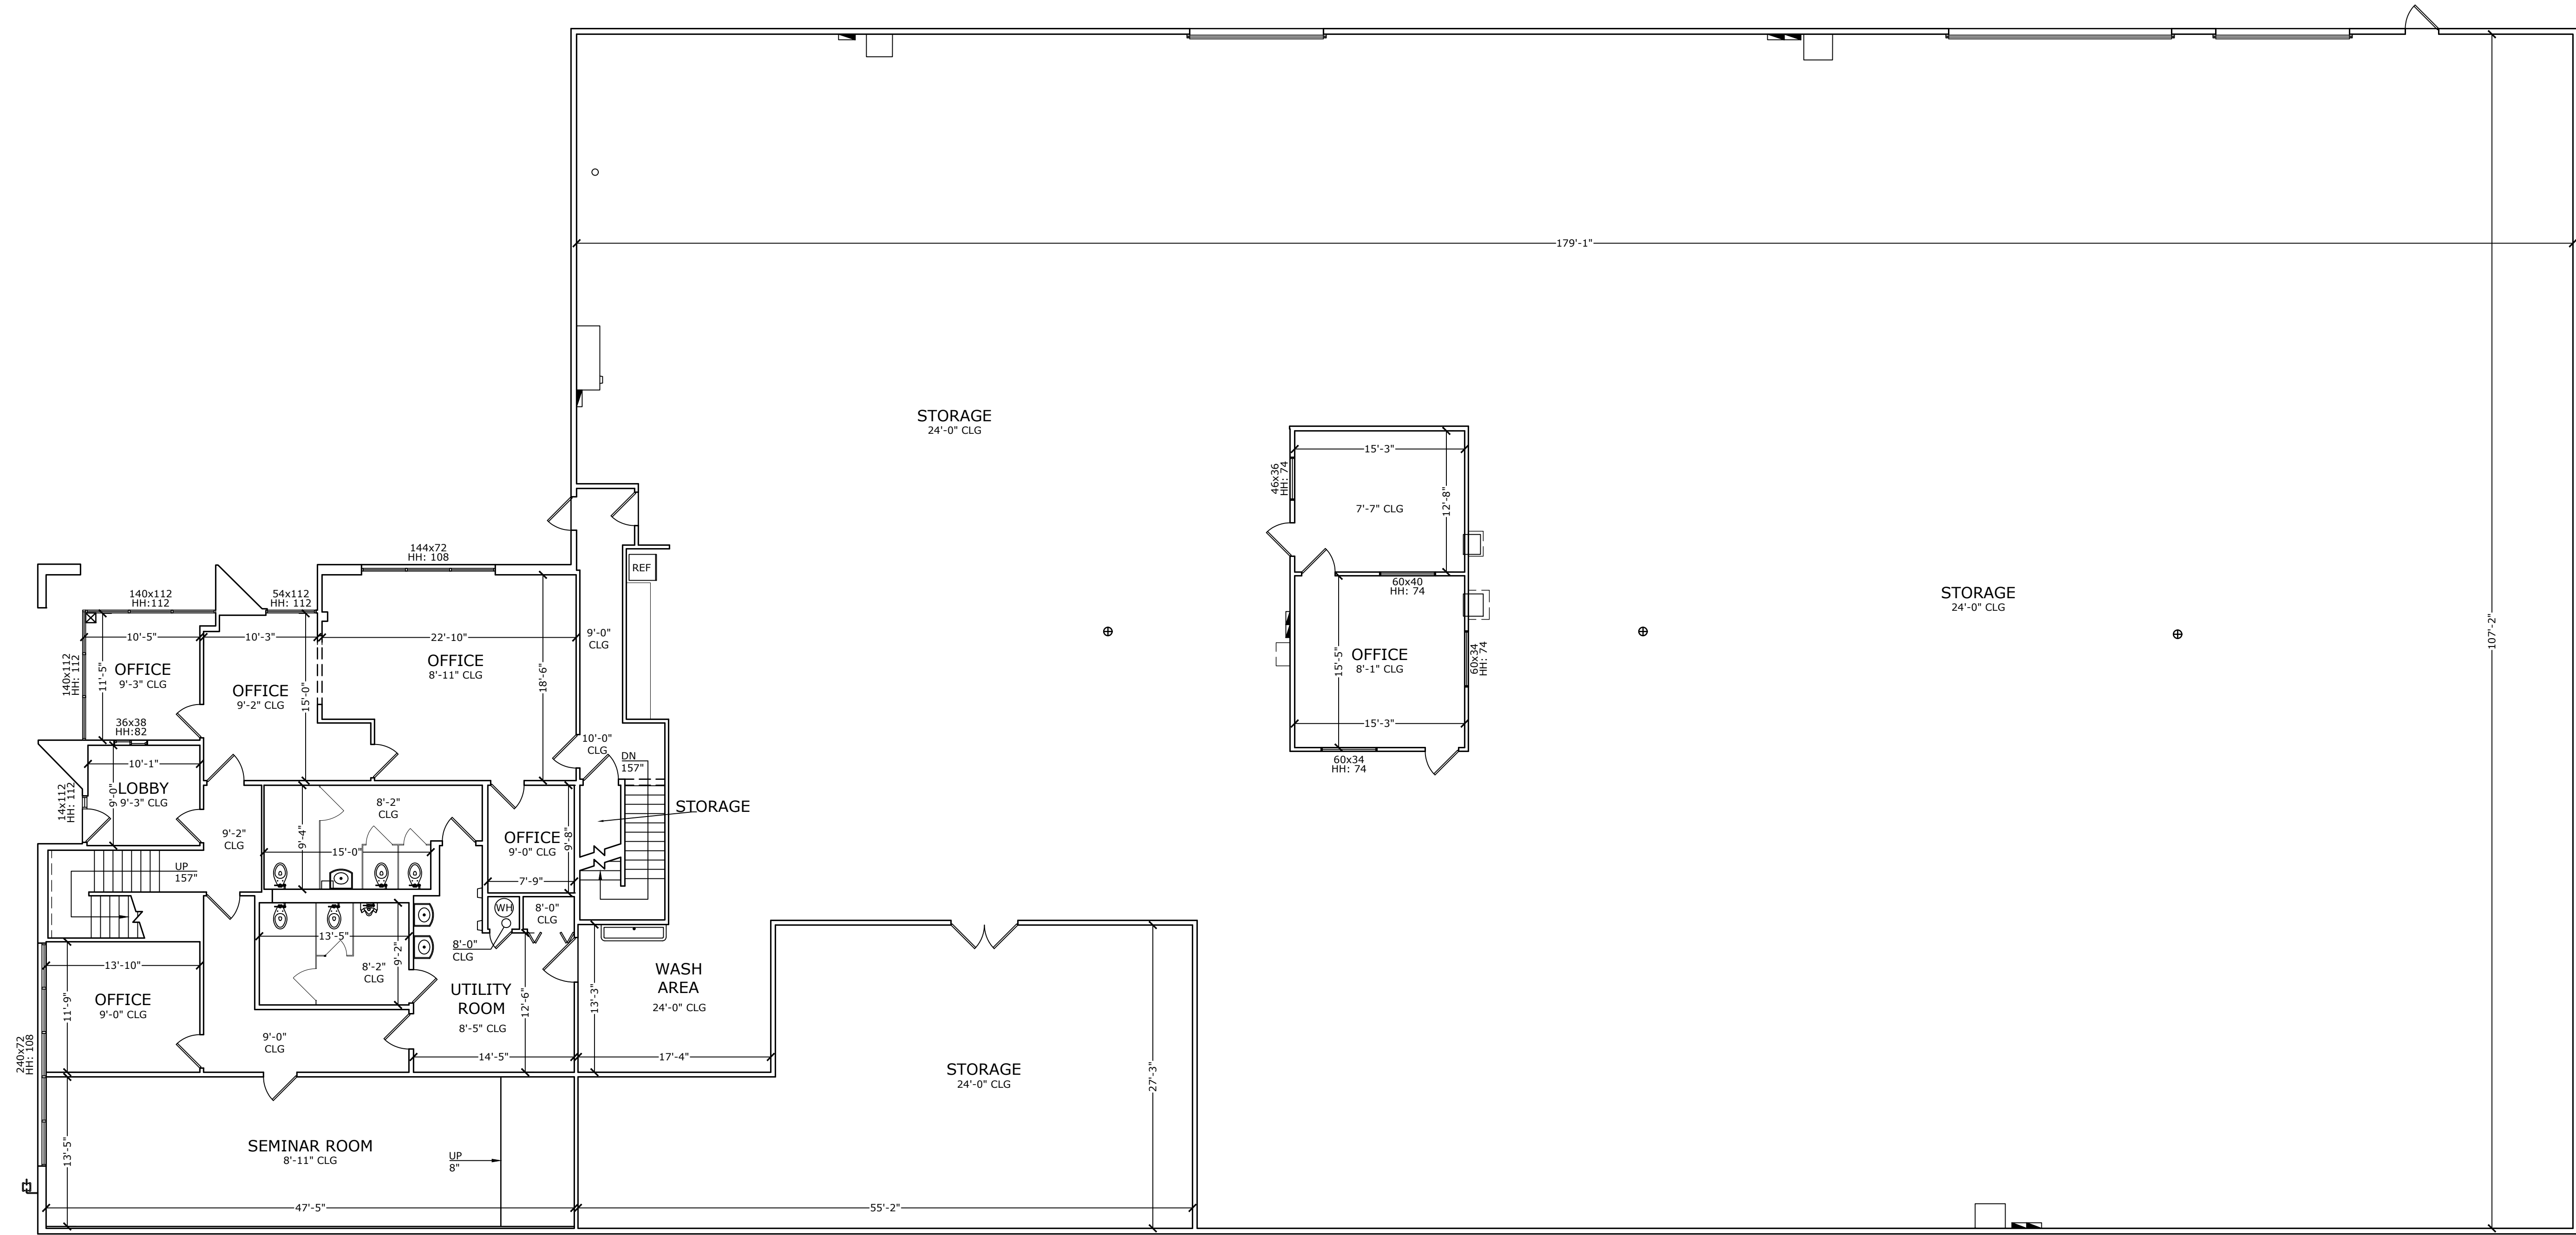

2746 SF OFFICES
 19483 SF WAREHOUSE
 22229 SF TOTAL

1st FLOOR

LEGEND			
[Symbol]	= RANGE	[Symbol]	= TANKLESS WATER HEATER
[Symbol]	= LOW CASEWORK	[Symbol]	= REFRIGERATOR
[Symbol]	= UPPER CASEWORK	[Symbol]	= OVEN
[Symbol]	= FULL HEIGHT CASEWORK	[Symbol]	= W/D = WASHER/DRYER COMBO
[Symbol]	= W = WASHER	[Symbol]	= D = DRYER
[Symbol]	= WS = WATER SOFTNER	[Symbol]	= FD = FLOOR DRAIN
[Symbol]	= WH = WATER HEATER	[Symbol]	= GM = GAS METER
[Symbol]	= EH = ELECTRICAL PANEL	[Symbol]	= WH = WALL HEATER
[Symbol]	= DP = DATUM POINT	[Symbol]	= CLG = CEILING HEIGHT
[Symbol]	= EM = ELECTRIC METER	[Symbol]	= HH = HEADER HEIGHT

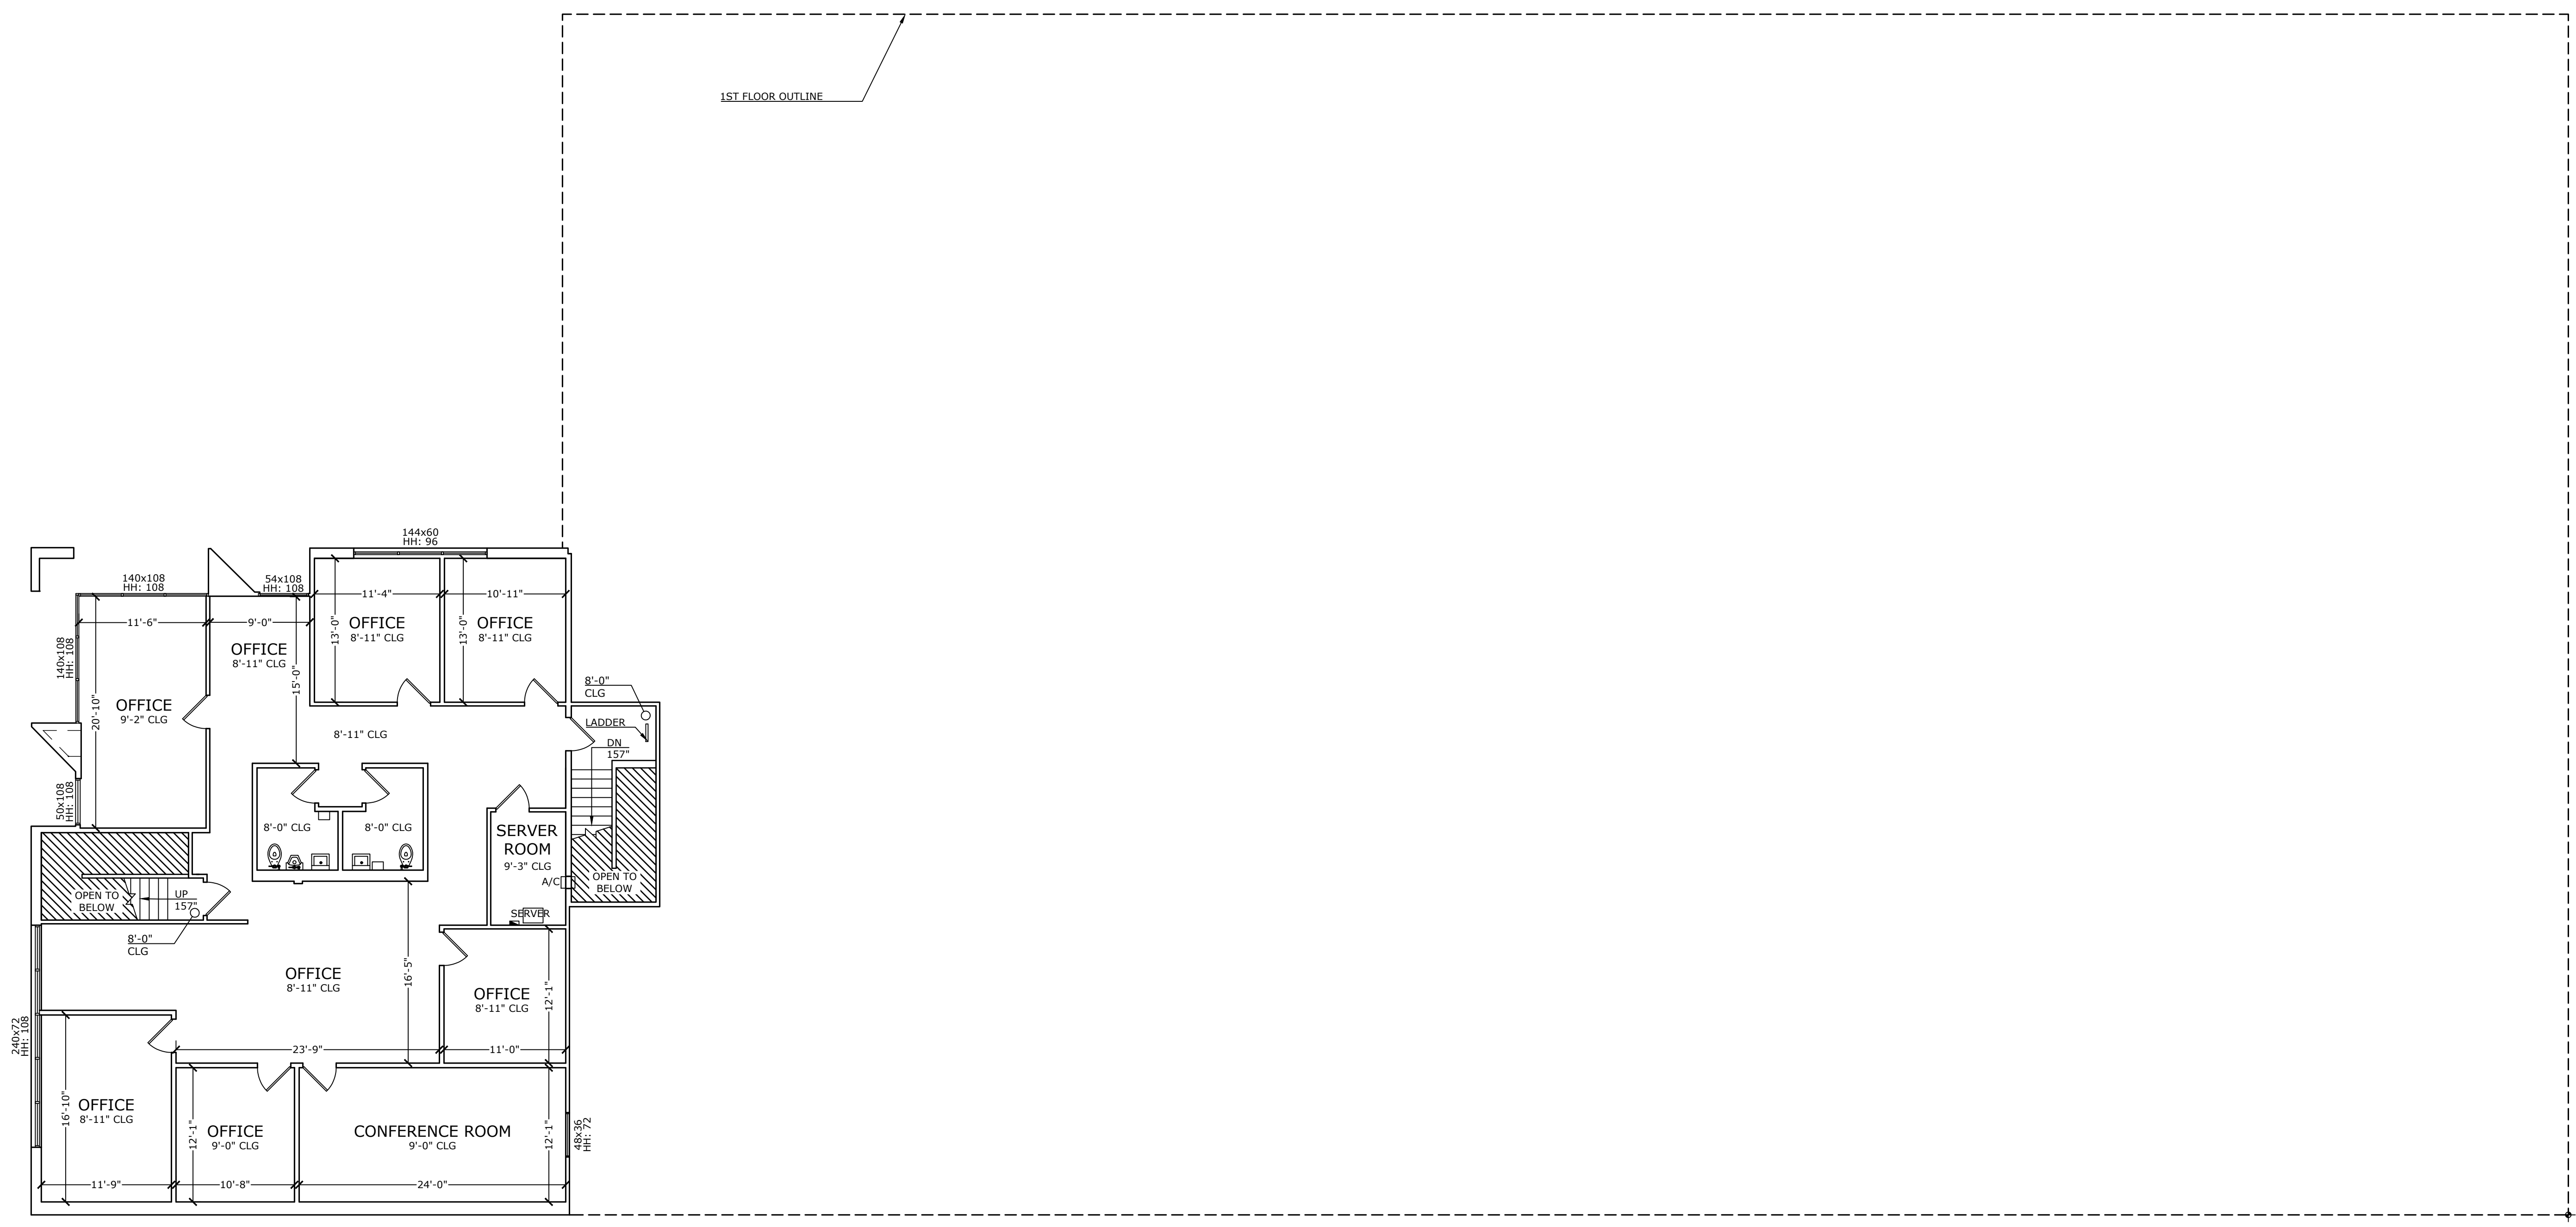

2893 SF

2ND FLOOR