

LP = LIGHT POLE

MH = MANHOLE



• B = BOLLARD

TC = TOP OF CURB

C/O = CLEAN-OUT

LOT 2

LOT 4

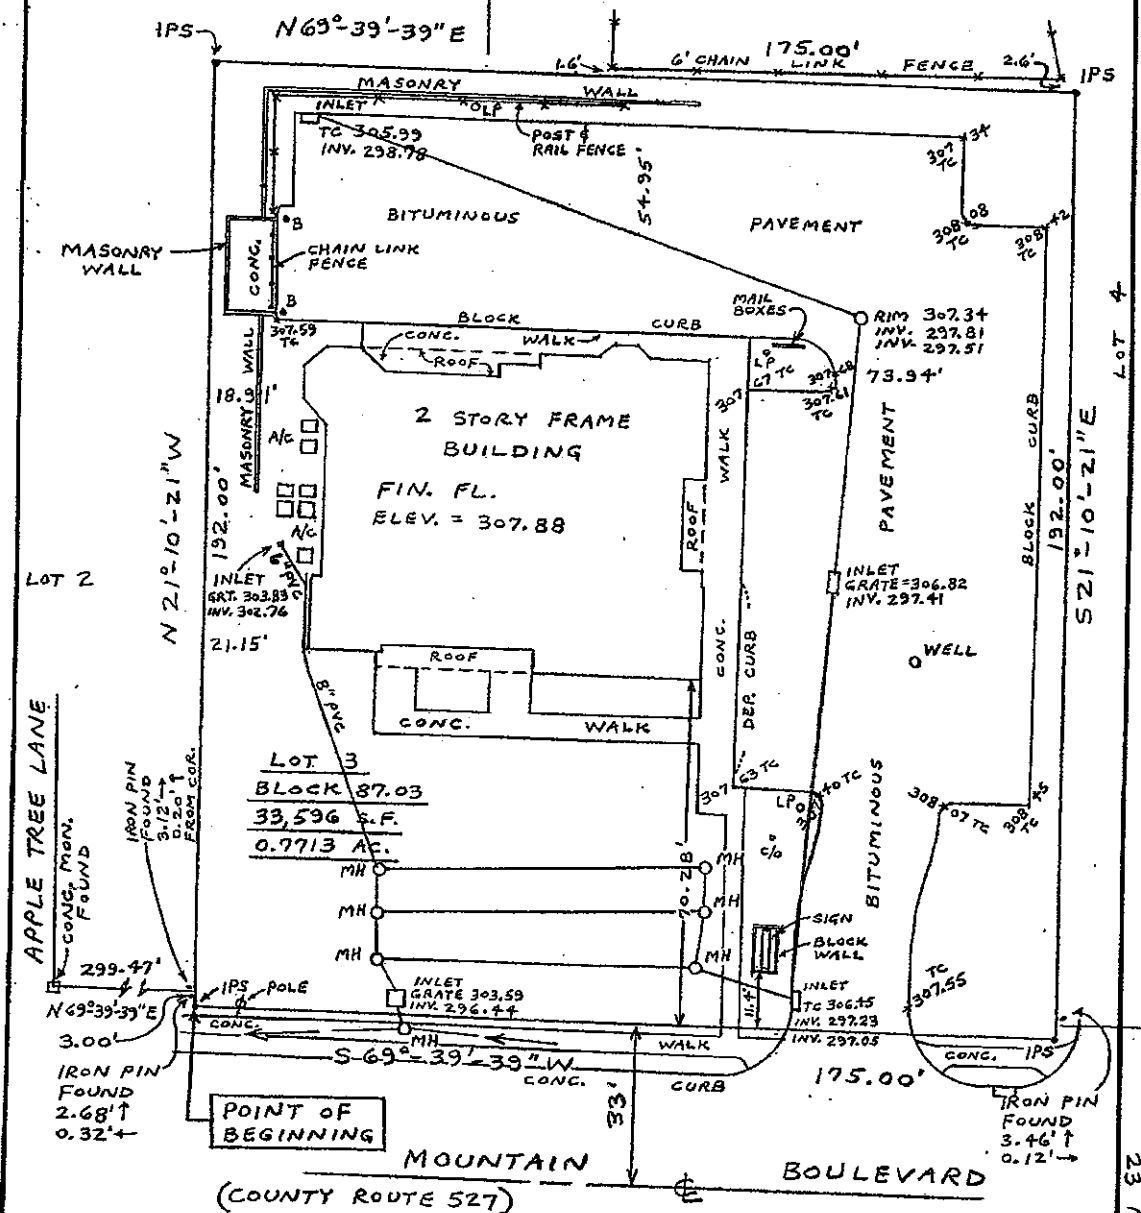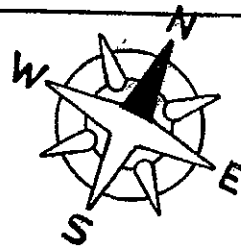

SEE SITE PLAN FOR AS-BUILTS

IPS = IRON PIPE SET

FISK ASSOCIATES

ENGINEERS-SURVEYORS-PLANNERS

631 UNION AVENUE

MIDDLESEX, NEW JERSEY 08846

732-356-9322

Stephen M. Fisk 6-4-09
STEPHEN M. FISK, L.S., Lic. 23919
PAUL A. FISK, P.E., Lic. 26353

L.S. - Professional Land Surveyor

P.E. - Professional Engineer

THIS SURVEY IS CERTIFIED ONLY TO:

BE-KI ASSOCIATES, L.L.C.
 23 MOUNTAIN BOULEVARD REALTY, L.L.C.
 KIWU HOLDINGS, L.L.C.
 PETER T. DEROSA, ESQ.
 H. JONATHAN RUBINSTEIN, ESQ.
 THE FEINSILVER LAW GROUP, P.C.
 CROWNLINE TITLE AGENCY, L.L.C.
 FIRST AMERICAN TITLE INSURANCE COMPANY
 LAKELAND BANK, ITS SUCCESSORS AND/OR ASSIGNS,
 AS THEIR INTERESTS MAY APPEAR
 ANDREA & ROMANO, L.L.C.
 MELISSA MULLENBURG, ESQ.

MAP OF SURVEY
23 MOUNTAIN BOULEVARD
LOT 3 **BLOCK 87.03**
TOWNSHIP OF WARREN
SOMERSET COUNTY NEW JERSEY
DEC. 28, 2006 **SCALE: 1"=30'**

534.160
 582.89, 28.108

W-4291-F

WARREN