





Colliers International  
1301 Gervais St, Suite 600  
Columbia, SC, 29201  
803-254-2300  
www.colliers.com

# One Harbison Way As Built

One Harbison Way, Columbia, SC, 29212

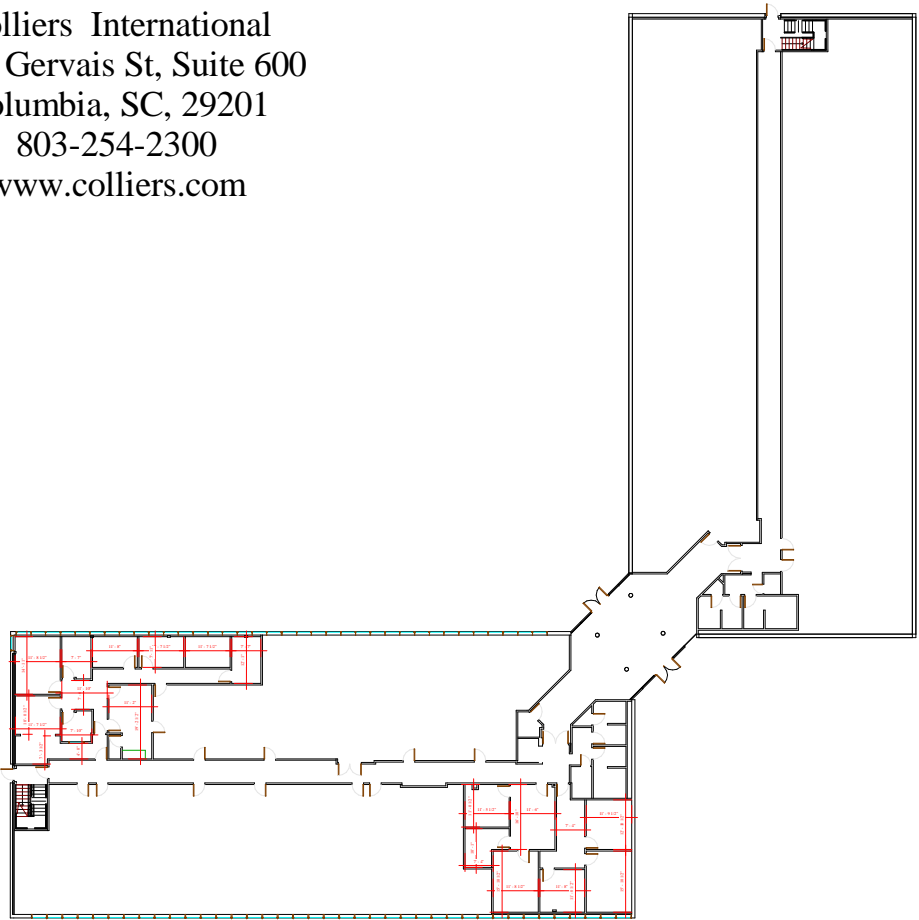

② 1st Floor Dimension Plan  
1" = 50'-0"

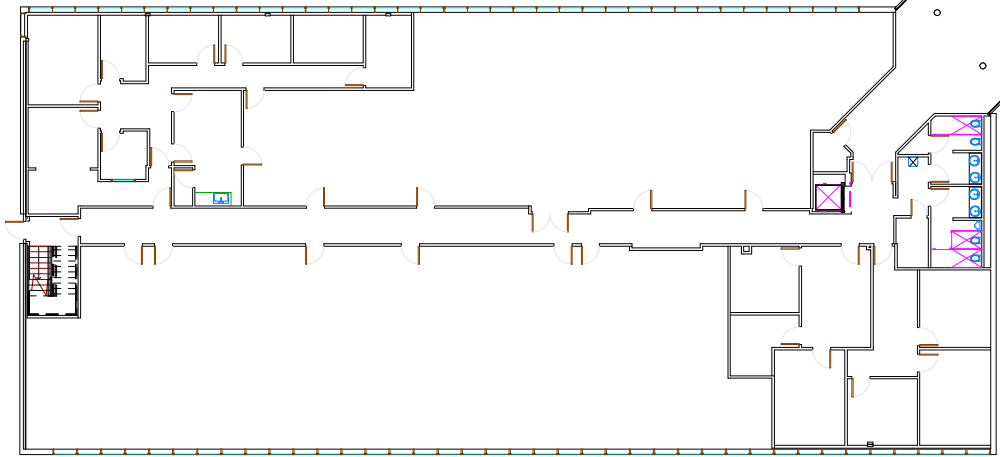


Formatted for 11" x 17" Sheet

① 1st Floor Wall Plan  
1/32" = 1'-0"

## Usable Area Legend

Suite 100	1345 SF
Suite 109	1568 SF
Common Area	4219 SF

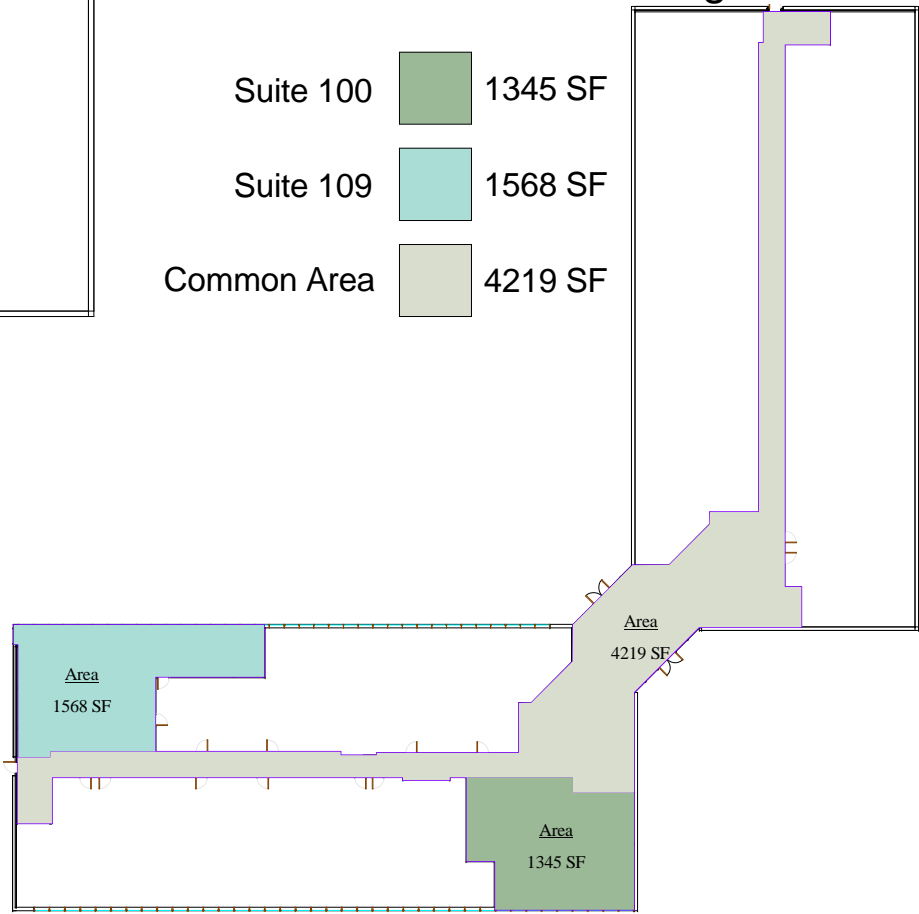

③ 1st Floor Area Plan  
1" = 50'-0"

Prepared by **DSquared Consulting**  
1432 D Avenue  
West Columbia, SC, 29169  
p - 803-622-9037  
f - 877-651-9982  
www.dsquaredconsulting.com



These drawings are provided solely for graphic representation purposes. DSquared shall not be held liable for any and all misstatements of facts, errors or omissions, prior sale, change of price or withdrawal from the market without notice, or damages connected with the use of this information. Recipient acknowledges that acceptance of this information effectively transfers any and all responsibility to recipient for use of this information.

ALL DIMENSIONS SHOULD BE FIELD VERIFIED!  
Published on 5/21/2012 2:31:07 PM