


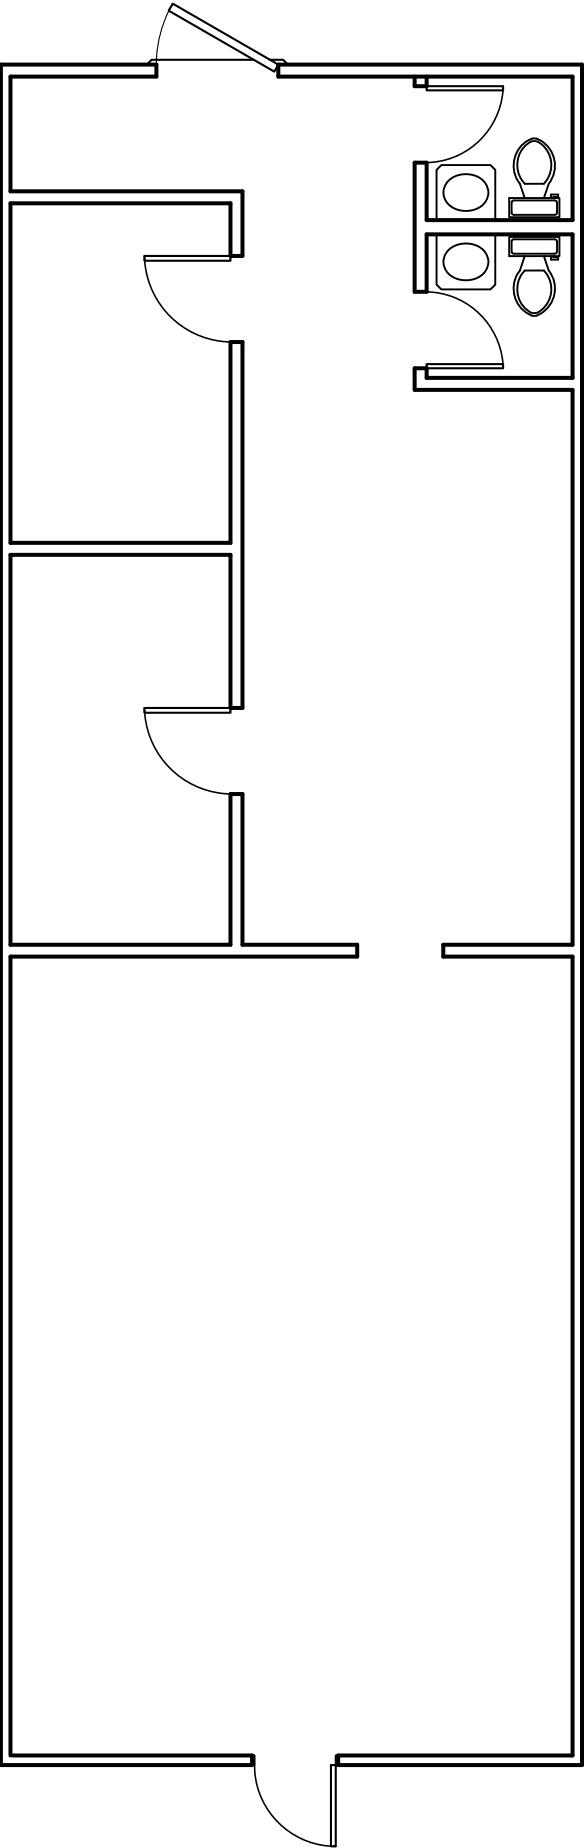

EXISTING SQUARE FOOTAGE: _____
BOMA - GRA 1200 #±

5761 Manatee Avenue West
Bradenton, Florida 34209

CLIENT: Executive Property
Management Group

AS-BUILT DATE: 11/19/14

SCALE: NTS

FINE IMPRESSIONS STUDIOS
ARCHITECTURAL DRAWING & DESIGN
920 59th Street West
Bradenton, FL 34205
941.748.0613

