


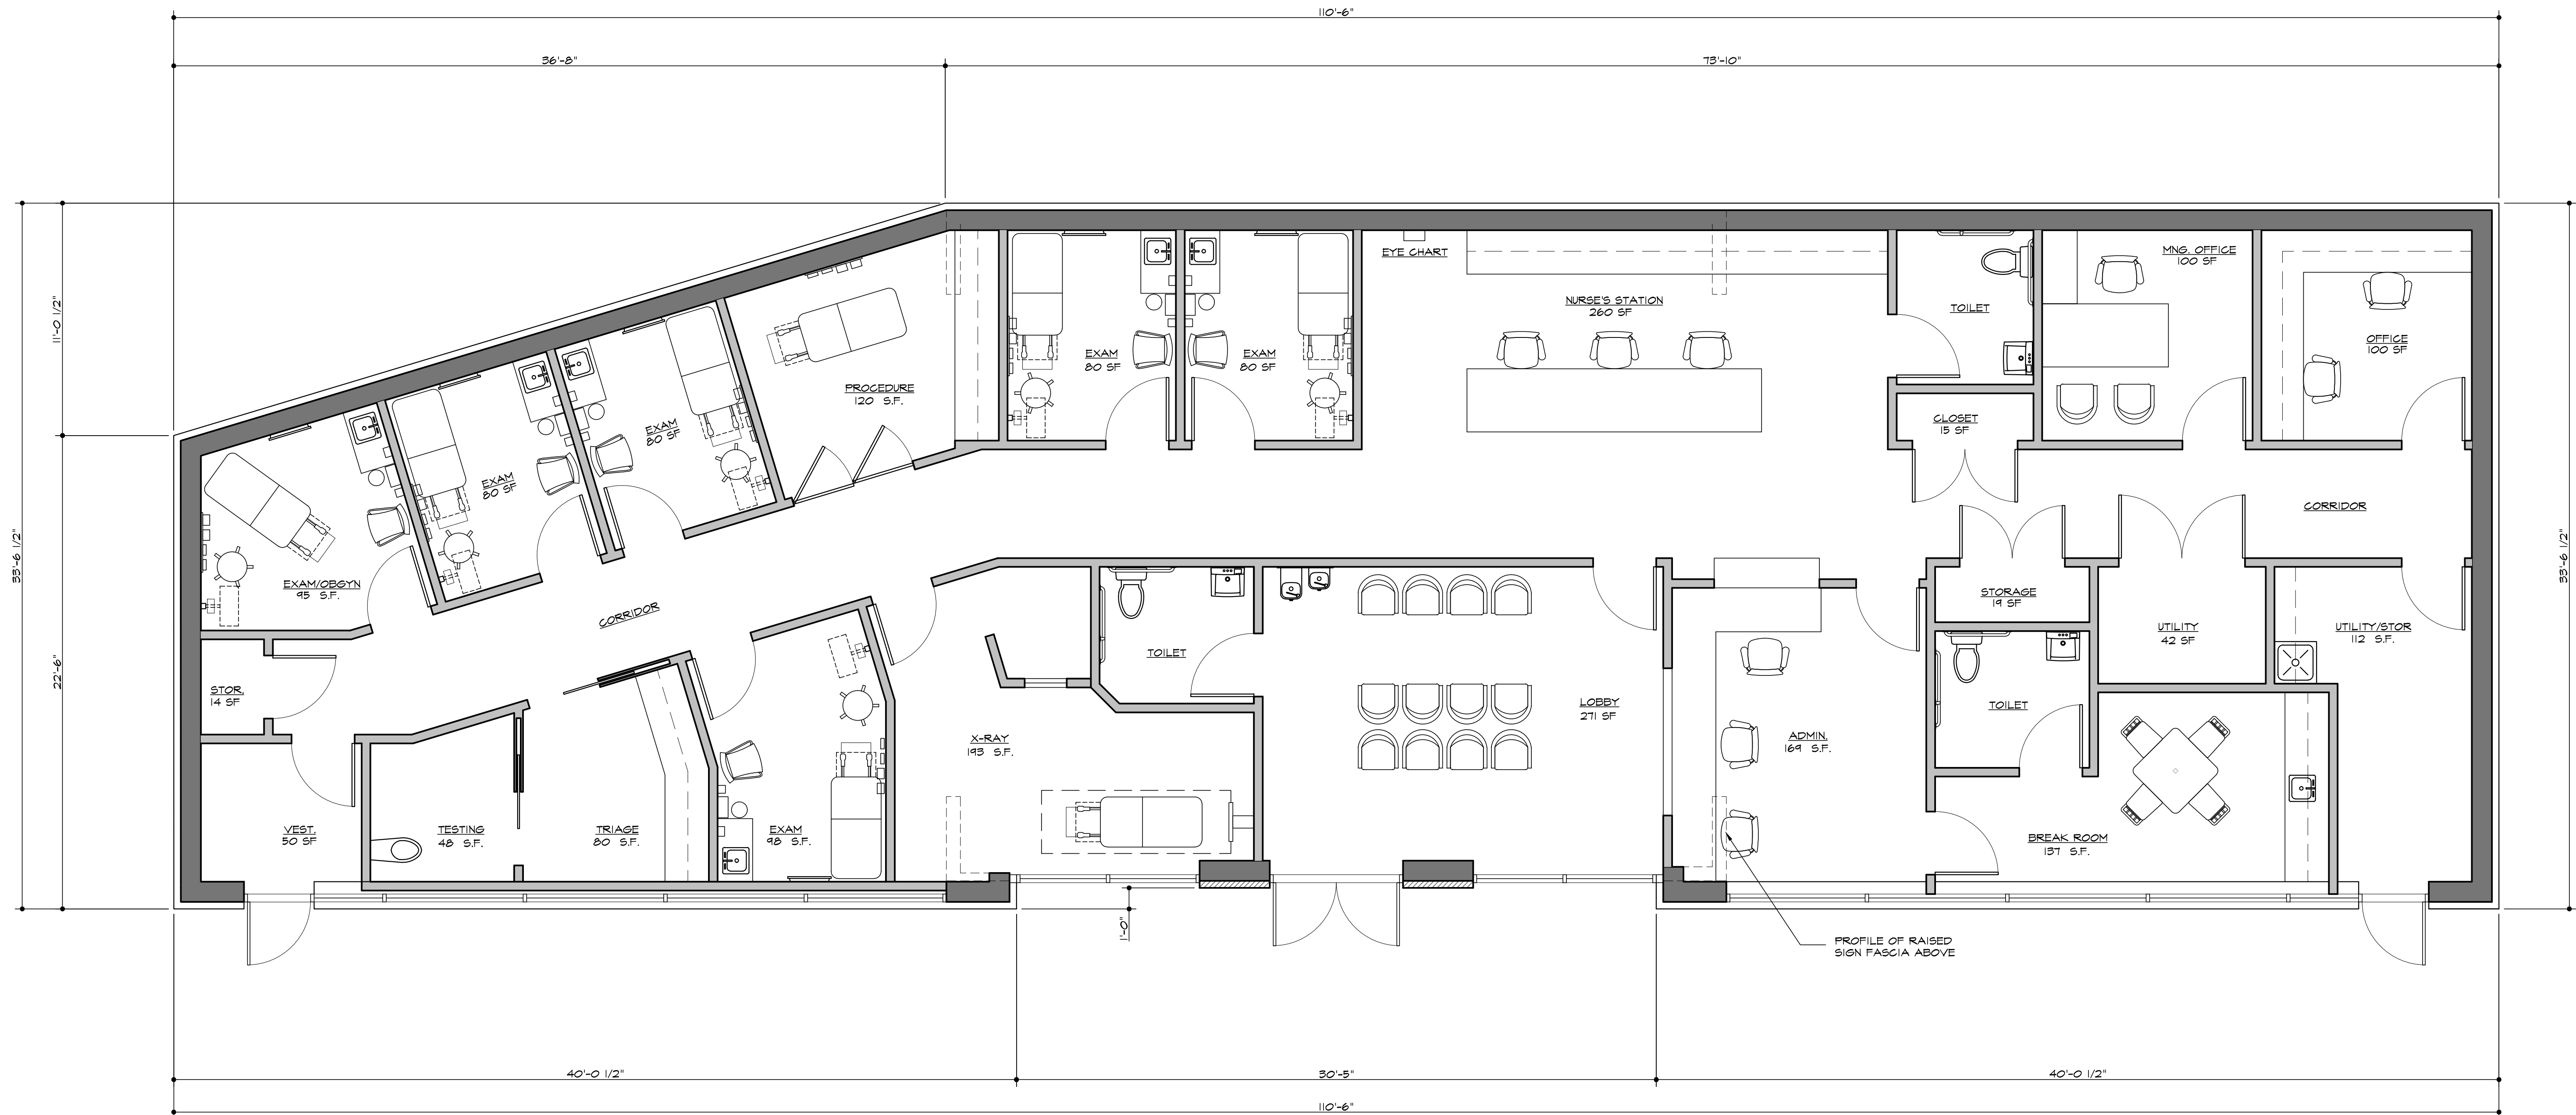

PRELIMINARY FLOOR PLAN
SCALE: 1/4"=1'-0"
GROSS BUILDING AREA: 3,410 SF

ADDED PRELIMINARY TENANT PLAN LAYOUT	6-26-23	4
MISCELLANEOUS REVISIONS PER MUNICIPAL COMPLIANCE REVIEW COMMENTS	6-23-23	3
MISCELLANEOUS REVISIONS PER MUNICIPAL REVIEW COMMENTS	4-3-23	2
MISCELLANEOUS REVISIONS PER MUNICIPAL REVIEW COMMENTS DATED 12/13/22	12-16-22	1
ISSUED FOR MUNICIPAL REVIEW AND APPROVAL	8-18-22	
ISSUED FOR CONCEPT REVIEW	5-6-22	
REVISION	DATE	NO.

DATUM ELEVATION 0'-0" =





PRELIMINARY FLOOR PLAN
NEW BUILDING
LOT 1, BLOCK 606
440 ROUTE 22
HILLSIDE, NEW JERSEY

1130 Route 202 South
Building B, Suite 5
Raritan, NJ 08859-1494
Phone: (609) 707-8100
Fax: (609) 707-8484
info@architectplus.com

Architecture PLUS
PC

Rocco Campanella, RA
NJ Reg. No. 09178
NY Reg. No. 019838
PA Reg. No. B-11734
Marc T. Marston, RA
NJ Reg. No. 10919
© 2022 Architecture PLUS, pc

SCALE : AS NOTED
DRWN BY : PL CHKD BY : RC
DATE : 5-6-22
PROJ. NO. : 21-152
DWG. NO. : A1P of 2

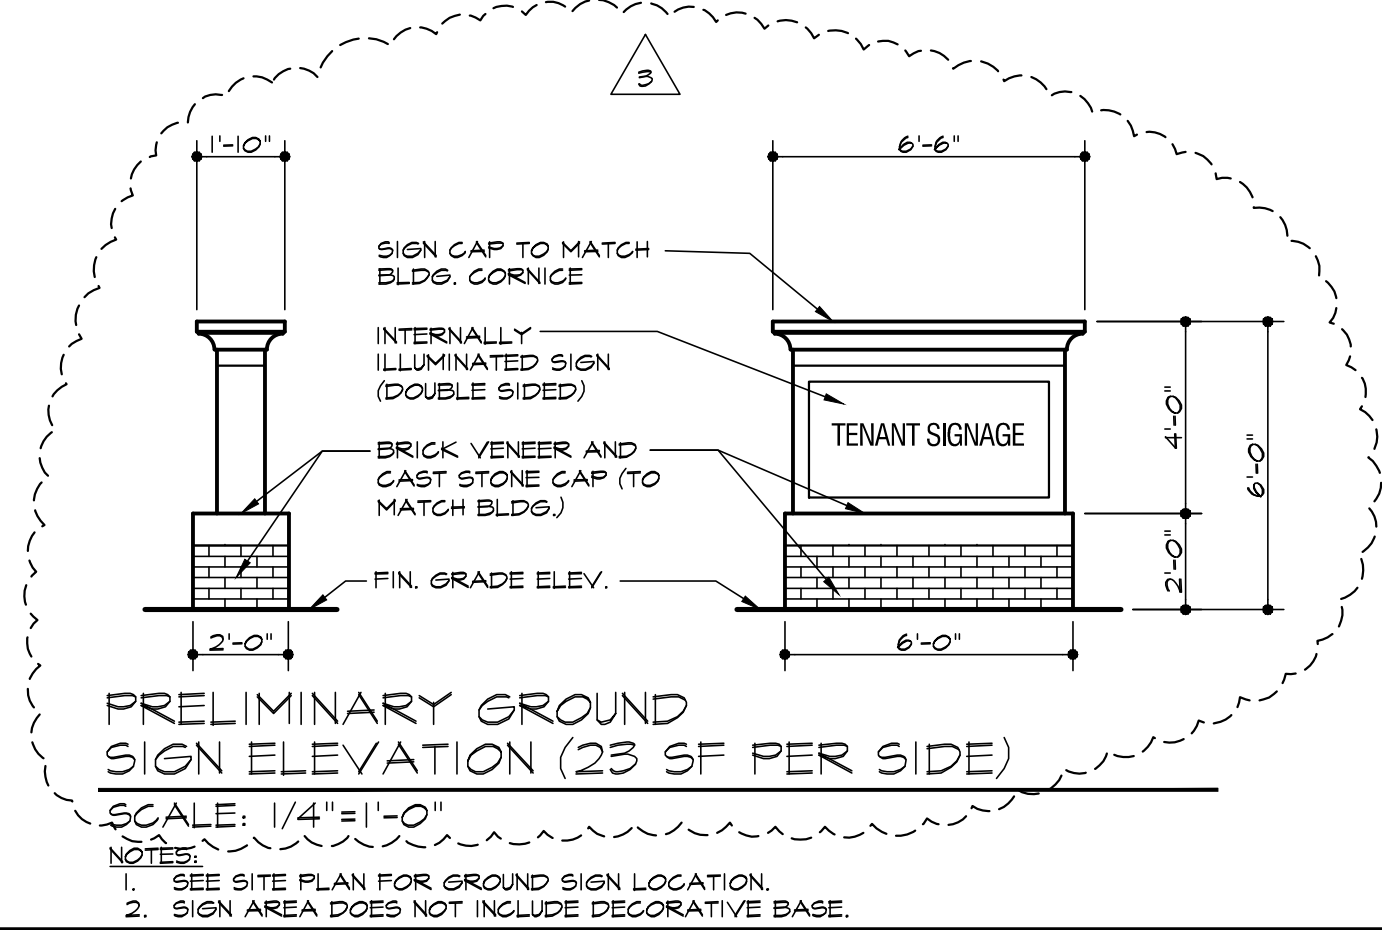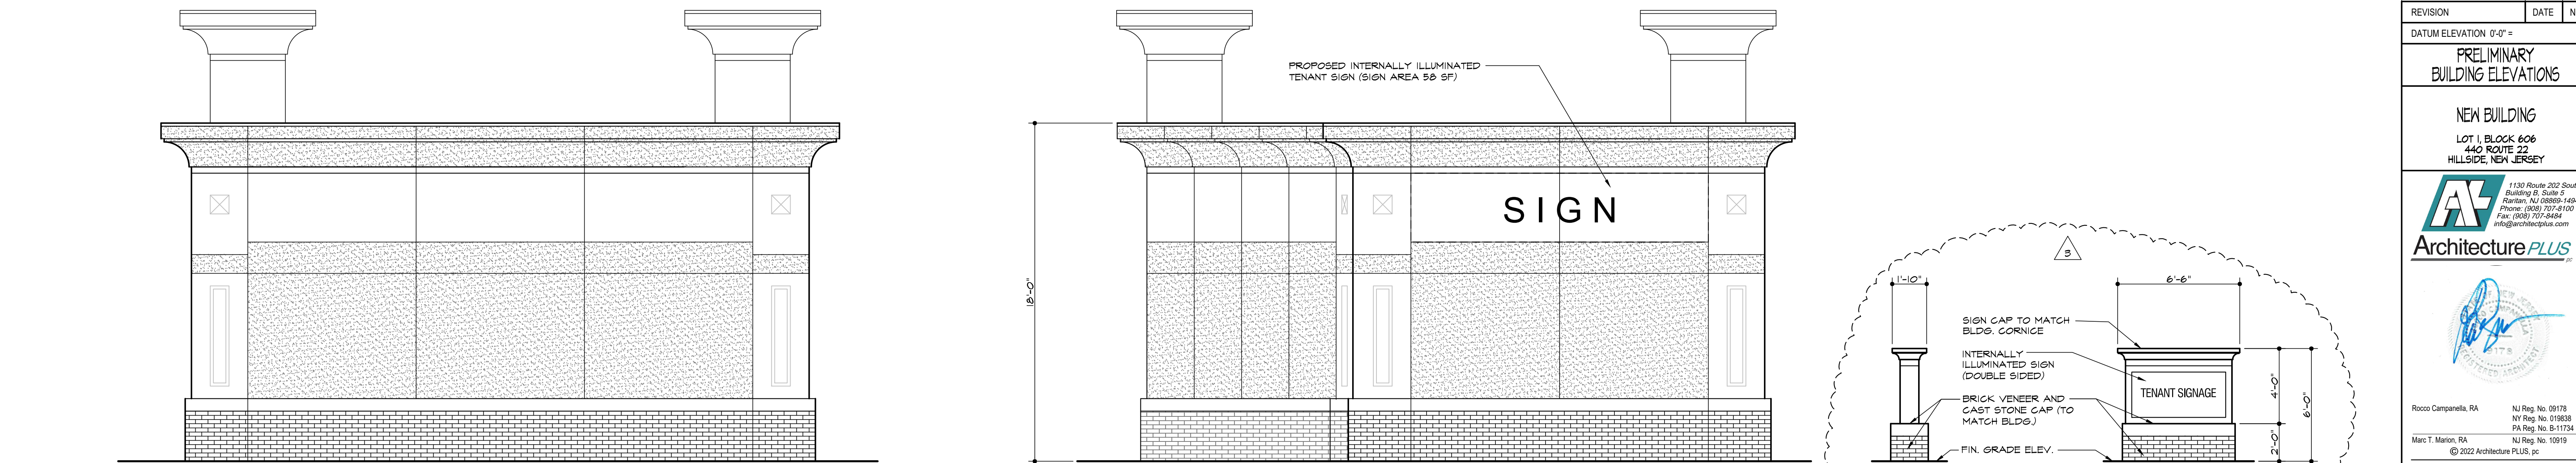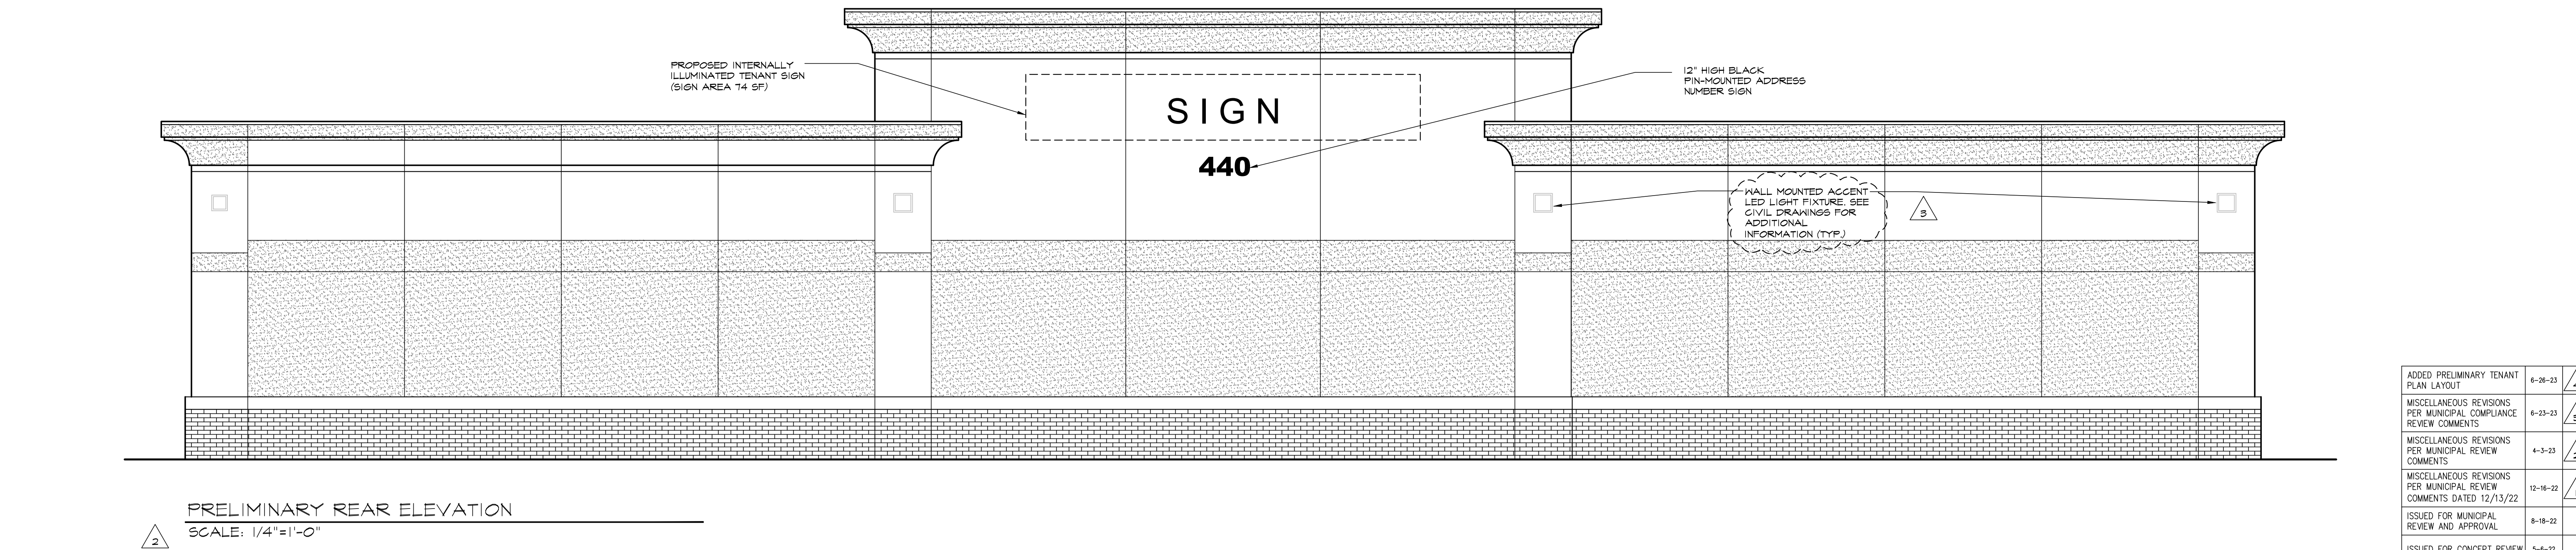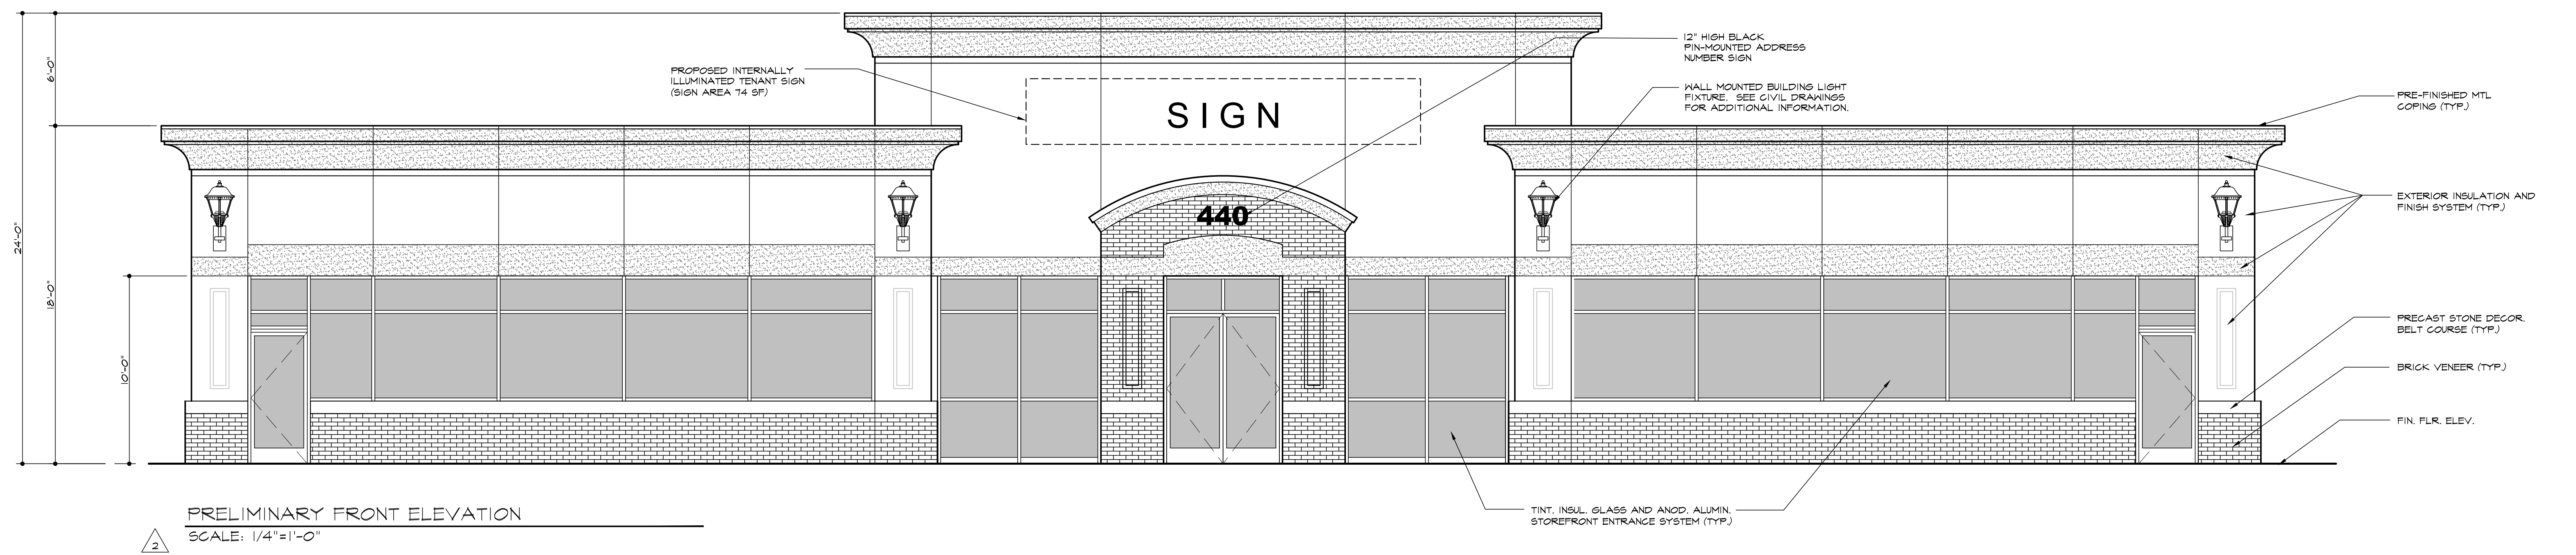

ADDED PRELIMINARY TENANT PLAN LAYOUT	6-26-23	4
MISCELLANEOUS REVISIONS PER MUNICIPAL COMPLIANCE REVIEW COMMENTS	6-23-23	3
MISCELLANEOUS REVISIONS PER MUNICIPAL REVIEW COMMENTS	4-3-23	2
MISCELLANEOUS REVISIONS PER MUNICIPAL REVIEW COMMENTS DATED 12/13/22	12-16-22	1
ISSUED FOR MUNICIPAL REVIEW AND APPROVAL	8-18-22	
ISSUED FOR CONCEPT REVIEW	5-6-22	
REVISION	DATE	NO.
DATUM ELEVATION 0'-0" =		
PRELIMINARY BUILDING ELEVATIONS		
NEW BUILDING		
LOT 1, BLOCK 606		
440 ROUTE 22		
HILLSIDE, NEW JERSEY		
 1130 Route 202 South Building B, Suite 5 Raritan, NJ 08869-1494 Phone: (609) 707-8100 Fax: (609) 707-8484 info@architectplus.com		
 Rocco Campanella, RA NJ Reg. No. 09178 NY Reg. No. 019838 PA Reg. No. B-11734 Marc T. Marion, RA NJ Reg. No. 10919 © 2022 Architecture PLUS, pc		
SCALE	AS NOTED	
DRWN BY	PL	CHKD BY : RC
DATE	5-6-22	
PROJ. NO.	21-152	
DWG. NO.	A2P of 2	