


Office Lofts @1028 Virginia Ave



CURRAN
ARCHITECTURE

5719 LAWTON LOOP E. DR., SUITE 212
INDIANAPOLIS, IN 46212
O :: 317.288.0681
F :: 317.288.0753

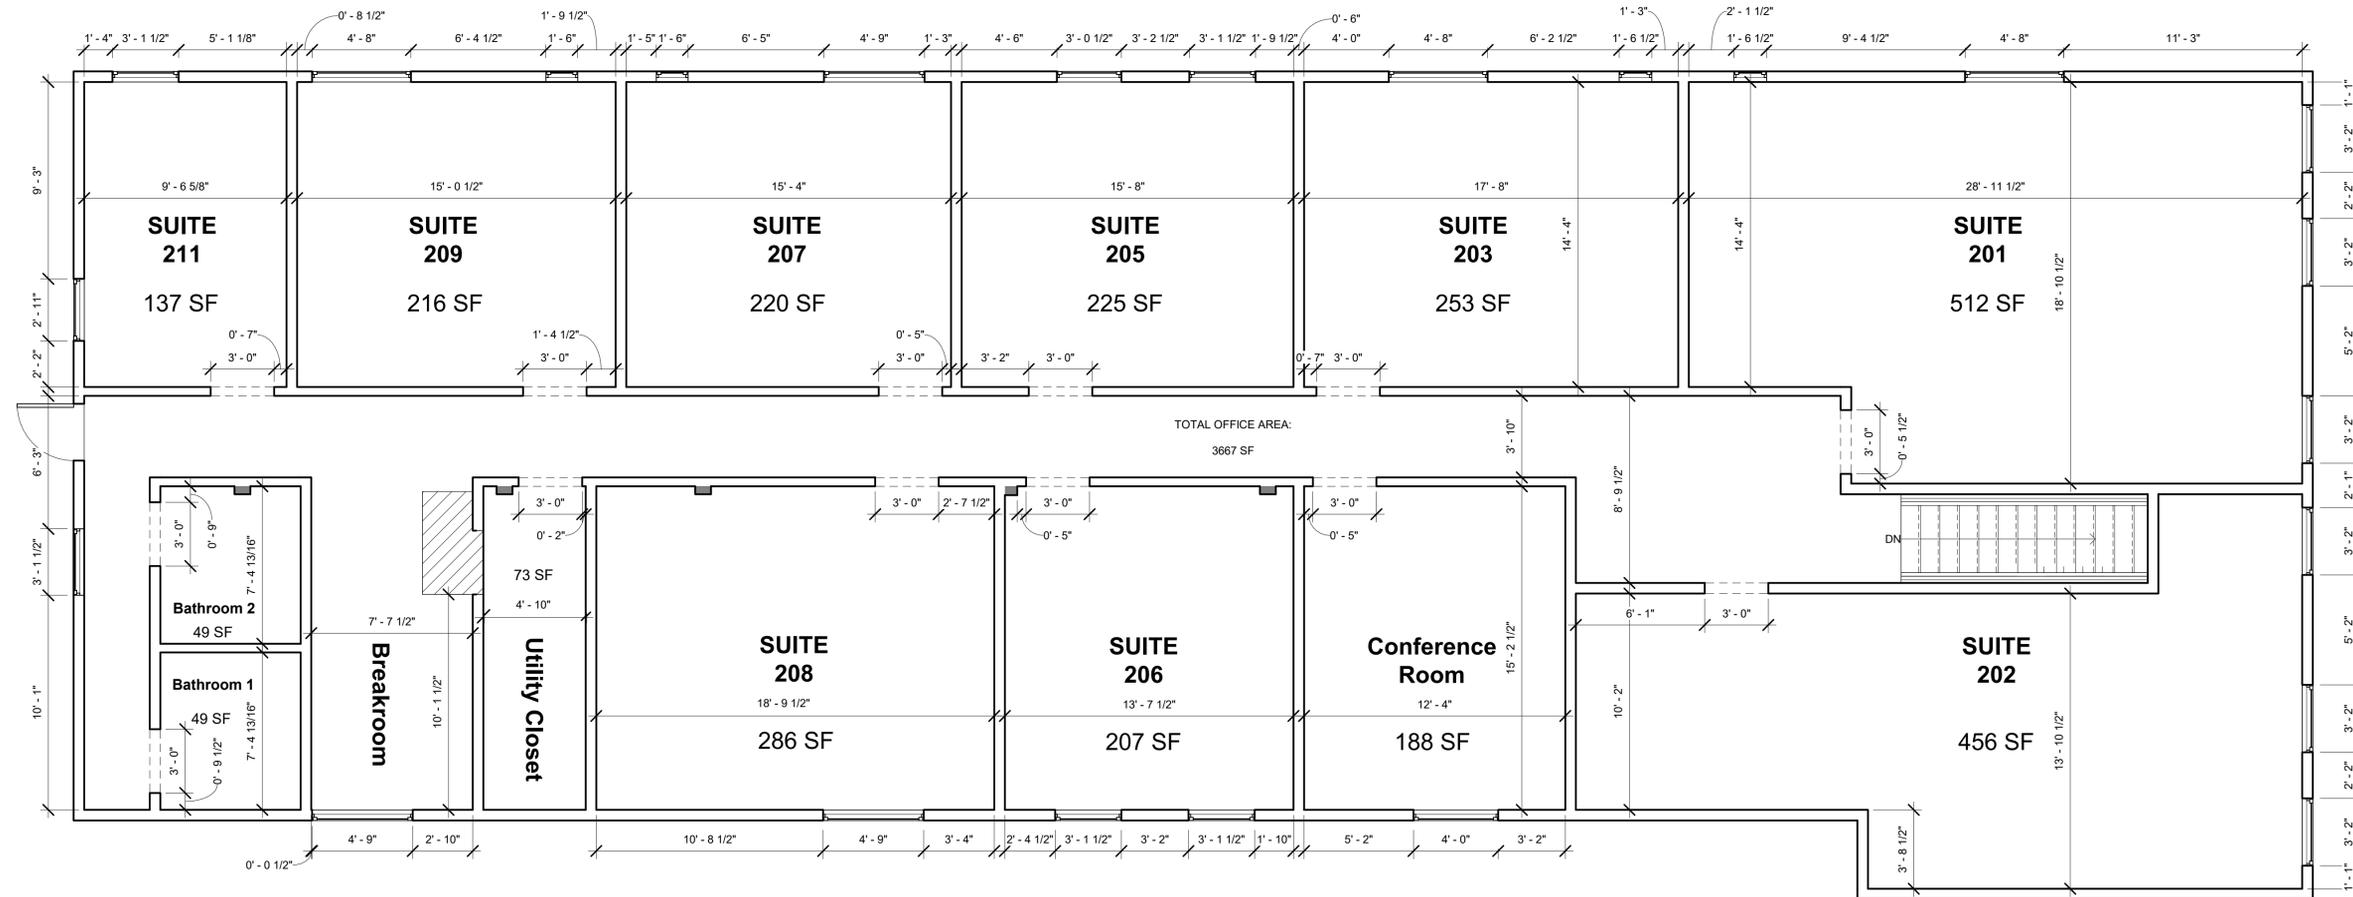

① Level 1
1/4" = 1'-0"

NOTE: ALL DIMENSIONS SHOWN ARE APPROXIMATE AND SHOULD BE CONSIDERED +/-

CERTIFICATION



THIS DRAWING AND THE IDEAS, DESIGNS AND CONCEPTS CONTAINED HEREIN ARE THE EXCLUSIVE INTELLECTUAL PROPERTY OF CURRAN ARCHITECTURE AND ARE NOT TO BE USED OR REPRODUCED, WHOLE OR IN PART, WITHOUT THE WRITTEN CONSENT OF CURRAN ARCHITECTURE.
© COPYRIGHT 2015, CURRAN ARCHITECTURE

PROJECT INFORMATION

VIRGINIA AVE AS-BUILT
1028 VIRGINIA, AVE. 46203

Issue Date
Project Status

ISSUE DATES

NO.	DESCRIPTION	DATE

PROJECT NUMBER: 200168

FLOOR PLAN

A101