



NE 85th Street

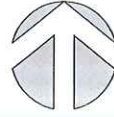

Parking

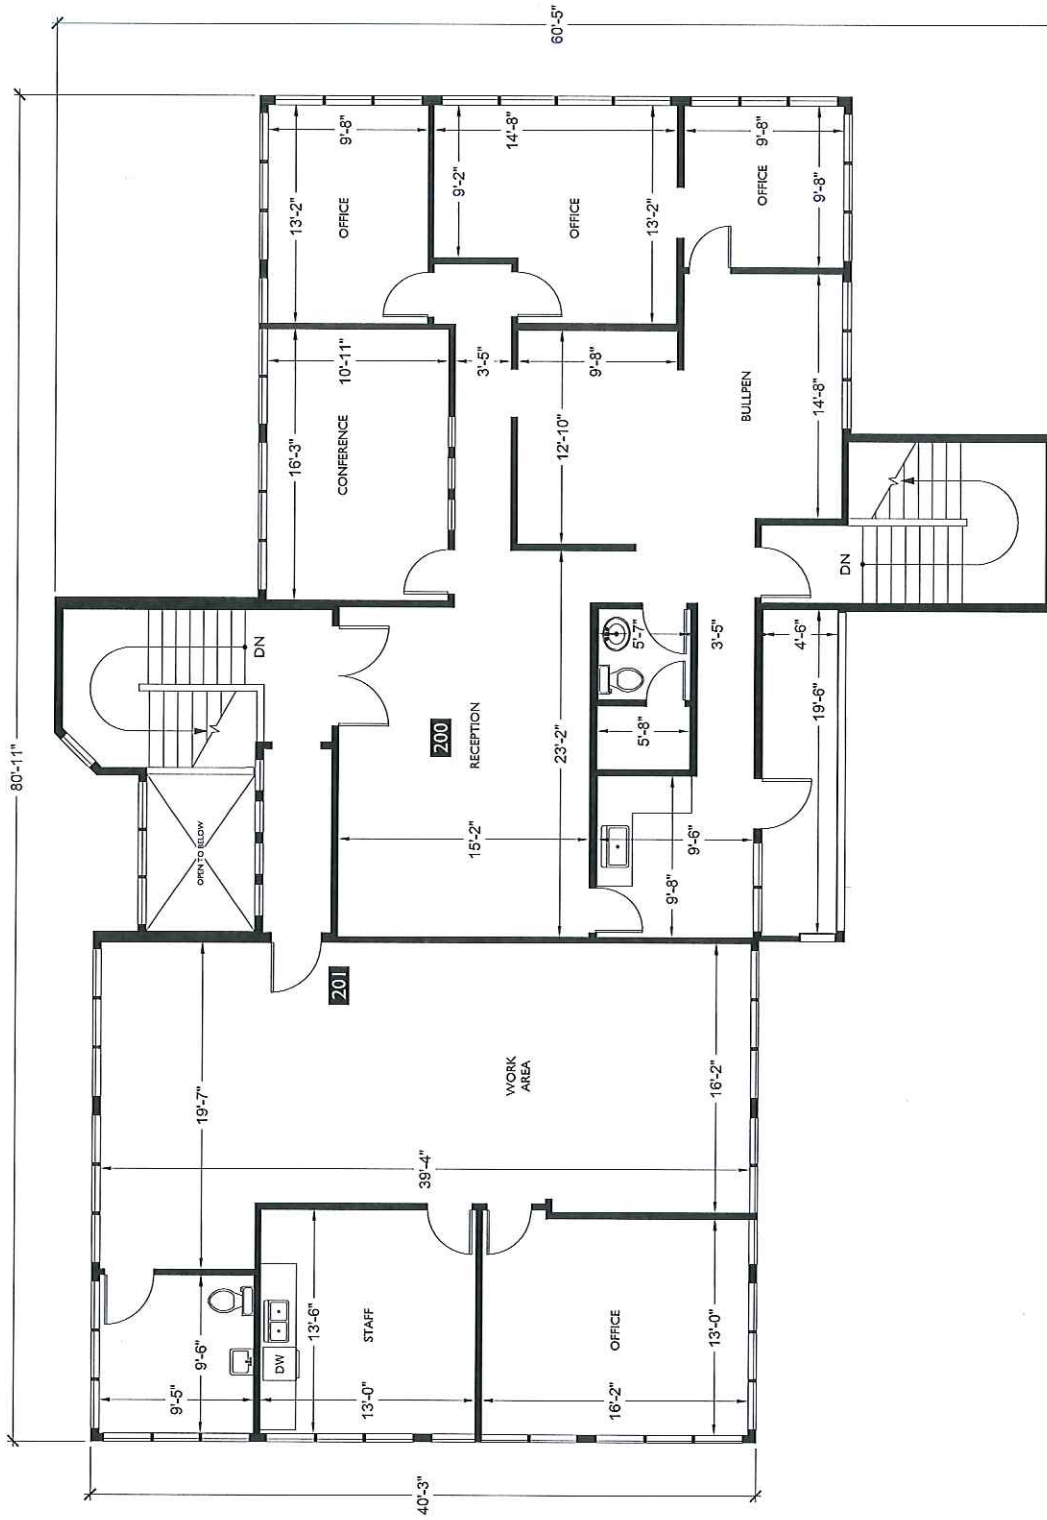

Parking

165th Avenue NE

Floor Plan

2

Floor

Office Building
16455 NE 85th Street
Redmond, WA 98052

Subject

Real Property Associates
8001 14th Avenue NE
Seattle, WA 98115

Client

2DFLOORPLANS.COM
206-328-7410 fax 206-328-4764
1700 21st Avenue South Suite 100
Seattle, WA 98144


2-D
AS-BUILT
FLOOR PLANS




Scale

Updated: July 2013 Project: C13-408

NE 85th Street

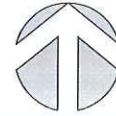

Parking

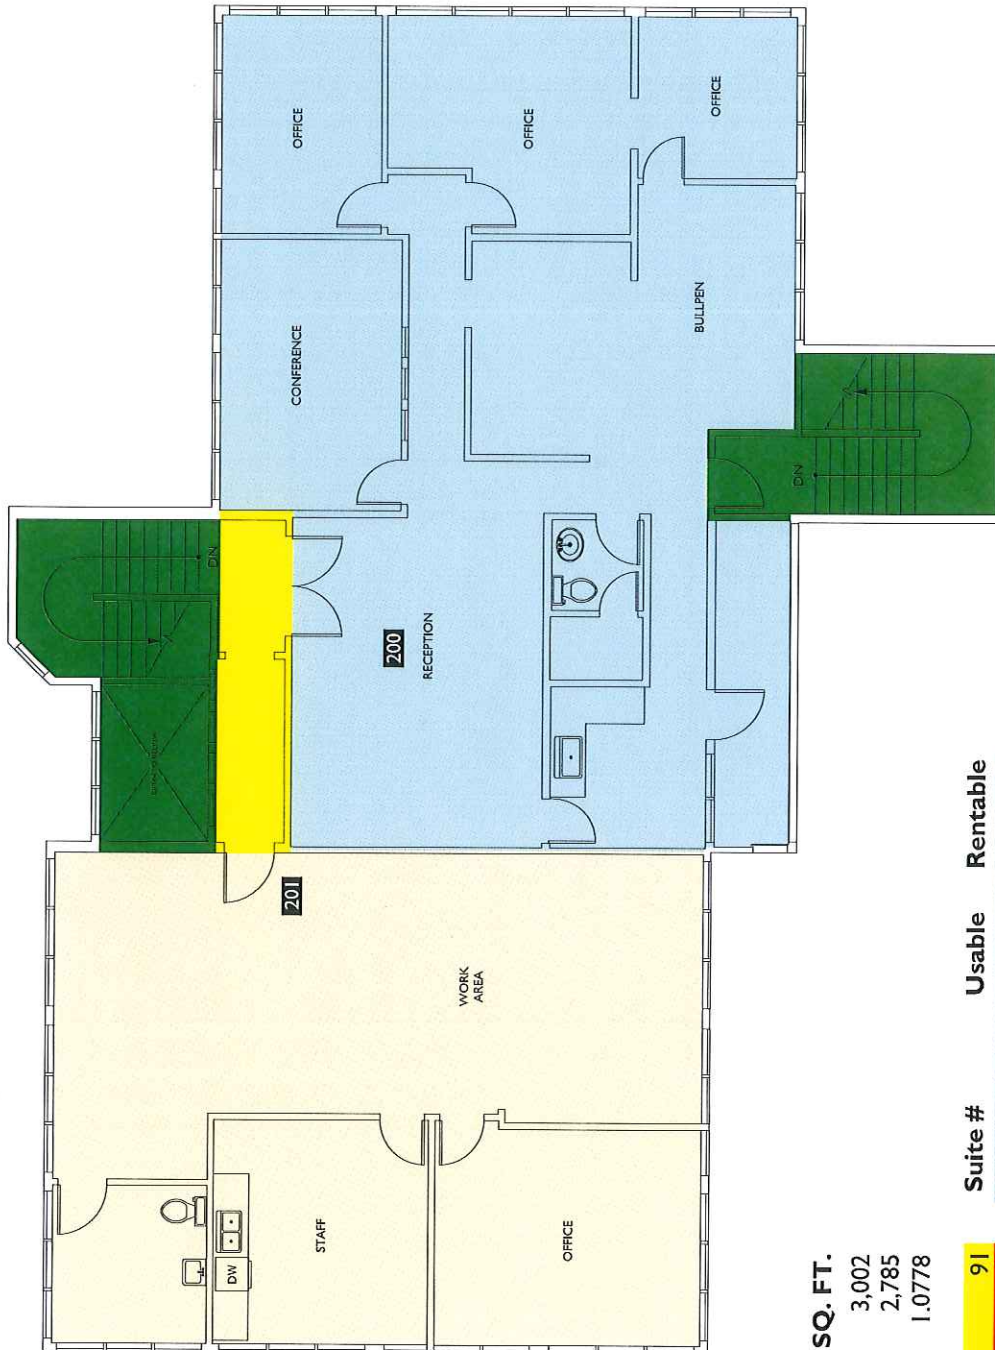

Floor Summary

Total Rentable Area	3,002
Total Usable Area	2,785
Combined R/U	1.0778

Floor Common	Suite #	Usable	Rentable
Building Common	Suite 200	1,621	1,747
Total Vertical	Suite 201	1,164	1,255

165th Avenue NE

Real Property Associates 8001 14th Avenue NE Seattle, WA 98115	Office Building 16455 NE 85th Street Redmond, WA 98052	Lease Plan	
		2	
Client	Subject	Floor	
		Scale	
		0 5 10 15	
		2D 206-328-7410 fax 206-328-4764 2D FLOOR PLANS.COM AS-BUILT FLOOR PLANS 1700 21st Avenue South Suite 100 Seattle, WA 98144	
		Measured: April 2008	Project: C8-165

2-D
FLOOR PLANS
AS-BUILT

2DFLOORPLANS.COM
206-328-7410 fax 206-328-4764
1700 21st Avenue South Suite 100
Seattle, WA 98144

