


712 FIFTH *avenue*

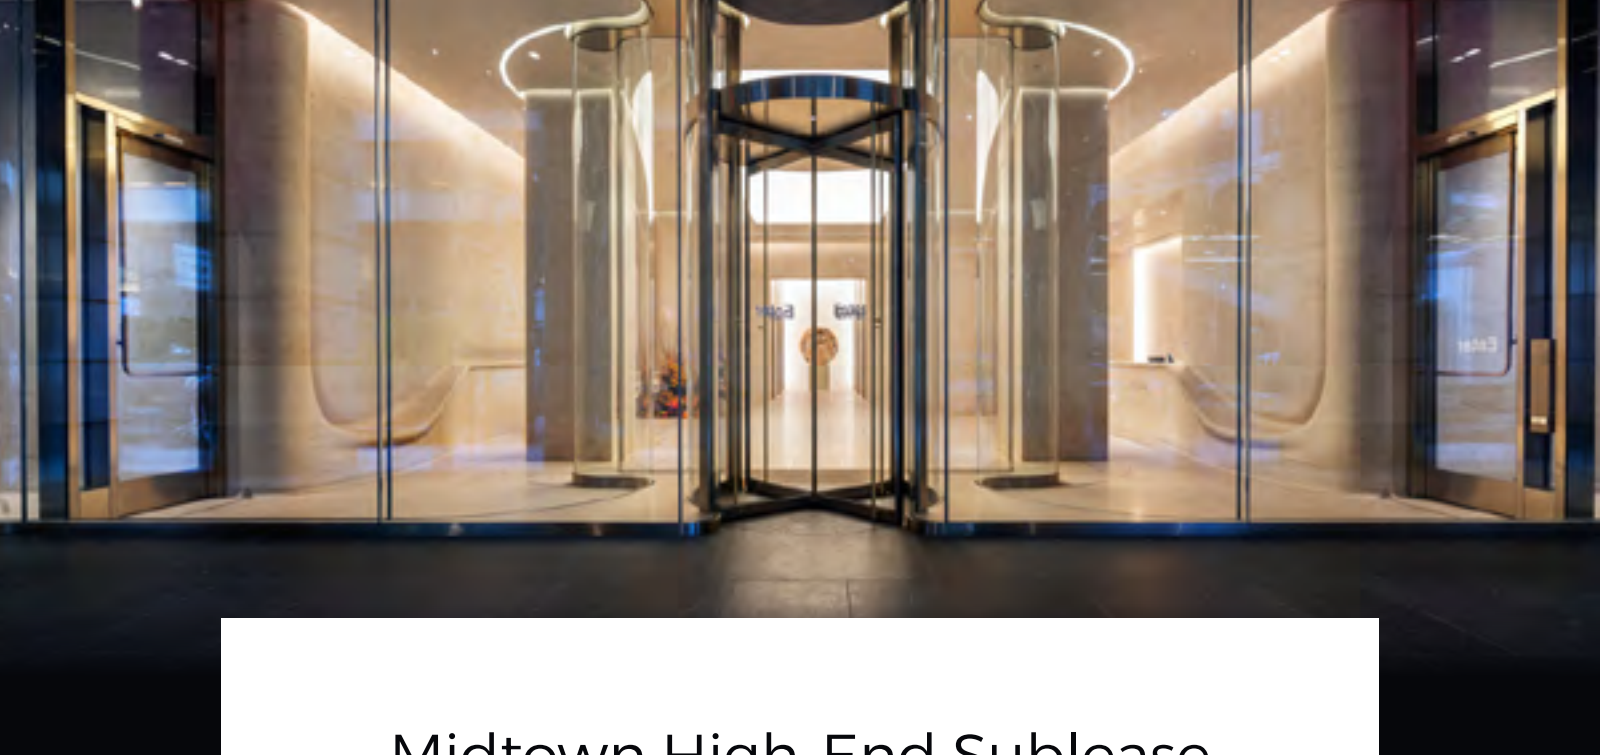


Midtown High-End Sublease

Available Immediately

12,930 RSF



- Term through May, 2025
- High-end, recently constructed full floor
- White glove service, luxury experience
- **Rent available upon request**

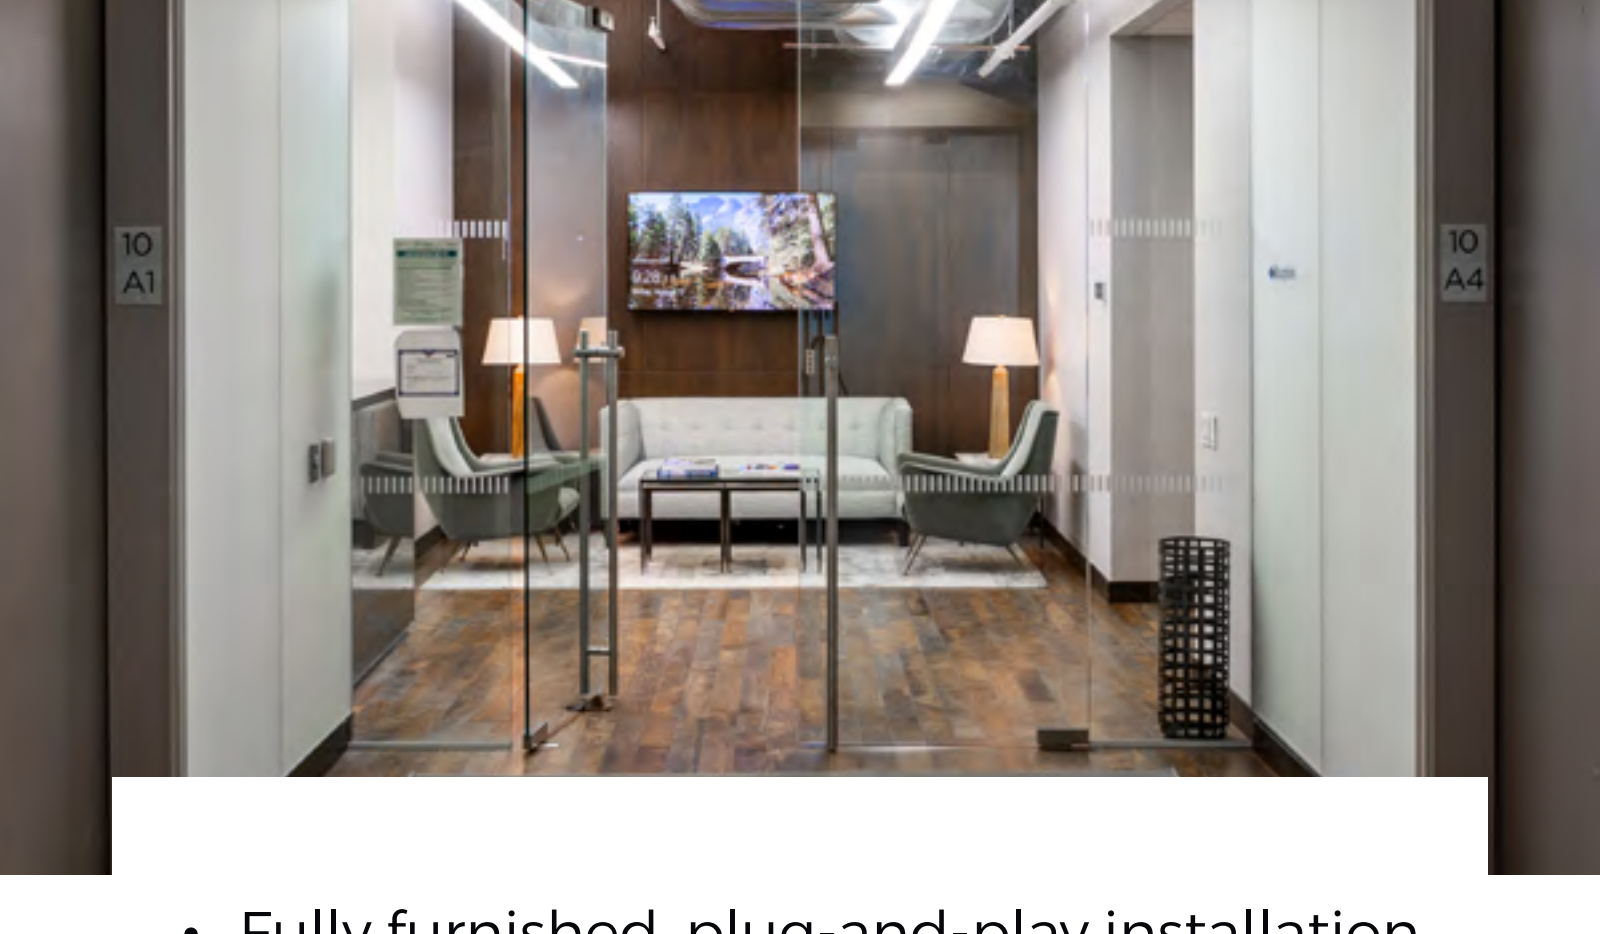


- Fully furnished, plug-and-play installation
 - Renovated lobby
 - Destination dispatch elevators



As-built Plan

12,930 RSF

56TH STREET

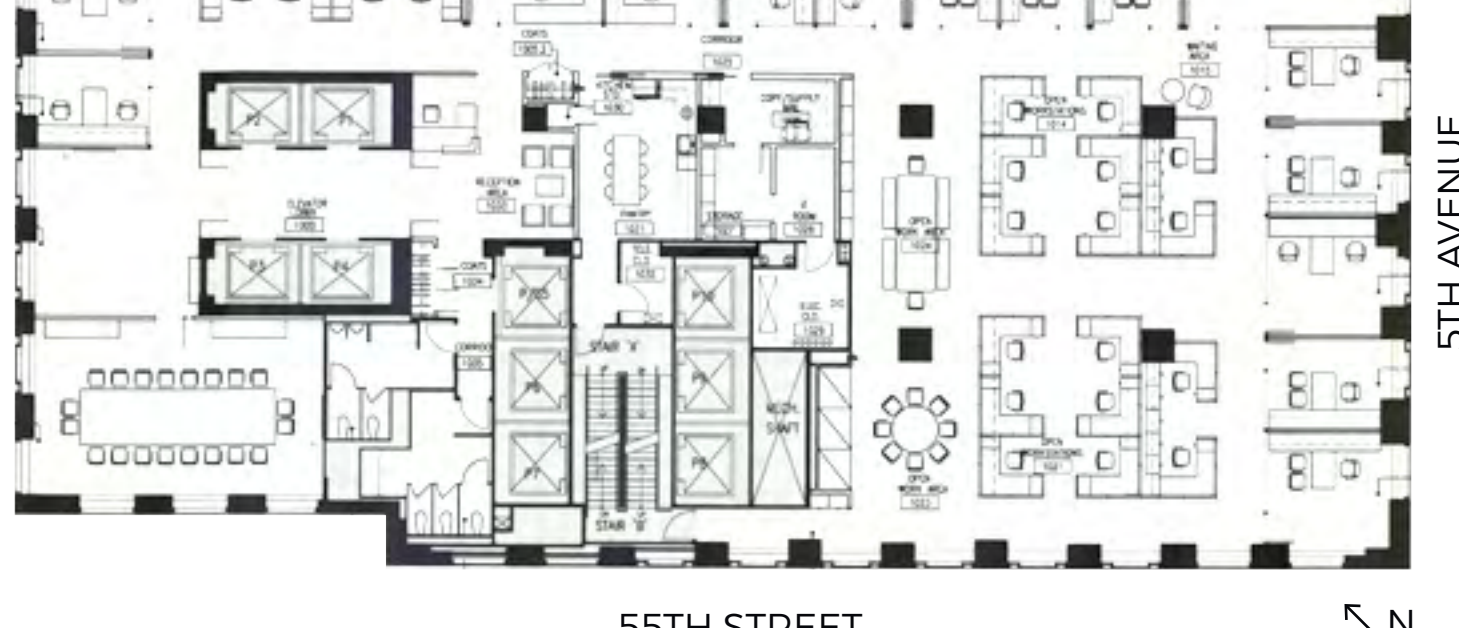


55TH STREET


5TH AVENUE



[DOWNLOAD FLOORPLAN](#)

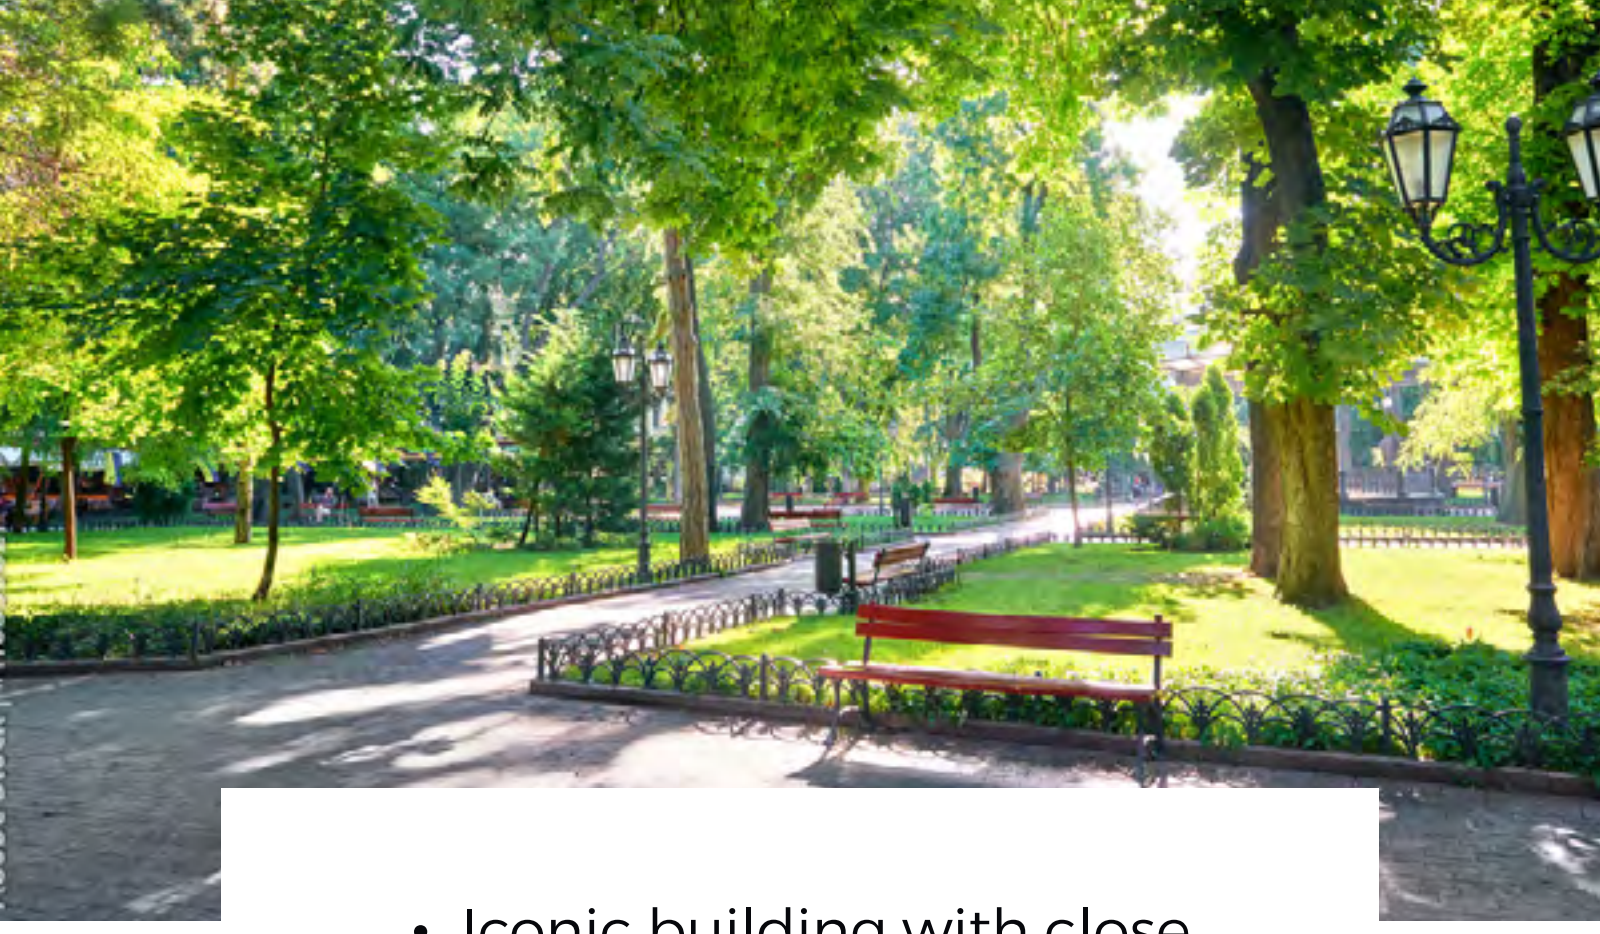

- Iconic building with close proximity to Central Park
- Abundance of dining, drinks & culture
- Access to all transit

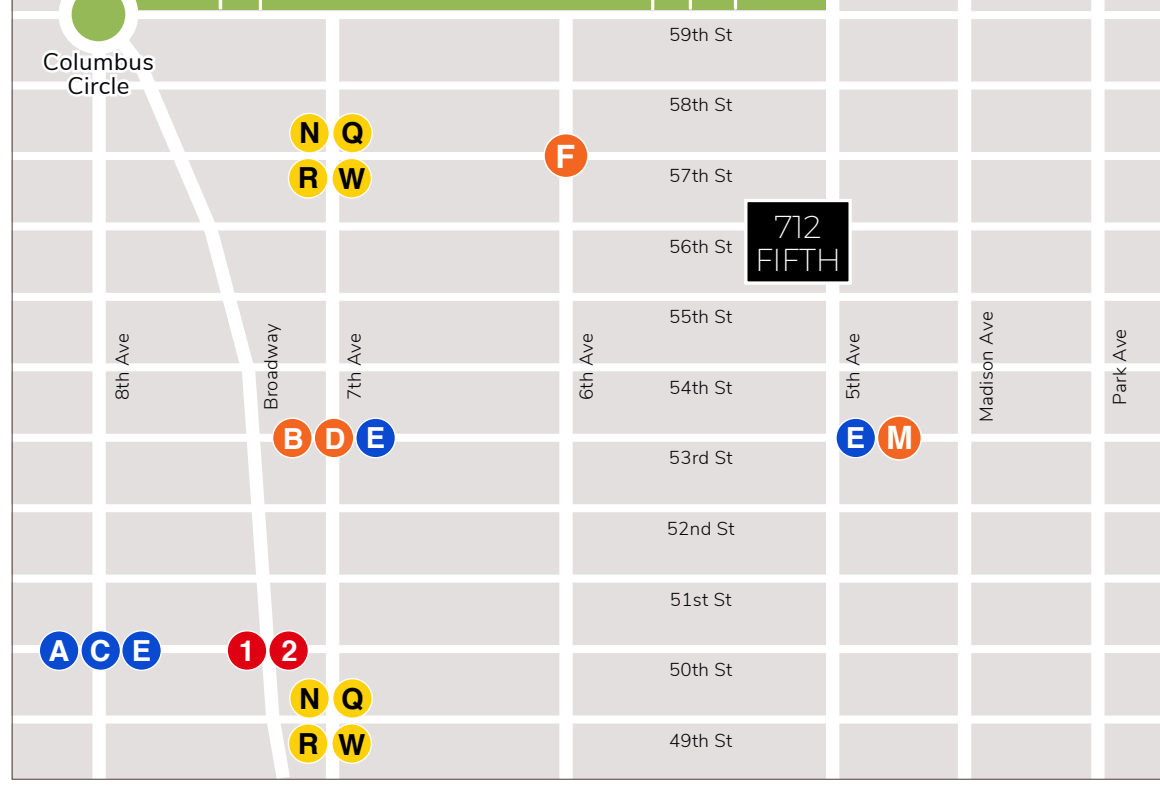

Darell Handler, COO

646.597.6171 | dhandler@handler-re.com

Kyle Galin, Vice President

646.998.6012 | kgalin@handler-re.com

Isaac Leader, Associate

646.747.4686 | ileader@handler-re.com

HANDLER
REAL ESTATE
ORGANIZATION

212.398.1888 | Handler-re.com

The information contained herein has been obtained from sources believed reliable. While we do not doubt its accuracy, we make no guarantee, warranty or representation about it. The prospective tenant should carefully verify each item, and all other information herein.