


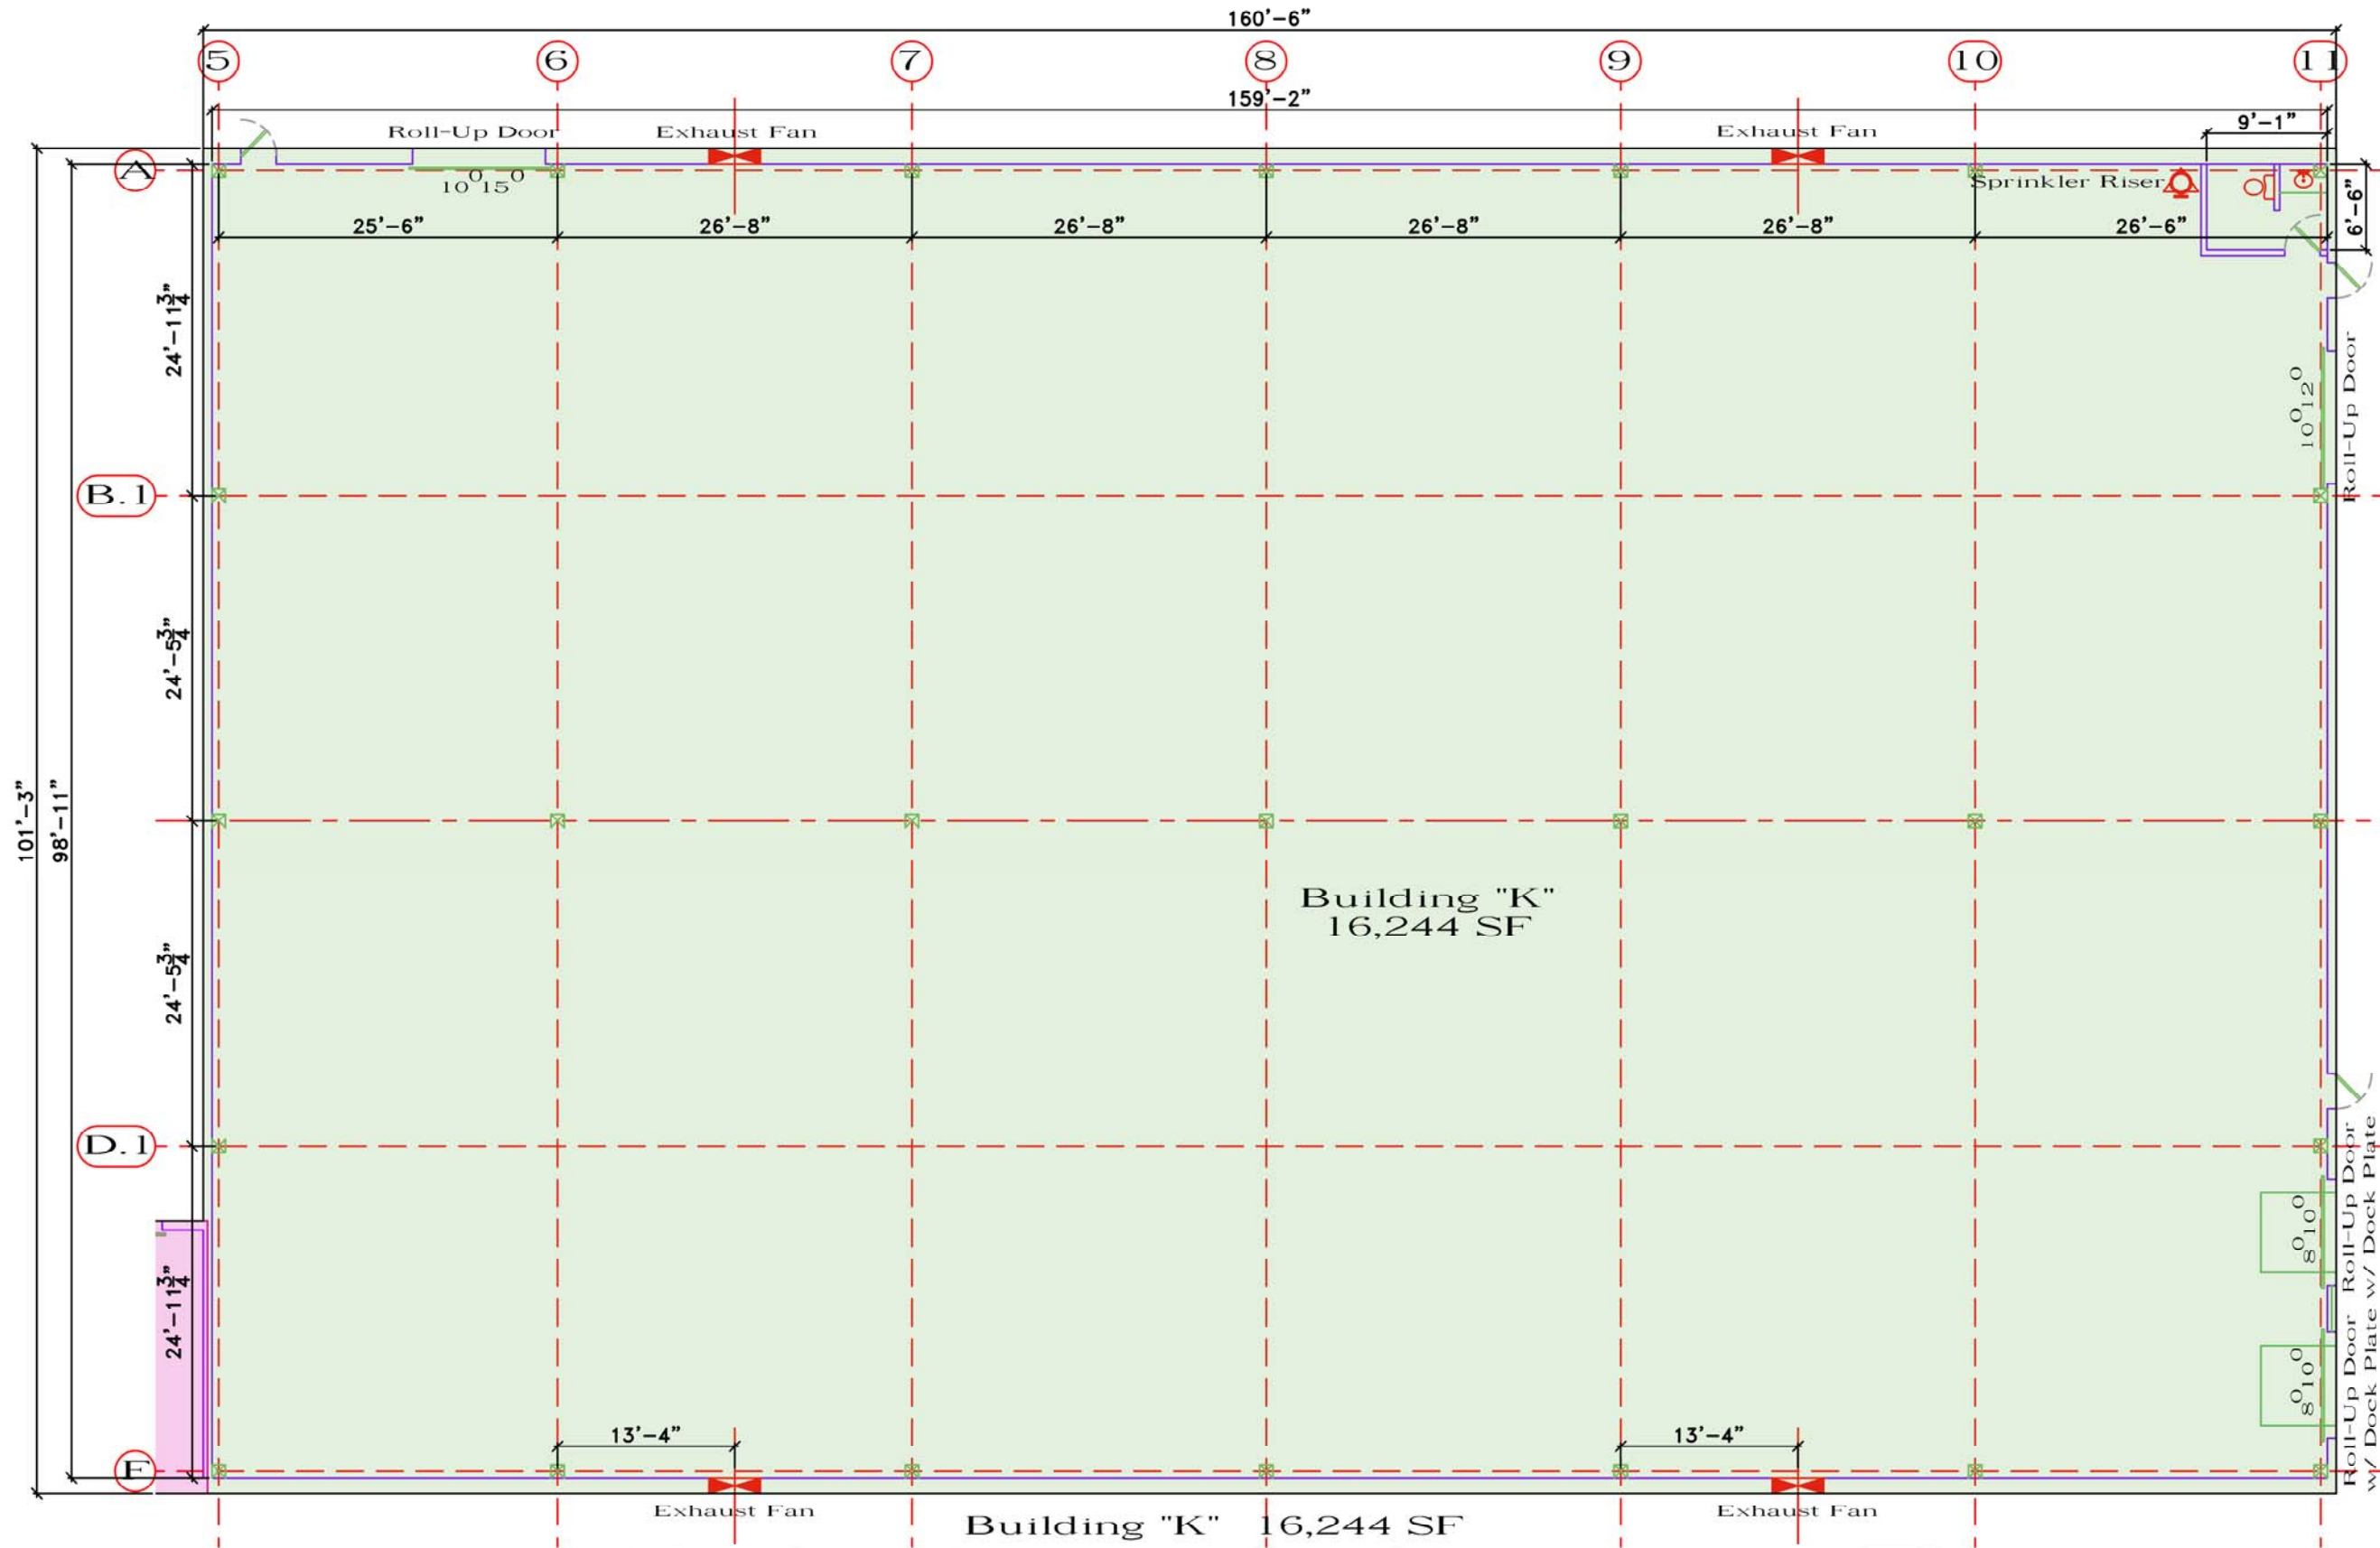

Building "K" 16,244 SF
601 Cumberland St.; Chattanooga, TN
Building "K" As-Built Floor Plan

Scale: 1/16" = 1'-0" on 11" x 17" Sheet

Information Deemed Reliable but not Guaranteed

Building "K" As-Built Floor Plan
Current Tenant: Sphere One
601 Cumberland St.
Chattanooga, TN 37404
Date: 09/09/2024 Scale: 1/16" = 1'-0" UNO

Hight Knox Properties, LLC
1776 Peachtree St. NW; Ste. 610S
Atlanta, GA 30309
CONTACT: Josh Siegel
M: +1 (478) 737-5403 www.hightknox.com

The CADfather; <http://cadfather.net>
Joseph Wilson (706) 618-7053

186 Akins Rd. Chickamauga, GA 30707
email: cadfather@att.net