
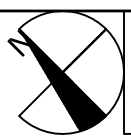


3921 East Baseline Road

Gilbert . Arizona

Suite B001 - 2,385 RSF

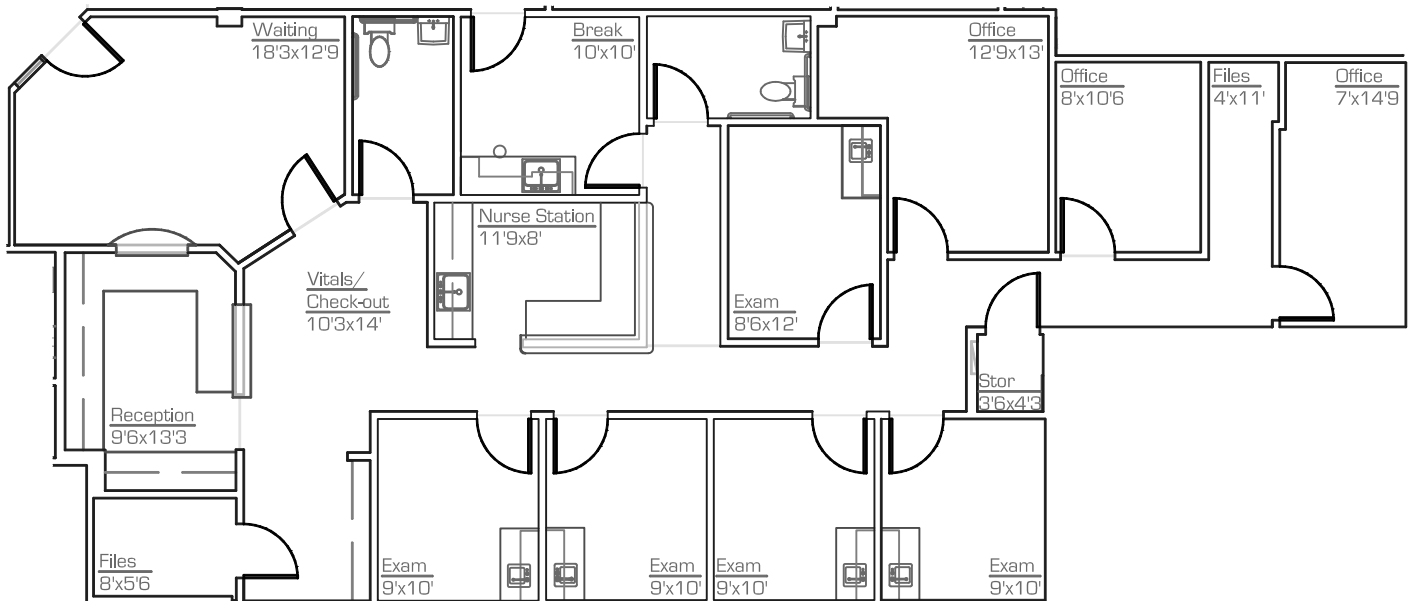

As-Built

scale: nts

February.2020

*All dimensions are approximate at $\pm 3"$

*All information is of general nature

precision**DIMENSIONS**

as-built & design
602. 790. 6412

