


Dr. Maloney & Dr. Pham
3450 Old Washington Rd
Suite 204
Waldorf, MD 20602

Waldorf Dental
Group

SHEFFIELD
CONSTRUCTION CO. INC.
678 Ritchie Hwy
Severna Park, Md. 21146
(410) 647-1185

2/15/18
2011

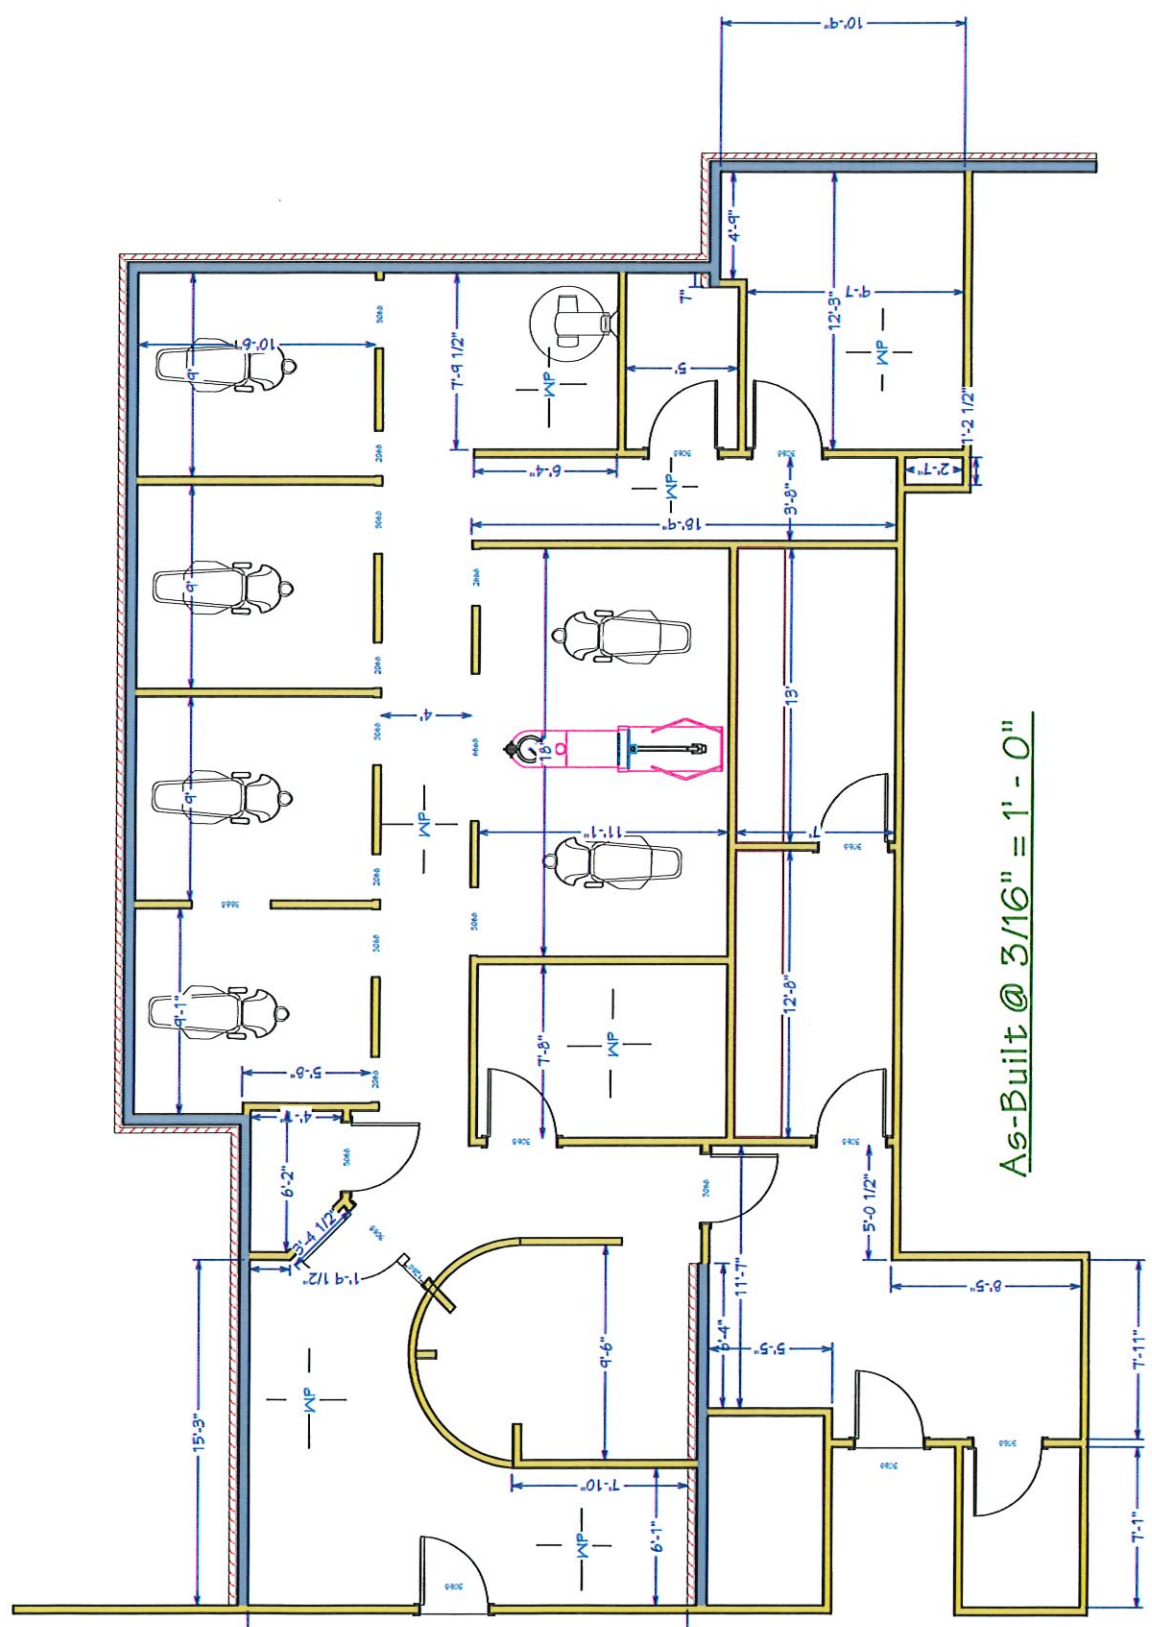

As-Built @ 3/16" = 1' - 0"