




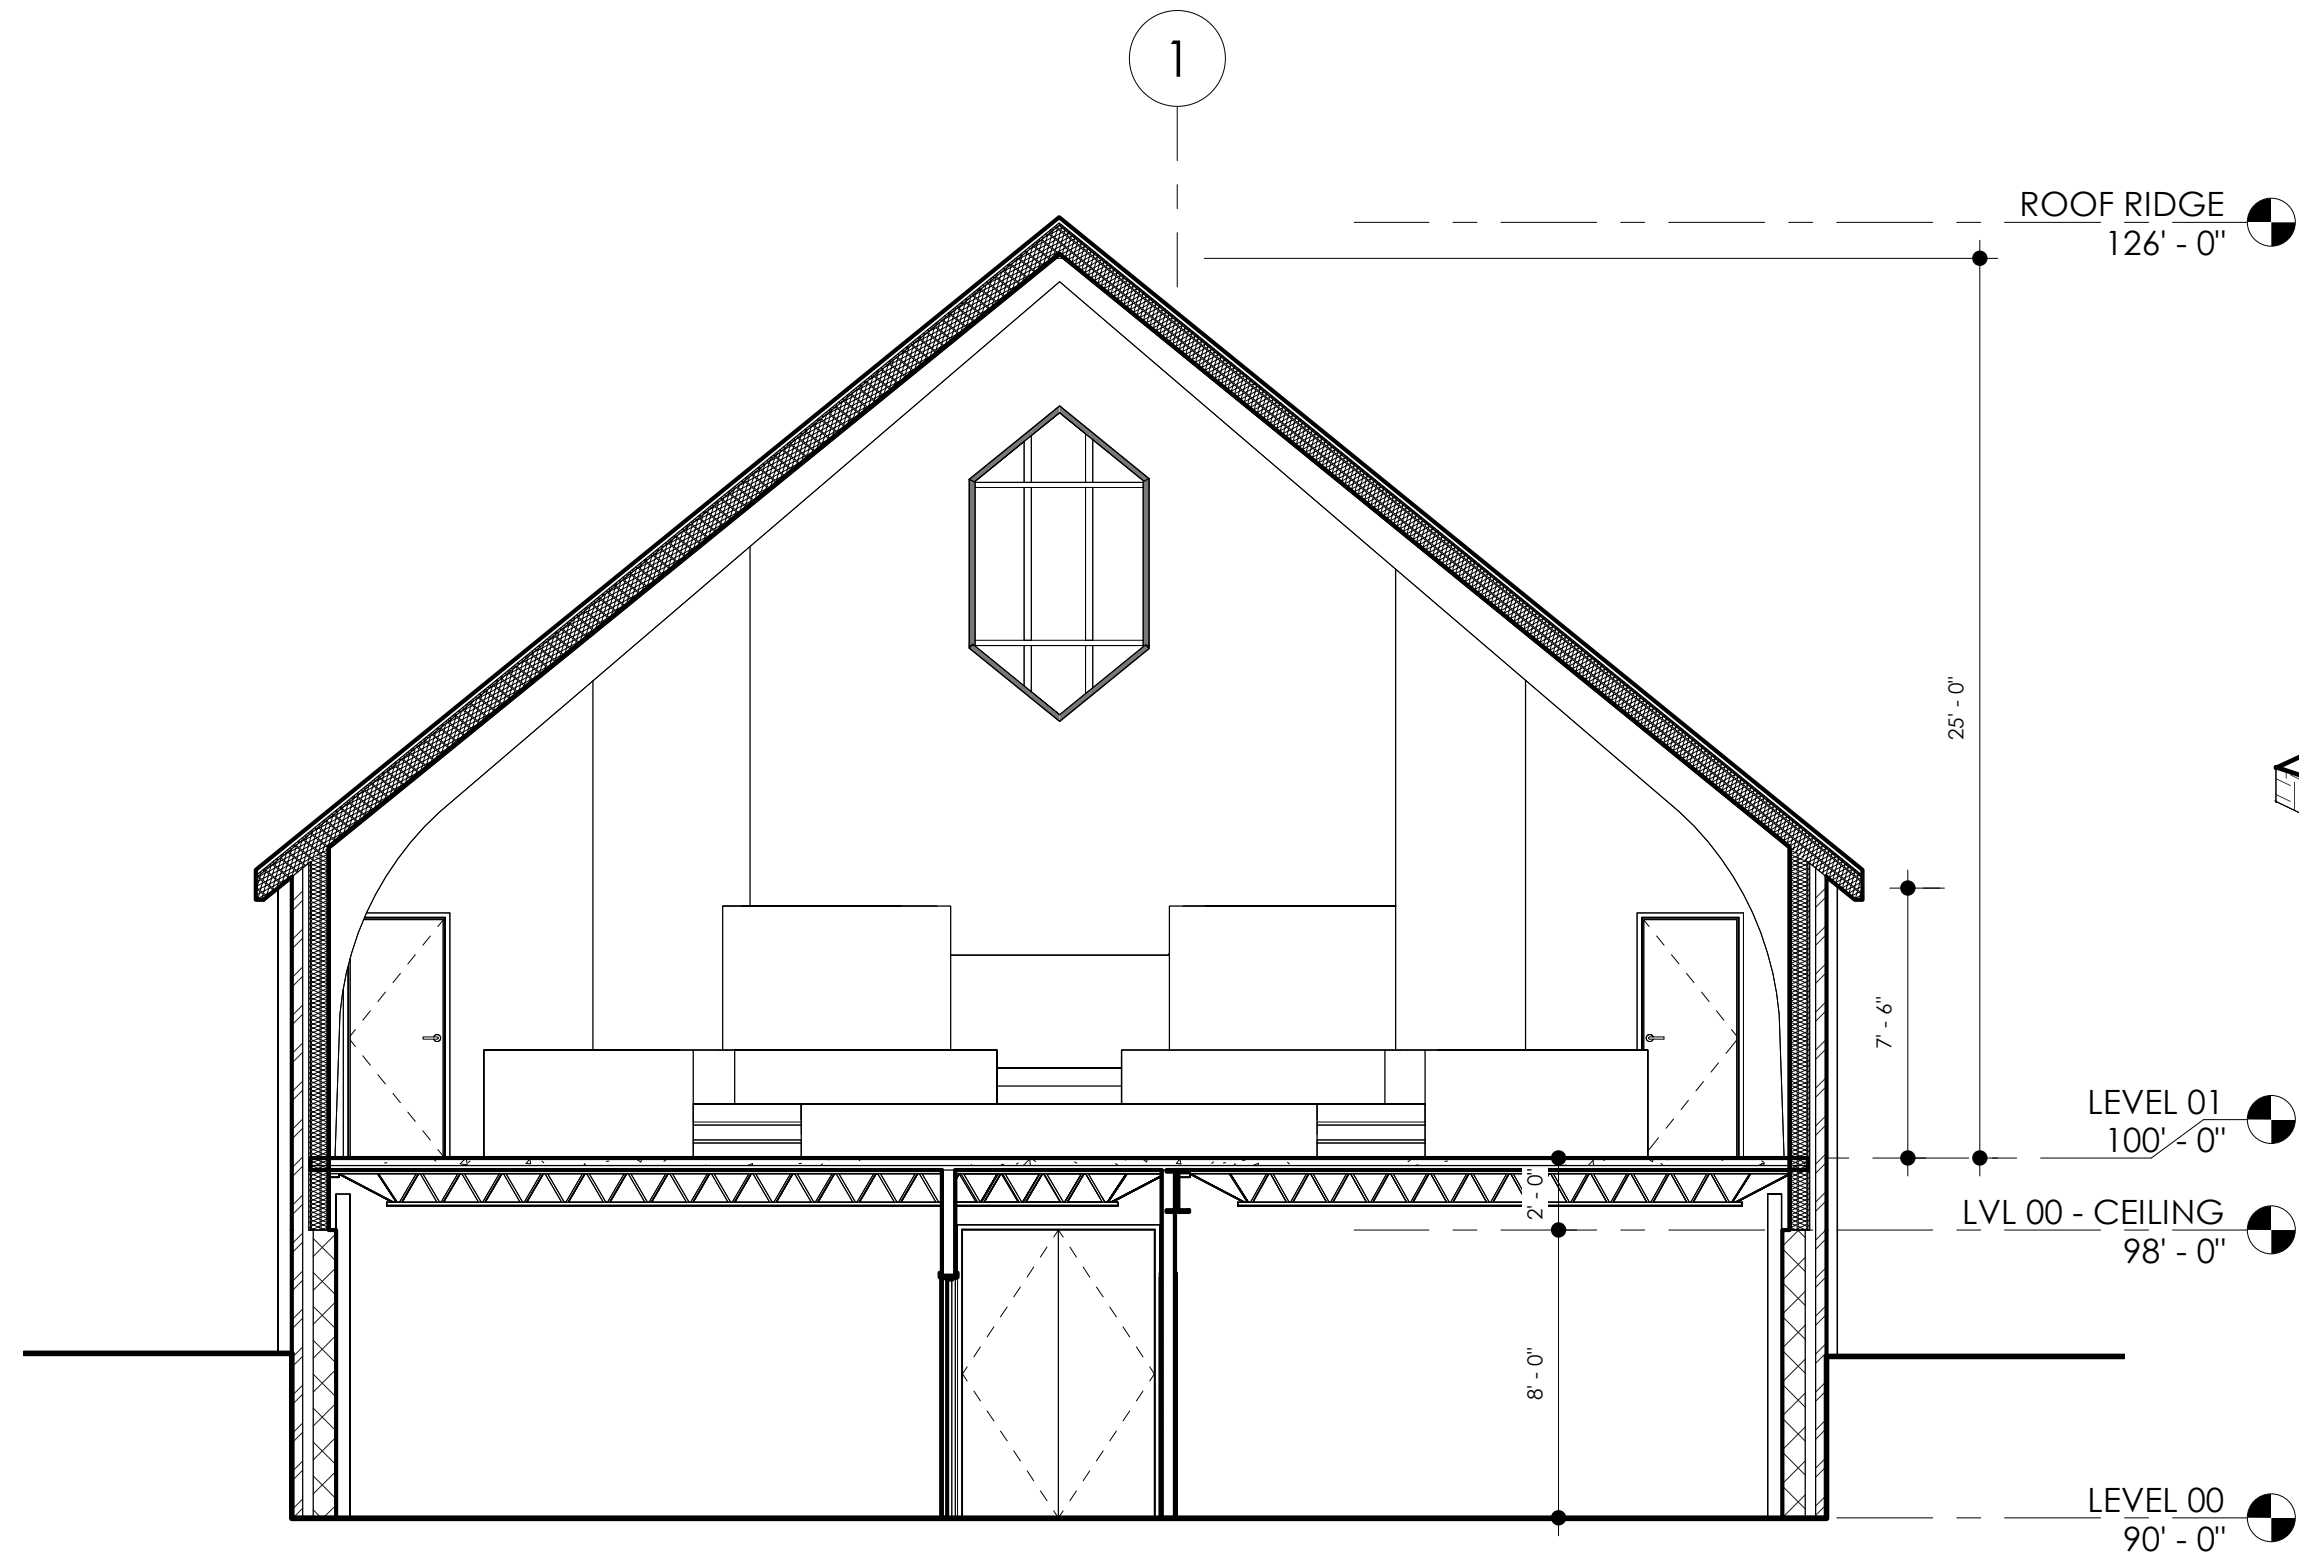

02 | AS-BUILT SECTION
[A1.09] 3/16" = 1'-0"

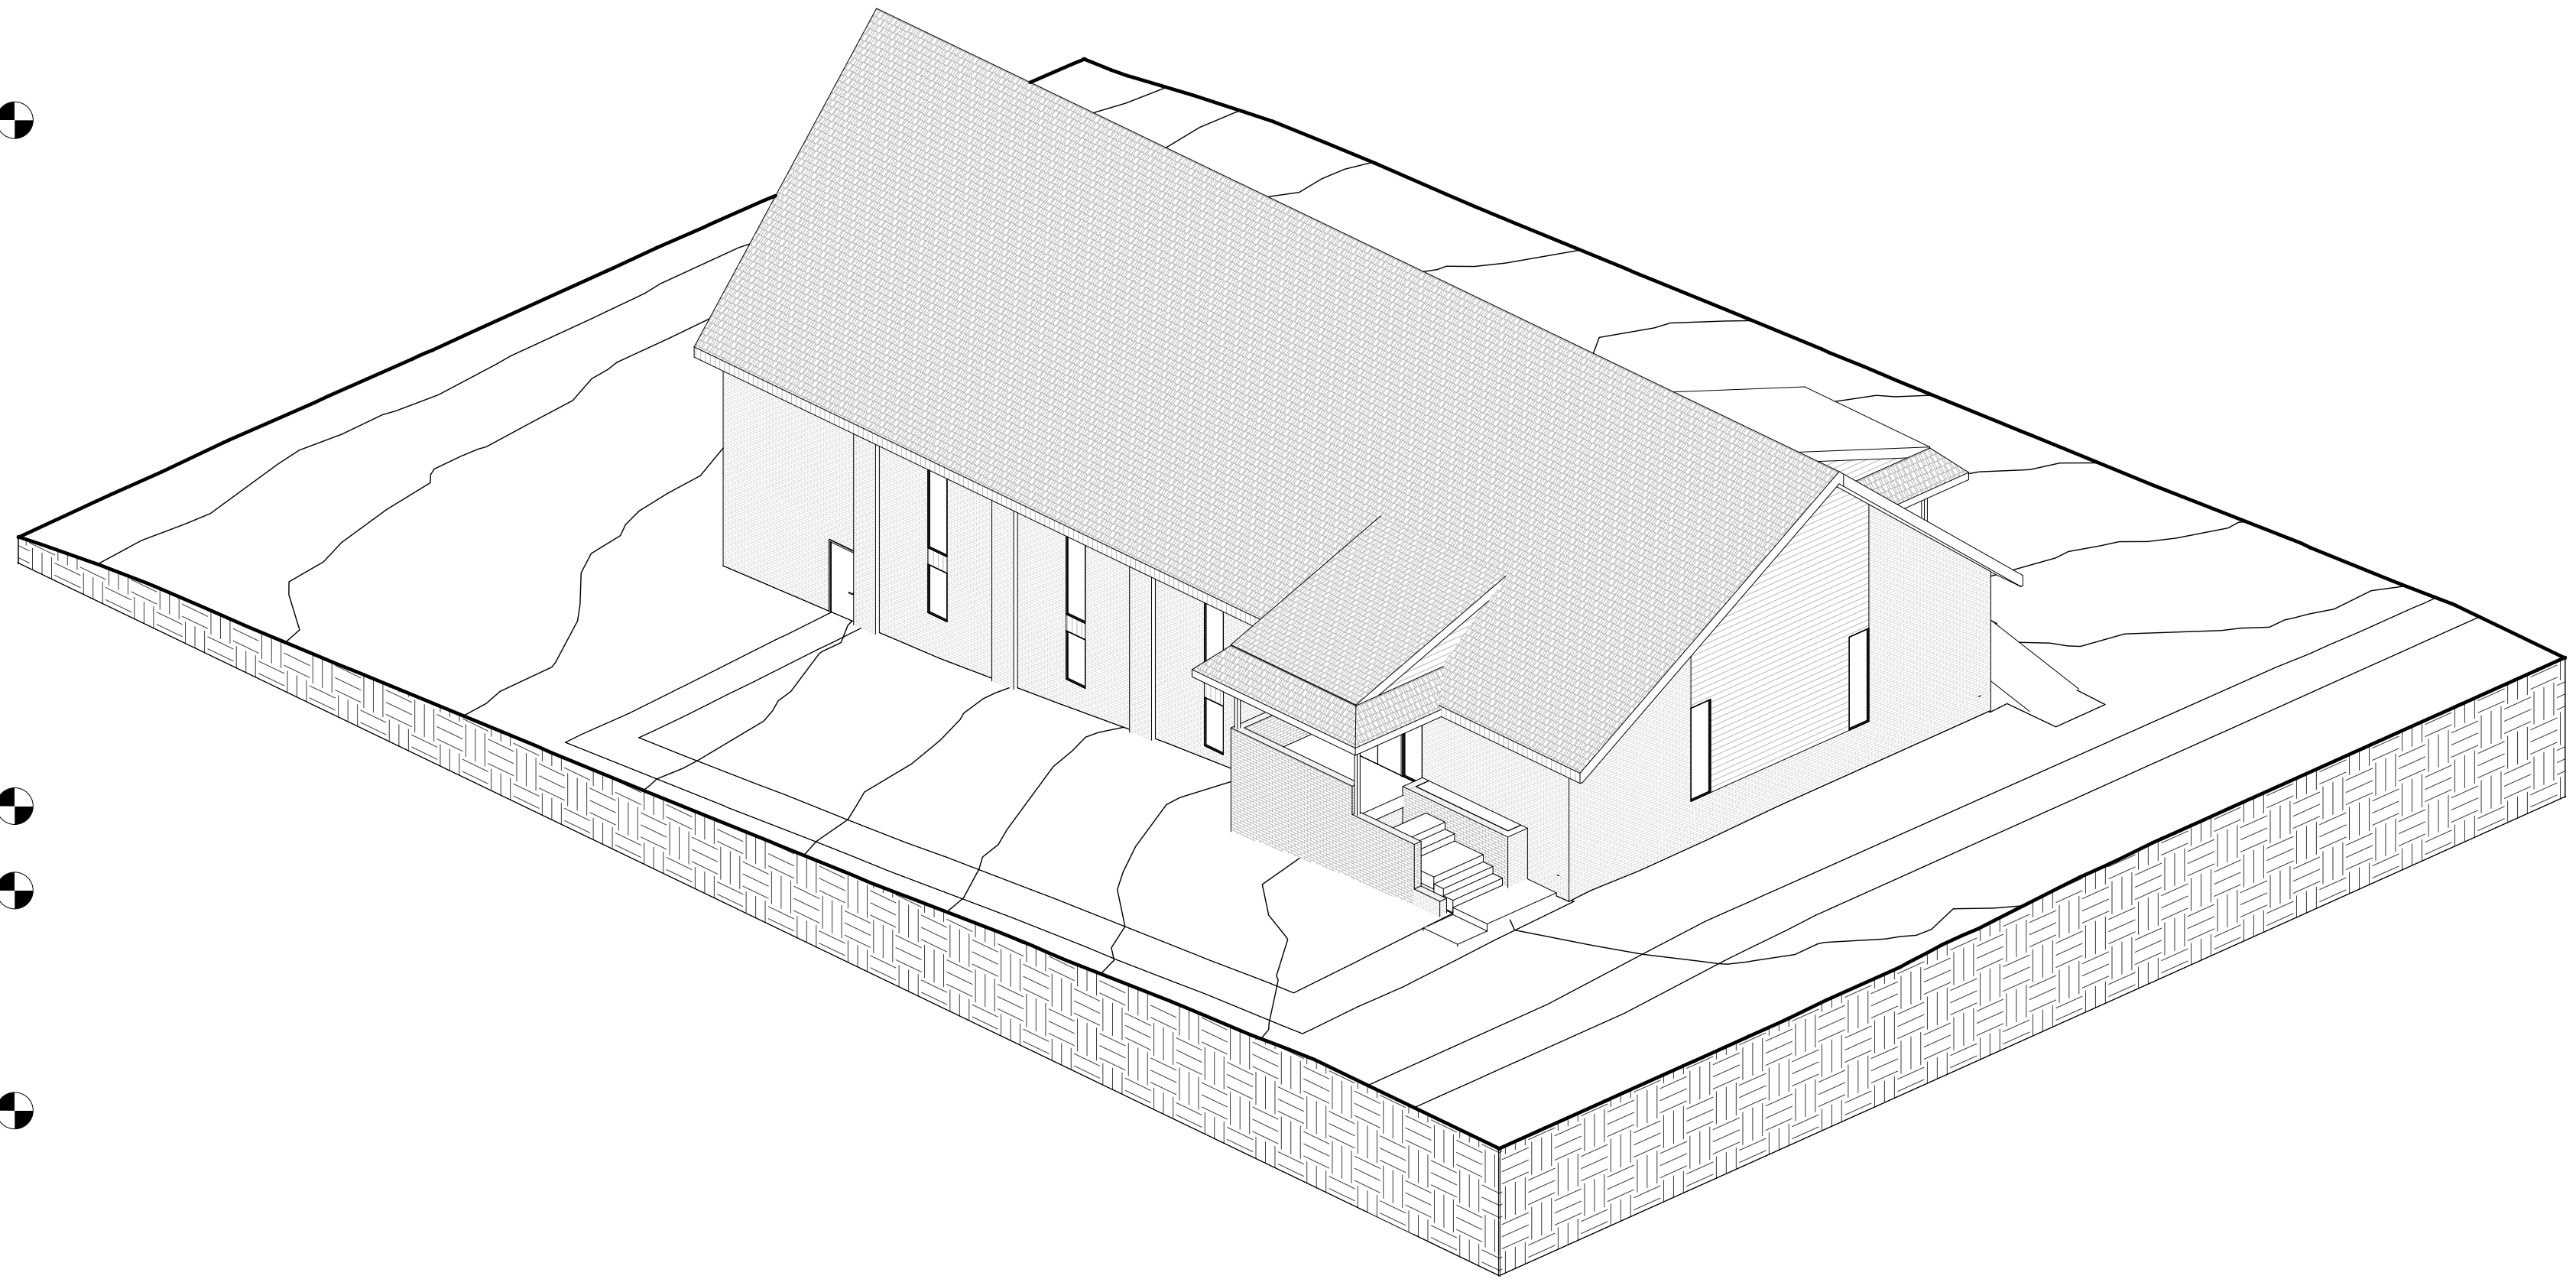

01 | AS-BUILT AXON 01
[A1.09]

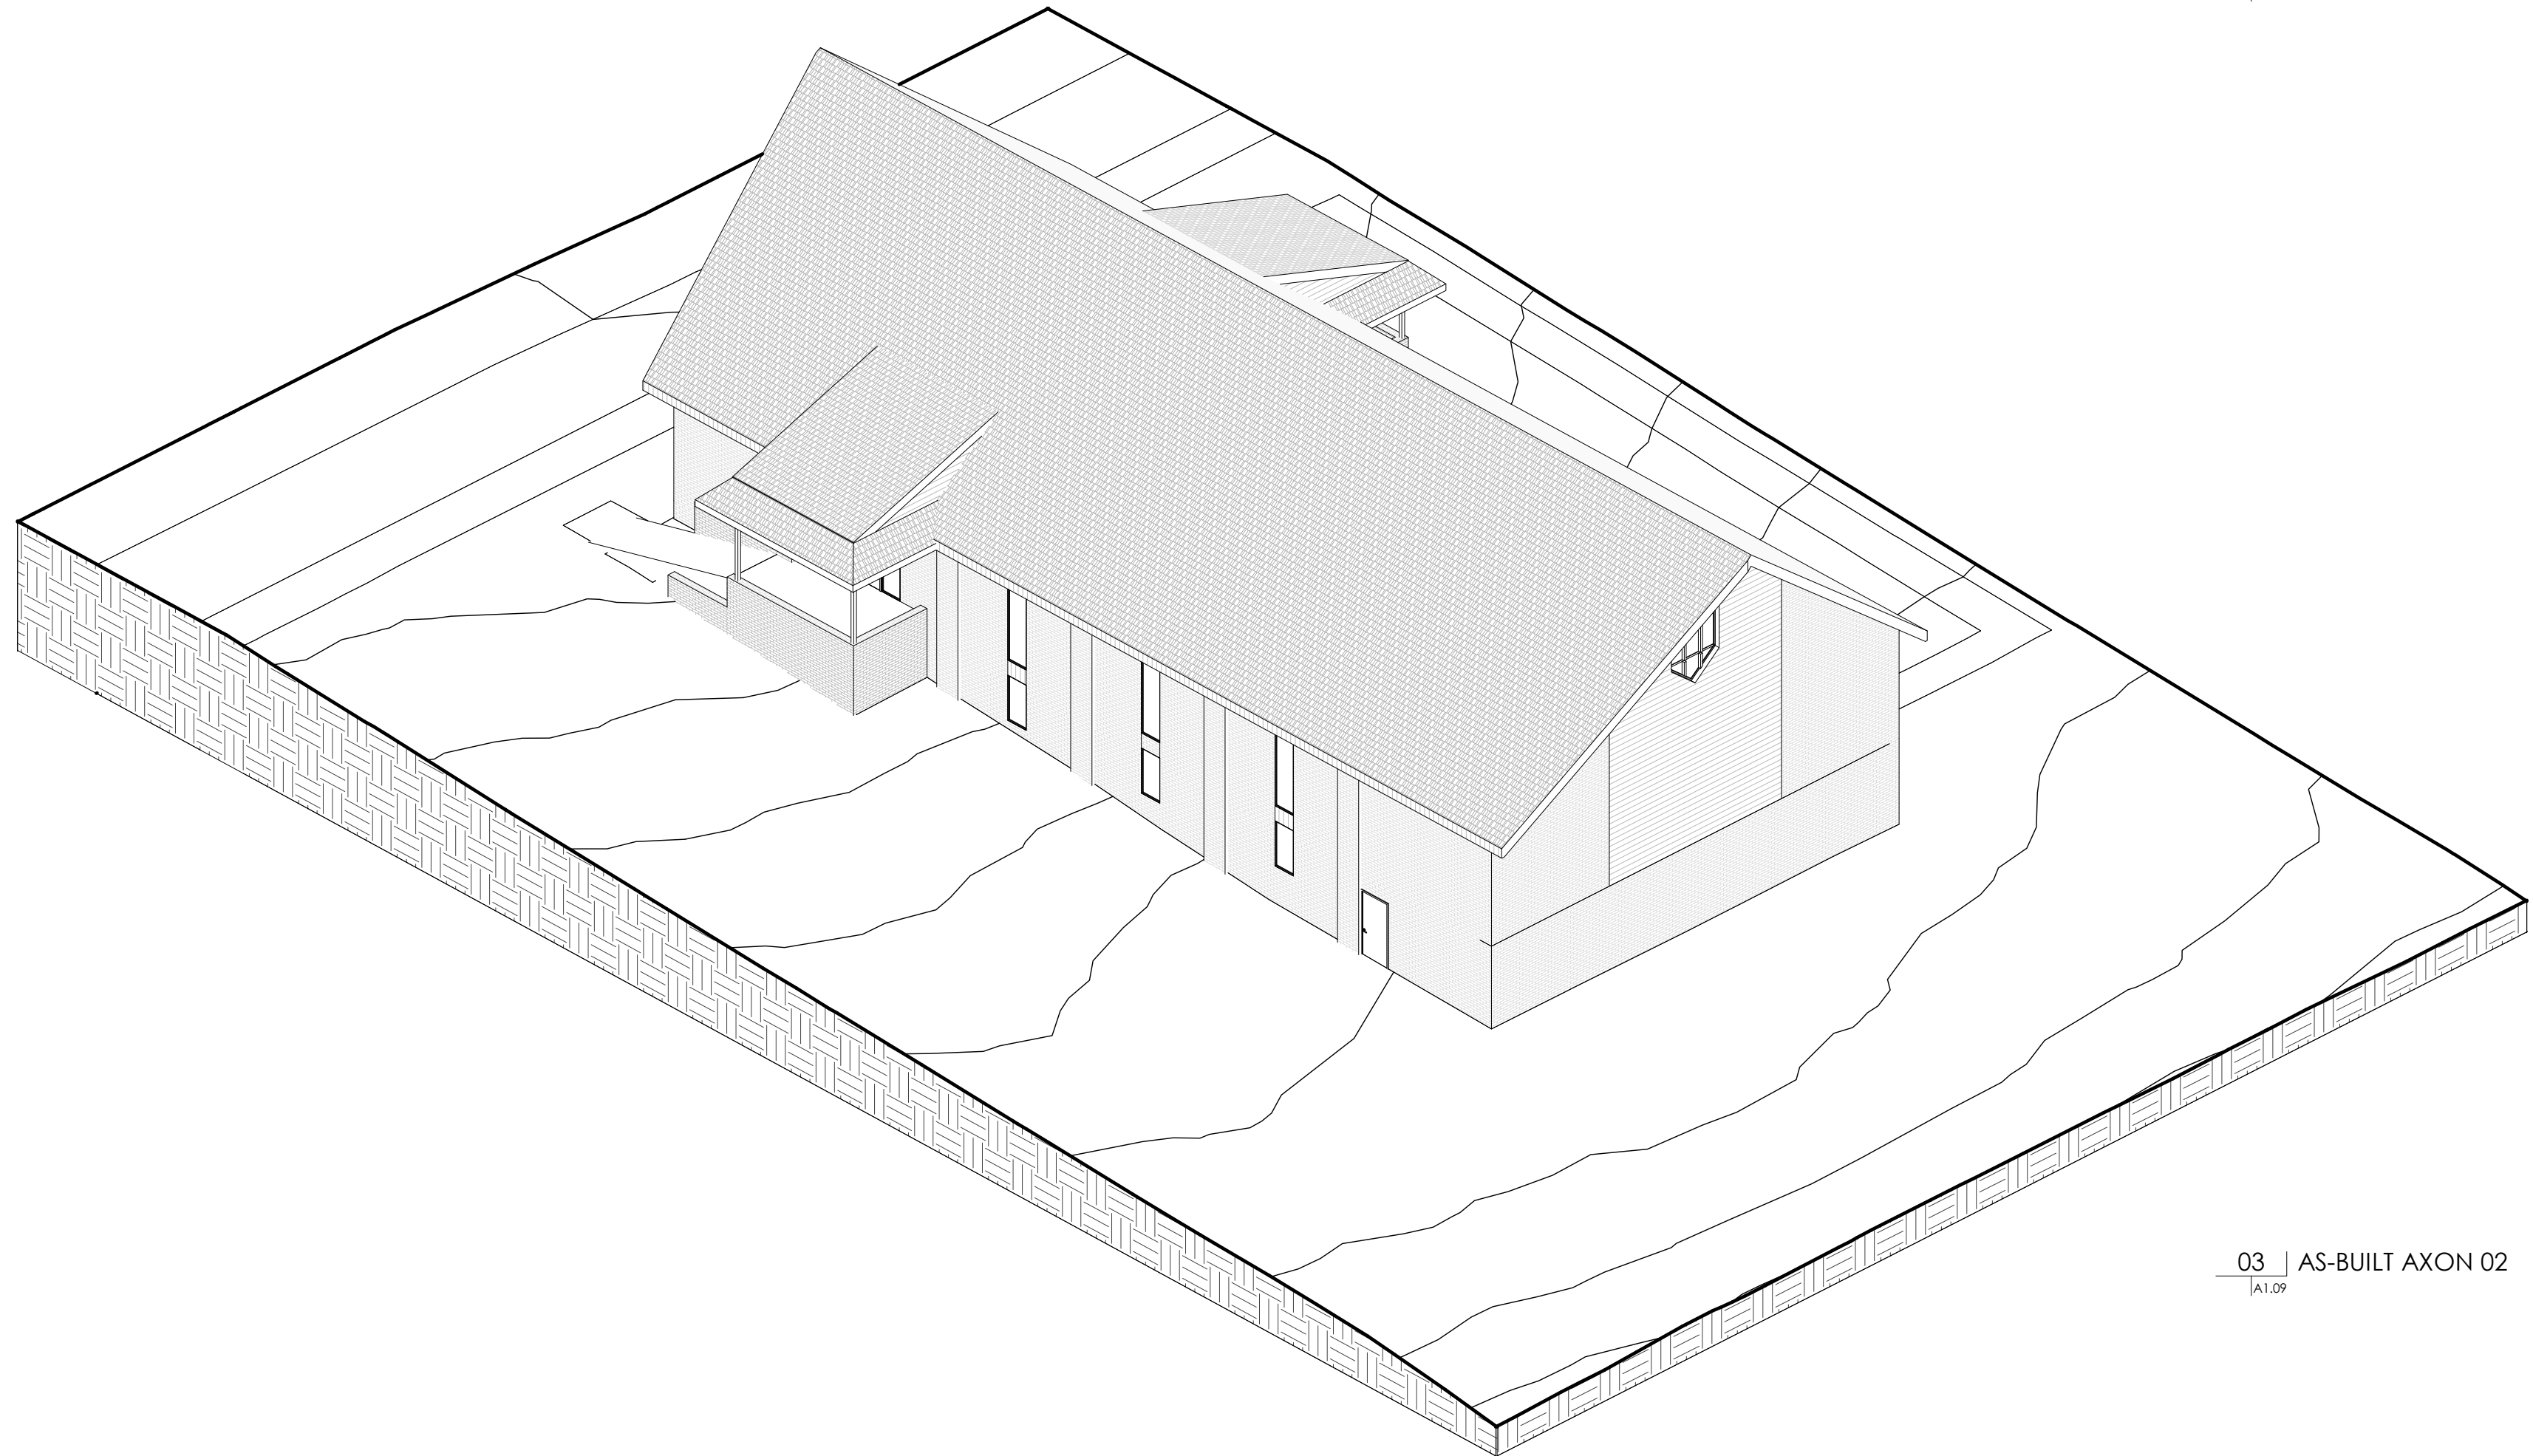

03 | AS-BUILT AXON 02
[A1.09]

PROJECT NAME:
TOWNSHIP CHURCH

LOCATION:
2400 E TOWNSHIP,
FAYETTEVILLE, AR
72703

AS-BUILTS

NOT FOR CONSTRUCTION



SHEET NAME AS-BUILT AXONS
+ SECTION

DATE 2024.09.20


REVISIONS

PROJECT NUMBER 24.14

SHEET NUMBER

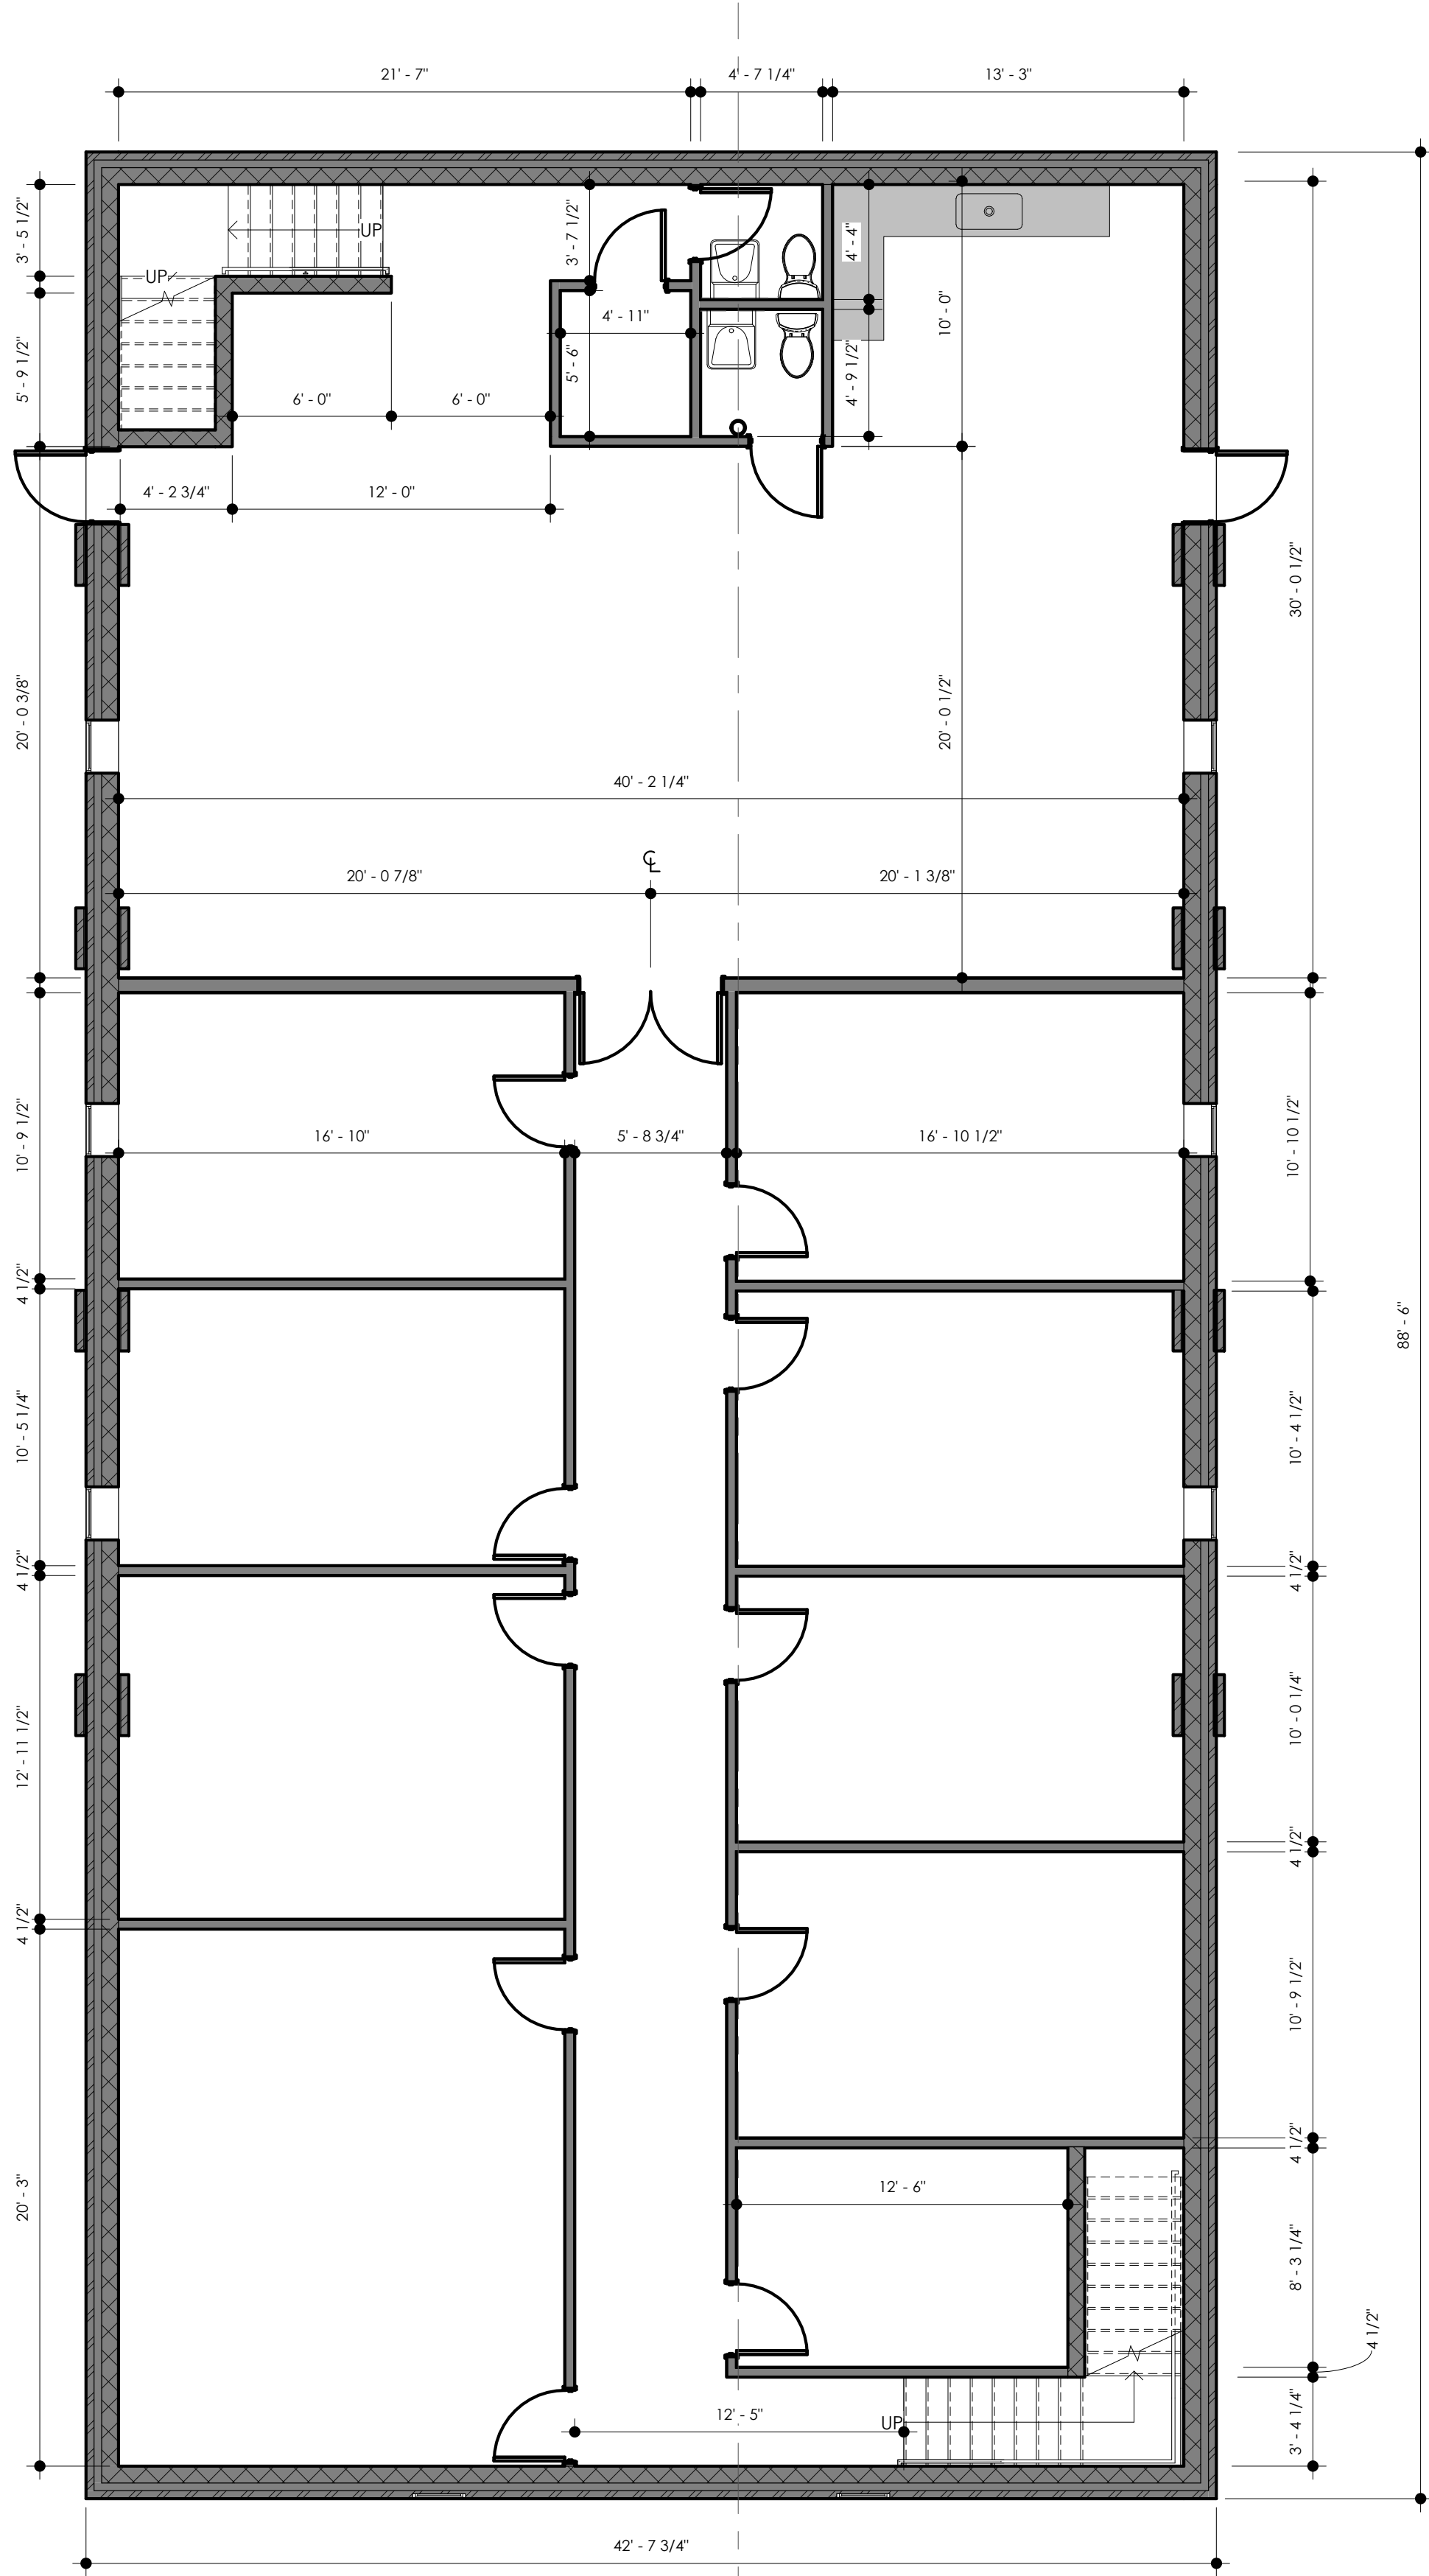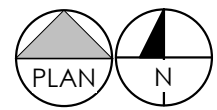

01 | AS-BUILT FLOOR PLAN - LEVEL 00
A1.09/A1.10 3/16\"/>

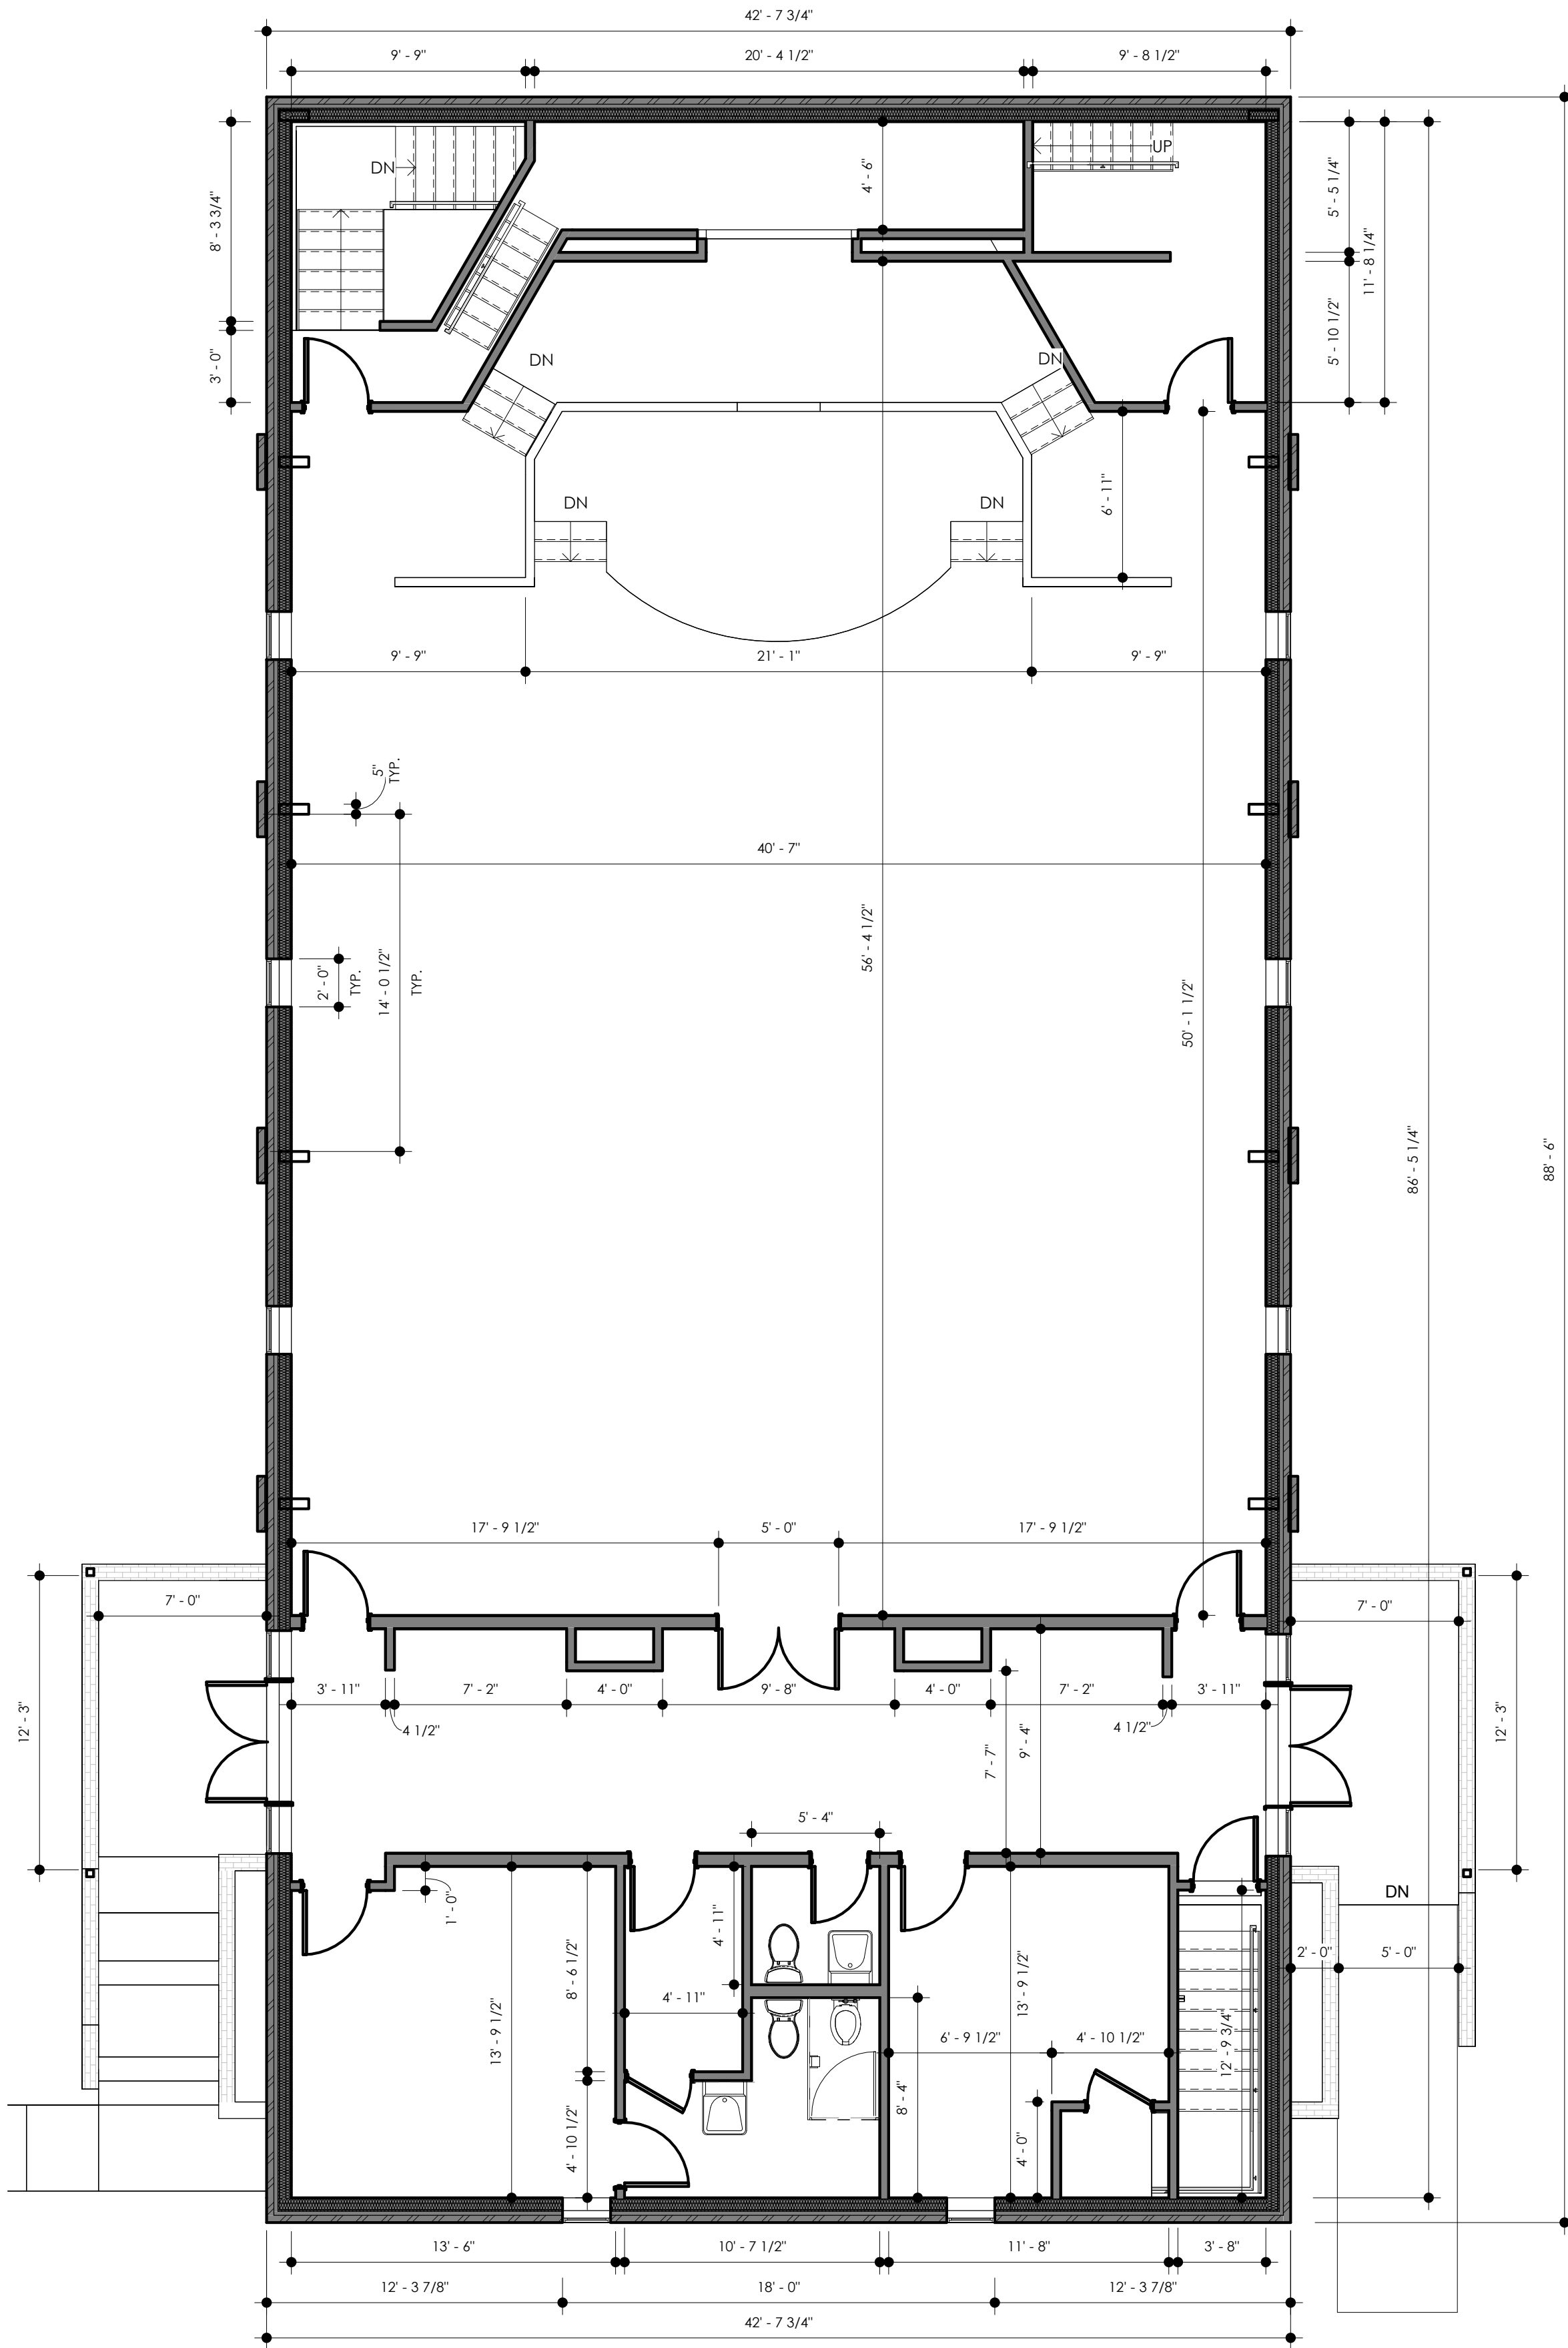

02 | AS-BUILT FLOOR PLAN - LEVEL 01
A1.09/A1.10 3/16\"/>

PROJECT NAME:
TOWNSHIP CHURCH

LOCATION:
2400 E TOWNSHIP,
FAYETTEVILLE, AR
72703

AS-BUILTS

NOT FOR CONSTRUCTION

AS-BUILT FLOOR
PLANS
SHEET NAME

DATE 2024.09.20

REVISIONS

PROJECT NUMBER 24.14

SHEET NUMBER