


# 3921 East Baseline Road

Gilbert, Arizona  
Suite 102 - 8,643 RSF

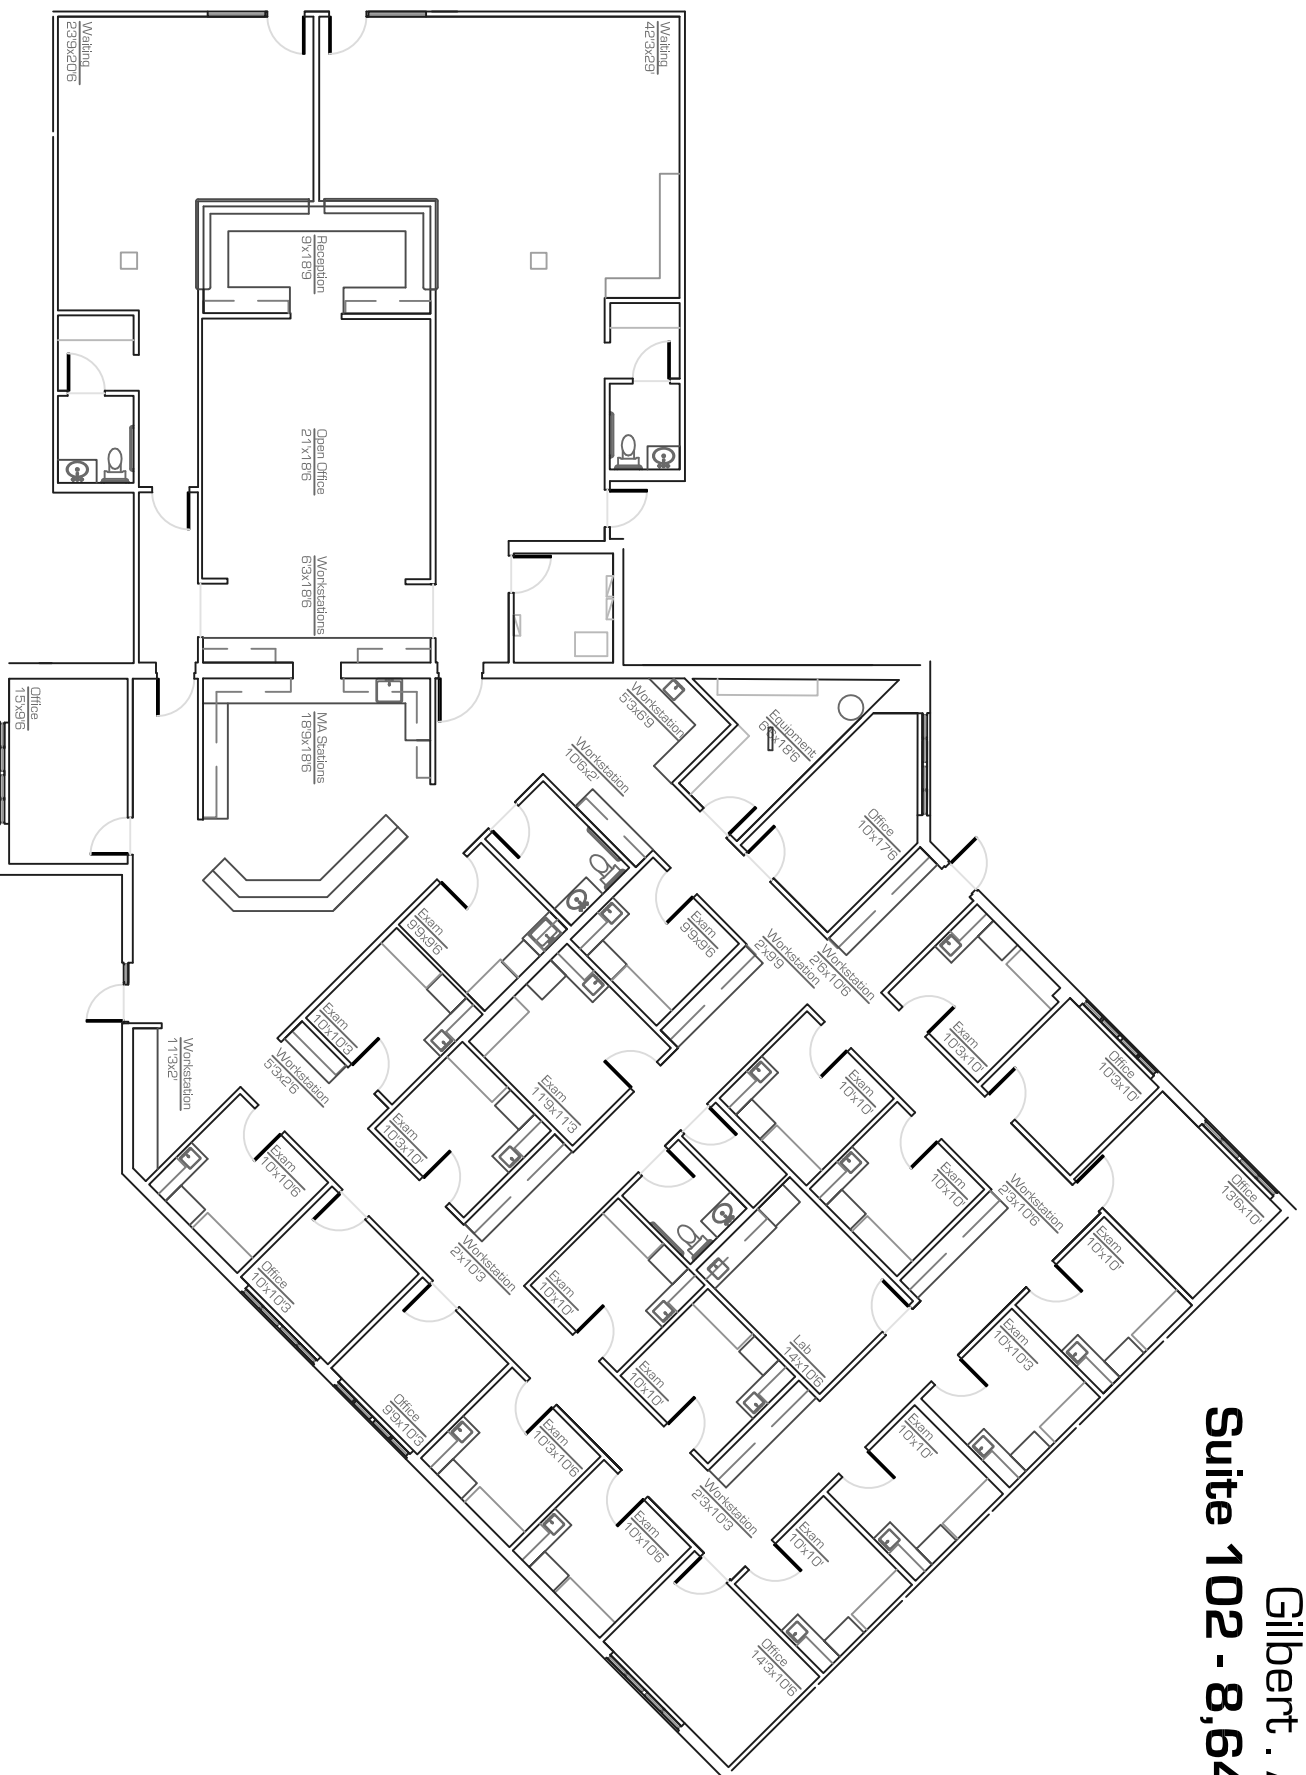

## As-Built

scale: nts  
January, 2020

\* All dimensions are approximate at ± 3"  
\* All information is of general nature

precision **DIMENSIONS**

as-built & design  
602.790.6412

