



WILDFLOWER
DESIGN STUDIO

© 2021 COPYRIGHT WILDFLOWER DESIGN STUDIO PC
THIS DRAWING IS AN INSTRUMENT OF SERVICE UNIQUE
TO THIS PROJECT. IT IS NOT TO BE REUSED OR
REPRODUCED IN WHOLE OR IN PART WITHOUT
WRITTEN PERMISSION FROM THE ARCHITECT.

**NOT FOR
CONSTRUCTION**

NOTE: AS WITH ALL EXISTING
BUILDINGS, THERE WILL BE MINOR
DISCREPANCIES IN DIMENSIONS
AND OTHER TOLERANCES TO
ACCOUNT FOR MINOR
IMPERFECTIONS
AND CONSTRUCTION VARIATIONS.

No.	Description	Date
A	OWNER REVIEW	21 NOV 2025


TRIBE
**AS-BUILT PLANS
FOR 127 W. ANTRIM**
FLOOR PLANS - LABELED

Project number	25-039
Date	21 NOV 2025
Drawn by	JAB
Checked by	JAB


A1.0

Scale 3/16" = 1'-0"

11/24/2025 10:05:48 AM

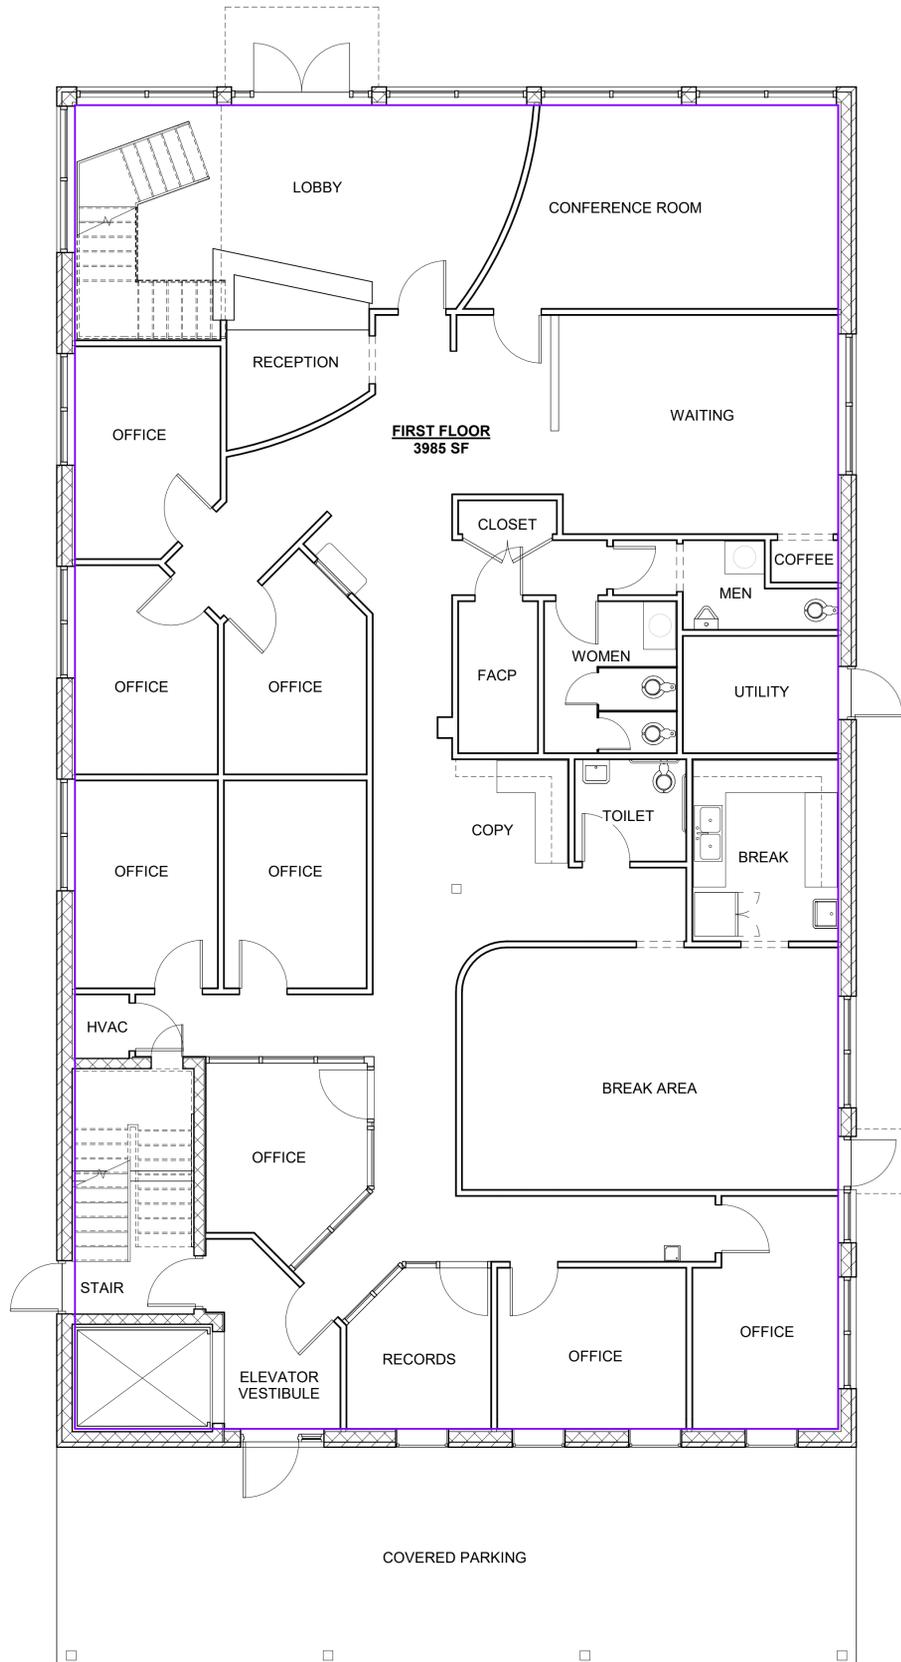

① LEVEL 1 LABELED
3/16" = 1'-0"

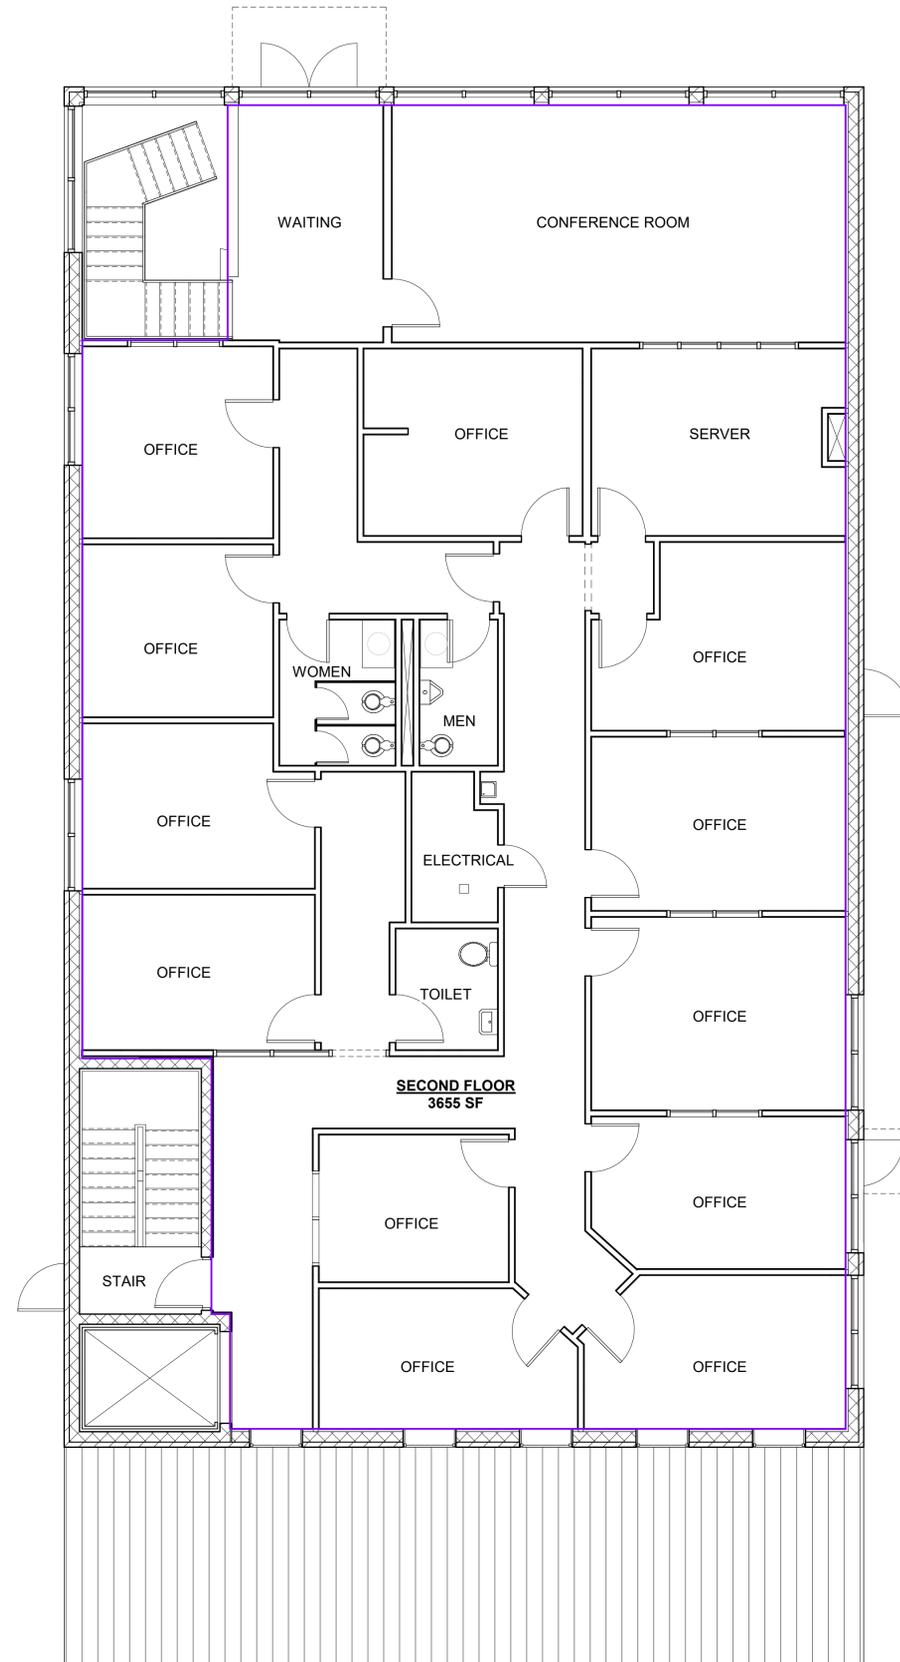

② LEVEL 2 LABELED
3/16" = 1'-0"