


EXHIBIT "A"

LAYOUT OF PREMISES

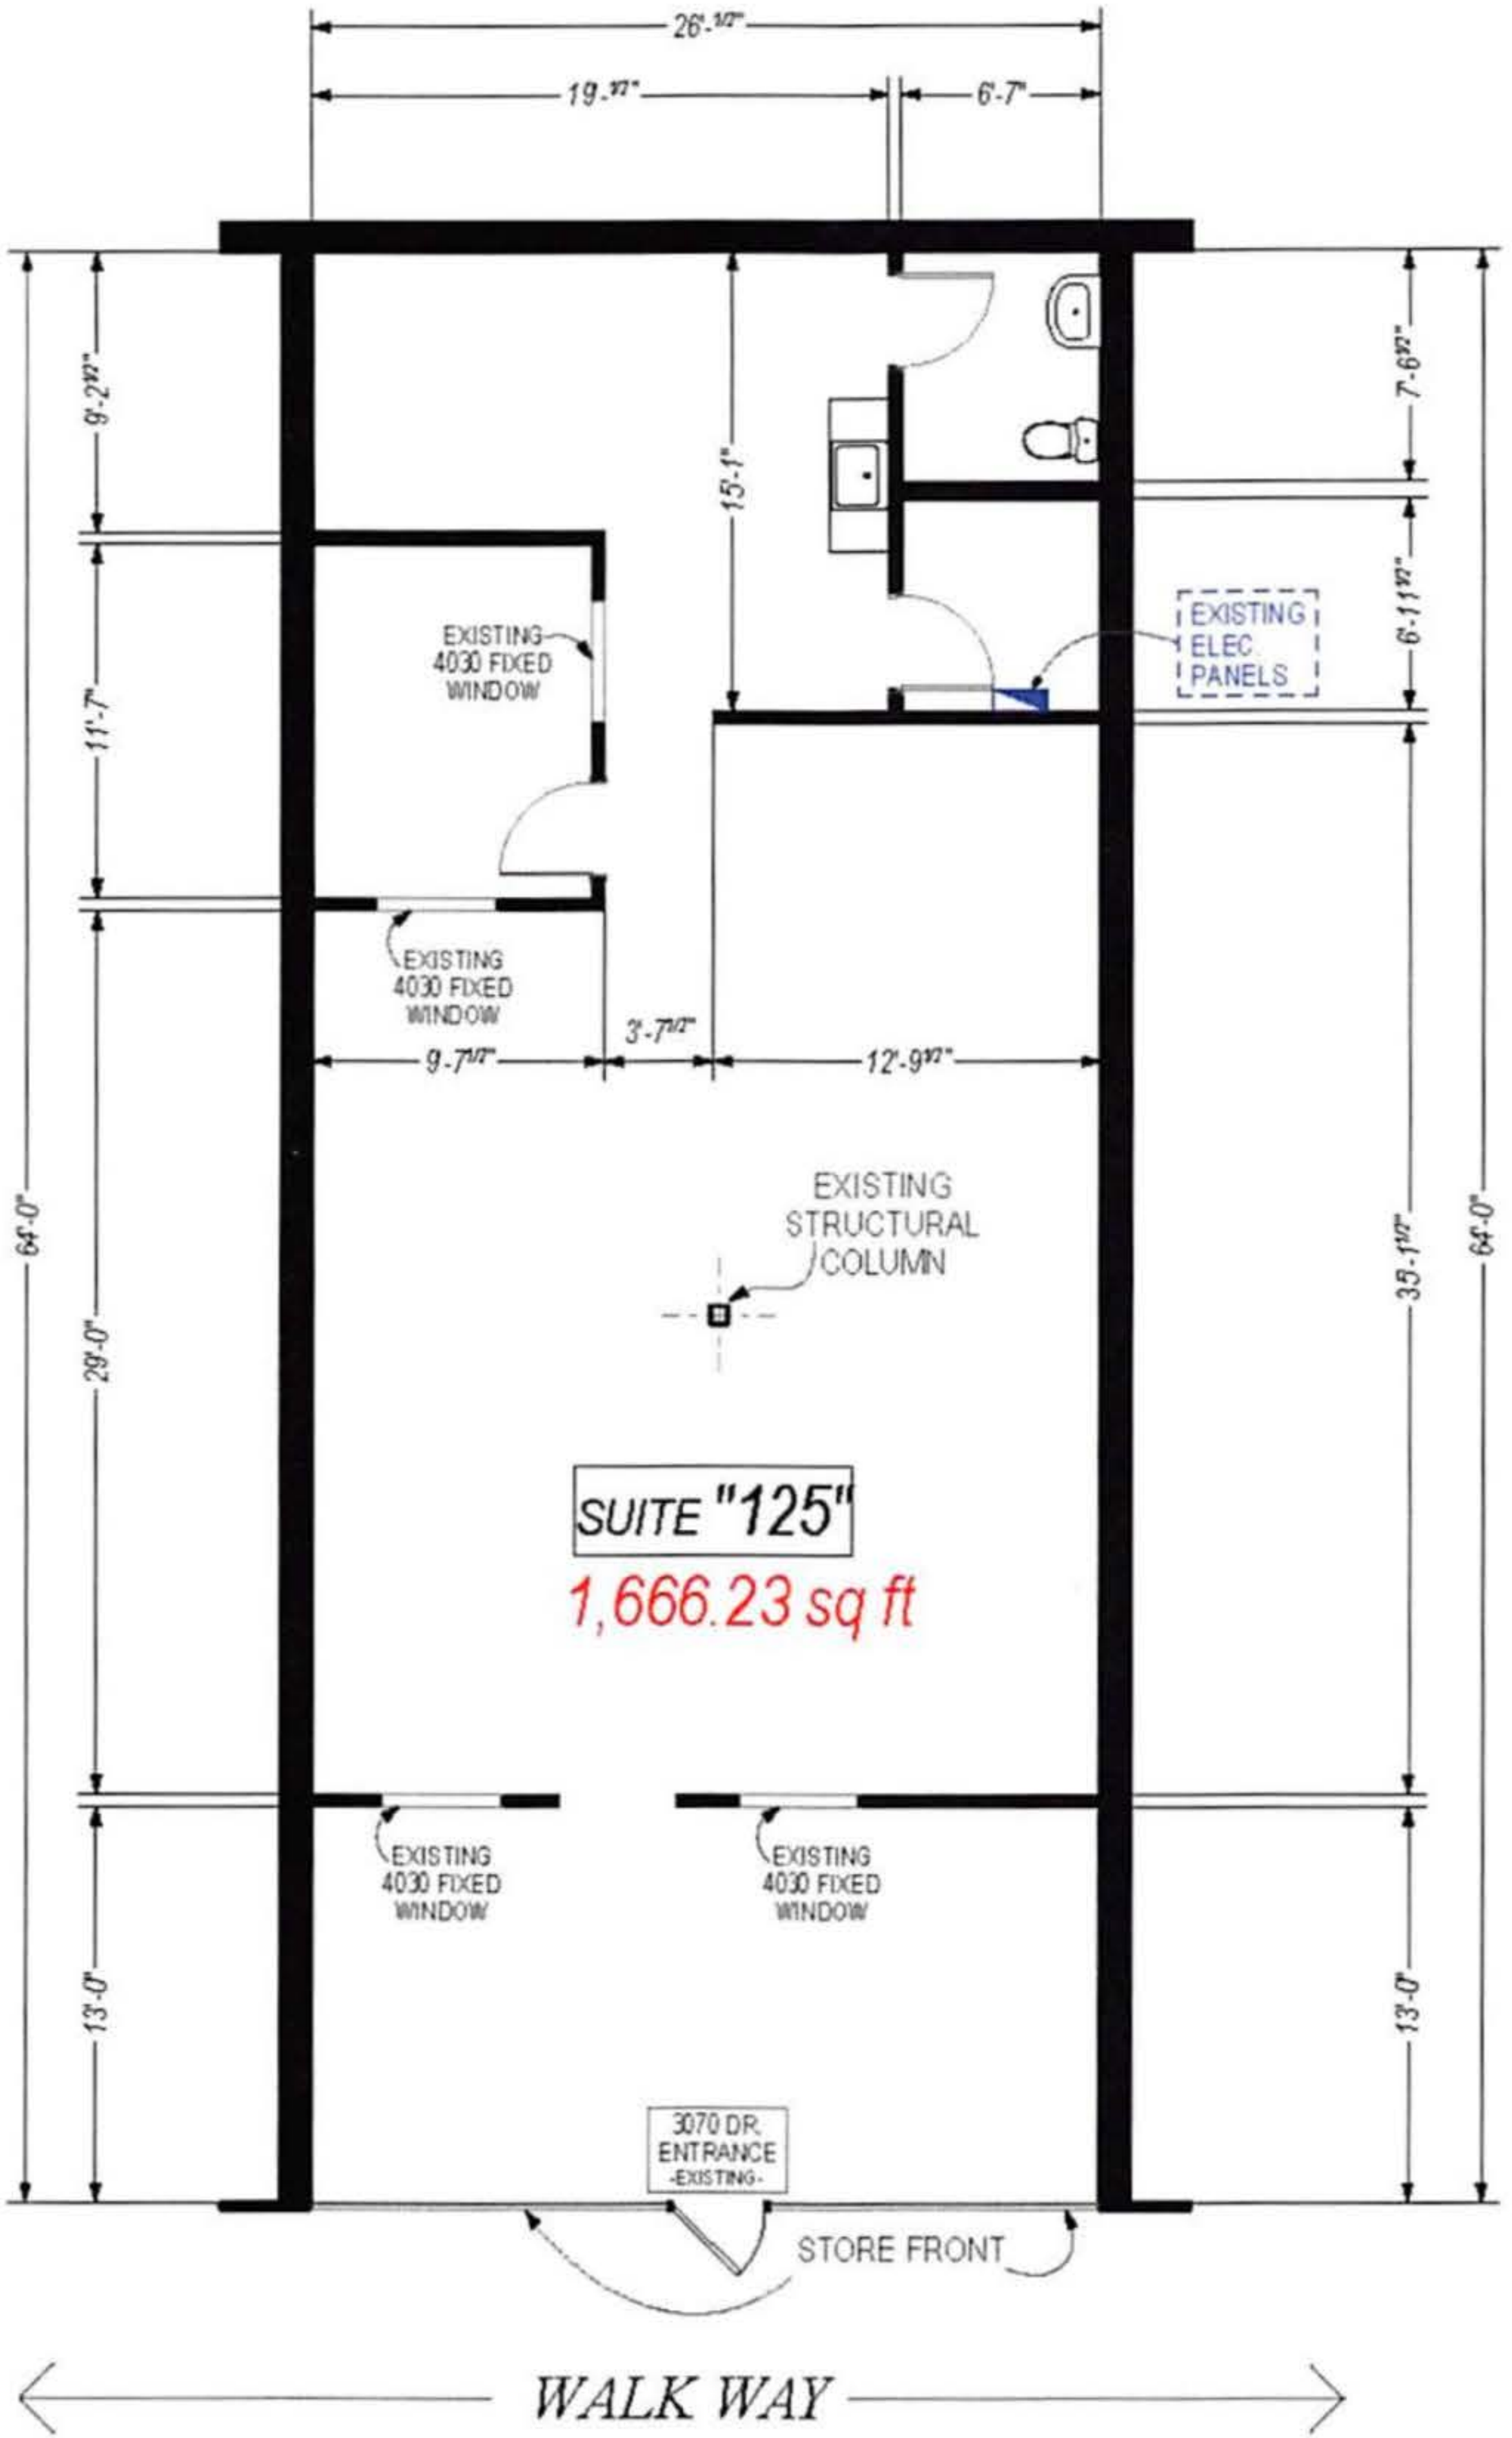

ASBUILT LAYOUT

Office Space at:

• 115 CODELL DR. Suite# 125 • Lexington, KY •